

Archived: Friday, February 14, 2025 11:15:44 AM

From: [Jones, Art](#)

Sent: Wednesday, February 12, 2025 11:31:49 AM

To: [Baitong Chen Kim, James Kim, Jenny](#)

Cc: [Steve Cassulo Fong, Cornelius Sullivan, Pat Stephens, Gabrielle Viswanathan, Srividhya Han, Jessie Kelly Kincella Marcus Herzog Nathaniel Dicke](#) [Nicole Ward Mike Calleja Dylan Smith Amanda Froman Haley, William \(Bill\) Kate Logan Ambriz, Antonio](#)

Subject: RE: Additional Information Request for ANs 647475, 647476, and 647477 Facility ID 119319

Importance: Normal

Sensitivity: None

Attachments:

[CCL MASTER EXISTING GCCS MAP ONLY_2025-02-12-36x48 - GCCS MAP.pdf](#) 

[EXTERNAL SENDER: Use caution with links/attachments]

Good Afternoon Chris

Attached is the updated as-built through 2-12 for your files.

Have a great day

Sincerely,

Art

Arthur E Jones Jr
Desert Southwest Region Manager/Vice President
SCS Engineers
Field Services Group
6 Sunset Way Suite 101
Henderson, NV 89014
Office Phone 209-702-6228
Mobile 209-345-2062

Email: ajones@scsengineers.com



Website: www.scsengineers.com

Driven By Client Success



This email may contain confidential information and is intended for use by the addressee and/or their intended representatives only. If you are not the intended recipient, please do not transmit, copy, disclose, store or utilize this communication in any manner. If you received this message in error, please notify the sender immediately and permanently delete this message from your computer. SCS Engineers accepts no liability for the content of this email or for the consequences of any actions taken on the basis of the information provided. – SCS Engineers

N:\CAD\ASBUILT - MASTERS\CHICUITA\GCCS\LOC MASTER EXISTING GCCS MAP ONLY 2025-02-10.dwg Feb 11, 2025 - 9:39am By: 5160garm

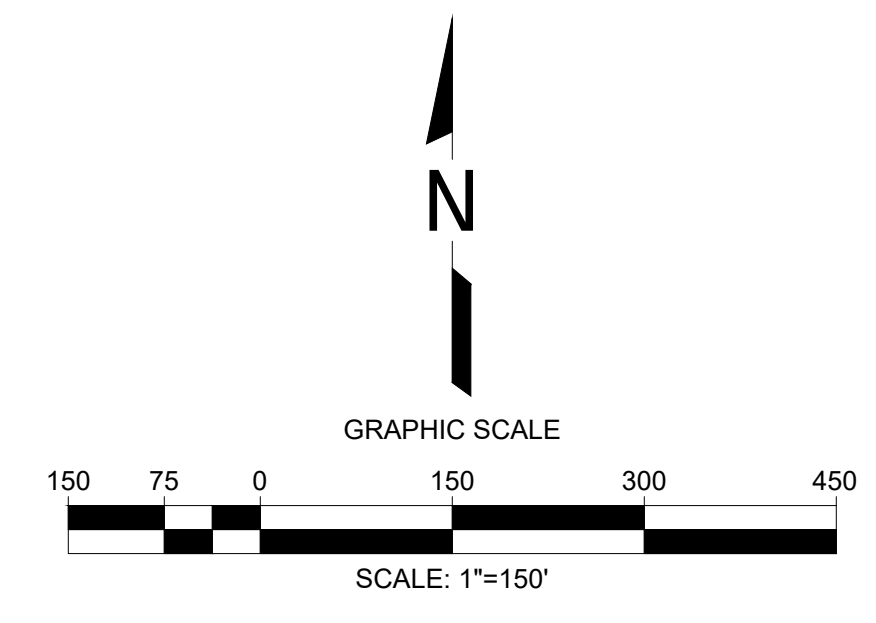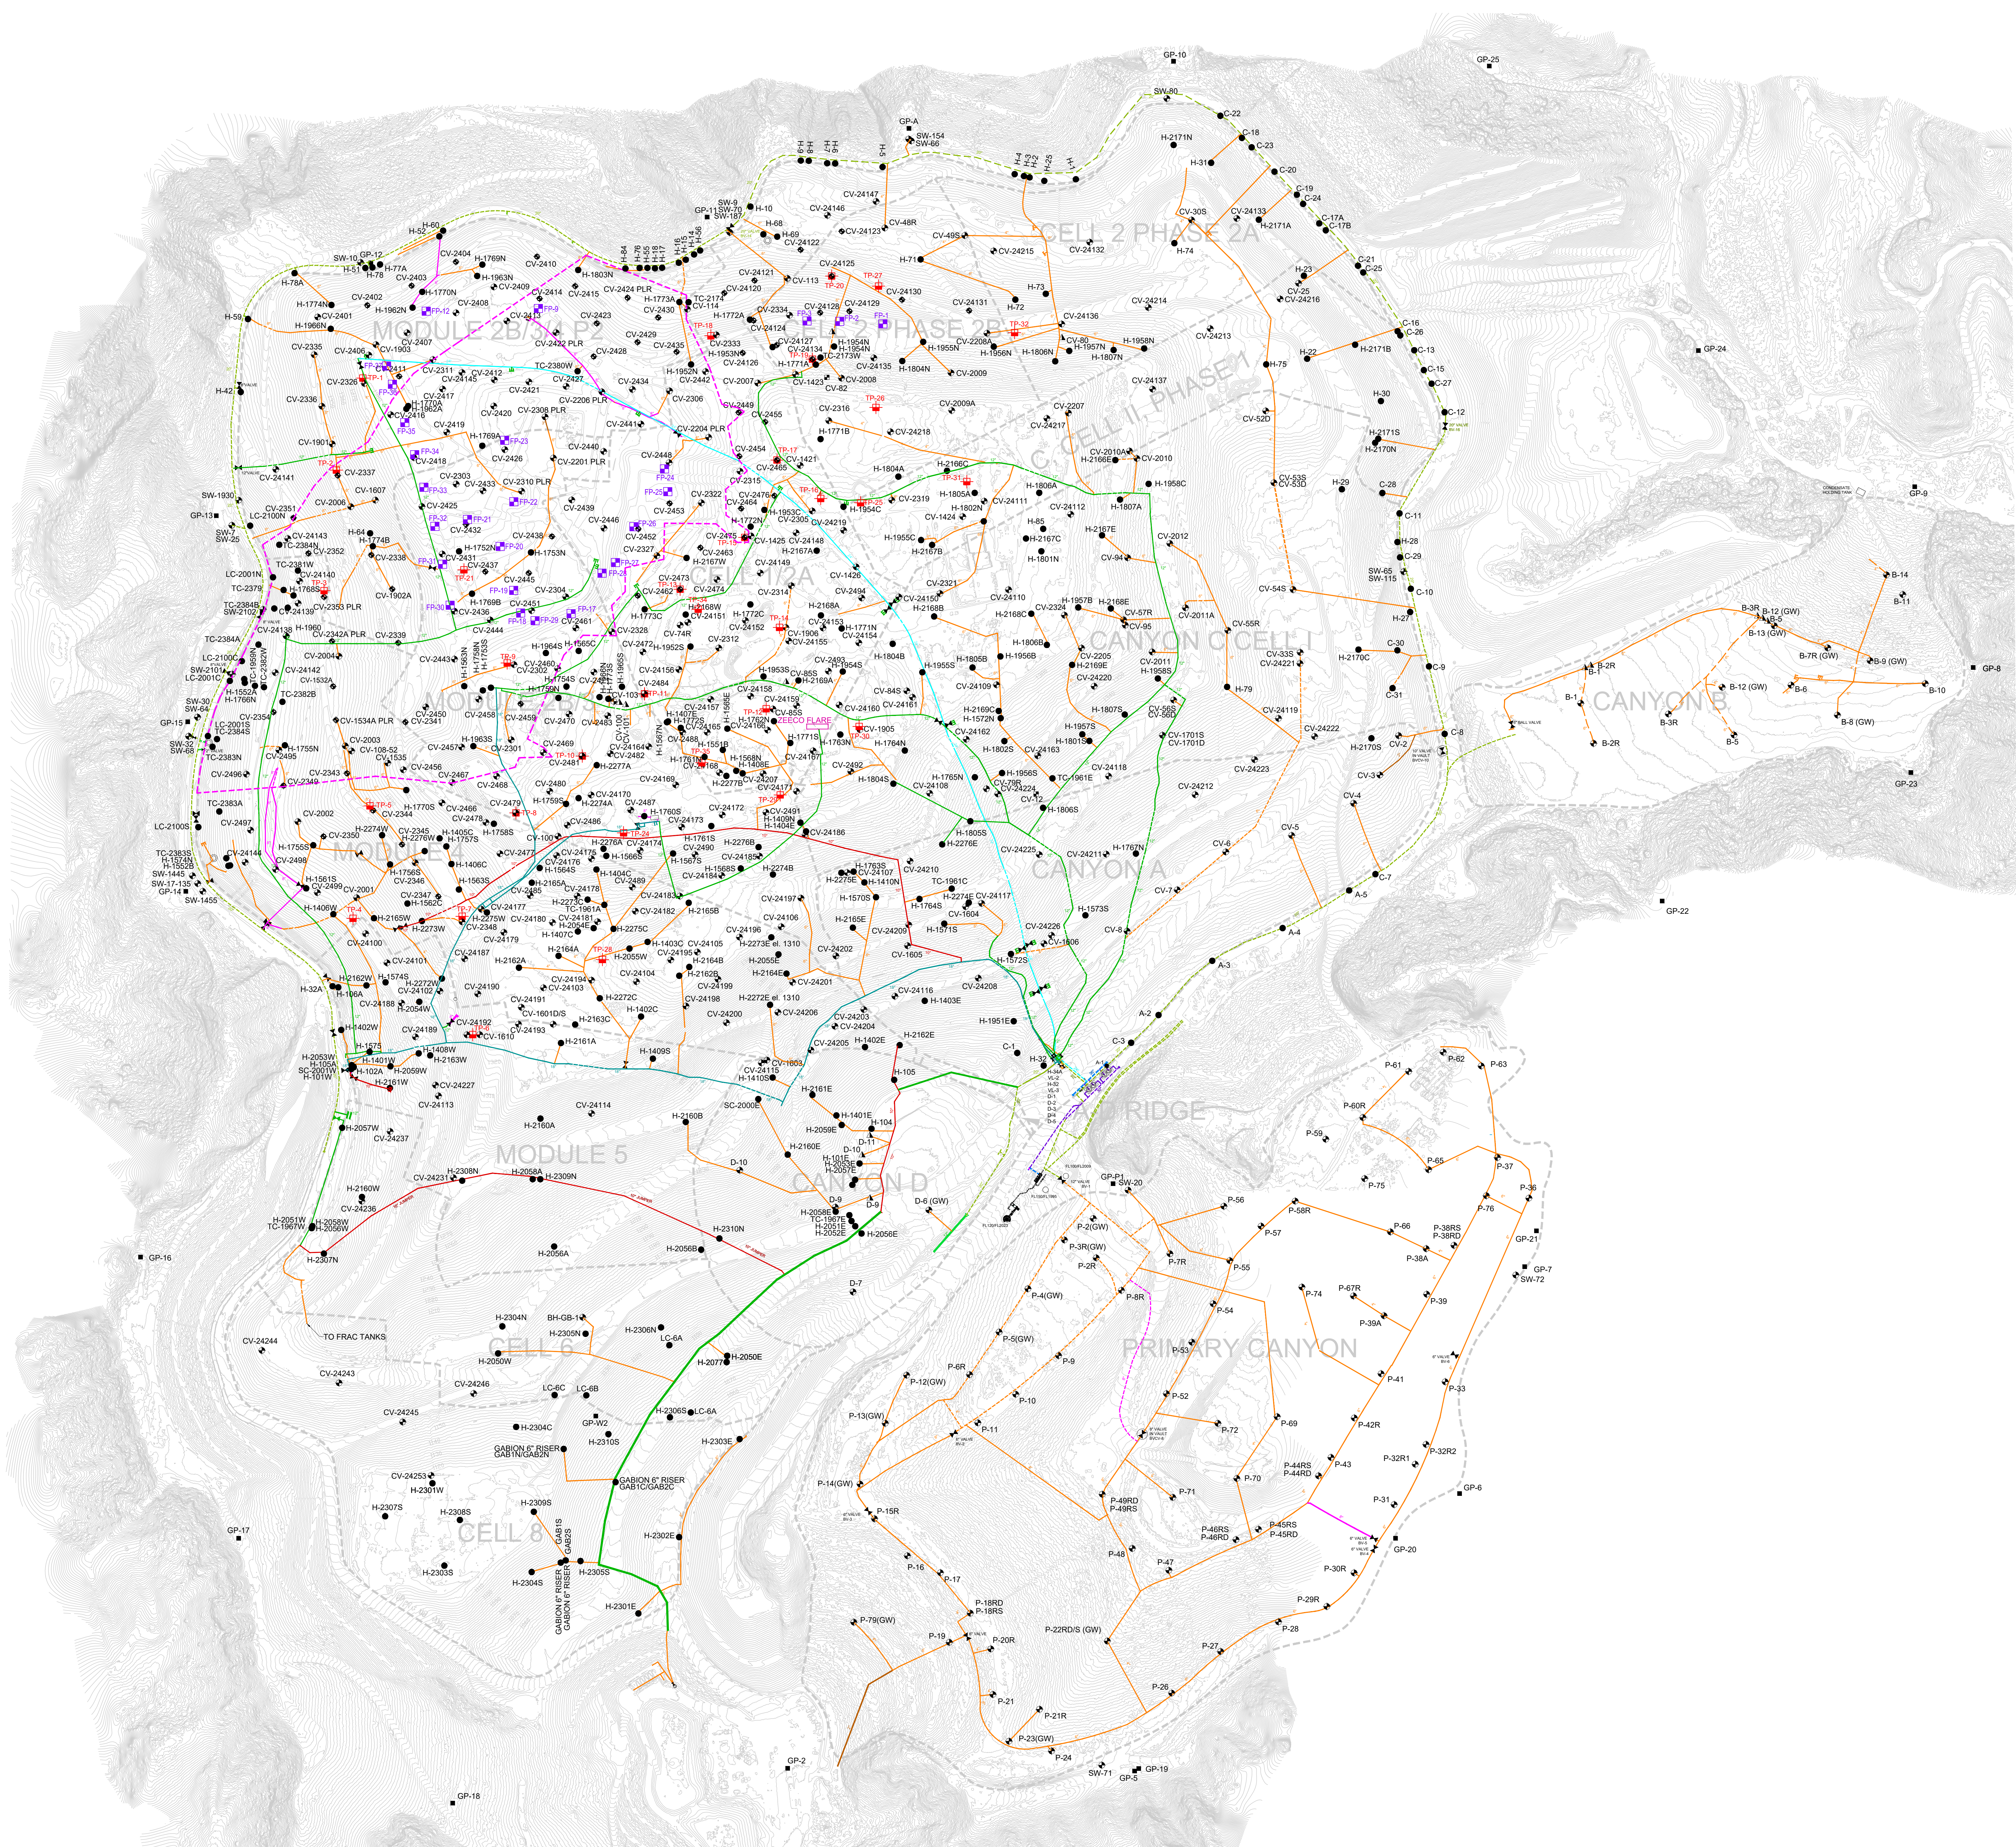

- LEGEND**
- TOPOGRAPHIC CONTOUR
 - EXISTING CELL LIMITS (APPROXIMATE)
 - EXISTING LFG VERTICAL EXTRACTION WELL
 - EXISTING LFG VERTICAL EXTRACTION WELL - PRESSURIZED LEACHATE RELEASE
 - EXISTING GABION LFG COLLECTOR WELL
 - EXISTING SOIL VAPOR EXTRACTION WELL
 - EXISTING LFG VERTICAL EXTRACTION WELL BELOW-GRADE
 - EXISTING SURFACE COLLECTOR WELLHEAD
 - EXISTING HORIZONTAL WELLS
 - EXISTING REMOTE VERTICAL WELLHEAD
 - EXISTING PERIMETER MIGRATION PROBE
 - EXISTING TEMPERATURE PROBE
 - EXISTING ISOLATION VALVE
 - EXISTING ACTIVATED CARBON VESSEL
 - EXISTING CONDENSATE SUMP
 - EXISTING 36" LFG COLLECTION HEADER PIPING
 - EXISTING 30" LFG COLLECTION HEADER PIPING
 - EXISTING 24" LFG COLLECTION HEADER PIPING
 - EXISTING 20" LFG COLLECTION HEADER PIPING
 - EXISTING 18" LFG COLLECTION HEADER PIPING
 - EXISTING 12" LFG COLLECTION HEADER PIPING
 - EXISTING 10" LFG COLLECTION HEADER PIPING
 - EXISTING 8" LFG COLLECTION LATERAL PIPING
 - EXISTING 4" LFG COLLECTION LATERAL PIPING
 - EXISTING 2" LFG COLLECTION LATERAL PIPING
 - BELOW-GRADE PIPES ARE SHOWN DASHED
 - REACTION AREA BOUNDARY (APPROXIMATE) - BASED ON DATA REVIEW
 - EXISTING CAP

- GENERAL DRAWING NOTES:
- EXISTING TOPOGRAPHIC SURVEY INFORMATION SHOWN WAS PROVIDED BY PROPELLOR, AERIAL PHOTOGRAPHY DATED FEBRUARY 06, 2025.
 - NORTH ARROW SHOWN HERE IS REFERENCE TO THE CALIFORNIA STATE PLANE ZONE V COORDINATE SYSTEM, NAD 83.
 - THE LOCATION OF ANY EXISTING PIPING, VALVES, TIE-IN LOCATIONS AND OTHER FEATURES ARE APPROXIMATE AND SHOULD BE USED FOR INFORMATION PURPOSES ONLY. ACTUAL FIELD CONDITIONS MAY VARY AND SUBJECT TO CHANGE BASED ON FUTURE FILL OPERATIONS, WASTE PLACEMENT, TOPOGRAPHIC FEATURES, AND OTHER SITE-SPECIFIC FACTORS.
 - EXISTING GCCS AS-BUILT DATED FEBRUARY 05, 2025.

DATE		REVISION	
NO.		NO.	
SHEET TITLE:		EXISTING GCCS MAP	
PROJECT TITLE:		CHICUITA CANYON LANDFILL CASTAIC, CALIFORNIA	
CLIENT:		SCS ENGINEERS ENVIRONMENTAL CONSULTANTS 10000 BUSHY CREEK DRIVE, SUITE 100 LONG BEACH, CA 90804 TEL: (562) 426-8844 FAX: (562) 426-8844	
DATE:		02/12/2025	
SCALE:		AS SHOWN	
1		1	