

Archived: Friday, February 28, 2025 9:21:42 AM

From: [Medina, Steven](#)

Sent: Friday, February 21, 2025 9:50:33 AM

To: bchen@aqmd.gov ndickel@aqmd.gov [Christina Ojeda](#)

Cc: [Han, Jessie](#) [Steve Cassulo](#) [Haley, William \(Bill\)](#) [Amanda Froman](#) [Michael Hearn](#) [Nicole Ward](#)
Christopher.Fear@WasteConnections.com [Viswanathan, Srividhya](#) [Kelly Kincella](#) [Kate Logan](#)

Subject: Re: Case No. 6177-4 Stipulated Order for Abatement - Weekly Pump Installation and operation update

Importance: Normal

Sensitivity: None

Attachments:

[Outlook-cmqkcb5k.png](#) [2025 CCLF Existing De-Watering Well with Pump Map_2025-02-21.pdf](#)

[EXTERNAL SENDER: Use caution with links/attachments]

Hello All,

In accordance with Condition 65 of the Modified Stipulated Order, below is the summary of the installation and operation of dewatering pumps for the Chiquita Canyon Landfill.

During 02/14/2025 to 02/20/2025, Chiquita completed the installation of, and began operating during the day, one (1) pump in a vertical LFG extraction well for a total of one hundred and thirty-one (131) pumps operating in vertical LFG extraction wells. Please refer to the attached, up-to-date map of LFG wells with operating pumps.

During 02/21/2025 to 02/27/2025, given the number of dewatering pumps installed to date, and the maintenance associated with those pumps, Chiquita plans to install and begin operating an additional two (2) pumps in vertical LFG extraction wells in locations along the north and south slope of the reaction area. The pump installation locations for next week are subject to change due to weather and/or safety conditions.

Regards,

STEVEN Ruben Medina, **E.I.T.**

Associate Professional

SCS Engineers

3900 Kilroy Airport Way, Suite 300

Long Beach, CA 90806


858-204-4342 (c)

5160srm@scsengineers.com

Driven by Client Success

www.scsengineers.com

□

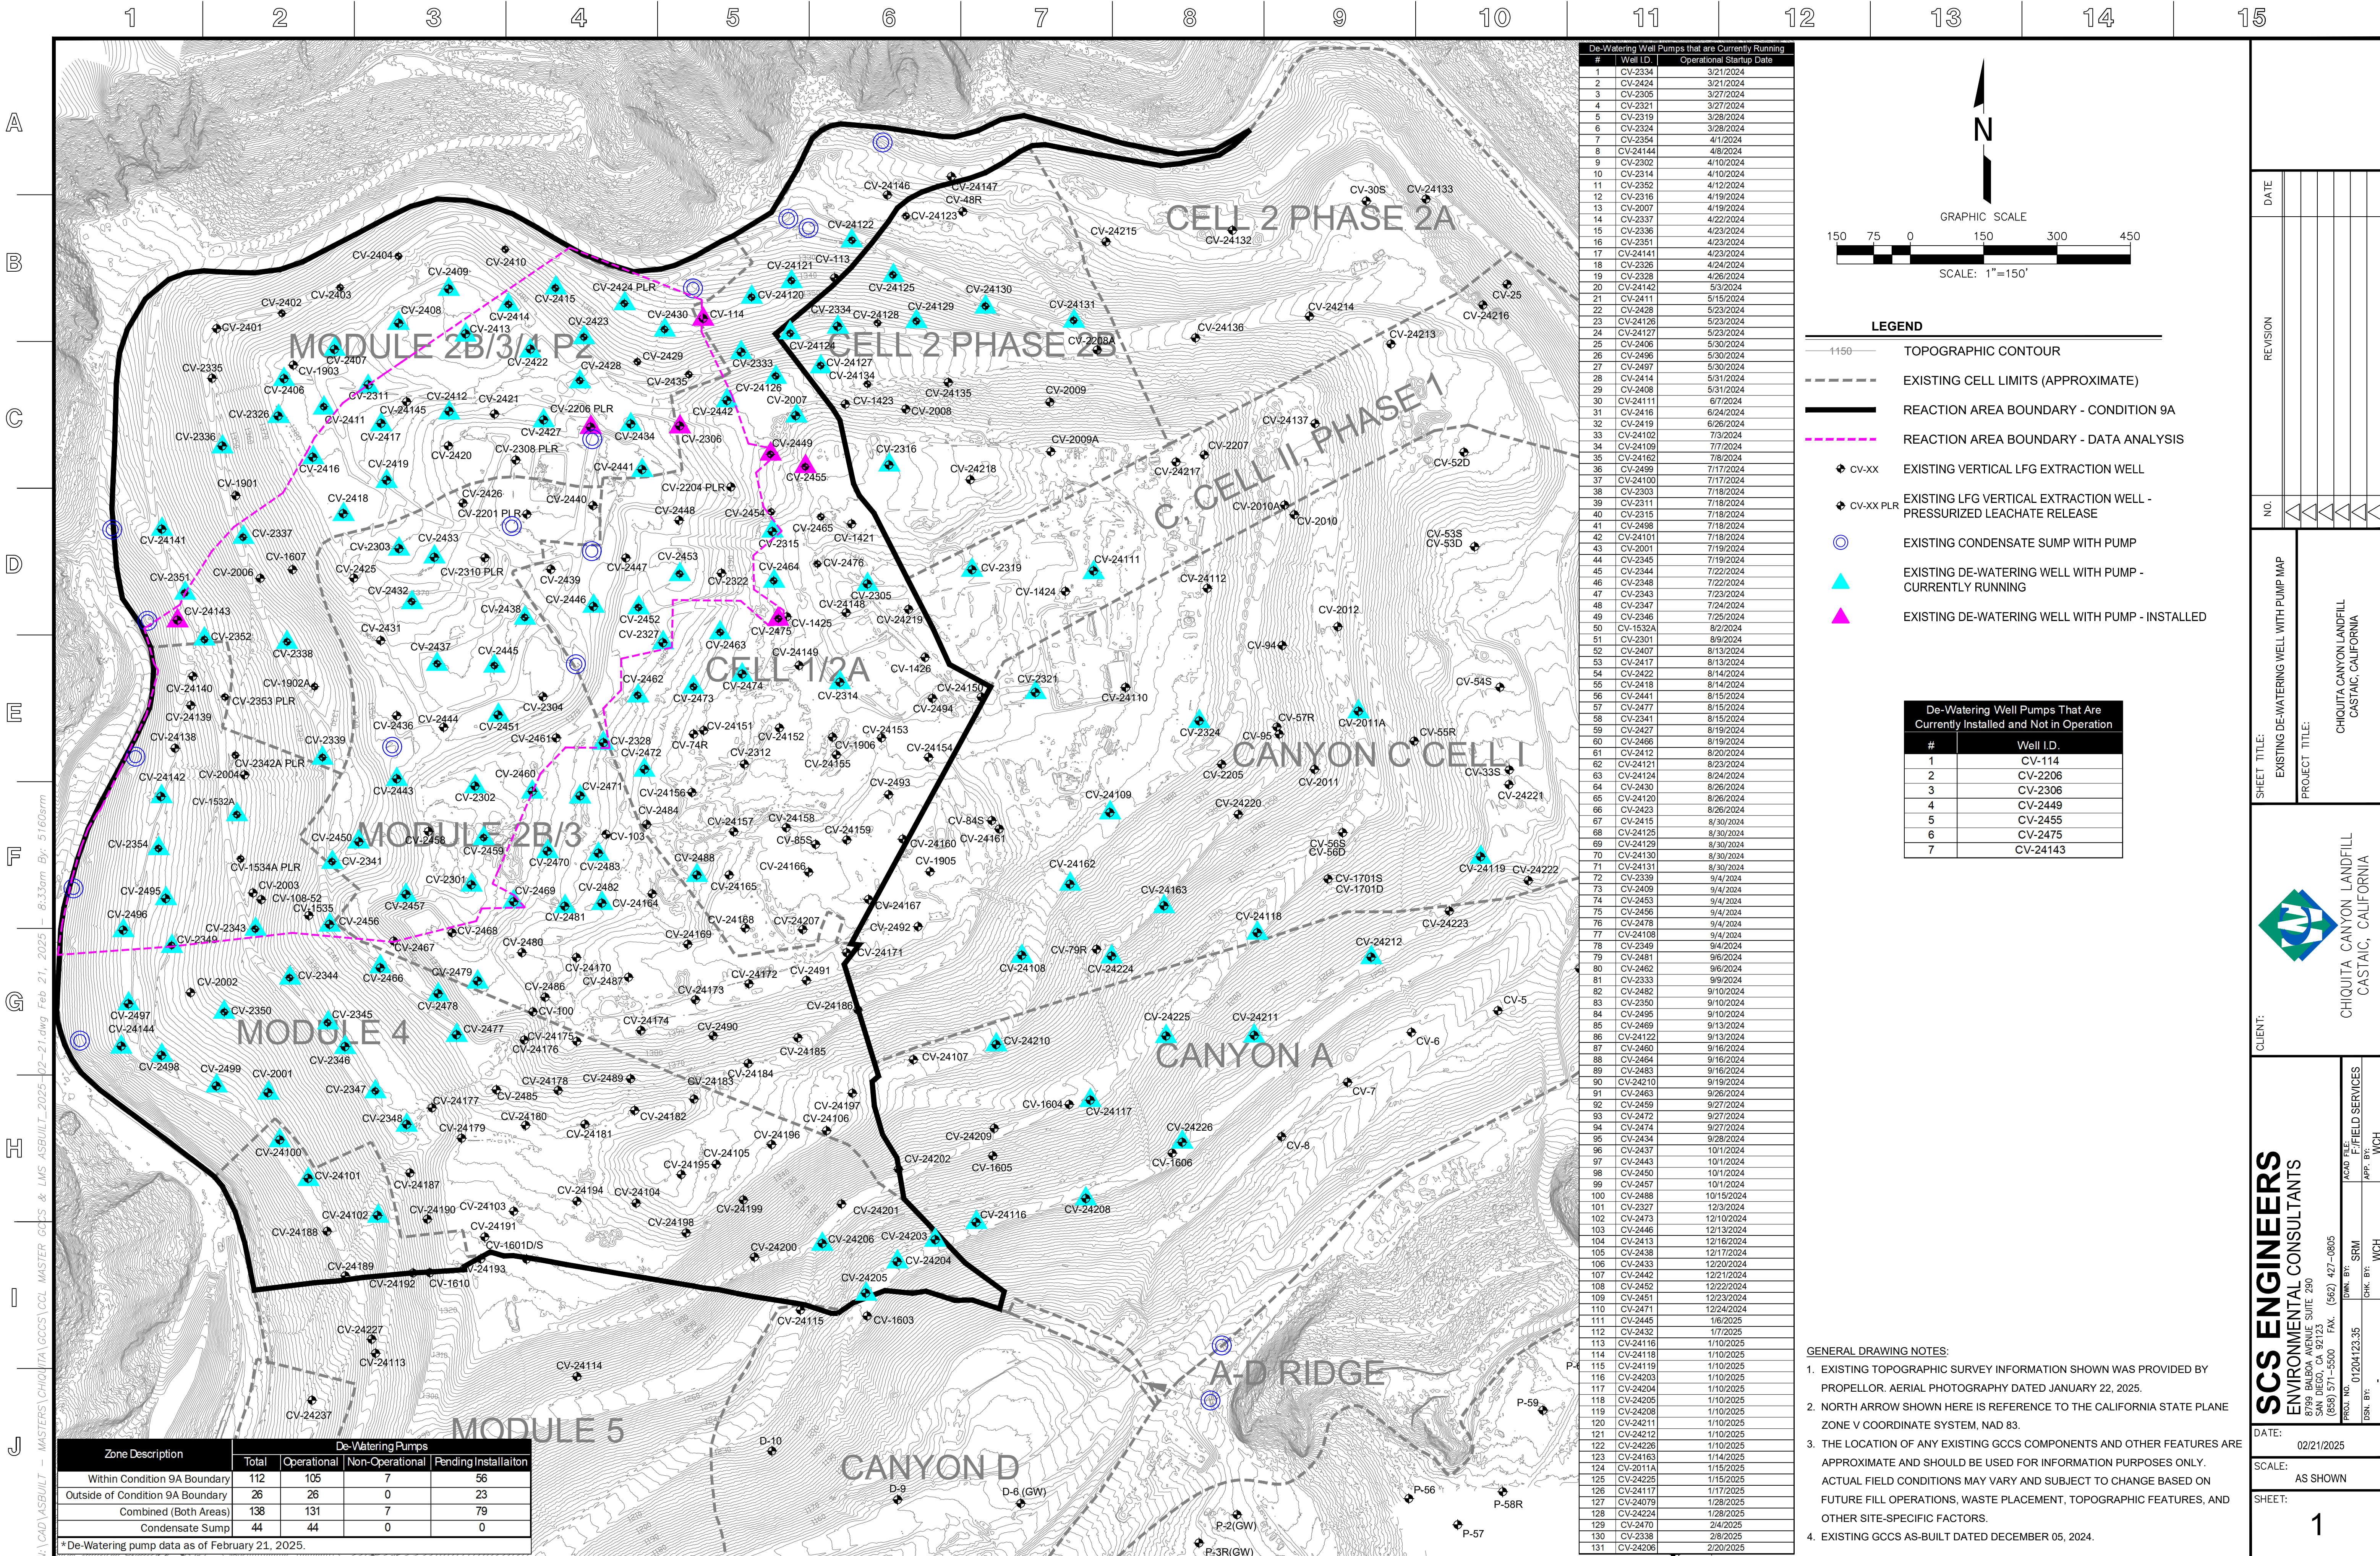

GENERAL DRAWING NOTES:

- EXISTING TOPOGRAPHIC SURVEY INFORMATION SHOWN WAS PROVIDED BY PROPELLOR. AERIAL PHOTOGRAPHY DATED JANUARY 22, 2025.
- NORTH ARROW SHOWN HERE IS REFERENCE TO THE CALIFORNIA STATE PLANE ZONE V COORDINATE SYSTEM, NAD 83.
- THE LOCATION OF ANY EXISTING GCCS COMPONENTS AND OTHER FEATURES ARE APPROXIMATE AND SHOULD BE USED FOR INFORMATION PURPOSES ONLY. ACTUAL FIELD CONDITIONS MAY VARY AND SUBJECT TO CHANGE BASED ON FUTURE FILL OPERATIONS, WASTE PLACEMENT, TOPOGRAPHIC FEATURES, AND OTHER SITE-SPECIFIC FACTORS.
- EXISTING GCCS AS-BUILT DATED DECEMBER 05, 2024.

DATE

REVISION

NO.

SHEET TITLE:
EXISTING DE-WATERING WELL WITH PUMP MAP

PROJECT TITLE:
CHICUITA CANYON LANDFILL
CASTAIC, CALIFORNIA

CLIENT:
SCS ENGINEERS
ENVIRONMENTAL CONSULTANTS
800 ALBANY AVE., SUITE 250
SAN DIEGO, CA 92123
(619) 571-5500 FAX: (619) 427-0805
PROJ. NO. 01004123-35
ACAD. FILE: F:\FIELD SERVICES
APP. BY: WCH
CHK. BY: WCH

DATE: 02/21/2025
SCALE: AS SHOWN
SHEET: 1