

**Archived:** Friday, March 7, 2025 9:53:02 AM

**From:** [Medina, Steven](#)

**Sent:** Friday, February 28, 2025 1:53:40 PM

**To:** [bchen@aqmd.gov](mailto:bchen@aqmd.gov) [ndickel@aqmd.gov](mailto:ndickel@aqmd.gov) [Christina Ojeda](#)

**Cc:** [Han, Jessie](#) [Steve Cassulo](#) [Haley, William \(Bill\)](#) [Amanda Froman](#) [Michael Hearn](#) [Nicole Ward](#)  
[Christopher.Fear@WasteConnections.com](mailto:Christopher.Fear@WasteConnections.com) [Viswanathan, Srividhya](#) [Kelly Kincella](#) [Kate Logan](#)

**Subject:** Re: Case No. 6177-4 Stipulated Order for Abatement - Weekly Pump Installation and operation update

**Importance:** Normal

**Sensitivity:** None

**Attachments:**

[Outlook-cmqkcb5k.png](#) [Outlook-o0ybx5fq.png](#) [2025 CCLF Existing De-Watering Well with Pump Map\\_2025-02-28.pdf](#)

---

[EXTERNAL SENDER: Use caution with links/attachments]

---

Hello All,

In accordance with Condition 65 of the Modified Stipulated Order, below is the summary of the installation and operation of dewatering pumps for the Chiquita Canyon Landfill.

During 02/21/2025 to 02/27/2025, Chiquita completed the installation of, and began operating during the day, zero (0) pumps in a vertical LFG extraction well for a total of one hundred and thirty-one (131) pumps operating in vertical LFG extraction wells. Please refer to the attached, up-to-date map of LFG wells with operating pumps.

During 02/28/2025 to 03/06/2025, given the number of dewatering pumps installed to date, and the maintenance associated with those pumps, Chiquita plans to install and begin operating an additional two (2) pumps in vertical LFG extraction wells in locations along the north and south slope of the reaction area. The pump installation locations for next week are subject to change due to weather and/or safety conditions.

Regards,

**STEVEN** Ruben Medina, **E.I.T.**

Associate Professional

**SCS Engineers**

3900 Kilroy Airport Way, Suite 300

Long Beach, CA 90806


858-204-4342 (c)

[5160srm@scsengineers.com](mailto:5160srm@scsengineers.com)

**Driven by Client Success**

[www.scsengineers.com](http://www.scsengineers.com)

---

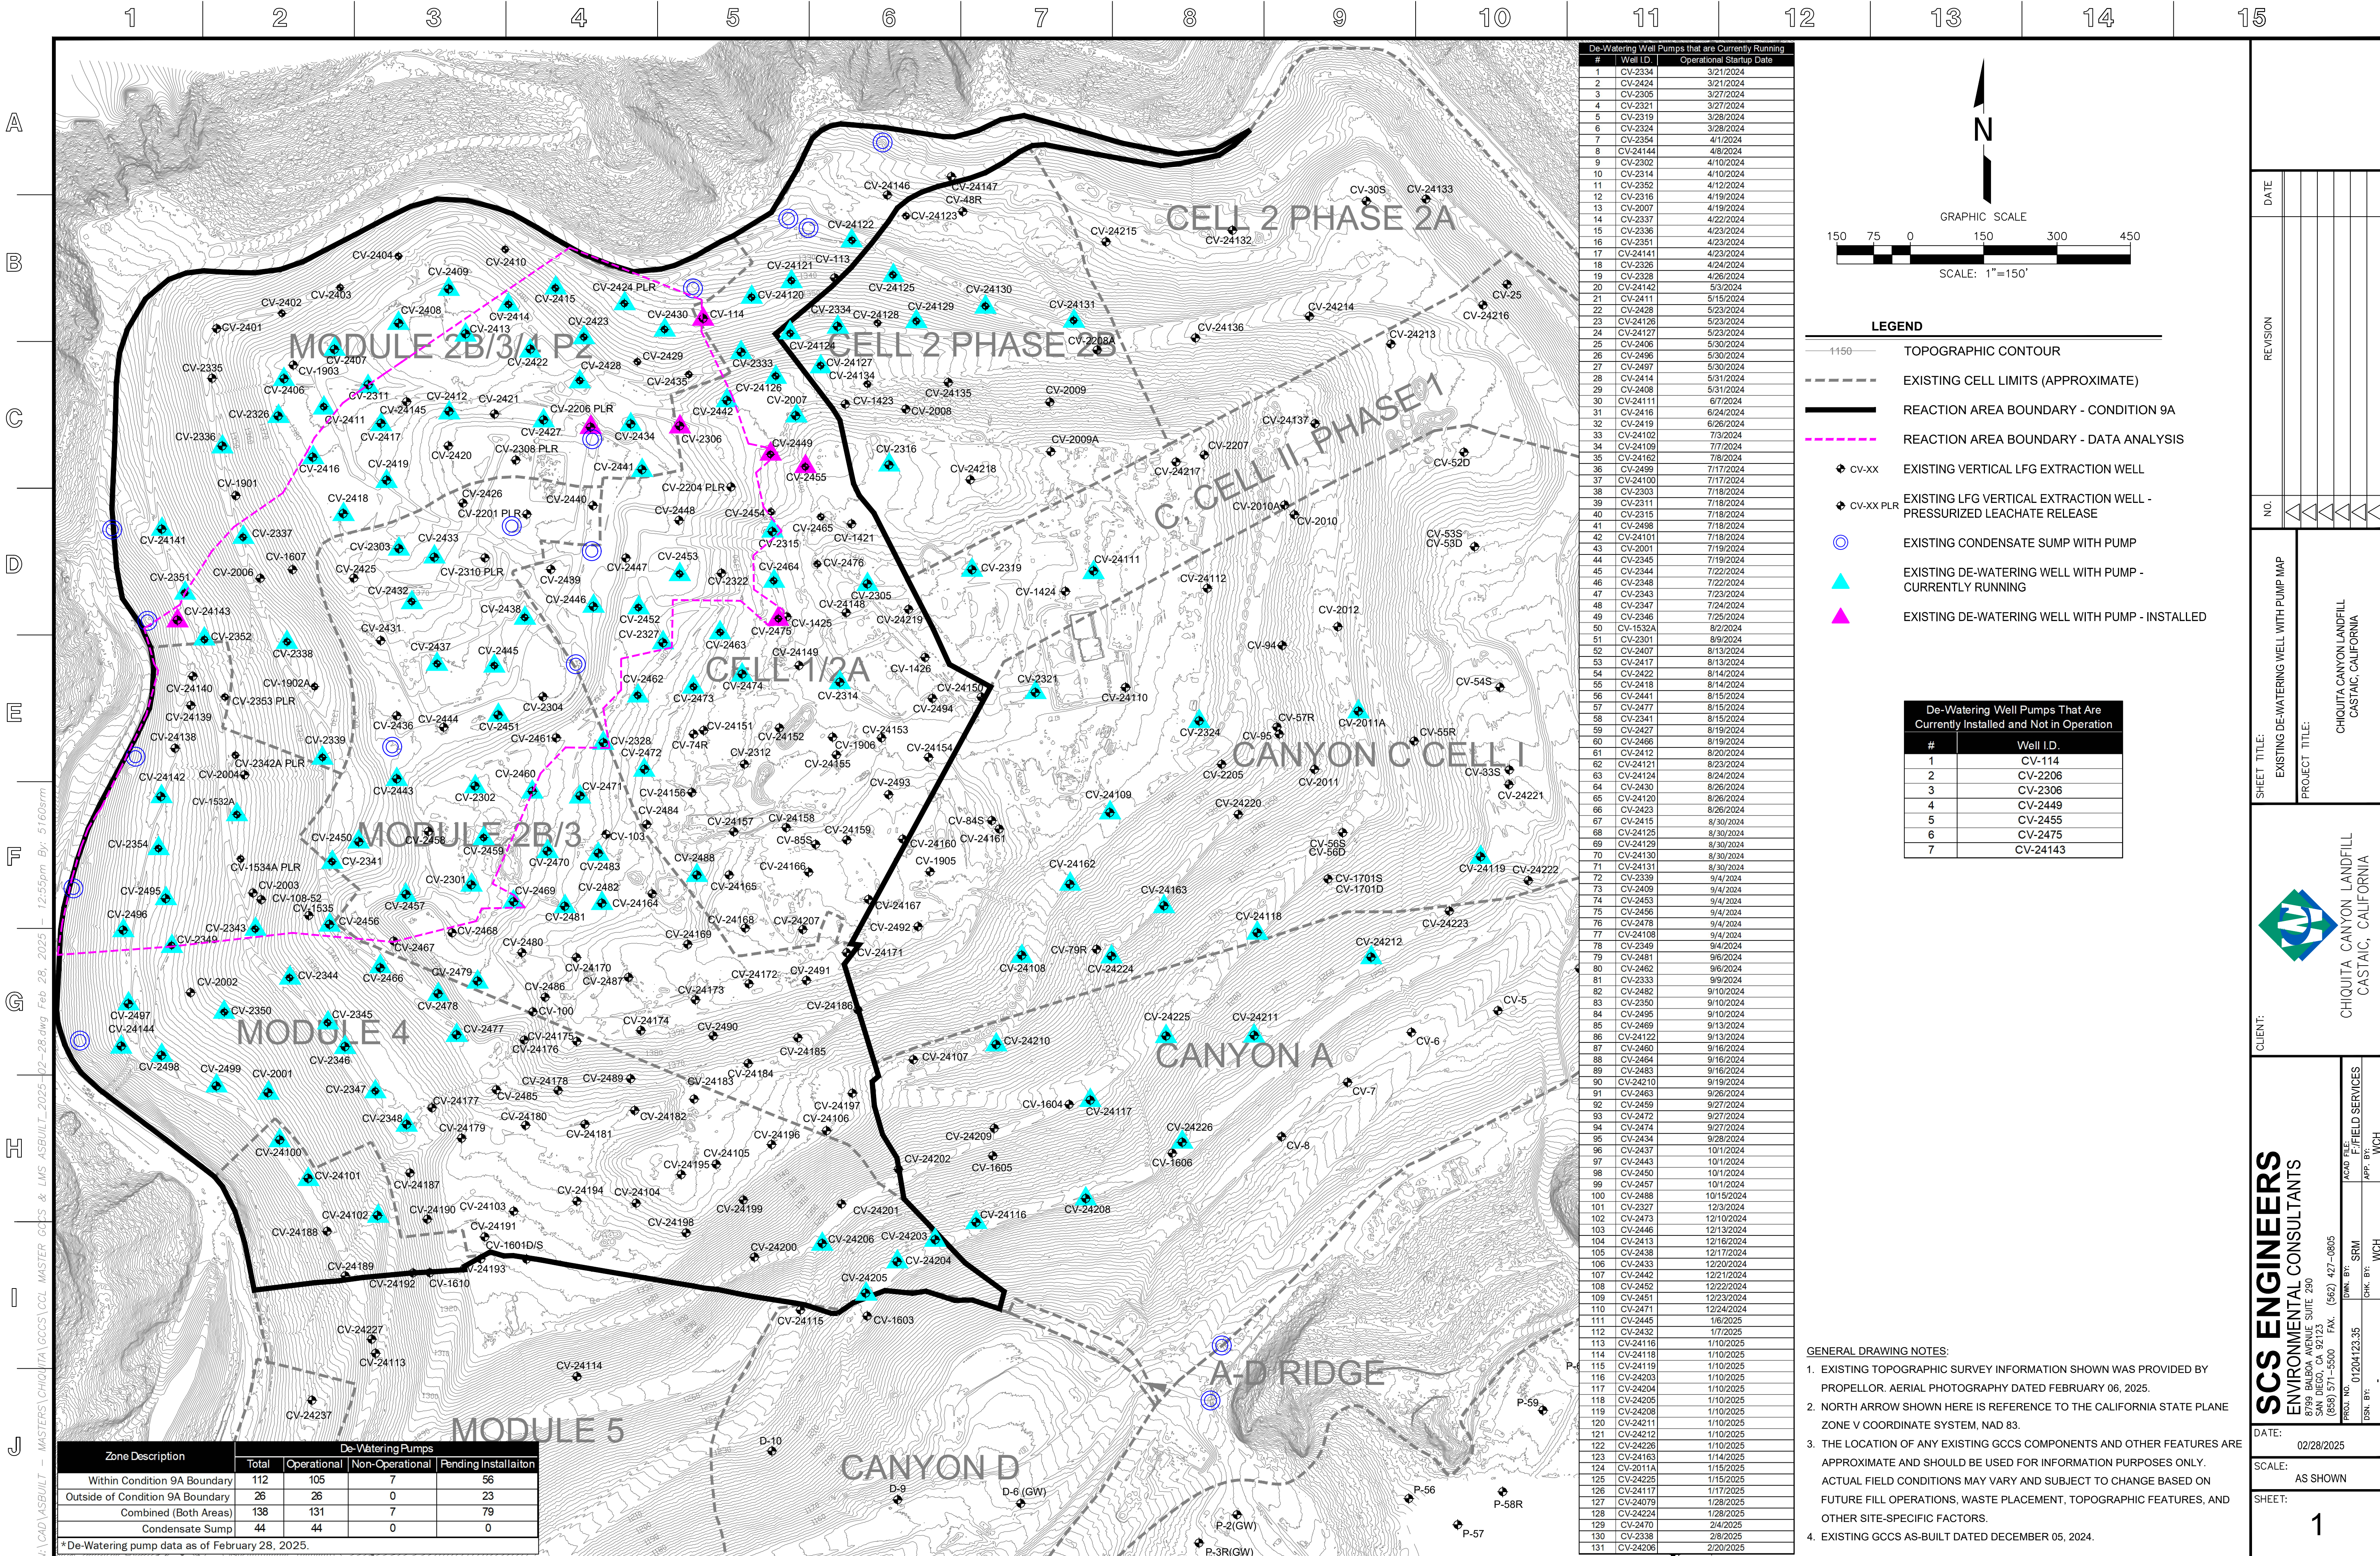

150750150300450

SCALE: 1"=150'

N

GRAPHIC SCALE

LEGEND

1150

TOPOGRAPHIC CONTOUR

---

EXISTING CELL LIMITS (APPROXIMATE)

---

REACTION AREA BOUNDARY - CONDITION 9A

---

REACTION AREA BOUNDARY - DATA ANALYSIS

CV-XX

EXISTING VERTICAL LFG EXTRACTION WELL

CV-XX PLR

EXISTING LFG VERTICAL EXTRACTION WELL - PRESSURIZED LEACHATE RELEASE

○

EXISTING CONDENSATE SUMP WITH PUMP

▲

EXISTING DE-WATERING WELL WITH PUMP - CURRENTLY RUNNING

▲

EXISTING DE-WATERING WELL WITH PUMP - INSTALLED

| De-Watering Well Pumps That Are Currently Installed and Not in Operation |           |
|--------------------------------------------------------------------------|-----------|
| #                                                                        | Well I.D. |
| 1                                                                        | CV-114    |
| 2                                                                        | CV-2206   |
| 3                                                                        | CV-2306   |
| 4                                                                        | CV-2449   |
| 5                                                                        | CV-2455   |
| 6                                                                        | CV-2475   |
| 7                                                                        | CV-24143  |

| De-Watering Well Pumps that are Currently Running |           |                          |
|---------------------------------------------------|-----------|--------------------------|
| #                                                 | Well I.D. | Operational Startup Date |
| 1                                                 | CV-2334   | 3/21/2024                |
| 2                                                 | CV-2424   | 3/21/2024                |
| 3                                                 | CV-2305   | 3/27/2024                |
| 4                                                 | CV-2321   | 3/27/2024                |
| 5                                                 | CV-2319   | 3/28/2024                |
| 6                                                 | CV-2324   | 3/28/2024                |
| 7                                                 | CV-2354   | 4/1/2024                 |
| 8                                                 | CV-24144  | 4/8/2024                 |
| 9                                                 | CV-2302   | 4/10/2024                |
| 10                                                | CV-2314   | 4/10/2024                |
| 11                                                | CV-2352   | 4/12/2024                |
| 12                                                | CV-2316   | 4/19/2024                |
| 13                                                | CV-2007   | 4/19/2024                |
| 14                                                | CV-2337   | 4/22/2024                |
| 15                                                | CV-2336   | 4/23/2024                |
| 16                                                | CV-2351   | 4/23/2024                |
| 17                                                | CV-24141  | 4/23/2024                |
| 18                                                | CV-2326   | 4/24/2024                |
| 19                                                | CV-2328   | 4/26/2024                |
| 20                                                | CV-24142  | 5/3/2024                 |
| 21                                                | CV-2411   | 5/15/2024                |
| 22                                                | CV-2428   | 5/23/2024                |
| 23                                                | CV-24126  | 5/23/2024                |
| 24                                                | CV-24127  | 5/23/2024                |
| 25                                                | CV-2408   | 5/30/2024                |
| 26                                                | CV-2406   | 5/30/2024                |
| 27                                                | CV-2497   | 5/30/2024                |
| 28                                                | CV-2414   | 5/31/2024                |
| 29                                                | CV-2408   | 5/31/2024                |
| 30                                                | CV-24111  | 6/7/2024                 |
| 31                                                | CV-2416   | 6/24/2024                |
| 32                                                | CV-2419   | 6/26/2024                |
| 33                                                | CV-24102  | 7/3/2024                 |
| 34                                                | CV-24108  | 7/7/2024                 |
| 35                                                | CV-24162  | 7/8/2024                 |
| 36                                                | CV-2499   | 7/17/2024                |
| 37                                                | CV-24100  | 7/17/2024                |
| 38                                                | CV-2303   | 7/18/2024                |
| 39                                                | CV-2311   | 7/18/2024                |
| 40                                                | CV-2315   | 7/18/2024                |
| 41                                                | CV-2498   | 7/18/2024                |
| 42                                                | CV-24101  | 7/18/2024                |
| 43                                                | CV-2001   | 7/19/2024                |
| 44                                                | CV-2345   | 7/19/2024                |
| 45                                                | CV-2344   | 7/22/2024                |
| 46                                                | CV-2348   | 7/22/2024                |
| 47                                                | CV-2343   | 7/23/2024                |
| 48                                                | CV-2347   | 7/24/2024                |
| 49                                                | CV-2346   | 7/25/2024                |
| 50                                                | CV-1532A  | 8/2/2024                 |
| 51                                                | CV-2301   | 8/9/2024                 |
| 52                                                | CV-2407   | 8/13/2024                |
| 53                                                | CV-2417   | 8/13/2024                |
| 54                                                | CV-2422   | 8/14/2024                |
| 55                                                | CV-2418   | 8/14/2024                |
| 56                                                | CV-2441   | 8/15/2024                |
| 57                                                | CV-2477   | 8/15/2024                |
| 58                                                | CV-2341   | 8/15/2024                |
| 59                                                | CV-2427   | 8/19/2024                |
| 60                                                | CV-2465   | 8/19/2024                |
| 61                                                | CV-2412   | 8/20/2024                |
| 62                                                | CV-24121  | 8/23/2024                |
| 63                                                | CV-24124  | 8/24/2024                |
| 64                                                | CV-2430   | 8/26/2024                |
| 65                                                | CV-24120  | 8/26/2024                |
| 66                                                | CV-2423   | 8/26/2024                |
| 67                                                | CV-2415   | 8/30/2024                |
| 68                                                | CV-24125  | 8/30/2024                |
| 69                                                | CV-24129  | 8/30/2024                |
| 70                                                | CV-24130  | 8/30/2024                |
| 71                                                | CV-24131  | 8/30/2024                |
| 72                                                | CV-2339   | 9/4/2024                 |
| 73                                                | CV-2409   | 9/4/2024                 |
| 74                                                | CV-2453   | 9/4/2024                 |
| 75                                                | CV-2456   | 9/4/2024                 |
| 76                                                | CV-2478   | 9/4/2024                 |
| 77                                                | CV-24108  | 9/4/2024                 |
| 78                                                | CV-2439   | 9/4/2024                 |
| 79                                                | CV-2481   | 9/6/2024                 |
| 80                                                | CV-2462   | 9/6/2024                 |
| 81                                                | CV-2333   | 9/9/2024                 |
| 82                                                | CV-2482   | 9/10/2024                |
| 83                                                | CV-2350   | 9/10/2024                |
| 84                                                | CV-2495   | 9/10/2024                |
| 85                                                | CV-2469   | 9/13/2024                |
| 86                                                | CV-24122  | 9/13/2024                |
| 87                                                | CV-2460   | 9/16/2024                |
| 88                                                | CV-2464   | 9/16/2024                |
| 89                                                | CV-2483   | 9/16/2024                |
| 90                                                | CV-24210  | 9/19/2024                |
| 91                                                | CV-2463   | 9/26/2024                |
| 92                                                | CV-2459   | 9/27/2024                |
| 93                                                | CV-2472   | 9/27/2024                |
| 94                                                | CV-2474   | 9/27/2024                |
| 95                                                | CV-2434   | 9/28/2024                |
| 96                                                | CV-2437   | 10/1/2024                |
| 97                                                | CV-2443   | 10/1/2024                |
| 98                                                | CV-2450   | 10/1/2024                |
| 99                                                | CV-2457   | 10/1/2024                |
| 100                                               | CV-2488   | 10/15/2024               |
| 101                                               | CV-2327   | 12/3/2024                |
| 102                                               | CV-2473   | 12/10/2024               |
| 103                                               | CV-2446   | 12/13/2024               |
| 104                                               | CV-2413   | 12/16/2024               |
| 105                                               | CV-2438   | 12/17/2024               |
| 106                                               | CV-2433   | 12/20/2024               |
| 107                                               | CV-2442   | 12/21/2024               |
| 108                                               | CV-2452   | 12/22/2024               |
| 109                                               | CV-2451   | 12/23/2024               |
| 110                                               | CV-2471   | 12/24/2024               |
| 111                                               | CV-2445   | 1/6/2025                 |
| 112                                               | CV-2432   | 1/7/2025                 |
| 113                                               | CV-24118  | 1/10/2025                |
| 114                                               | CV-24119  | 1/10/2025                |
| 115                                               | CV-24119  | 1/10/2025                |
| 116                                               | CV-24203  | 1/10/2025                |
| 117                                               | CV-24204  | 1/10/2025                |
| 118                                               | CV-24205  | 1/10/2025                |
| 119                                               | CV-24208  | 1/10/2025                |
| 120                                               | CV-24211  | 1/10/2025                |
| 121                                               | CV-24212  | 1/10/2025                |
| 122                                               | CV-24163  | 1/10/2025                |
| 123                                               | CV-24163  | 1/14/2025                |
| 124                                               | CV-2011A  | 1/15/2025                |
| 125                                               | CV-24225  | 1/15/2025                |
| 126                                               | CV-24117  | 1/17/2025                |
| 127                                               | CV-24079  | 1/28/2025                |
| 128                                               | CV-24224  | 1/28/2025                |
| 129                                               | CV-2470   | 2/4/2025                 |
| 130                                               | CV-2338   | 2/8/2025                 |
| 131                                               | CV-24206  | 2/20/2025                |

| Zone Description                 | De-Watering Pumps |             |                 |                      |
|----------------------------------|-------------------|-------------|-----------------|----------------------|
|                                  | Total             | Operational | Non-Operational | Pending Installation |
| Within Condition 9A Boundary     | 112               | 105         | 7               | 56                   |
| Outside of Condition 9A Boundary | 26                | 26          | 0               | 23                   |
| Combined (Both Areas)            | 138               | 131         | 7               | 79                   |
| Condensate Sump                  | 44                | 44          | 0               | 0                    |

\*De-Watering pump data as of February 28, 2025.

- GENERAL DRAWING NOTES:
- EXISTING TOPOGRAPHIC SURVEY INFORMATION SHOWN WAS PROVIDED BY PROPELLOR. AERIAL PHOTOGRAPHY DATED FEBRUARY 06, 2025.
  - NORTH ARROW SHOWN HERE IS REFERENCE TO THE CALIFORNIA STATE PLANE ZONE V COORDINATE SYSTEM, NAD 83.
  - THE LOCATION OF ANY EXISTING GCCS COMPONENTS AND OTHER FEATURES ARE APPROXIMATE AND SHOULD BE USED FOR INFORMATION PURPOSES ONLY. ACTUAL FIELD CONDITIONS MAY VARY AND SUBJECT TO CHANGE BASED ON FUTURE FILL OPERATIONS, WASTE PLACEMENT, TOPOGRAPHIC FEATURES, AND OTHER SITE-SPECIFIC FACTORS.
  - EXISTING GCCS AS-BUILT DATED DECEMBER 05, 2024.

DATE

REVISION

NO.

SHEET TITLE:  
EXISTING DE-WATERING WELL WITH PUMP MAP

PROJECT TITLE:  
CHIQUITA CANYON LANDFILL  
CASTAIC, CALIFORNIA

CLIENT:

SCS ENGINEERS  
ENVIRONMENTAL CONSULTANTS  
2500 ALBANY AVE., SUITE 250  
SAN DIEGO, CA 92125  
(619) 571-5500 FAX: (619) 427-0805

DATE:

02/28/2025

SCALE:

AS SHOWN

SHEET:

1

ACAD FILE: F:\FIELD SERVICES

APP. BY: WCH

CHK. BY: WCH