

Archivado: Viernes 21 de marzo de 2025 8:49:56 AM

De: [Jones, Art](#)

Enviado: Miércoles 19 de marzo de 2025 7:08:21 AM

Para: [Baitong Chen](#) [Kim, James Kim](#), [Jenny](#)

Cc: [Steve Cassulo](#) [Fong, Cornelius Sullivan](#), [Pat Stephens](#), [Gabrielle Viswanathan](#), [Srividhya Han](#), [Jessie Kelly Kincella](#) [Nathaniel Dickel](#) [Nicole Ward](#) [Mike Calleja](#) [Dylan Smith](#) [Amanda Froman](#) [Haley, William \(Bill\)](#) [Kate Logan](#) [Ambriz, Antonio Johnson](#), [Cage](#)

Asunto: Ref.: Solicitud de Información Adicional para ANs 647475, 647476 y 647477, Código de Centro 119319

Importancia: Normal

Sensibilidad: Ninguna

Adjunto:

[CCL MASTER EXISTING GCCS MAP ONLY_2025-03-18-36x48 - GCCS MAP.pdf](#);

[REMITENTE EXTERNO: Tenga precaución con los enlaces/adjuntos]

Buenos Días Chris

Se encuentra adjunta la última actualización conforme a obra para Chiquita, para su uso.

No verá el segundo TOX en este plano debido a que todavía no está operativo.

Le deseo un buen día

Atentamente,

Art



Arthur E Jones Jr
Gerente de la Región Sudoeste del Desierto/Vicepresidente de
SCS Engineers
Field Services Group
6 Sunset Way Suite 101
Henderson, NV 89014
Teléfono de la Oficina 209-702-6228
Móvil 209-345-2062

Email: ajones@scsengineers.com
Sitio web: www.scsengineers.com
Dirigidos por el Éxito de los Clientes



Este e-mail puede contener información confidencial y está previsto para uso del destinatario y/o sus representantes previstos únicamente. Si no es el destinatario previsto, por favor, no transmita, copie, divulgue, guarde ni utilice esta comunicación de ninguna manera. Si recibió este mensaje por error, por favor, informe al remitente inmediatamente y elimine este mensaje de forma permanente de su computadora. SCS Engineers no asume ninguna responsabilidad por el contenido de este e-mail no por las consecuencias de ninguna acción tomada en base a la información proporcionada.
– SCS Engineers

N:\CAD\ASBUILT - MASTERS\CHICUITA\GCCS\LOC MASTER EXISTING GCCS MAP ONLY 2025-03-18.dwg Mar 18, 2025 - 6:47pm By: 5160arm

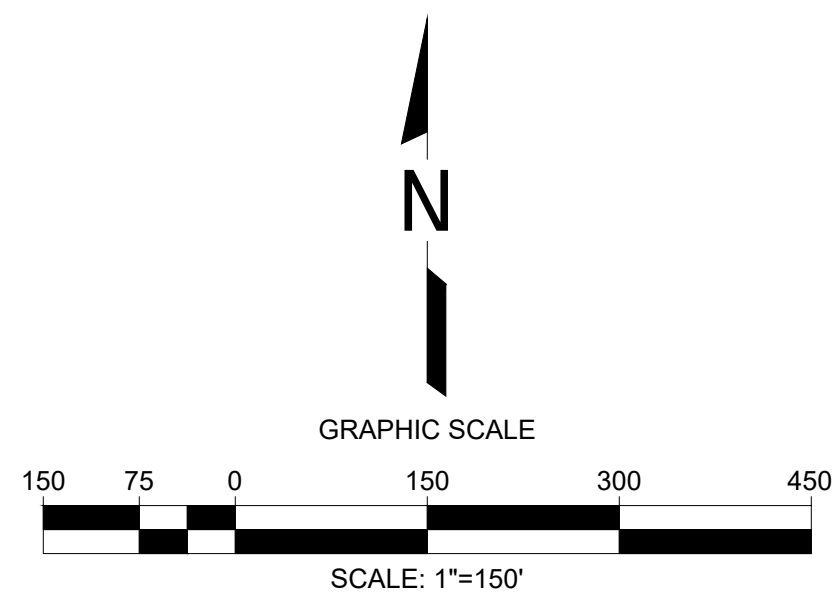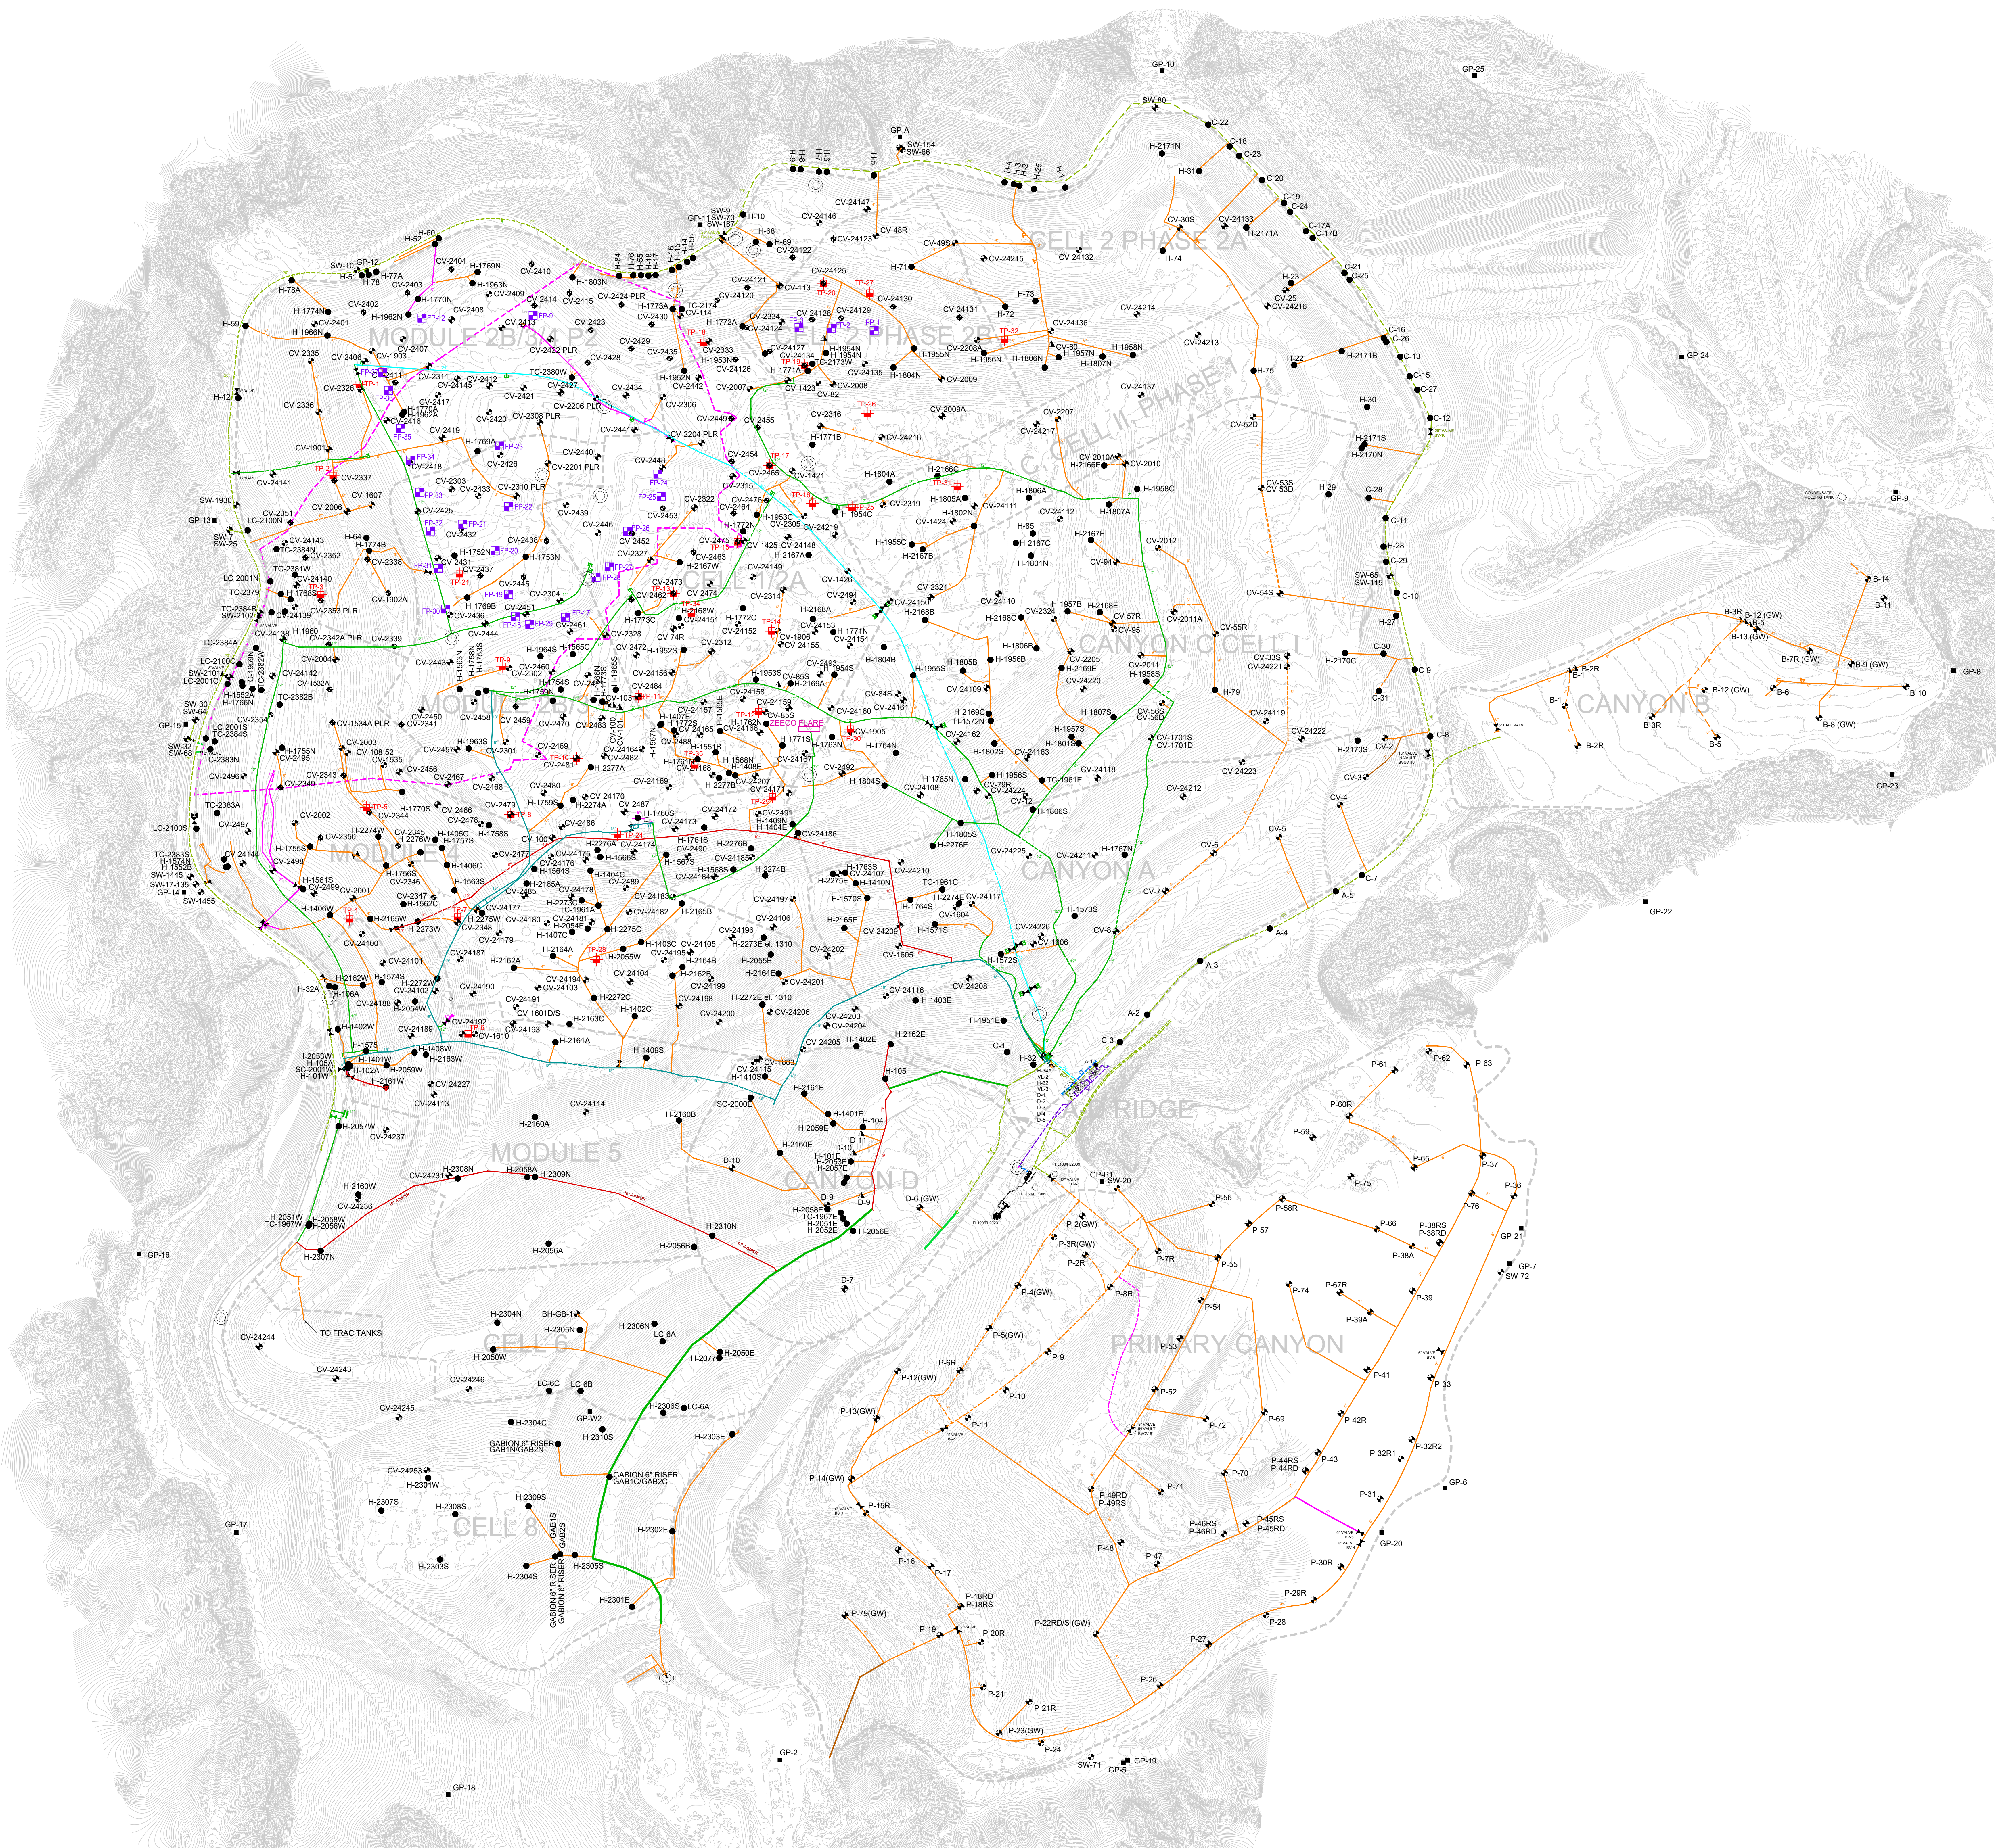

- LEGEND**
- TOPOGRAPHIC CONTOUR
 - EXISTING CELL LIMITS (APPROXIMATE)
 - EXISTING LFG VERTICAL EXTRACTION WELL
 - EXISTING LFG VERTICAL EXTRACTION WELL - PRESSURIZED LEACHATE RELEASE
 - EXISTING GABION LFG COLLECTOR WELL
 - EXISTING SOIL VAPOR EXTRACTION WELL
 - EXISTING LFG VERTICAL EXTRACTION WELL BELOW-GRADE
 - EXISTING SURFACE COLLECTOR WELLHEAD
 - EXISTING HORIZONTAL WELLS
 - EXISTING REMOTE VERTICAL WELLHEAD
 - EXISTING PERIMETER MIGRATION PROBE
 - EXISTING TEMPERATURE PROBE
 - EXISTING ISOLATION VALVE
 - EXISTING ACTIVATED CARBON VESSEL
 - EXISTING CONDENSATE SUMP
 - EXISTING 36\"/>

- GENERAL DRAWING NOTES:**
- EXISTING TOPOGRAPHIC SURVEY INFORMATION SHOWN WAS PROVIDED BY PROPELLOR, AERIAL PHOTOGRAPHY DATED FEBRUARY 26, 2025.
 - NORTH ARROW SHOWN HERE IS REFERENCE TO THE CALIFORNIA STATE PLANE ZONE V COORDINATE SYSTEM, NAD 83.
 - THE LOCATION OF ANY EXISTING PIPING, VALVES, TIE-IN LOCATIONS AND OTHER FEATURES ARE APPROXIMATE AND SHOULD BE USED FOR INFORMATION PURPOSES ONLY. ACTUAL FIELD CONDITIONS MAY VARY AND SUBJECT TO CHANGE BASED ON FUTURE FILL OPERATIONS, WASTE PLACEMENT, TOPOGRAPHIC FEATURES, AND OTHER SITE-SPECIFIC FACTORS.
 - EXISTING GCCS AS-BUILT DATED MARCH 18, 2025.

SCS ENGINEERS ENVIRONMENTAL CONSULTANTS 10000 BUSH BLVD., SUITE 100 DALLAS, TEXAS 75243 TEL: (972) 252-8844 FAX: (972) 252-8844	DATE: 03/18/2025	SCALE: AS SHOWN
	PROJECT TITLE: CHICUITA CANYON LANDFILL CASTAIC, CALIFORNIA	
CLIENT: CHICUITA CANYON LANDFILL CASTAIC, CALIFORNIA	SHEET TITLE: EXISTING GCCS MAP	
DESIGNER: JMSRM	CHECKER: JMSRM	DATE: 03/18/2025
DATE: 03/18/2025	SCALE: AS SHOWN	1 of 1