

Archivado: Viernes 9 de mayo de 2025 9:56:38 AM

De: [Medina, Steven](#)

Enviado: Viernes 2 de mayo de 2025 3:04:45 PM

Para: bchen@aqmd.gov ndickel@aqmd.gov [Christina Ojeda](#)

Cc: [Han, Jessie](#) [Steve Cassulo](#) [Haley, William \(Bill\)](#) [Amanda Froman](#) [Michael Hearn](#) [Nicole Ward](#) Christopher.Fear@WasteConnections.com [Viswanathan, Srividhya](#) [Kate Logan](#) [Mark.Adams](#)

Asunto: Ref.: Orden de Depuración Estipulada del Caso No. 6177-4 - Actualización sobre la Instalación y Operación Semanal de las Bombas

Importancia: Normal

Sensibilidad: Ninguna

Adjunto:

[Outlook-cmqkcb5k.png](#); [Outlook-o0ybx5fq.png](#); [Outlook-jtlptmqi.png](#); [Outlook-jtawij2i.png](#); [Outlook-3hw0er4l.png](#); [Outlook-3rgztszi.png](#); [Outlook-25rflldvy.png](#); [Outlook-p30v2ukt.png](#); [Outlook-2qny0dk4.png](#); [Outlook-jscwrblw.png](#); [Outlook-fxfn123c.png](#); [Outlook-samhi5se.png](#); 2025 CCLF Existing De-Watering Well with Pump Map_2025-05-02.pdf;

[REMITENTE EXTERNO: Tenga precaución con los enlaces/adjuntos]

Todos,

Según la Condición 65 de la Orden Estipulada Modificada, a continuación se encuentra el resumen de la instalación y operación de las bombas de desagüe para el Vertedero de Chiquita Canyon.

Durante el período que transcurrió desde el 25/04/2025 hasta el 01/05/2025, Chiquita completó la instalación y comenzó a operar durante el día cuatro (4) bombas en pozos verticales de extracción de LFG dando un total de ciento cincuenta y una (151) bombas operado en pozos verticales de extracción de LFG. Por favor, consulte el mapa actualizado adjunto de los pozos de LFG con bombas operando.

Durante el período que va del 02/05/2025 hasta el 08/05/2025, dada la cantidad de bombas de desagüe instaladas hasta la fecha y el mantenimiento asociado a esas bombas, Chiquita tiene planeado instalar y comenzar a operar otras dos (2) bombas en pozos verticales de extracción de LFG en ubicaciones a lo largo de la pendiente norte y sur de la zona reactiva. Las ubicaciones de las instalaciones de las bombas para la semana que viene están sujetas a cambios debido a las condiciones climáticas y/o de seguridad.

Atentamente,

STEVEN Rubén Medina, E.I.T.

Personal Profesional

SCS Engineers

3900 Kilroy Airport Way, Suite 300

Long Beach, CA 90806


858-204-4342 (c)

5160srm@scsengineers.com

Dirigidos por el Éxito de los Clientes

www.scsengineers.com

□

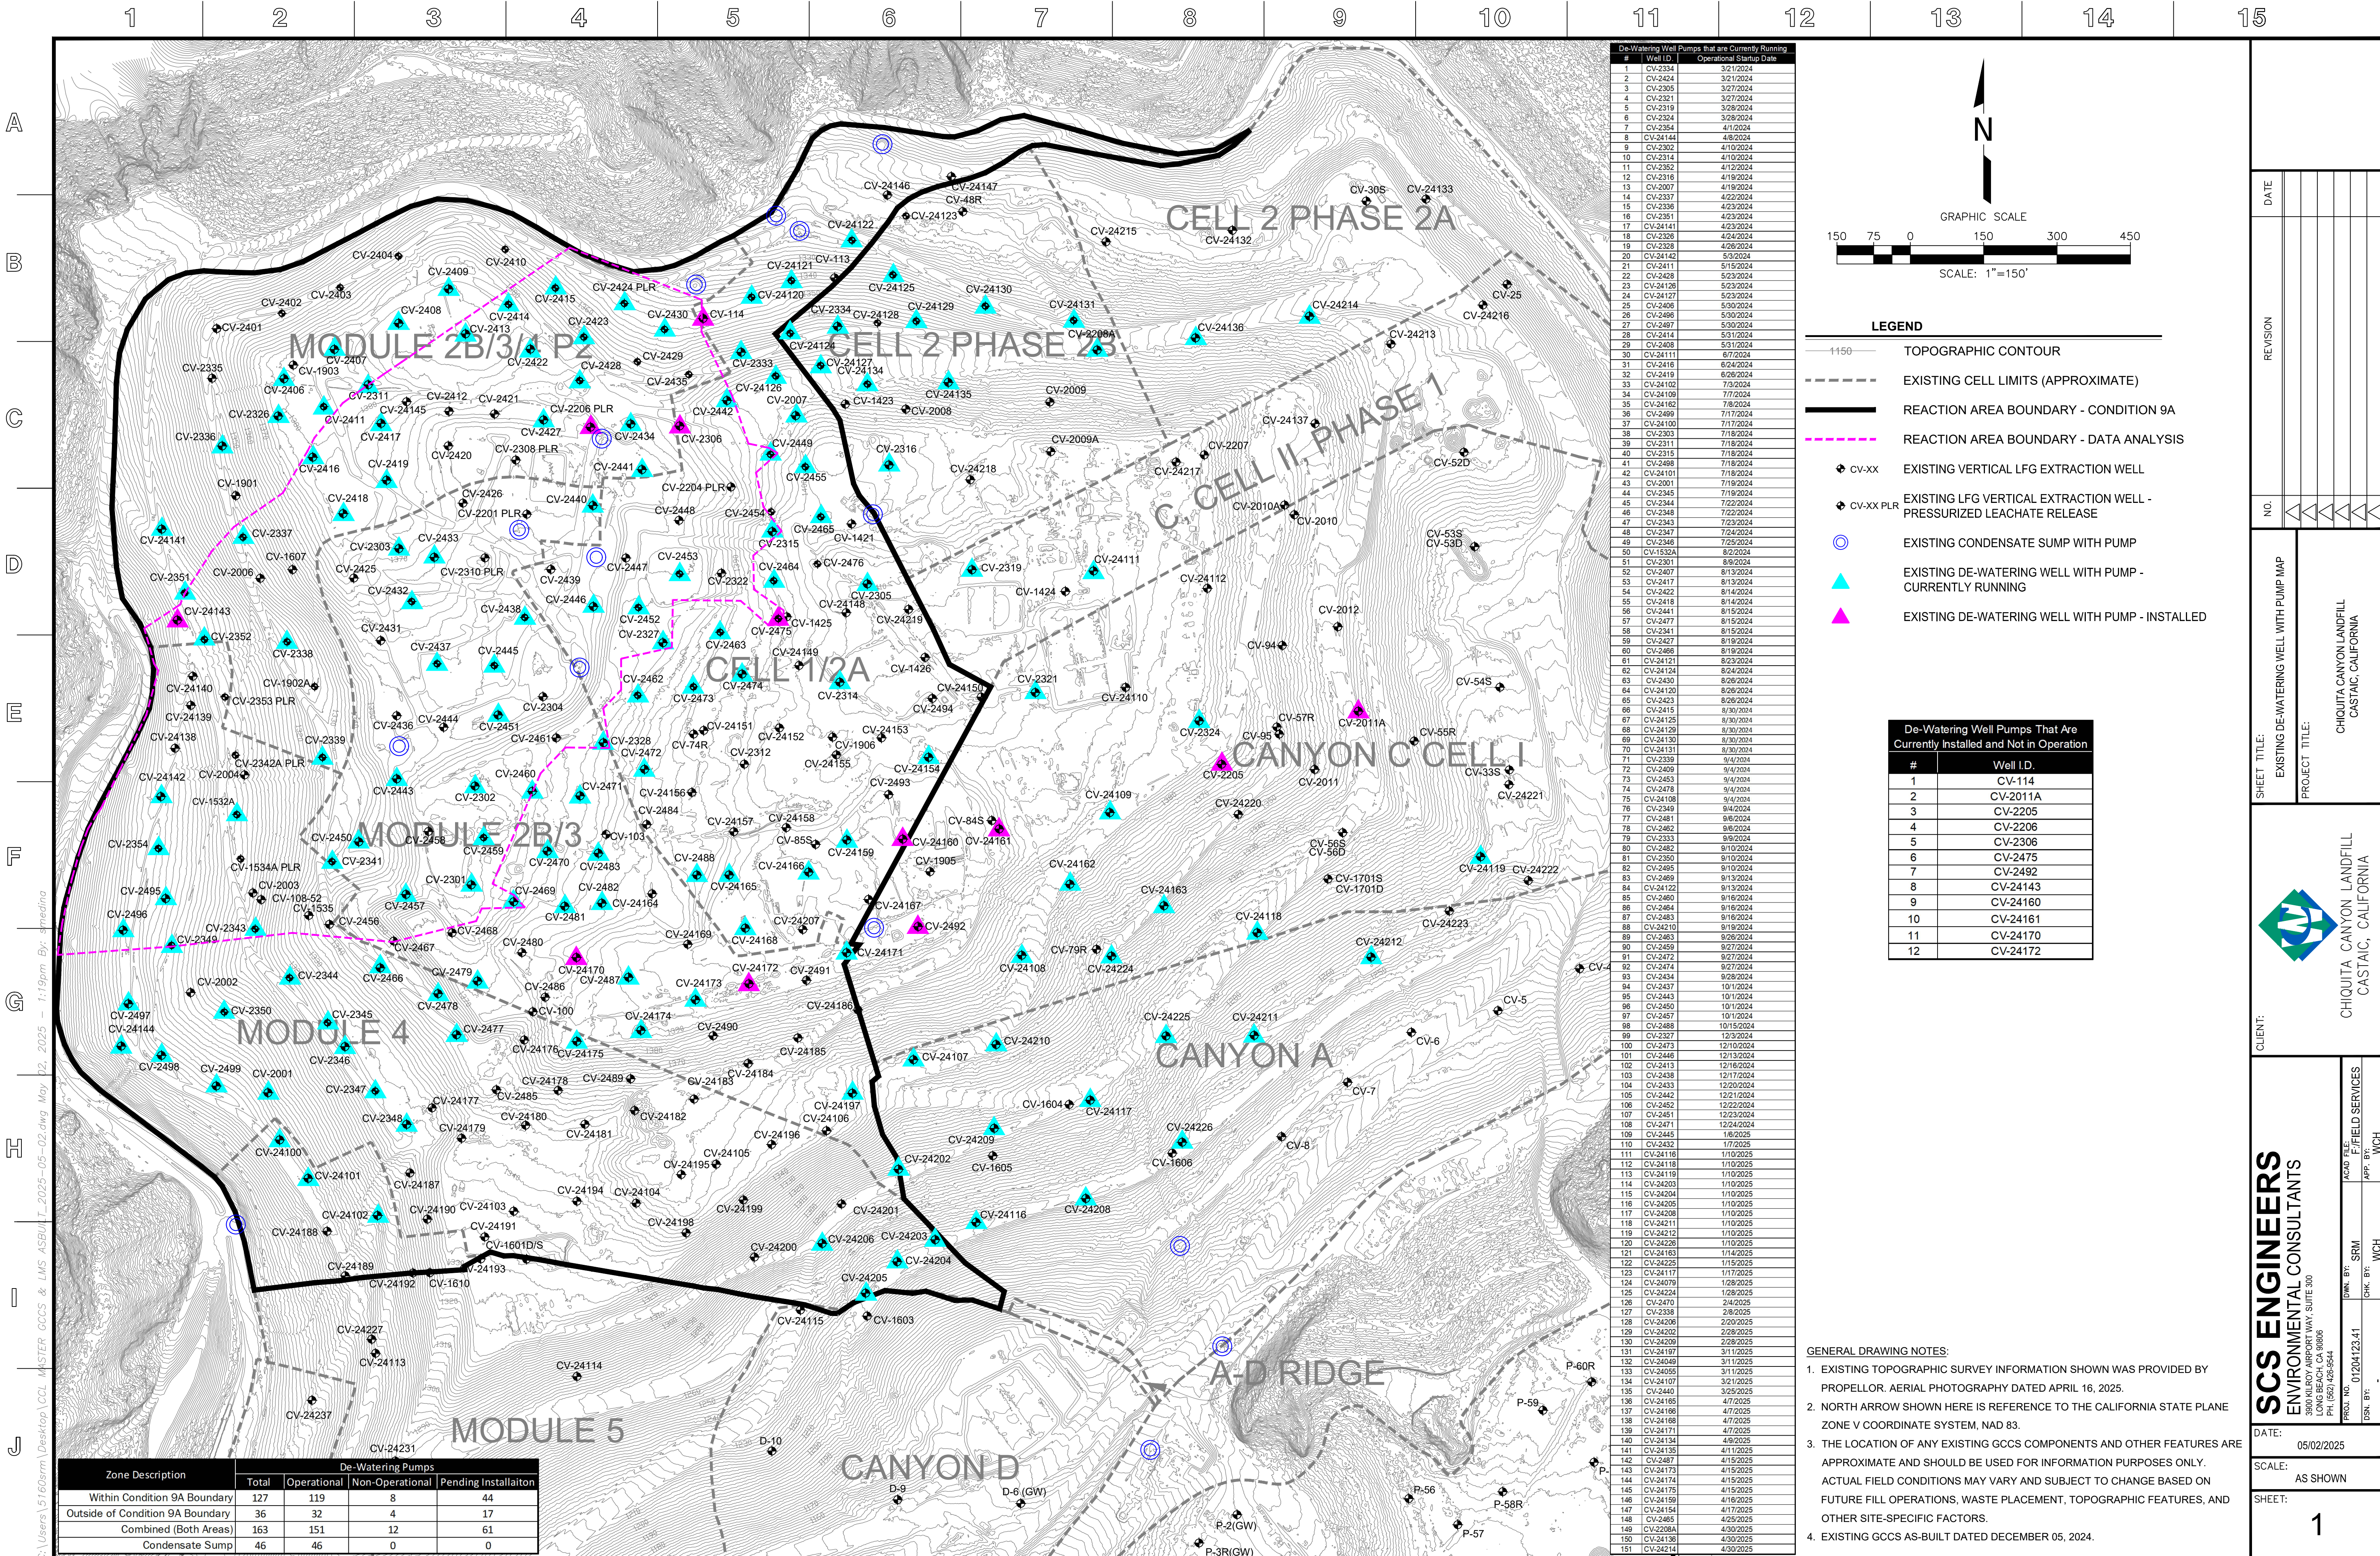

De-Watering Well Pumps That are Currently Running	
Well I.D.	Operational Startup Date
1 CV-2334	3/21/2024
2 CV-2424	3/21/2024
3 CV-2305	3/27/2024
4 CV-2321	3/27/2024
5 CV-2319	3/28/2024
6 CV-2324	3/28/2024
7 CV-2354	4/1/2024
8 CV-24144	4/8/2024
9 CV-2302	4/10/2024
10 CV-2314	4/10/2024
11 CV-2352	4/12/2024
12 CV-2316	4/18/2024
13 CV-2007	4/19/2024
14 CV-2337	4/22/2024
15 CV-2336	4/23/2024
16 CV-2351	4/23/2024
17 CV-24141	4/23/2024
18 CV-2326	4/24/2024
19 CV-2328	4/26/2024
20 CV-24142	5/3/2024
21 CV-24111	5/15/2024
22 CV-2428	5/23/2024
23 CV-24126	5/23/2024
24 CV-24127	5/23/2024
25 CV-2406	5/30/2024
26 CV-2408	5/30/2024
27 CV-2497	5/30/2024
28 CV-2414	5/31/2024
29 CV-2408	5/31/2024
30 CV-24111	6/7/2024
31 CV-2416	6/28/2024
32 CV-2419	6/28/2024
33 CV-24102	7/9/2024
34 CV-24109	7/10/2024
35 CV-24162	7/8/2024
36 CV-2499	7/17/2024
37 CV-24100	7/17/2024
38 CV-2303	7/18/2024
39 CV-2311	7/18/2024
40 CV-2315	7/18/2024
41 CV-2498	7/18/2024
42 CV-24101	7/18/2024
43 CV-2001	7/18/2024
44 CV-2345	7/19/2024
45 CV-2344	7/22/2024
46 CV-2348	7/22/2024
47 CV-2303	7/23/2024
48 CV-2347	7/24/2024
49 CV-2346	7/25/2024
50 CV-1532A	8/2/2024
51 CV-2301	8/6/2024
52 CV-2407	8/13/2024
53 CV-2417	8/13/2024
54 CV-2422	8/14/2024
55 CV-2418	8/14/2024
56 CV-2441	8/15/2024
57 CV-2477	8/15/2024
58 CV-2341	8/15/2024
59 CV-2427	8/19/2024
60 CV-2466	8/19/2024
61 CV-24121	8/23/2024
62 CV-24124	8/24/2024
63 CV-2430	8/26/2024
64 CV-24120	8/26/2024
65 CV-2423	8/26/2024
66 CV-2415	8/30/2024
67 CV-24125	8/30/2024
68 CV-24129	8/30/2024
69 CV-24130	8/30/2024
70 CV-24131	8/30/2024
71 CV-2339	9/4/2024
72 CV-2409	9/4/2024
73 CV-2453	9/4/2024
74 CV-2478	9/4/2024
75 CV-24108	9/4/2024
76 CV-2349	9/4/2024
77 CV-2481	9/6/2024
78 CV-2462	9/6/2024
79 CV-2333	9/9/2024
80 CV-2482	9/10/2024
81 CV-2350	9/10/2024
82 CV-2465	9/10/2024
83 CV-2469	9/13/2024
84 CV-24122	9/13/2024
85 CV-2460	9/16/2024
86 CV-2464	9/16/2024
87 CV-2463	9/16/2024
88 CV-24210	9/19/2024
89 CV-2463	9/26/2024
90 CV-2459	9/27/2024
91 CV-2472	9/27/2024
92 CV-2474	9/27/2024
93 CV-2434	9/28/2024
94 CV-2437	10/1/2024
95 CV-2443	10/1/2024
96 CV-2450	10/1/2024
97 CV-2457	10/1/2024
98 CV-2488	10/15/2024
99 CV-2327	12/3/2024
100 CV-2473	12/10/2024
101 CV-2446	12/13/2024
102 CV-2413	12/16/2024
103 CV-2438	12/17/2024
104 CV-2433	12/20/2024
105 CV-2442	12/21/2024
106 CV-2452	12/22/2024
107 CV-2451	12/23/2024
108 CV-2471	12/24/2024
109 CV-2445	1/6/2025
110 CV-2432	1/7/2025
111 CV-24116	1/10/2025
112 CV-24118	1/10/2025
113 CV-24119	1/10/2025
114 CV-24203	1/10/2025
115 CV-24204	1/10/2025
116 CV-24205	1/10/2025
117 CV-24208	1/10/2025
118 CV-24211	1/10/2025
119 CV-24212	1/10/2025
120 CV-24226	1/10/2025
121 CV-24163	1/14/2025
122 CV-24225	1/15/2025
123 CV-24117	1/17/2025
124 CV-24079	1/28/2025
125 CV-24224	1/28/2025
126 CV-2470	2/4/2025
127 CV-2338	2/8/2025
128 CV-24206	2/20/2025
129 CV-24202	2/28/2025
130 CV-24209	2/28/2025
131 CV-24197	3/11/2025
132 CV-24049	3/11/2025
133 CV-24055	3/11/2025
134 CV-24107	3/21/2025
135 CV-2440	3/25/2025
136 CV-24165	4/7/2025
137 CV-24166	4/7/2025
138 CV-24168	4/7/2025
139 CV-24171	4/7/2025
140 CV-24134	4/9/2025
141 CV-24135	4/11/2025
142 CV-2487	4/15/2025
143 CV-24173	4/15/2025
144 CV-24174	4/15/2025
145 CV-24175	4/15/2025
146 CV-24159	4/16/2025
147 CV-24154	4/17/2025
148 CV-2465	4/25/2025
149 CV-2208A	4/30/2025
150 CV-24136	4/30/2025
151 CV-24214	4/30/2025

GRAPHIC SCALE

150 75 0 150 300 450

SCALE: 1"=150'

LEGEND

1150 TOPOGRAPHIC CONTOUR

--- EXISTING CELL LIMITS (APPROXIMATE)

--- REACTION AREA BOUNDARY - CONDITION 9A

--- REACTION AREA BOUNDARY - DATA ANALYSIS

CV-XX EXISTING VERTICAL LFG EXTRACTION WELL

CV-XX PLR EXISTING LFG VERTICAL EXTRACTION WELL - PRESSURIZED LEACHATE RELEASE

EXISTING CONDENSATE SUMP WITH PUMP

EXISTING DE-WATERING WELL WITH PUMP - CURRENTLY RUNNING

EXISTING DE-WATERING WELL WITH PUMP - INSTALLED

De-Watering Well Pumps That Are Currently Installed and Not in Operation	
#	Well I.D.
1	CV-114
2	CV-2011A
3	CV-2205
4	CV-2206
5	CV-2306
6	CV-2475
7	CV-2492
8	CV-24143
9	CV-24160
10	CV-24161
11	CV-24170
12	CV-24172

Zone Description	De-Watering Pumps			
	Total	Operational	Non-Operational	Pending Installation
Within Condition 9A Boundary	127	119	8	44
Outside of Condition 9A Boundary	36	32	4	17
Combined (Both Areas)	163	151	12	61
Condensate Sump	46	46	0	0

GENERAL DRAWING NOTES:

- EXISTING TOPOGRAPHIC SURVEY INFORMATION SHOWN WAS PROVIDED BY PROPELLOR. AERIAL PHOTOGRAPHY DATED APRIL 16, 2025.
- NORTH ARROW SHOWN HERE IS REFERENCE TO THE CALIFORNIA STATE PLANE ZONE V COORDINATE SYSTEM, NAD 83.
- THE LOCATION OF ANY EXISTING GCCS COMPONENTS AND OTHER FEATURES ARE APPROXIMATE AND SHOULD BE USED FOR INFORMATION PURPOSES ONLY. ACTUAL FIELD CONDITIONS MAY VARY AND SUBJECT TO CHANGE BASED ON FUTURE FILL OPERATIONS, WASTE PLACEMENT, TOPOGRAPHIC FEATURES, AND OTHER SITE-SPECIFIC FACTORS.
- EXISTING GCCS AS-BUILT DATED DECEMBER 05, 2024.

SHEET TITLE: EXISTING DE-WATERING WELL WITH PUMP MAP

PROJECT TITLE: CHIQUITA CANYON LANDFILL CASTAIC, CALIFORNIA

CLIENT: SCS ENGINEERS ENVIRONMENTAL CONSULTANTS
1500 N. CALIFORNIA AVE., SUITE 300
LONG BEACH, CA 90806
PH: (562) 426-9544

DATE: 05/02/2025

SCALE: AS SHOWN

SHEET: 1

CHIQUITA CANYON LANDFILL CASTAIC, CALIFORNIA

CHIQUITA CANYON LANDFILL CASTAIC, CALIFORNIA

DATE: 05/02/2025

SCALE: AS SHOWN

SHEET: 1