

**Archivado:** Jueves 29 de mayo de 2025 10:13:01 AM

**De:** [Medina, Steven](#)

**Enviado:** Viernes 23 de mayo de 2025 3:34:33 PM

**Para:** [bchen@aqmd.gov](mailto:bchen@aqmd.gov) [ndickel@aqmd.gov](mailto:ndickel@aqmd.gov) [Christina Ojeda](#)

**Cc:** [Han, Jessie](#) [Steve Cassulo](#) [Haley, William \(Bill\)](#) [Amanda Froman](#) [Michael Hearn](#) [Nicole Ward](#) [Christopher.Fear@WasteConnections.com](mailto:Christopher.Fear@WasteConnections.com) [Viswanathan, Srividhya](#) [Kate Logan](#) [Mark.Adams](#)

**Asunto:** Ref.: Orden de Depuración Estipulada del Caso No. 6177-4 - Actualización sobre la Instalación y Operación Semanal de las Bombas

**Importancia:** Normal

**Sensibilidad:** Ninguna

**Adjunto:**

[Outlook-cmqkcb5k.png](#); [Outlook-o0ybx5fq.png](#); [Outlook-jtlptmqi.png](#); [Outlook-jtawij2i.png](#); [Outlook-3hw0er4l.png](#); [Outlook-3rgztszi.png](#); [Outlook-25rfdvy.png](#); [Outlook-p30v2ukt.png](#); [Outlook-2qny0dk4.png](#); [Outlook-jscwrblw.png](#); [Outlook-fxnf123c.png](#); [Outlook-samhi5se.png](#); [Outlook-mcndynwc.png](#); [Outlook-cgbrzklf.png](#); [Outlook-en34wr2y.png](#); [2025 CCLF Existing De-Watering Well with Pump Map\\_2025-05-23.pdf](#);

---

[REMITENTE EXTERNO: Tenga precaución con los enlaces/adjuntos]

Todos,

Según la Condición 65 de la Orden Estipulada Modificada, a continuación se encuentra el resumen de la instalación y operación de las bombas de desagüe para el Vertedero de Chiquita Canyon.

Durante el período que transcurrió desde el 16/05/2025 hasta el 22/05/2025, Chiquita completó la instalación y comenzó a operar durante el día una (1) bomba en pozos verticales de extracción de LFG dando un total de ciento sesenta (160) bombas operado en pozos verticales de extracción de LFG. La semana pasada se retiraron dos (2) bombas y esta semana se agregó una (1) bomba, generando una reducción neta de una (1) bomba. Por favor, consulte el mapa actualizado adjunto de los pozos de LFG con bombas operando.

Durante el período que va del 23/05/2025 hasta el 29/05/2025, dada la cantidad de bombas de desagüe instaladas hasta la fecha y el mantenimiento asociado a esas bombas, Chiquita tiene planeado instalar y comenzar a operar otras dos (2) bombas en pozos verticales de extracción de LFG en ubicaciones a lo largo de la pendiente norte y sur de la zona reactiva. Las ubicaciones de las instalaciones de las bombas para la semana que viene están sujetas a cambios debido a las condiciones climáticas y/o de seguridad.

Atentamente,

**STEVEN** Rubén Medina, E.I.T.

Personal Profesional

**SCS Engineers**

3900 Kilroy Airport Way, Suite 300


Long Beach, CA 90806

858-204-4342 (c)


[SMedina@scsengineers.com](mailto:SMedina@scsengineers.com)

Dirigidos por el Éxito de los Clientes

[www.scsengineers.com](http://www.scsengineers.com)

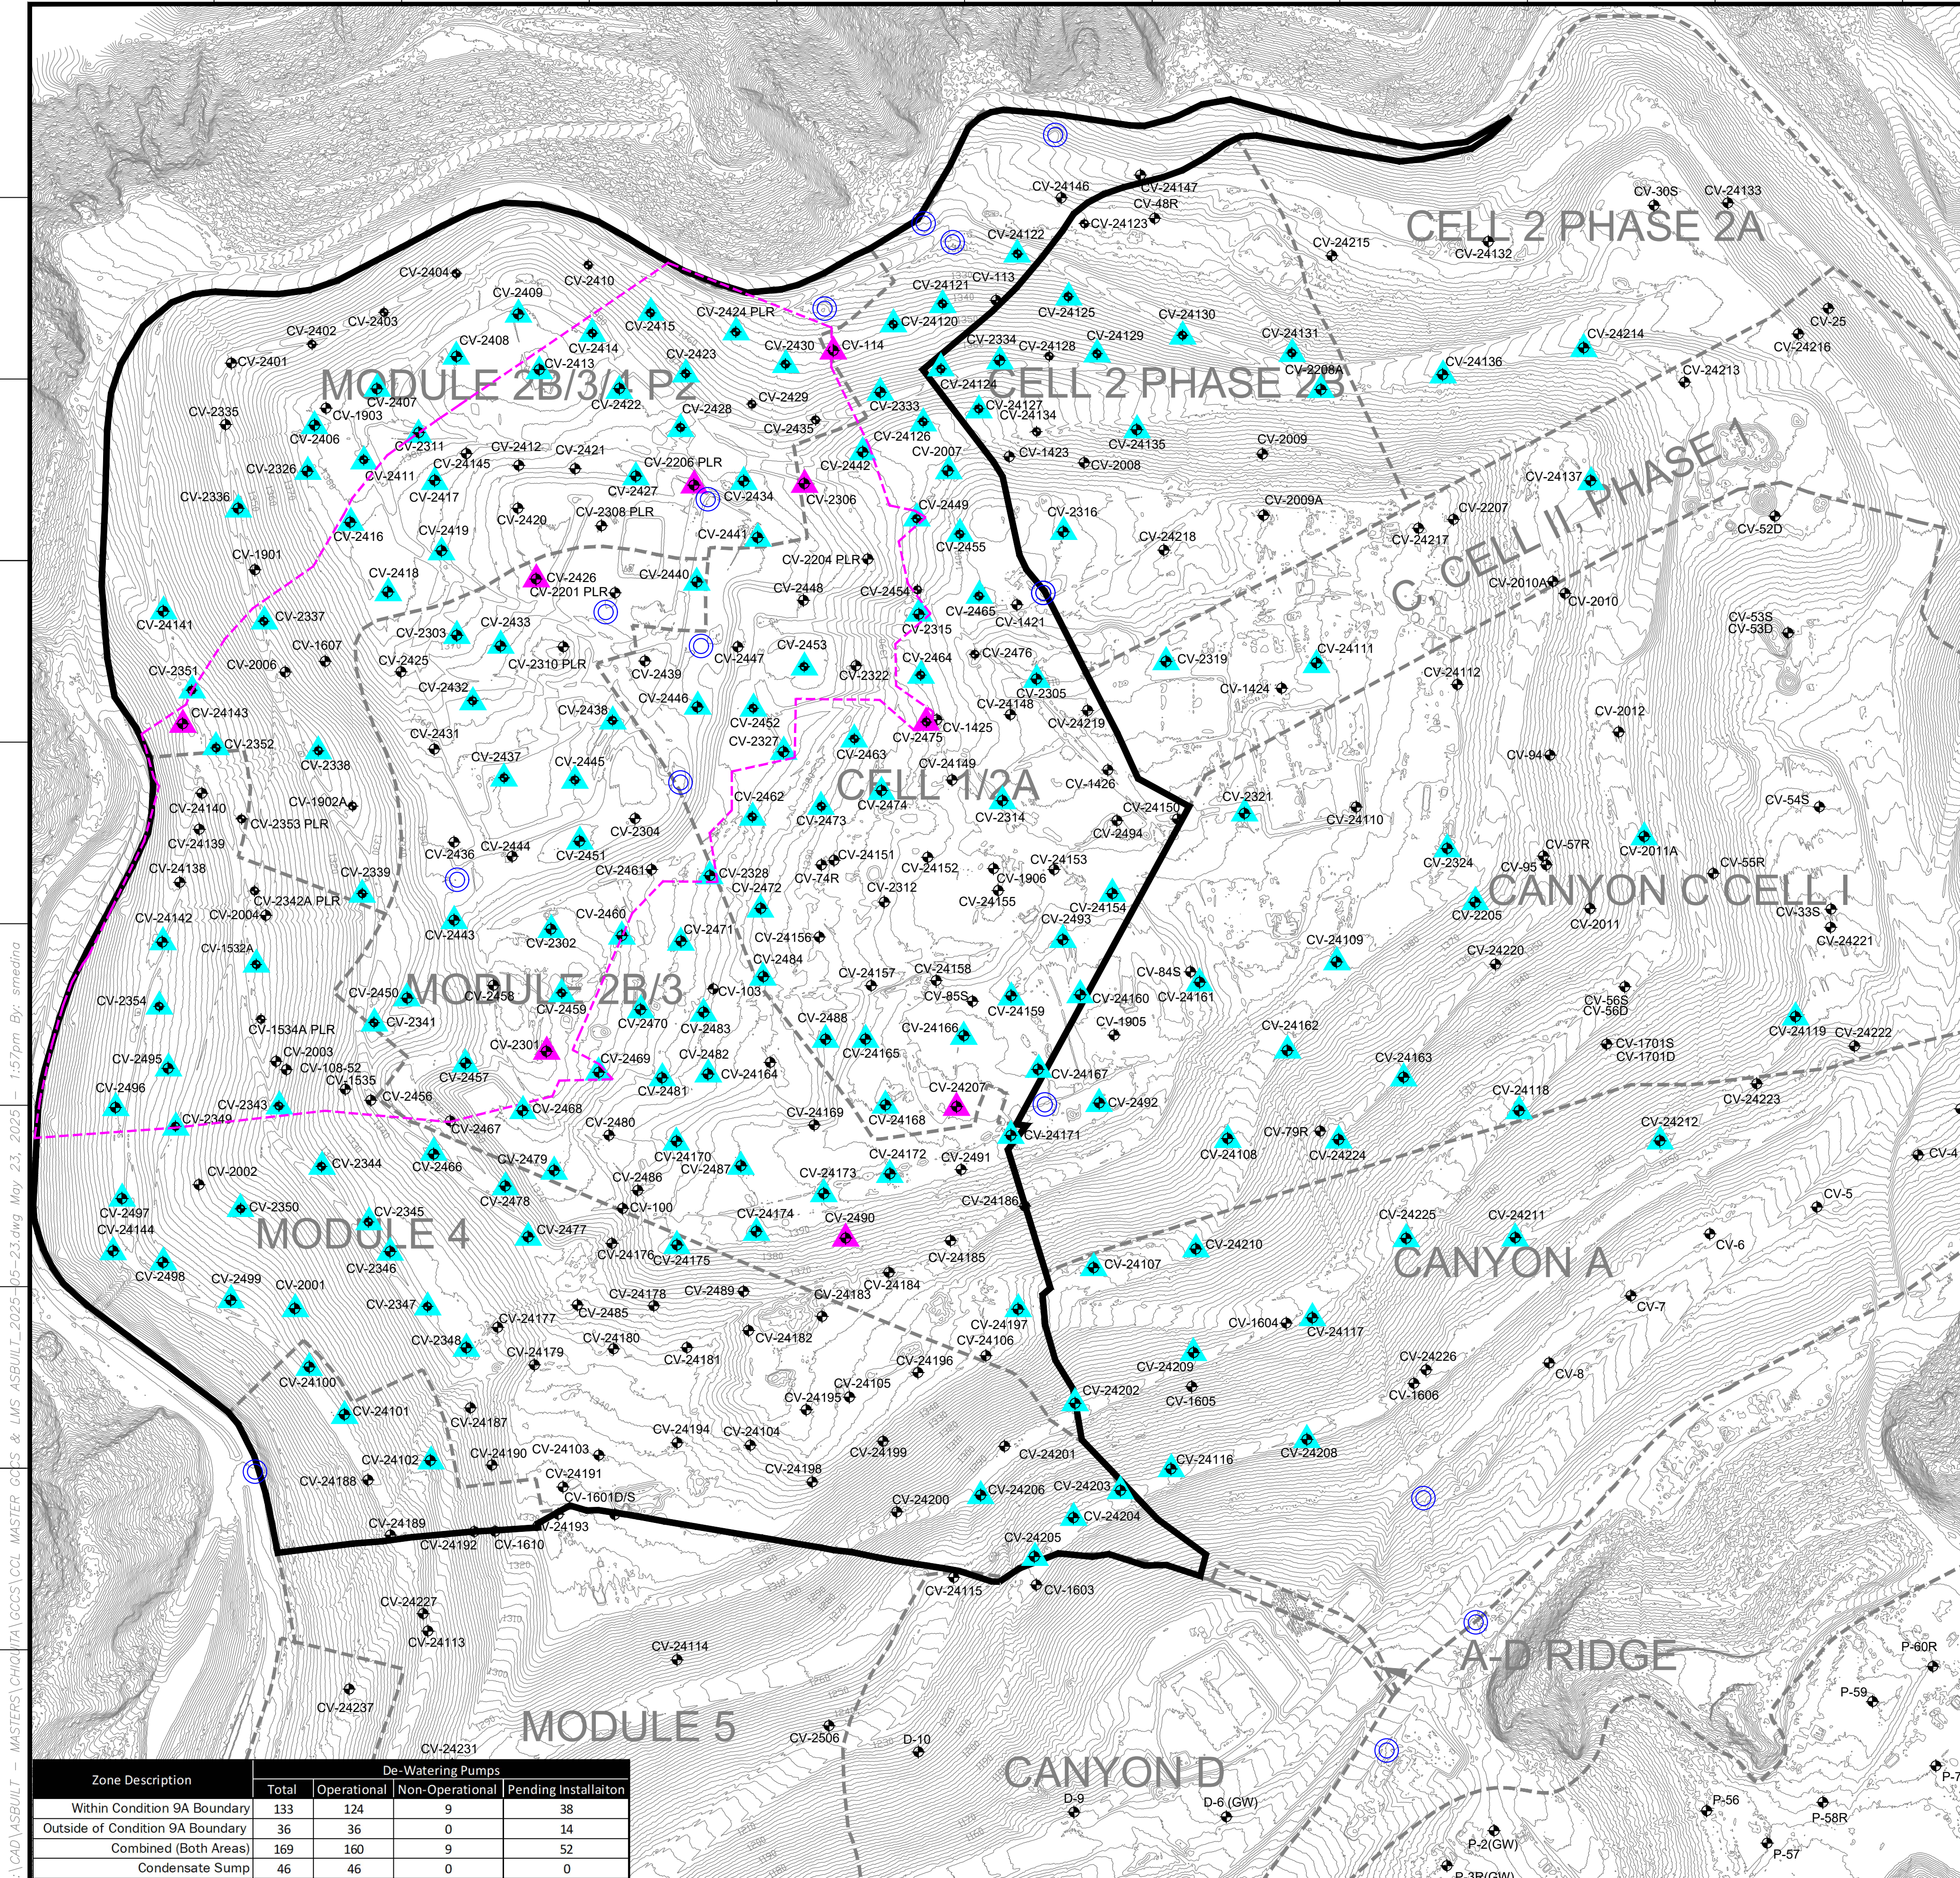

| De-Watering Well Pumps that are Currently Running |          |                          |
|---------------------------------------------------|----------|--------------------------|
| #                                                 | Well ID  | Operational Startup Date |
| 1                                                 | CV-2334  | 3/21/2024                |
| 2                                                 | CV-2424  | 3/21/2024                |
| 3                                                 | CV-2325  | 3/27/2024                |
| 4                                                 | CV-2321  | 3/27/2024                |
| 5                                                 | CV-2319  | 3/28/2024                |
| 6                                                 | CV-2324  | 3/28/2024                |
| 7                                                 | CV-2354  | 4/1/2024                 |
| 8                                                 | CV-24144 | 4/8/2024                 |
| 9                                                 | CV-2302  | 4/10/2024                |
| 10                                                | CV-2314  | 4/10/2024                |
| 11                                                | CV-2352  | 4/12/2024                |
| 12                                                | CV-2316  | 4/19/2024                |
| 13                                                | CV-2307  | 4/19/2024                |
| 14                                                | CV-2337  | 4/22/2024                |
| 15                                                | CV-2335  | 4/23/2024                |
| 16                                                | CV-2351  | 4/23/2024                |
| 17                                                | CV-24141 | 4/23/2024                |
| 18                                                | CV-2325  | 4/24/2024                |
| 19                                                | CV-2328  | 4/26/2024                |
| 20                                                | CV-24142 | 5/3/2024                 |
| 21                                                | CV-2411  | 5/16/2024                |
| 22                                                | CV-2428  | 5/23/2024                |
| 23                                                | CV-24126 | 5/23/2024                |
| 24                                                | CV-24127 | 5/23/2024                |
| 25                                                | CV-2428  | 5/23/2024                |
| 26                                                | CV-2485  | 5/30/2024                |
| 27                                                | CV-2497  | 5/30/2024                |
| 28                                                | CV-2414  | 5/31/2024                |
| 29                                                | CV-2488  | 5/31/2024                |
| 30                                                | CV-24111 | 6/7/2024                 |
| 31                                                | CV-2418  | 6/24/2024                |
| 32                                                | CV-2419  | 6/24/2024                |
| 33                                                | CV-24102 | 7/3/2024                 |
| 34                                                | CV-24109 | 7/7/2024                 |
| 35                                                | CV-24162 | 7/8/2024                 |
| 36                                                | CV-2409  | 7/17/2024                |
| 37                                                | CV-24100 | 7/17/2024                |
| 38                                                | CV-2303  | 7/18/2024                |
| 39                                                | CV-2311  | 7/18/2024                |
| 40                                                | CV-2315  | 7/18/2024                |
| 41                                                | CV-2488  | 7/18/2024                |
| 42                                                | CV-24101 | 7/18/2024                |
| 43                                                | CV-2419  | 7/19/2024                |
| 44                                                | CV-2345  | 7/19/2024                |
| 45                                                | CV-2344  | 7/22/2024                |
| 46                                                | CV-2348  | 7/22/2024                |
| 47                                                | CV-2343  | 7/23/2024                |
| 48                                                | CV-2347  | 7/24/2024                |
| 49                                                | CV-2346  | 7/25/2024                |
| 50                                                | CV-1526A | 8/2/2024                 |
| 51                                                | CV-2401  | 8/13/2024                |
| 52                                                | CV-2417  | 8/13/2024                |
| 53                                                | CV-2422  | 8/14/2024                |
| 54                                                | CV-2418  | 8/14/2024                |
| 55                                                | CV-2441  | 8/15/2024                |
| 56                                                | CV-2477  | 8/15/2024                |
| 57                                                | CV-2341  | 8/15/2024                |
| 58                                                | CV-2427  | 8/19/2024                |
| 59                                                | CV-2485  | 8/19/2024                |
| 60                                                | CV-24121 | 8/23/2024                |
| 61                                                | CV-24124 | 8/24/2024                |
| 62                                                | CV-2420  | 8/29/2024                |
| 63                                                | CV-24120 | 8/29/2024                |
| 64                                                | CV-2423  | 8/29/2024                |
| 65                                                | CV-2415  | 9/2/2024                 |
| 66                                                | CV-24125 | 9/30/2024                |
| 67                                                | CV-24129 | 9/30/2024                |
| 68                                                | CV-24130 | 9/30/2024                |
| 69                                                | CV-24131 | 9/30/2024                |
| 70                                                | CV-2339  | 9/4/2024                 |
| 71                                                | CV-2409  | 9/4/2024                 |
| 72                                                | CV-2453  | 9/4/2024                 |
| 73                                                | CV-2478  | 9/4/2024                 |
| 74                                                | CV-24108 | 9/4/2024                 |
| 75                                                | CV-2349  | 9/4/2024                 |
| 76                                                | CV-2481  | 9/6/2024                 |
| 77                                                | CV-2462  | 9/6/2024                 |
| 78                                                | CV-2333  | 9/9/2024                 |
| 79                                                | CV-2482  | 9/10/2024                |
| 80                                                | CV-2360  | 9/10/2024                |
| 81                                                | CV-2485  | 9/10/2024                |
| 82                                                | CV-2469  | 9/13/2024                |
| 83                                                | CV-24122 | 9/13/2024                |
| 84                                                | CV-2480  | 9/16/2024                |
| 85                                                | CV-2464  | 9/16/2024                |
| 86                                                | CV-2483  | 9/16/2024                |
| 87                                                | CV-2410  | 9/19/2024                |
| 88                                                | CV-2463  | 9/26/2024                |
| 89                                                | CV-2459  | 9/27/2024                |
| 90                                                | CV-2472  | 9/27/2024                |
| 91                                                | CV-2474  | 9/27/2024                |
| 92                                                | CV-2434  | 9/28/2024                |
| 93                                                | CV-2437  | 10/1/2024                |
| 94                                                | CV-2453  | 10/1/2024                |
| 95                                                | CV-2450  | 10/1/2024                |
| 96                                                | CV-2457  | 10/1/2024                |
| 97                                                | CV-2488  | 10/15/2024               |
| 98                                                | CV-2327  | 12/3/2024                |
| 99                                                | CV-2473  | 12/10/2024               |
| 100                                               | CV-2446  | 12/13/2024               |
| 101                                               | CV-2413  | 12/18/2024               |
| 102                                               | CV-2438  | 12/17/2024               |
| 103                                               | CV-2433  | 12/20/2024               |
| 104                                               | CV-2442  | 12/21/2024               |
| 105                                               | CV-2452  | 12/22/2024               |
| 106                                               | CV-2461  | 12/23/2024               |
| 107                                               | CV-2471  | 12/24/2024               |
| 108                                               | CV-2445  | 1/6/2025                 |
| 109                                               | CV-2432  | 1/7/2025                 |
| 110                                               | CV-24116 | 1/10/2025                |
| 111                                               | CV-24118 | 1/10/2025                |
| 112                                               | CV-24119 | 1/10/2025                |
| 113                                               | CV-24203 | 1/10/2025                |
| 114                                               | CV-24204 | 1/10/2025                |
| 115                                               | CV-24205 | 1/10/2025                |
| 116                                               | CV-24206 | 1/10/2025                |
| 117                                               | CV-24211 | 1/10/2025                |
| 118                                               | CV-24212 | 1/10/2025                |
| 119                                               | CV-24193 | 1/14/2025                |
| 120                                               | CV-24225 | 1/15/2025                |
| 121                                               | CV-24117 | 1/17/2025                |
| 122                                               | CV-24079 | 1/28/2025                |
| 123                                               | CV-2470  | 2/4/2025                 |
| 124                                               | CV-2338  | 2/8/2025                 |
| 125                                               | CV-24206 | 2/20/2025                |
| 126                                               | CV-24202 | 2/28/2025                |
| 127                                               | CV-24209 | 2/28/2025                |
| 128                                               | CV-24197 | 3/11/2025                |
| 129                                               | CV-24049 | 3/11/2025                |
| 130                                               | CV-24055 | 3/11/2025                |
| 131                                               | CV-24107 | 3/12/2025                |
| 132                                               | CV-2440  | 3/25/2025                |
| 133                                               | CV-24168 | 4/7/2025                 |
| 134                                               | CV-24166 | 4/7/2025                 |
| 135                                               | CV-24169 | 4/7/2025                 |
| 136                                               | CV-24171 | 4/7/2025                 |
| 137                                               | CV-24135 | 4/11/2025                |
| 138                                               | CV-2487  | 4/15/2025                |
| 139                                               | CV-24170 | 4/15/2025                |
| 140                                               | CV-24174 | 4/15/2025                |
| 141                                               | CV-24175 | 4/15/2025                |
| 142                                               | CV-24159 | 4/16/2025                |
| 143                                               | CV-24154 | 4/17/2025                |
| 144                                               | CV-2465  | 4/25/2025                |
| 145                                               | CV-2208A | 5/1/2025                 |
| 146                                               | CV-24138 | 5/1/2025                 |
| 147                                               | CV-24214 | 5/1/2025                 |
| 148                                               | CV-24093 | 5/6/2025                 |
| 149                                               | CV-24160 | 5/6/2025                 |
| 150                                               | CV-24202 | 5/7/2025                 |
| 151                                               | CV-2205  | 5/8/2025                 |
| 152                                               | CV-24181 | 5/8/2025                 |
| 153                                               | CV-24167 | 5/8/2025                 |
| 154                                               | CV-24170 | 5/8/2025                 |
| 155                                               | CV-24172 | 5/8/2025                 |
| 156                                               | CV-2468  | 5/9/2025                 |
| 157                                               | CV-2464  | 5/9/2025                 |
| 158                                               | CV-24224 | 5/12/2025                |
| 159                                               | CV-24137 | 5/15/2025                |
| 160                                               | CV-2011A | 5/20/2025                |

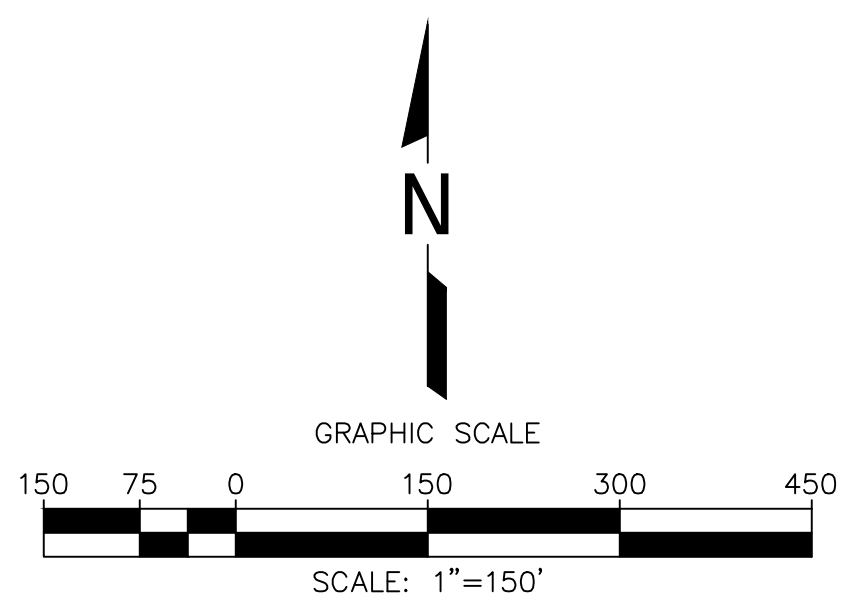

- LEGEND**
- 1150 TOPOGRAPHIC CONTOUR
  - EXISTING CELL LIMITS (APPROXIMATE)
  - REACTION AREA BOUNDARY - CONDITION 9A
  - REACTION AREA BOUNDARY - DATA ANALYSIS
  - CV-XX EXISTING VERTICAL LFG EXTRACTION WELL
  - CV-XX PLR EXISTING LFG VERTICAL EXTRACTION WELL - PRESSURIZED LEACHATE RELEASE
  - EXISTING CONDENSATE SUMP WITH PUMP
  - EXISTING DE-WATERING WELL WITH PUMP - CURRENTLY RUNNING
  - EXISTING DE-WATERING WELL WITH PUMP - INSTALLED

| De-Watering Well Pumps That Are Currently Installed and Not in Operation |          |
|--------------------------------------------------------------------------|----------|
| #                                                                        | Well ID  |
| 1                                                                        | CV-114   |
| 2                                                                        | CV-2206  |
| 3                                                                        | CV-2301  |
| 4                                                                        | CV-2306  |
| 5                                                                        | CV-2426  |
| 6                                                                        | CV-2475  |
| 7                                                                        | CV-2490  |
| 8                                                                        | CV-24143 |
| 9                                                                        | CV-24207 |

- GENERAL DRAWING NOTES:**
- EXISTING TOPOGRAPHIC SURVEY INFORMATION SHOWN WAS PROVIDED BY PROPELLOR. AERIAL PHOTOGRAPHY DATED MAY 14, 2025.
  - NORTH ARROW SHOWN HERE IS REFERENCE TO THE CALIFORNIA STATE PLANE ZONE V COORDINATE SYSTEM, NAD 83.
  - THE LOCATION OF ANY EXISTING GCCS COMPONENTS AND OTHER FEATURES ARE APPROXIMATE AND SHOULD BE USED FOR INFORMATION PURPOSES ONLY.
  - EXISTING GCCS AS-BUILT DATED MAY 21, 2025.

| Zone Description                 | De-Watering Pumps |             |                 |                      |
|----------------------------------|-------------------|-------------|-----------------|----------------------|
|                                  | Total             | Operational | Non-Operational | Pending Installation |
| Within Condition 9A Boundary     | 133               | 124         | 9               | 38                   |
| Outside of Condition 9A Boundary | 36                | 36          | 0               | 14                   |
| Combined (Both Areas)            | 169               | 160         | 9               | 52                   |
| Condensate Sump                  | 46                | 46          | 0               | 0                    |

DATE

REVISION

NO

SHEET TITLE:  
EXISTING DE-WATERING WELL WITH PUMP MAP

PROJECT TITLE:  
CHIQUITA CANYON LANDFILL  
CASTAIC, CALIFORNIA

CLIENT:

SCS ENGINEERS  
ENVIRONMENTAL CONSULTANTS  
15000 WILSON AVENUE, SUITE 300  
LONG BEACH, CA 90806  
PH: (562) 426-9544

DATE: 05/23/2025

SCALE: AS SHOWN

SHEET: 1

ACAD FILE: F:\FIELD SERVICES

DWN. BY: SRM

CHK. BY: WCH

APP. BY: WCH