

Archived: Friday, June 6, 2025 8:22:06 AM

From: [Medina, Steven](#)

Sent: Friday, May 30, 2025 4:33:20 PM

To: bchen@aqmd.gov ndickel@aqmd.gov [Christina Ojeda](#)

Cc: [Han, Jessie](#) [Steve Cassulo](#) [Haley, William \(Bill\)](#) [Amanda Froman](#) [Michael Hearn](#) [Nicole Ward](#)
Christopher.Fear@WasteConnections.com [Viswanathan, Srividhya](#) [Kate Logan](#) [Mark Adams](#)

Subject: Re: Case No. 6177-4 Stipulated Order for Abatement - Weekly Pump Installation and operation update

Importance: Normal

Sensitivity: None

Attachments:

[Outlook-cmqkcb5k.png](#) [Outlook-o0ybx5fq.png](#) [Outlook-jtlptmqi.png](#) [Outlook-jtawij2i.png](#) [Outlook-3hw0er4l.png](#)
[Outlook-3rgztszi.png](#) [Outlook-25rldvy.png](#) [Outlook-p30v2ukt.png](#) [Outlook-2qny0dk4.png](#) [Outlook-jscwrblw.png](#)
[Outlook-fxfnl23c.png](#) [Outlook-samhi5se.png](#) [Outlook-mcndynwc.png](#) [Outlook-cgbrzklf.png](#) [Outlook-en34wr2y.png](#)
[Outlook-02mtaq0a.png](#) [025 CCLF Existing De-Watering Well with Pump Map_2025-05-30.pdf](#)

[EXTERNAL SENDER: Use caution with links/attachments]

All,

In accordance with Condition 65 of the Modified Stipulated Order, below is the summary of the installation and operation of dewatering pumps for the Chiquita Canyon Landfill.

During 05/23/2025 to 05/29/2025, Chiquita completed the installation of, and began operating during the day, four (4) pumps in a vertical LFG extraction well for a total of one hundred and fifty-seven (157) pumps operating in vertical LFG extraction wells. Seven (7) pumps were removed last week, and four (4) pumps were added this week, leading to a net decrease of three (3) pumps. Seven (7) pumps were removed as part of the transition from pneumatic to Lorentz pumps. Please refer to the attached, up-to-date map of LFG wells with operating pumps.

During 05/30/2025 to 06/05/2025, given the number of dewatering pumps installed to date, and the maintenance associated with those pumps, Chiquita plans to install and begin operating an additional four (4) pumps in vertical LFG extraction wells in locations along the north and south slope of the reaction area. The pump installation locations for next week are subject to change due to weather and/or safety conditions.

Regards,

STEVEN Ruben Medina, **E.I.T.**

Staff Professional

SCS Engineers

3900 Kilroy Airport Way, Suite 300

Long Beach, CA 90806

858-204-4342 (c)


SMedina@scsengineers.com

Driven by Client Success

www.scsengineers.com

□

Dis-Watering Well Pumps that are Currently Running		
#	Well ID	Operational Start Date
1	CV-2334	3/21/2020
2	CV-2304	3/21/2020
3	CV-2305	3/27/2024
4	CV-2321	3/27/2024
5	CV-2384	4/1/2024
6	CV-2344	4/1/2024
7	CV-2302	4/10/2024
8	CV-2314	4/10/2024
9	CV-2382	4/12/2024
10	CV-2316	4/12/2024
11	CV-2307	4/19/2024
12	CV-2337	4/22/2024
13	CV-2338	4/23/2024
14	CV-2381	4/23/2024
15	CV-2414	4/23/2024
16	CV-2328	4/24/2024
17	CV-2328	4/26/2024
18	CV-2342	4/26/2024
19	CV-2411	5/15/2024
20	CV-2428	5/23/2024
21	CV-2416	5/23/2024
22	CV-2427	5/23/2024
23	CV-2406	5/30/2024
24	CV-2496	5/30/2024
25	CV-2487	5/30/2024
26	CV-2414	5/30/2024
27	CV-2408	5/31/2024
28	CV-2411	6/7/2024
29	CV-2416	6/24/2024
30	CV-2419	6/24/2024
31	CV-24102	7/3/2024
32	CV-24109	7/7/2024
33	CV-24182	7/8/2024
34	CV-2409	8/1/2024
35	CV-24100	7/17/2024
36	CV-2303	7/18/2024
37	CV-2315	7/18/2024
38	CV-2408	7/18/2024
39	CV-24101	7/18/2024
40	CV-24001	7/19/2024
41	CV-2345	7/19/2024
42	CV-2414	7/19/2024
43	CV-2438	7/22/2024
44	CV-2343	7/23/2024
45	CV-2347	7/24/2024
46	CV-2406	7/24/2024
47	CV-1532A	8/2/2024
48	CV-2407	8/13/2024
49	CV-2417	8/13/2024
50	CV-2422	8/14/2024
51	CV-2418	8/14/2024
52	CV-2477	8/15/2024
53	CV-2341	8/15/2024
54	CV-2427	8/15/2024
55	CV-2466	8/19/2024
56	CV-24121	8/23/2024
57	CV-24124	8/24/2024
58	CV-2423	8/26/2024
59	CV-2420	8/26/2024
60	CV-2423	8/26/2024
61	CV-2415	9/30/2024
62	CV-2425	9/30/2024
63	CV-24126	9/30/2024
64	CV-24130	9/30/2024
65	CV-24131	9/30/2024
66	CV-2409	9/30/2024
67	CV-2409	9/30/2024
68	CV-2453	9/4/2024
69	CV-2478	9/4/2024
70	CV-24108	9/4/2024
71	CV-2409	9/4/2024
72	CV-2481	9/6/2024
73	CV-2462	9/6/2024
74	CV-2333	9/6/2024
75	CV-2482	9/10/2024
76	CV-2350	9/10/2024
77	CV-2495	9/10/2024
78	CV-2486	9/10/2024
79	CV-2480	9/10/2024
80	CV-2484	9/16/2024
81	CV-2483	9/16/2024
82	CV-2410	9/16/2024
83	CV-2453	9/26/2024
84	CV-2459	9/27/2024
85	CV-2472	9/27/2024
86	CV-2474	9/27/2024
87	CV-2434	9/27/2024
88	CV-2437	10/1/2024
89	CV-2443	10/1/2024
90	CV-2450	10/1/2024
91	CV-2437	10/1/2024
92	CV-2488	10/15/2024
93	CV-2327	12/3/2024
94	CV-2413	12/10/2024
95	CV-2413	12/10/2024
96	CV-2473	12/18/2024
97	CV-2438	12/21/2024
98	CV-2453	12/21/2024
99	CV-2462	12/21/2024
100	CV-2452	12/22/2024
101	CV-2451	12/23/2024
102	CV-2471	12/24/2024
103	CV-2445	12/24/2024
104	CV-2432	11/7/2025
105	CV-2416	11/10/2025
106	CV-24118	11/10/2025
107	CV-2419	11/10/2025
108	CV-24203	11/10/2025
109	CV-24203	11/10/2025
110	CV-24205	11/10/2025
111	CV-24208	11/10/2025
112	CV-24211	11/10/2025
113	CV-24213	11/14/2025
114	CV-24225	11/15/2025
115	CV-24171	11/15/2025
116	CV-24079	12/28/2025
117	CV-2470	2/4/2026
118	CV-2338	2/8/2026
119	CV-24008	2/8/2026
120	CV-24202	2/28/2026
121	CV-24009	2/28/2026
122	CV-24049	3/11/2026
123	CV-24655	3/11/2026
124	CV-24107	3/21/2026
125	CV-2440	3/25/2026
126	CV-24185	4/7/2026
127	CV-24086	4/7/2026
128	CV-24168	4/7/2026
129	CV-24171	4/7/2026
130	CV-24135	4/11/2026
131	CV-24187	4/15/2026
132	CV-24173	4/15/2026
133	CV-24174	4/15/2026
134	CV-24175	4/15/2026
135	CV-24159	4/15/2026
136	CV-24154	4/17/2026
137	CV-2465	4/25/2026
138	CV-2208A	5/1/2026
139	CV-24136	5/1/2026
140	CV-24214	5/1/2026
141	CV-24093	5/6/2026
142	CV-24180	5/6/2026
143	CV-24224	5/6/2026
144	CV-23902	5/15/2026
145	CV-24161	5/8/2026
146	CV-24167	5/8/2026
147	CV-24170	5/8/2026
148	CV-24172	5/8/2026
149	CV-2488	5/9/2026
150	CV-2484	5/9/2026
151	CV-2487	5/9/2026
152	CV-24391	5/15/2026
153	CV-2011A	5/20/2026
154	CV-2412	5/27/2026
155	CV-2421	5/27/2026
156	CV-24020	5/30/2026
157	CV-2456	5/31/2026

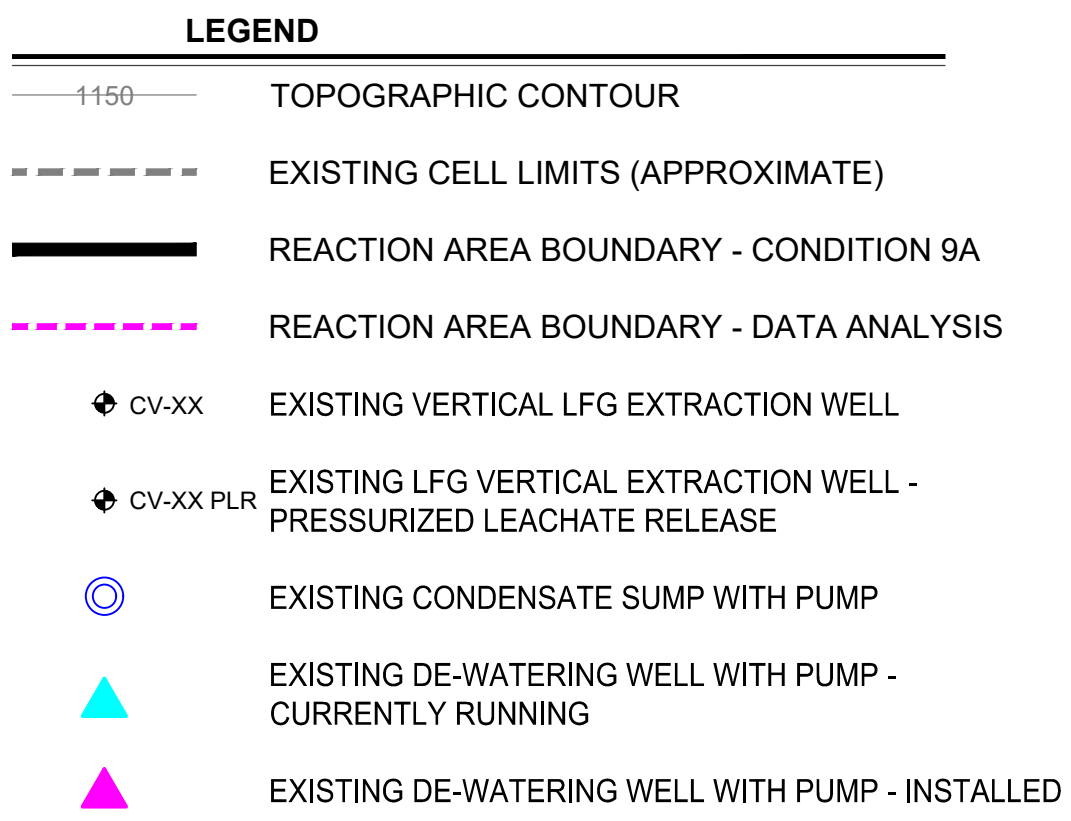

De-Watering Well Pumps That Are Currently Installed and Not in Operation	
#	Well I.D.
1	CV-114
2	CV-2206
3	CV-2301
4	CV-2306
5	CV-2426
6	CV-2436
7	CV-2439
8	CV-2444
9	CV-2475
10	CV-2490
11	CV-24207
12	CV-24212

SCS ENGINEERS ENVIRONMENTAL CONSULTANTS 3900 KILROY AVENUE SUITE 300 LONG BEACH, CA 90806 PH: (562) 733-8541	DATE: 05/30/2025		PROJ. NO.: 01204123-41 DSN. BY: - CHK. BY: WCH		ACAD. FILE: F:\FIELD SERVICES	
	SCALE: AS SHOWN		DWG. BY: SRM APP. BY: WCH		WCH	
SHEET: 1						

GENERAL DRAWING NOTES:

1. EXISTING TOPOGRAPHIC SURVEY INFORMATION SHOWN WAS PROVIDED BY PROPELLOR. AERIAL PHOTOGRAPHY DATED MAY 14, 2025.
2. NORTH ARROW SHOWN HERE IS REFERENCE TO THE CALIFORNIA STATE PLANE ZONE V COORDINATE SYSTEM, NAD 83.
3. THE LOCATION OF ANY EXISTING GCCS COMPONENTS AND OTHER FEATURES ARE APPROXIMATE AND SHOULD BE USED FOR INFORMATION PURPOSES ONLY.
4. EXISTING GCCS AS-BUILT DATED MAY 21, 2025.