

Archived: Wednesday, July 9, 2025 9:19:42 AM

From: [Medina, Steven](#)

Sent: Thursday, July 3, 2025 11:33:33 AM

To: bchen@aqmd.gov ndickel@aqmd.gov [Christina Ojeda](#)

Cc: [Han, Jessie](#) [Steve Cassulo](#) [Haley, William \(Bill\)](#) [Amanda Froman](#) [Michael Hearn](#) [Nicole Ward](#)
Christopher.Fear@WasteConnections.com [Viswanathan, Srividhya](#) [Kate Logan](#) [Mark Adams](#) [Haley, William \(Bill\)](#)

Subject: Re: Case No. 6177-4 Stipulated Order for Abatement - Weekly Pump Installation and operation update

Importance: Normal

Sensitivity: None

Attachments:

[Outlook-4sjcmgpq.png](#) [Outlook-ynjuzh34.png](#) [Outlook-t50axwe4.png](#) [2025 CCLF Existing De-Watering Well with Pump Map_2025-07-03.pdf](#)

[EXTERNAL SENDER: Use caution with links/attachments]

All,

In accordance with Condition 65 of the Modified Stipulated Order, below is the summary of the installation and operation of dewatering pumps for the Chiquita Canyon Landfill.

This submittal has been provided one day in advance in observance of tomorrow's federal and state holiday, Independence Day.

In accordance with Condition 65 of the Modified Stipulated Order, below is the summary of the installation and operation of dewatering pumps for the Chiquita Canyon Landfill.

This submittal has been provided one day in advance in observance of the upcoming holiday.

During 06/27/2025 to 07/03/2025, Chiquita completed the installation of, and began operating during the day, zero (0) pumps in a vertical LFG extraction well for a total of one hundred and sixty-seven (167) pumps operating in vertical LFG extraction wells. Please refer to the attached, up-to-date map of LFG wells with operating pumps.

During 07/04/2025 to 07/10/2025, given the number of dewatering pumps installed to date, and the maintenance associated with those pumps, Chiquita plans to install and begin operating an additional four (4) pumps in vertical LFG extraction wells in locations along the north and south slope of the reaction area. The pump installation locations for next week are subject to change due to weather and/or safety conditions.

Regards,

STEVEN Ruben Medina, **E.I.T.**

Staff Professional

SCS Engineers

3900 Kilroy Airport Way, Suite 300

Long Beach, CA 90806


858-204-4342 (c)

SMedina@scsengineers.com

Driven by Client Success

www.scsengineers.com

□

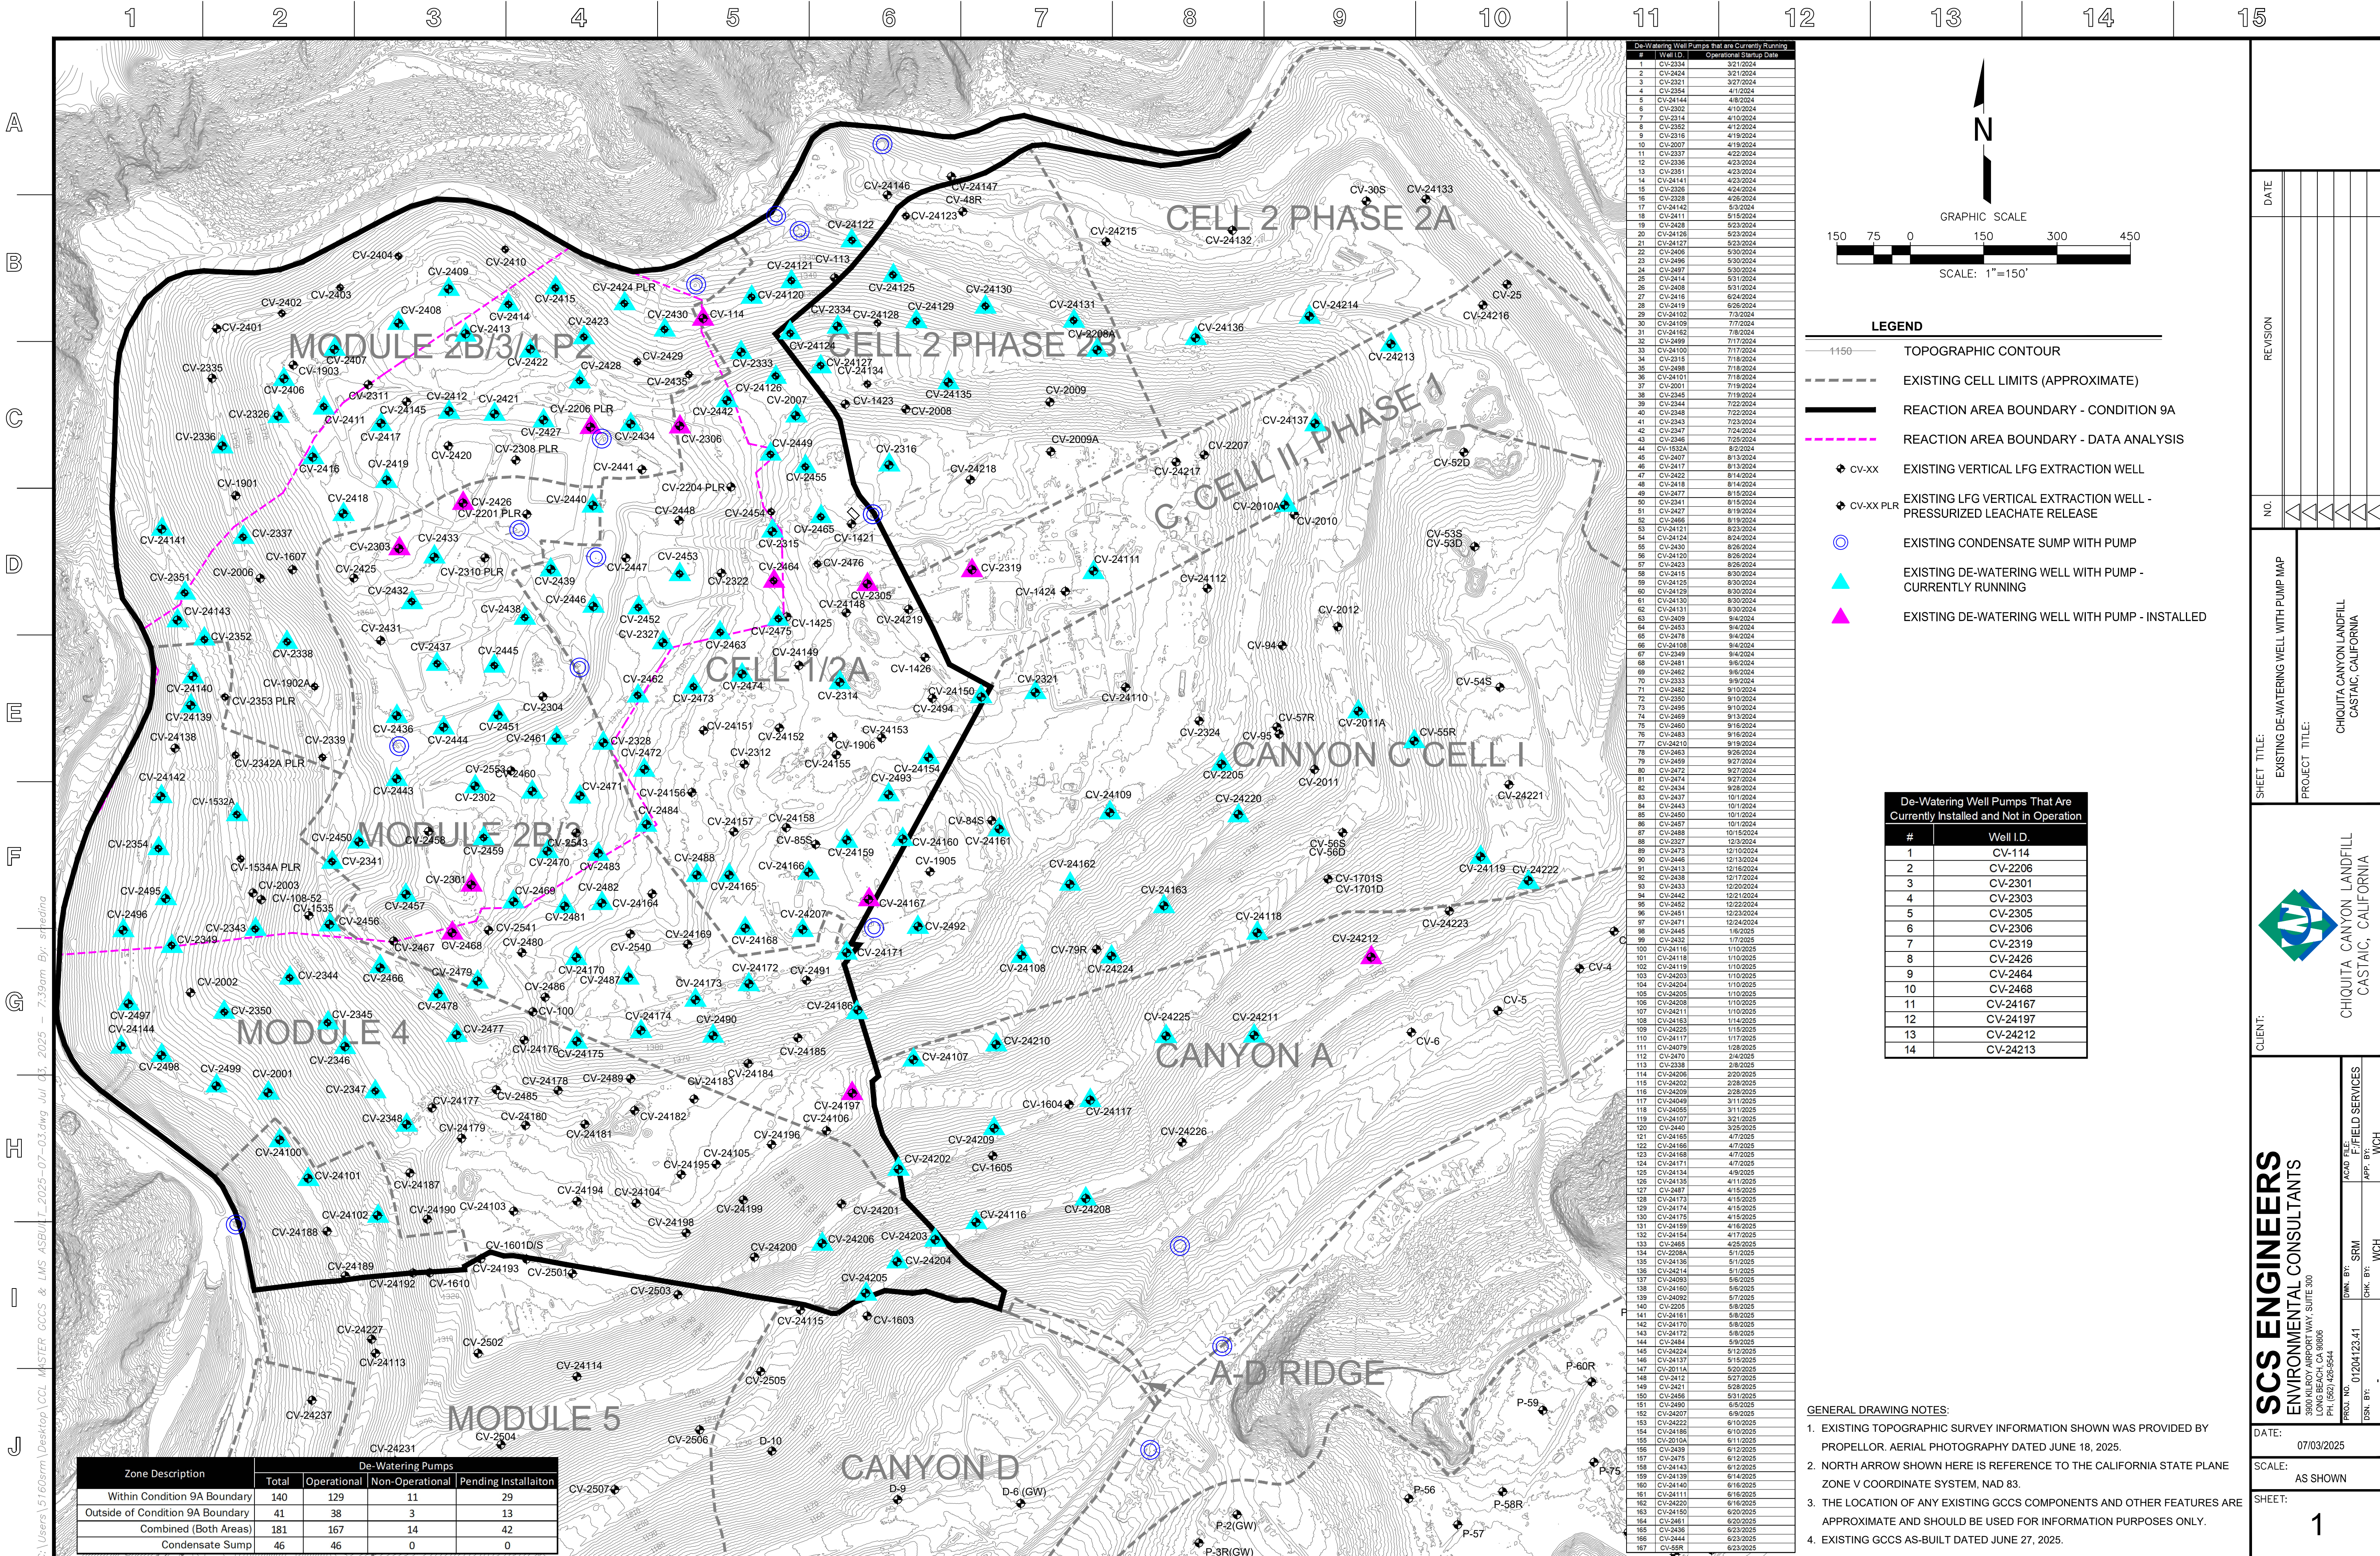

Zone Description	De-Watering Pumps			
	Total	Operational	Non-Operational	Pending Installation
Within Condition 9A Boundary	140	129	11	29
Outside of Condition 9A Boundary	41	38	3	13
Combined (Both Areas)	181	167	14	42
Condensate Sump	46	46	0	0

De-Watering Well Pumps that are Currently Running	
#	Well ID
1	CV-2334
2	CV-2404
3	CV-2321
4	CV-2354
5	CV-24144
6	CV-2302
7	CV-2314
8	CV-2352
9	CV-2316
10	CV-2007
11	CV-2337
12	CV-2336
13	CV-2351
14	CV-24141
15	CV-2335
16	CV-2338
17	CV-24142
18	CV-2411
19	CV-2403
20	CV-24126
21	CV-24127
22	CV-2405
23	CV-2496
24	CV-2497
25	CV-2414
26	CV-2408
27	CV-2415
28	CV-2419
29	CV-24102
30	CV-24109
31	CV-24152
32	CV-2409
33	CV-24100
34	CV-2315
35	CV-2408
36	CV-24101
37	CV-2001
38	CV-2345
39	CV-2344
40	CV-2348
41	CV-2343
42	CV-2347
43	CV-2346
44	CV-1532A
45	CV-2407
46	CV-2417
47	CV-2422
48	CV-2418
49	CV-2477
50	CV-2341
51	CV-2427
52	CV-2466
53	CV-24121
54	CV-24124
55	CV-24130
56	CV-24120
57	CV-2433
58	CV-2415
59	CV-24125
60	CV-24129
61	CV-24130
62	CV-24131
63	CV-2409
64	CV-2453
65	CV-2478
66	CV-24108
67	CV-2349
68	CV-2481
69	CV-2482
70	CV-2333
71	CV-2482
72	CV-2380
73	CV-2495
74	CV-2489
75	CV-2460
76	CV-2483
77	CV-24210
78	CV-2463
79	CV-2459
80	CV-2472
81	CV-2474
82	CV-2434
83	CV-2437
84	CV-2443
85	CV-2450
86	CV-2457
87	CV-2488
88	CV-2327
89	CV-2473
90	CV-2446
91	CV-2413
92	CV-2438
93	CV-2433
94	CV-2442
95	CV-2453
96	CV-2451
97	CV-2471
98	CV-2445
99	CV-2432
100	CV-24116
101	CV-24118
102	CV-24119
103	CV-24203
104	CV-24204
105	CV-24205
106	CV-24208
107	CV-24211
108	CV-24163
109	CV-24225
110	CV-24117
111	CV-24078
112	CV-2470
113	CV-2338
114	CV-24209
115	CV-24202
116	CV-24209
117	CV-24049
118	CV-24055
119	CV-24107
120	CV-2440
121	CV-24165
122	CV-24166
123	CV-24168
124	CV-24171
125	CV-24134
126	CV-24135
127	CV-2487
128	CV-24173
129	CV-24174
130	CV-24175
131	CV-24159
132	CV-24154
133	CV-2485
134	CV-2208A
135	CV-24136
136	CV-24214
137	CV-24093
138	CV-24160
139	CV-24092
140	CV-2205
141	CV-24161
142	CV-24170
143	CV-24172
144	CV-2404
145	CV-24224
146	CV-24137
147	CV-2011A
148	CV-24112
149	CV-2421
150	CV-2456
151	CV-2400
152	CV-24207
153	CV-2439
154	CV-24175
155	CV-2010A
156	CV-24139
157	CV-24140
158	CV-24141
159	CV-24139
160	CV-24140
161	CV-24141
162	CV-24220
163	CV-24150
164	CV-24061
165	CV-2436
166	CV-2444
167	CV-55R

De-Watering Well Pumps That are Currently Installed and Not in Operation	
#	Well I.D.
1	CV-114
2	CV-2206
3	CV-2301
4	CV-2303
5	CV-2305
6	CV-2306
7	CV-2319
8	CV-2426
9	CV-2464
10	CV-2468
11	CV-24167
12	CV-24197
13	CV-24212
14	CV-24213

- GENERAL DRAWING NOTES:
- EXISTING TOPOGRAPHIC SURVEY INFORMATION SHOWN WAS PROVIDED BY PROPELLOR. AERIAL PHOTOGRAPHY DATED JUNE 18, 2025.
 - NORTH ARROW SHOWN HERE IS REFERENCE TO THE CALIFORNIA STATE PLANE ZONE V COORDINATE SYSTEM, NAD 83.
 - THE LOCATION OF ANY EXISTING GCCS COMPONENTS AND OTHER FEATURES ARE APPROXIMATE AND SHOULD BE USED FOR INFORMATION PURPOSES ONLY.
 - EXISTING GCCS AS-BUILT DATED JUNE 27, 2025.

DATE: 07/03/2025

SCALE: AS SHOWN

SHEET: 1

REVISION

NO.

SHEET TITLE: EXISTING DE-WATERING WELL WITH PUMP MAP

PROJECT TITLE: CHIUQUITA CANYON LANDFILL CASTAIC, CALIFORNIA

CLIENT: CHIUQUITA CANYON LANDFILL CASTAIC, CALIFORNIA

SCS ENGINEERS ENVIRONMENTAL CONSULTANTS
15000 WILSON AVENUE, SUITE 300
LONG BEACH, CA 90806
PH: (562) 426-9544
FAX: (562) 426-9544

ACAD FILE: SRM
APP. BY: WCH
CHK. BY: WCH