

Archived: Wednesday, July 16, 2025 2:55:36 PM

From: [Medina, Steven](#)

Sent: Friday, July 11, 2025 4:40:36 PM

To: bchen@aqmd.gov ndickel@aqmd.gov [Christina Ojeda](#)

Cc: [Han, Jessie](#) [Steve Cassulo](#) [Haley, William \(Bill\)](#) [Amanda Froman](#) [Michael Hearn](#) [Nicole Ward](#)
Christopher.Fear@WasteConnections.com [Viswanathan, Srividhya](#) [Kate Logan](#) [Mark Adams](#) [Haley, William \(Bill\)](#)

Subject: Re: Case No. 6177-4 Stipulated Order for Abatement - Weekly Pump Installation and operation update

Importance: Normal

Sensitivity: None

Attachments:

[Outlook-4sjcmgpq.png](#) [Outlook-ynjuzh34.png](#) [Outlook-t50axwe4.png](#) [Outlook-sm4zc4rh.png](#) [2025 CCLF Existing De-Watering Well with Pump Map_2025-07-11.pdf](#)

[EXTERNAL SENDER: Use caution with links/attachments]

All,

In accordance with Condition 65 of the Modified Stipulated Order, below is the summary of the installation and operation of dewatering pumps for the Chiquita Canyon Landfill.

During 07/04/2025 to 07/10/2025, Chiquita completed the installation of, and began operating during the day, two (2) pumps in a vertical LFG extraction well for a total of one hundred and sixty-eight (168) pumps operating in vertical LFG extraction wells. One (1) pump was removed last week as part of the transition from pneumatic to Lorentz pumps, and two (2) pumps were added since last Friday, leading to a net increase of one (1) pump. Please refer to the attached, up-to-date map of LFG wells with operating pumps.

During 07/11/2025 to 07/17/2025, given the number of dewatering pumps installed to date, and the maintenance associated with those pumps, Chiquita plans to install and begin operating an additional three (3) pumps in vertical LFG extraction wells in locations along the north and south slope of the reaction area. The pump installation locations for next week are subject to change due to weather and/or safety conditions.

Regards,

STEVEN Ruben Medina, **E.I.T.**

Staff Professional

SCS Engineers

3900 Kilroy Airport Way, Suite 300

Long Beach, CA 90806


858-204-4342 (c)

SMedina@scsengineers.com

Driven by Client Success

www.scsengineers.com

□

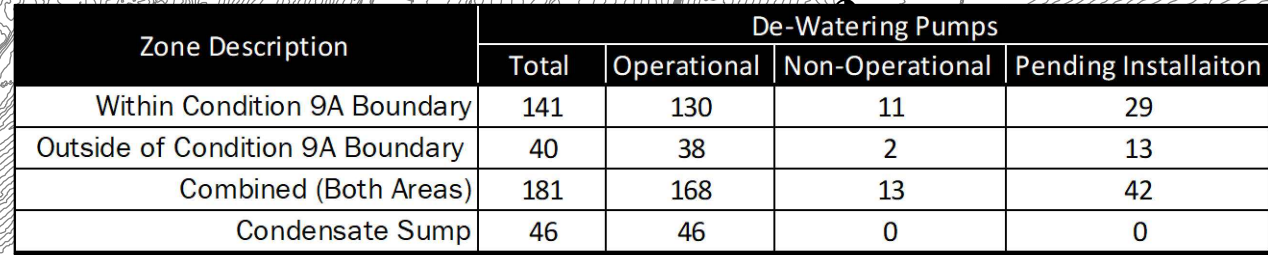

N

GRAPHIC SCALE

150750150300450

SCALE: 1"=150'

LEGEND

TOPOGRAPHIC CONTOUR

EXISTING CELL LIMITS (APPROXIMATE)

REACTION AREA BOUNDARY - CONDITION 9A

REACTION AREA BOUNDARY - DATA ANALYSIS

CV-XX
EXISTING VERTICAL LFG EXTRACTION WELL

CV-XX PLR
EXISTING LFG VERTICAL EXTRACTION WELL -
PRESSURIZED LEACHATE RELEASE

EXISTING CONDENSATE SUMP WITH PUMP

EXISTING DE-WATERING WELL WITH PUMP -
CURRENTLY RUNNING

EXISTING DE-WATERING WELL WITH PUMP - INSTALLED

De-Watering Well Pumps That Are
Currently Installed and Not in Operation

#	Well I.D.
1	CV-114
2	CV-2206
3	CV-2301
4	CV-2303
5	CV-2306
6	CV-2426
7	CV-2464
8	CV-2468
9	CV-24148
10	CV-24167
11	CV-24197
12	CV-24212
13	CV-24213

SHEET TITLE:
EXISTING DE-WATERING WELL WITH PUMP MAP

PROJECT TITLE:

CHIQUITA CANYON LANDFILL
CASTAIC, CALIFORNIA

CLIENT:

CHIQUITA CANYON LANDFILL
CASTAIC, CALIFORNIA

SCS ENGINEERS
ENVIRONMENTAL CONSULTANTS

3000 KILBOY AIRPORT HWY., SUITE 300
LONG BEACH, CA 90806
PH: (562) 426-6544

PROJ. NO.
01204123.41

DSN. BY:
-

DWN. BY: SRM

CHK. BY: WCH

ACAD FILE:
F:\FIELD SERVICES

APP. BY:

WCH

DATE:
07/11/2025

SCALE:
AS SHOWN

SHEET:
1

GENERAL DRAWING NOTES:

1. EXISTING TOPOGRAPHIC SURVEY INFORMATION SHOWN WAS PROVIDED BY PROPELLOR. AERIAL PHOTOGRAPHY DATED JULY 09, 2025.
2. NORTH ARROW SHOWN HERE IS REFERENCE TO THE CALIFORNIA STATE PLANE ZONE V COORDINATE SYSTEM, NAD 83.
3. THE LOCATION OF ANY EXISTING GCCS COMPONENTS AND OTHER FEATURES ARE APPROXIMATE AND SHOULD BE USED FOR INFORMATION PURPOSES ONLY.
4. EXISTING GCCS AS-BUILT DATED JUNE 27, 2025.