


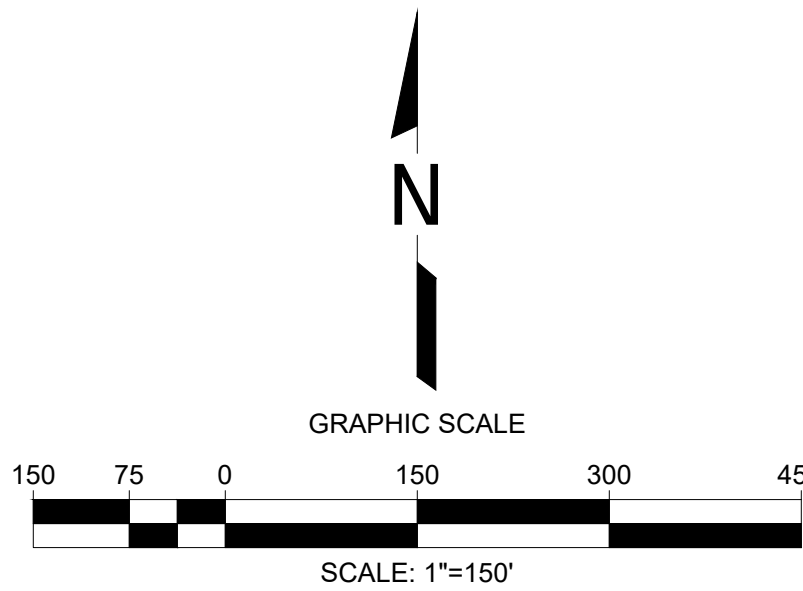

1-150		TOPOGRAPHIC CONTOUR
		EXISTING CELL LIMITS (APPROXIMATE)
	CV-XX	EXISTING LFG VERTICAL EXTRACTION WELL
	CV-XX PLG	EXISTING LFG VERTICAL EXTRACTION WELL - PRESSURIZED LEACHATE RELEASE
	BH-GB	EXISTING GABION LFG COLLECTOR WELL
	SW-XX	EXISTING SOIL VAPOR EXTRACTION WELL
	CV-XX	EXISTING LFG VERTICAL EXTRACTION WELL BELOW-GRADE
	FP-XX	EXISTING SURFACE COLLECTOR WELLHEAD
	HX-XX	EXISTING HORIZONTAL WELLS
	C-XX	EXISTING REMOTE VERTICAL WELLHEAD
	GP-XX	EXISTING PERIMETER MIGRATION PROBE
	TP-XX	EXISTING TEMPERATURE PROBE
		EXISTING ISOLATION VALVE
	AC	EXISTING ACTIVATED CARBON VESSEL
		EXISTING CONDENSATE SUMP
	36"	EXISTING 36" LFG COLLECTION HEADER PIPING
	30"	EXISTING 30" LFG COLLECTION HEADER PIPING
	24"	EXISTING 24" LFG COLLECTION HEADER PIPING
	20"	EXISTING 20" LFG COLLECTION HEADER PIPING
	18"	EXISTING 18" LFG COLLECTION HEADER PIPING
	12"	EXISTING 12" LFG COLLECTION HEADER PIPING
	10"	EXISTING 10" LFG COLLECTION HEADER PIPING
	8"	EXISTING 8" LFG COLLECTION LATERAL PIPING
	4/6"	EXISTING 4/6" LFG COLLECTION LATERAL PIPING
	2/3"	EXISTING 2/3" LFG COLLECTION LATERAL PIPING
		BELOW-GRADE PIPES ARE SHOWN DASHED
		REACTION AREA BOUNDARY (APPROXIMATE) - BASED ON DATA REVIEW
		EXISTING CAP

- GENERAL DRAWING NOTES:
1. EXISTING TOPOGRAPHIC SURVEY INFORMATION SHOWN WAS PROVIDED BY PROPELLOR. AERIAL PHOTOGRAPHY DATED JULY 09, 2025.
 2. NORTH ARROW SHOWN HERE IS REFERENCE TO THE CALIFORNIA STATE PLANE ZONE V COORDINATE SYSTEM, NAD 83.
 3. THE LOCATION OF ANY EXISTING PIPING, VALVES, TIE-IN LOCATIONS AND OTHER FEATURES ARE APPROXIMATE AND SHOULD BE USED FOR INFORMATION PURPOSES ONLY. ACTUAL FIELD CONDITIONS MAY VARY AND SUBJECT TO CHANGE BASED ON FUTURE PILL OPERATIONS, WASTE PLACEMENT, TOPOGRAPHIC FEATURES, AND OTHER SITE-SPECIFIC FACTORS.
 4. EXISTING GCCS AS-BUILT DATED JULY 23, 2025.