

From: Medina, Steven <SMedina@scsengineers.com>
Sent: Friday, August 29, 2025 4:55 PM
To: bchen@aqmd.gov; ndickel@aqmd.gov; Christina Ojeda
Cc: Han, Jessie; Steve Cassulo; Haley, William (Bill); Amanda Froman; Michael Hearn; Nicole Ward; Christopher.Fear@WasteConnections.com; Viswanathan, Srividhya; Kate Logan; Mark.Adams
Subject: Re: Case No. 6177-4 Stipulated Order for Abatement - Weekly Pump Installation and operation update
Attachments: 2025 CCLF Existing De-Watering Well with Pump Map_2025-08-29.pdf

[EXTERNAL SENDER: Use caution with links/attachments]

All

In accordance with Condition 65 of the Modified Stipulated Order, below is the summary of the installation and operation of dewatering pumps for the Chiquita Canyon Landfill. This information is subject to change based on further review and verification.

During 08/22/2025 to 08/28/2025, Chiquita completed the installation of, and began operating during the day, three (3) pumps in a vertical LFG extraction well for a total of one hundred (100) pumps operating in vertical LFG extraction wells. Please refer to the attached, up-to-date map of LFG wells with operating pumps. Additionally, eight (8) pumps were taken offline last week in preparation for the deployment of the required EVOH liner, and three (3) new pumps became operational, leading to a net decrease of five (5) pumps. All three (3) wells were brought back online, the previously recorded installation date was used in the operational pump table.

During 08/29/2025 to 09/04/2025, given the number of dewatering pumps installed to date, and the maintenance associated with those pumps, Chiquita plans to install and begin operating an additional two (2) pumps in vertical LFG extraction wells in locations along the north and south slope of the reaction area. The pump installation locations for next week are subject to change due to weather and/or safety conditions.

STEVEN Ruben Medina, **E.I.T.**
Staff Professional
SCS Engineers
3900 Kilroy Airport Way, Suite 300
Long Beach, CA 90806
858-204-4342 (c)
SMedina@scsengineers.com


Driven by Client Success
www.scsengineers.com

*2024 Conrad Quality Focus
Award Recipient*




GENERAL DRAWING NOTES

1. EXISTING TOPOGRAPHIC SURVEY INFORMATION SHOWN WAS PROVIDED BY PROPELLOR. AERIAL PHOTOGRAPHY DATED AUGUST 13, 2025.
2. NORTH ARROW SHOWN HERE IS REFERENCE TO THE CALIFORNIA STATE PLANE ZONE V COORDINATE SYSTEM, NAD 83.
3. THE LOCATION OF ANY EXISTING GCCS COMPONENTS AND OTHER FEATURES ARE APPROXIMATE AND SHOULD BE USED FOR INFORMATION PURPOSES ONLY.
4. EXISTING GCCS AS-BUILT DATED AUGUST 29, 2025.

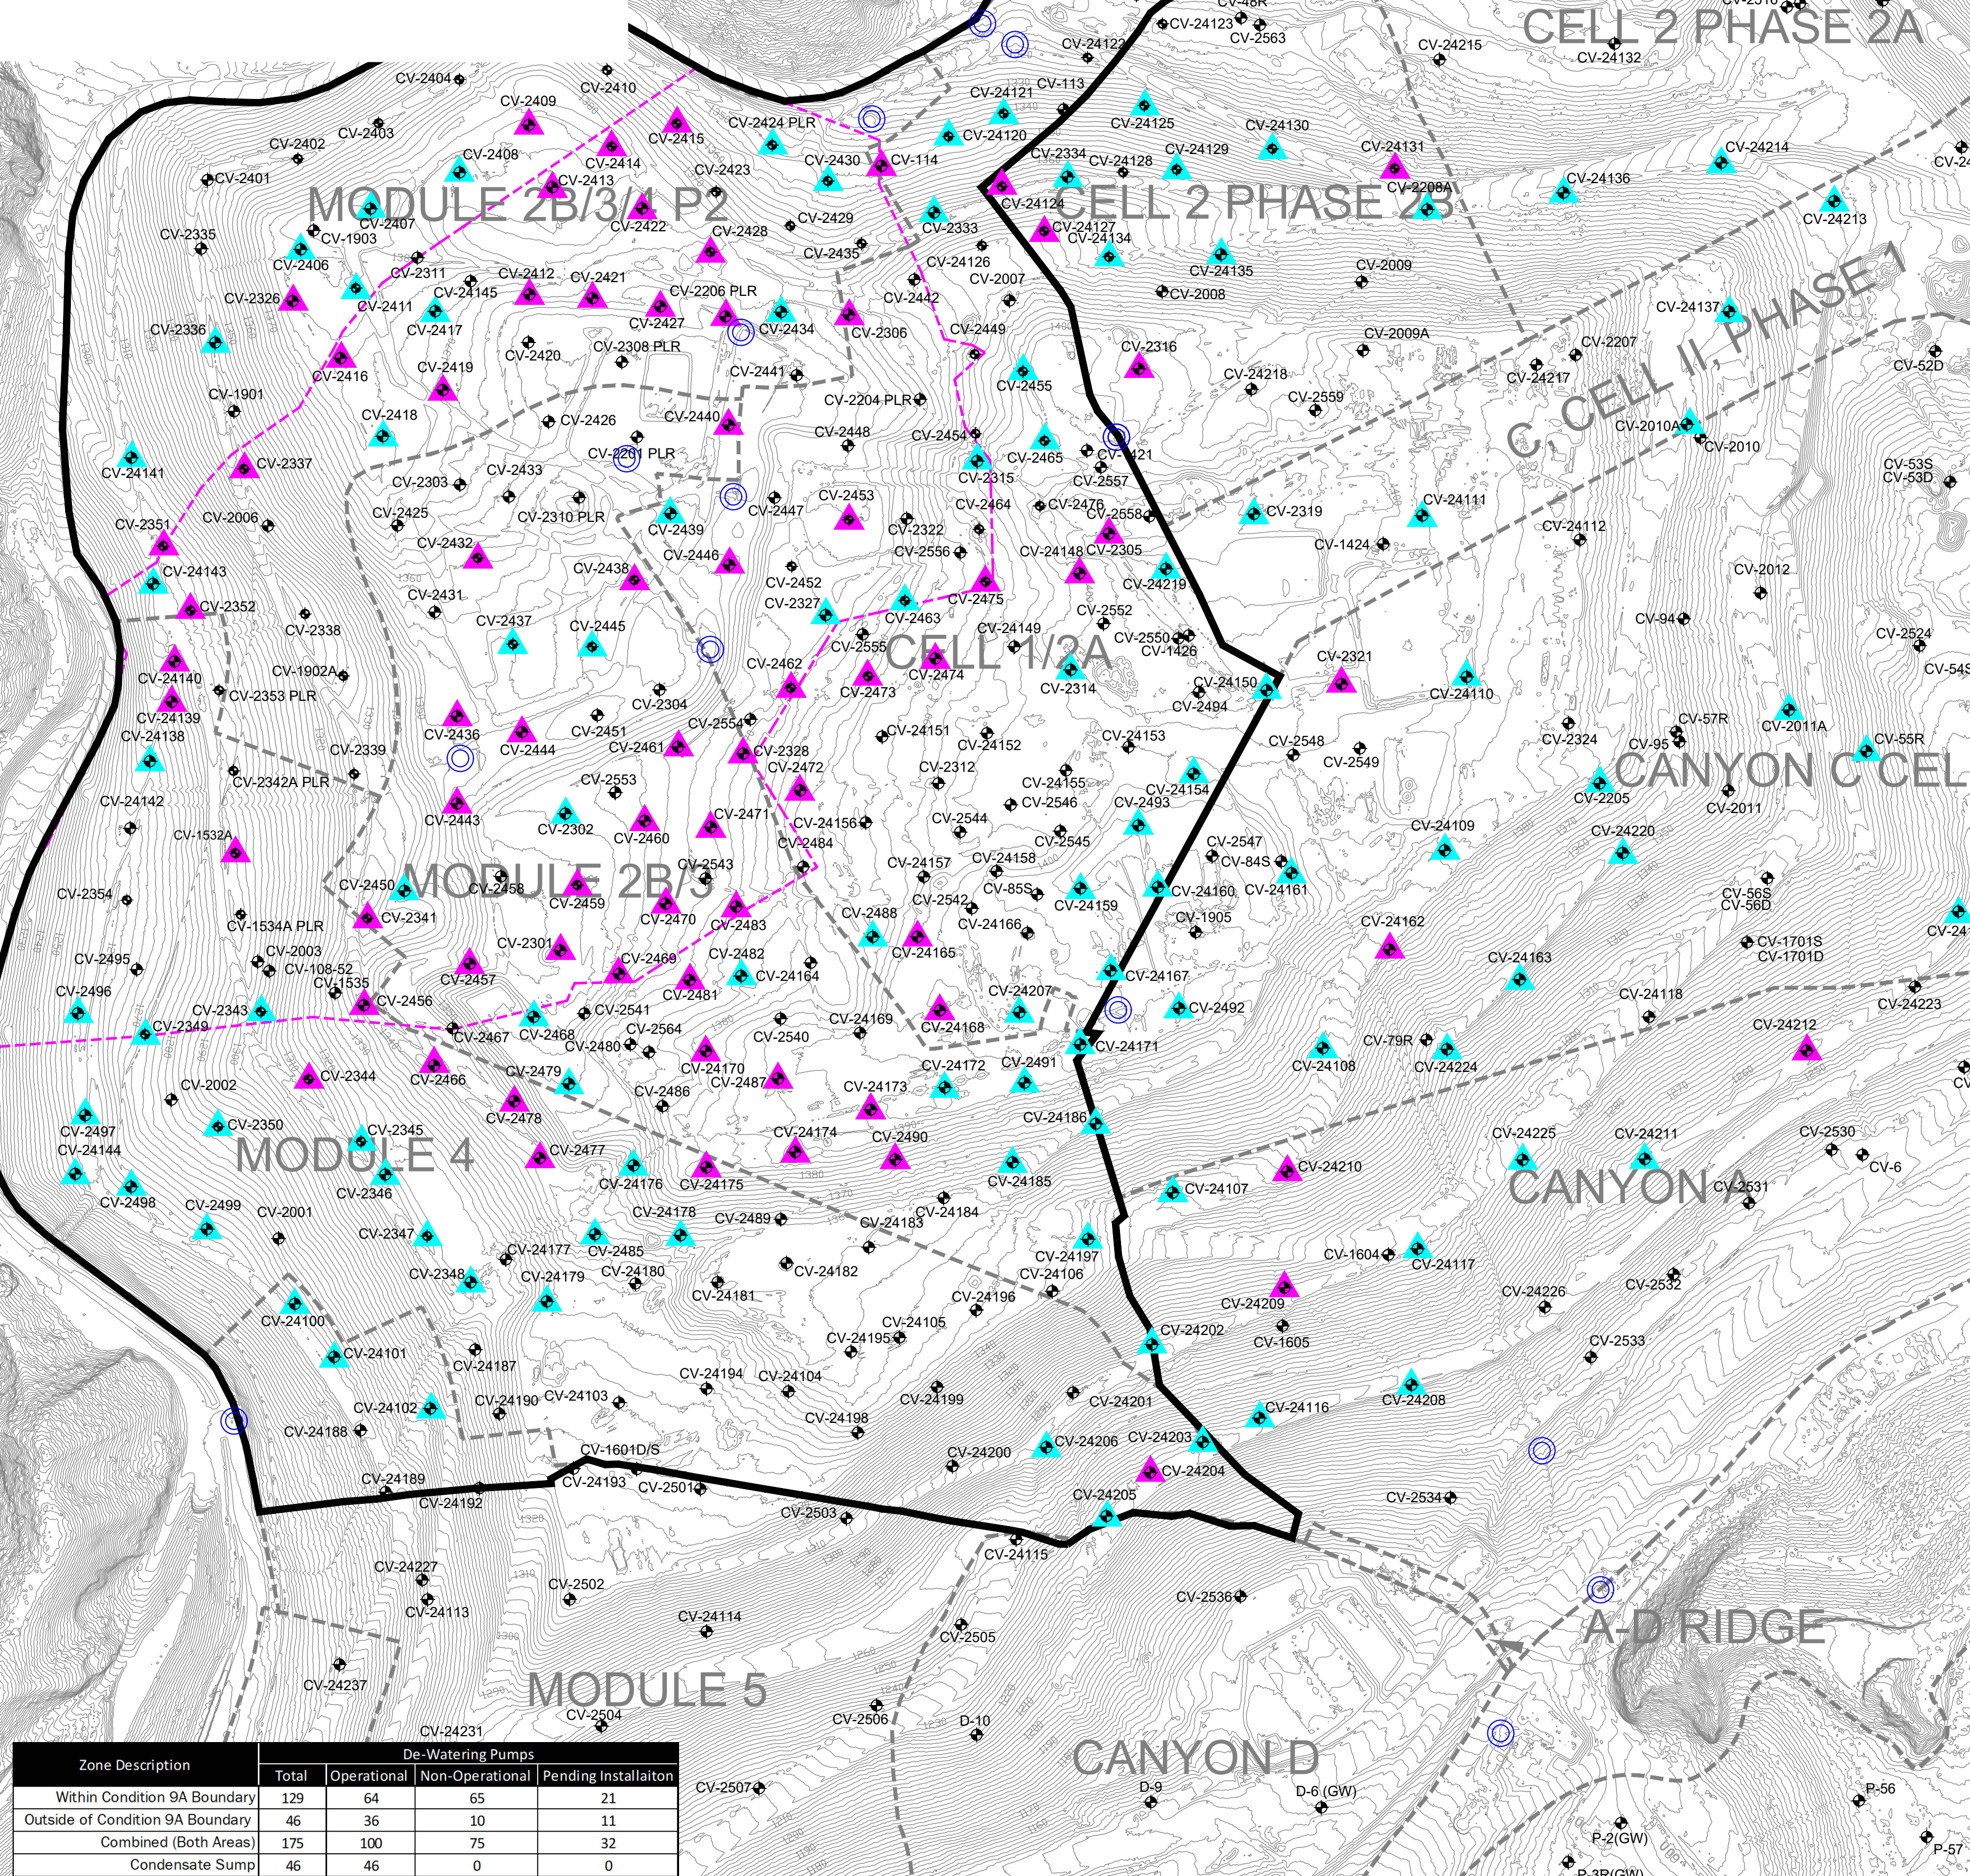

Zone Description	De-Watering Pumps			
	Total	Operational	Non-Operational	Pending Installation
Within Condition 9A Boundary	129	64	65	21
Outside of Condition 9A Boundary	46	36	10	11
Combined (Both Areas)	175	100	75	32
Condensate Sump	46	46	0	0

De-Watering Well Pumps that are Currently Running		
#	Well I.D.	Operational Start/Up Date
1	CV-2334	3/21/2024
2	CV-2424	3/21/2024
3	CV-2314	4/10/2024
4	CV-2336	4/23/2024
5	CV-24141	4/23/2024
6	CV-24144	5/13/2024
7	CV-2406	5/30/2024
8	CV-2496	5/30/2024
9	CV-2497	5/30/2024
10	CV-2408	5/31/2024
11	CV-2411	6/24/2024
12	CV-24102	7/3/2024
13	CV-24100	7/17/2024
14	CV-2499	7/17/2024
15	CV-2315	7/18/2024
16	CV-2498	7/18/2024
17	CV-24101	7/18/2024
18	CV-2343-PLR	7/18/2024
19	CV-2345	7/19/2024
20	CV-2348	7/22/2024
21	CV-2347	7/24/2024
22	CV-2346	7/25/2024
23	CV-2407	8/13/2024
24	CV-2417	8/13/2024
25	CV-2418	8/14/2024
26	CV-24121	8/23/2024
27	CV-2430	8/26/2024
28	CV-24125	8/30/2024
29	CV-24129	8/30/2024
30	CV-24130	8/30/2024
31	CV-24108	9/4/2024
32	CV-2349	9/4/2024
33	CV-2333	9/9/2024
34	CV-2482	9/10/2024
35	CV-2350	9/10/2024
36	CV-2463	9/26/2024
37	CV-2434	9/28/2024
38	CV-2437	10/1/2024
39	CV-2450	10/1/2024
40	CV-2488	10/15/2024
41	CV-2327	12/3/2024
42	CV-2445	1/6/2025
43	CV-24116	1/10/2025
44	CV-24203	1/10/2025
45	CV-24205	1/10/2025
46	CV-24208	1/10/2025
47	CV-24163	1/14/2025
48	CV-24225	1/15/2025
49	CV-24117	1/17/2025
50	CV-2479	1/28/2025
51	CV-24206	2/20/2025
52	CV-24202	2/28/2025
53	CV-2455	3/11/2025
54	CV-24197	3/11/2025
55	CV-24107	3/21/2025
56	CV-24171	4/7/2025
57	CV-24134	4/9/2025
58	CV-24171	4/7/2025
59	CV-24135	4/11/2025
60	CV-24159	4/16/2025
61	CV-24154	4/17/2025
62	CV-2465	4/25/2025
63	CV-2208A	5/1/2025
64	CV-24136	5/1/2025
65	CV-24214	5/1/2025
66	CV-2493	5/6/2025
67	CV-24160	5/6/2025
68	CV-2492	5/7/2025
69	CV-2205	5/8/2025
70	CV-24161	5/8/2025
71	CV-24172	5/8/2025
72	CV-24167	5/8/2025
73	CV-2468	5/9/2025
74	CV-24224	5/12/2025
75	CV-24119	5/14/2025
76	CV-24211	5/15/2025
77	CV-24137	5/15/2025
78	CV-2011A	5/20/2025
79	CV-24207	6/9/2025
80	CV-24222	6/10/2025
81	CV-24186	6/10/2025
82	CV-2010A	6/11/2025
83	CV-24143	6/12/2025
84	CV-2439	6/12/2025
85	CV-24111	6/16/2025
86	CV-24220	6/16/2025
87	CV-24150	6/20/2025
88	CV-55R	6/23/2025
89	CV-2319	7/9/2025
90	CV-24213	7/9/2025
91	CV-24219	7/9/2025
92	CV-24185	7/14/2025
93	CV-24110	7/17/2025
94	CV-24138	7/28/2025
95	CV-2485	8/7/2025
96	CV-24176	8/7/2025
97	CV-24120	8/8/2025
98	CV-24178	8/8/2025
99	CV-24179	8/8/2025
100	CV-2492	N/A

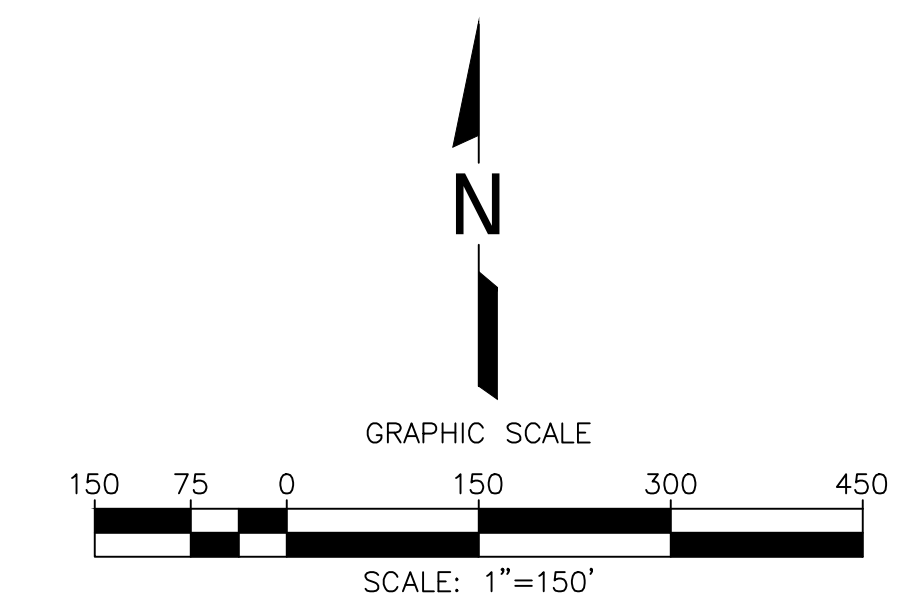

LEGEND

- | | |
|--|---|
| | TOPOGRAPHIC CONTOUR |
| | EXISTING CELL LIMITS (APPROXIMATE) |
| | REACTION AREA BOUNDARY - CONDITION 9A |
| | REACTION AREA BOUNDARY - DATA ANALYSIS |
| | EXISTING VERTICAL LFG EXTRACTION WELL |
| | EXISTING LFG VERTICAL EXTRACTION WELL -
PRESSURIZED LEACHATE RELEASE |
| | EXISTING CONDENSATE SUMP WITH PUMP |
| | EXISTING DE-WATERING WELL WITH PUMP -
CURRENTLY RUNNING |
| | EXISTING DE-WATERING WELL WITH PUMP - INSTALLED |

#	Well ID
1	CV-114
2	CV-1532A-PLR
3	CV-2206
4	CV-2301
5	CV-2302
6	CV-2305
7	CV-2306
8	CV-2316
9	CV-2321
10	CV-2326
11	CV-2328
12	CV-2337
13	CV-2341
14	CV-2344
15	CV-2351
16	CV-2352
17	CV-2409
18	CV-2411
19	CV-2412
20	CV-2413
21	CV-2415
22	CV-2422
23	CV-2414-PLR
24	CV-2416
25	CV-2419
26	CV-2421
27	CV-2427
28	CV-2428
29	CV-2433
30	CV-2436
31	CV-2438
32	CV-2440
33	CV-2443
34	CV-2444
35	CV-2446
36	CV-2453
37	CV-2456
38	CV-2457
39	CV-2459
40	CV-2460
41	CV-2461
42	CV-2462
43	CV-2465
44	CV-2469
45	CV-2470
46	CV-2472
47	CV-2472
48	CV-2473
49	CV-2474
50	CV-2475
51	CV-2477
52	CV-2478
53	CV-2481
54	CV-2483
55	CV-2487
56	CV-2490
57	CV-2492
58	CV-2499
59	CV-24124
60	CV-24127
61	CV-24131
62	CV-24139
63	CV-24140
64	CV-24148
65	CV-24152
66	CV-24165
67	CV-24168
68	CV-24170
69	CV-24173
70	CV-24174
71	CV-24175
72	CV-24204
73	CV-24209
74	CV-24210
75	CV-24212

SCS ENGINEERS ENVIRONMENTAL CONSULTANTS 3900 KILROY AVENUE, SUITE 300 COLLETON, CA 95926 PH: (916) 433-0044				CLIENT: CHIQUITA CANYON LANDFILL CASTAIC, CALIFORNIA		SHEET TITLE: EXISTING DE-WATERING WELL WITH PUMP MAP PROJECT TITLE: CHIQUITA CANYON LANDFILL CASTAIC, CALIFORNIA		NO. REVISION DATE	
DATE: 08/29/2025		DWN. BY: SRM 012044123.41		ACAD. FILE: F:\FIELD SERVICES		CHK. BY: WCH		DATE	
SCALE: AS SHOWN		DSN. BY:		APP. BY:		WCH		DATE	
SHEET: 1									