

From: Han, Jessie <JHan@scsengineers.com>
Sent: Friday, September 5, 2025 4:37 PM
To: bchen@aqmd.gov; ndickel@aqmd.gov; Christina Ojeda
Cc: Steve Cassulo; Haley, William (Bill); Amanda Froman; Michael Hearn; Nicole Ward; Christopher.Fear@WasteConnections.com; Viswanathan, Srividhya; Kate Logan; Mark.Adams; Medina, Steven
Subject: RE: Case No. 6177-4 Stipulated Order for Abatement - Weekly Pump Installation and operation update
Attachments: 2025 CCLF Existing De-Watering Well with Pump Map_2025-09-05.pdf

[EXTERNAL SENDER: Use caution with links/attachments]

Hi All,

In accordance with Condition 65 of the Modified Stipulated Order, below is the summary of the installation and operation of dewatering pumps for the Chiquita Canyon Landfill. This information is subject to change based on further review and verification.

During 08/29/2025 to 09/04/2025, Chiquita completed the installation of, and began operating during the day, three (3) pumps in a vertical LFG extraction well for a total of one hundred and six (106) pumps operating in vertical LFG extraction wells. Please refer to the attached, up-to-date map of LFG wells with operating pumps. The number of pumps installed and operational has been adjusted after further review and verification and in part due to typical maintenance.

During 09/05/2025 to 09/11/2025, given the number of dewatering pumps installed to date, and the maintenance associated with those pumps, Chiquita plans to install and begin operating an additional two (2) pumps in vertical LFG extraction wells in locations along the north and south slope of the reaction area. The pump installation locations for next week are subject to change due to weather and/or safety conditions.


Jessie Han
Project Manager
SCS Engineers
3900 Kilroy Airport Way, Suite 300
Long Beach, CA 90806
Mobile: 562-508-2497
JHan@scsengineers.com

Driven by Client Success
www.scsengineers.com


1. EXISTING TOPOGRAPHIC SURVEY INFORMATION SHOWN WAS PROVIDED BY PROPELLOR. AERIAL PHOTOGRAPHY DATED AUGUST 13, 2025.
2. NORTH ARROW SHOWN HERE IS REFERENCE TO THE CALIFORNIA STATE PLANE ZONE V COORDINATE SYSTEM, NAD 83.
3. THE LOCATION OF ANY EXISTING GCCS COMPONENTS AND OTHER FEATURES ARE APPROXIMATE AND SHOULD BE USED FOR INFORMATION PURPOSES ONLY.
4. EXISTING GCCS AS-BUILT DATED AUGUST 29, 2025.

Zone Description	De-Watering Pumps			
	Total	Operational	Non-Operational	Pending Installation
Within Condition 9A Boundary	135	71	64	21
Outside of Condition 9A Boundary	43	35	8	11
Combined (Both Areas)	178	106	72	32
Condensate Sump	46	46	0	0

De-Watering Well Pumps that are Currently Running		
#	Well I.D.	Operational Startup Date
1	CV-2334	3/21/2024
2	CV-2424	3/21/2024
3	CV-2314	4/10/2024
4	CV-2336	4/23/2024
5	CV-24141	4/23/2024
6	CV-24144	5/13/2024
7	CV-2406	5/30/2024
8	CV-2496	5/30/2024
9	CV-2497	5/30/2024
10	CV-2408	5/31/2024
11	CV-2411	6/24/2024
12	CV-24102	7/3/2024
13	CV-24162	7/7/2024
14	CV-24100	7/17/2024
15	CV-2499	7/17/2024
16	CV-2315	7/18/2024
17	CV-2498	7/18/2024
18	CV-24101	7/18/2024
19	CV-2343-PLR	7/18/2024
20	CV-2345	7/19/2024
21	CV-2348	7/22/2024
22	CV-2347	7/24/2024
23	CV-2346	7/25/2024
24	CV-2407	8/13/2024
25	CV-2417	8/13/2024
26	CV-2418	8/14/2024
27	CV-24121	8/23/2024
28	CV-2430	8/26/2024
29	CV-24125	8/30/2024
30	CV-24129	8/30/2024
31	CV-24130	8/30/2024
32	CV-24108	9/4/2024
33	CV-2349	9/4/2024
34	CV-2333	9/9/2024
35	CV-2482	9/10/2024
36	CV-2350	9/10/2024
37	CV-2463	9/26/2024
38	CV-2434	9/28/2024
39	CV-2437	10/1/2024
40	CV-2450	10/1/2024
41	CV-2488	10/15/2024
42	CV-2327	12/3/2024
43	CV-2445	1/6/2025
44	CV-24116	1/10/2025
45	CV-24203	1/10/2025
46	CV-24205	1/10/2025
47	CV-24208	1/10/2025
48	CV-24163	1/14/2025
49	CV-24225	1/15/2025
50	CV-24117	1/17/2025
51	CV-2479	1/28/2025
52	CV-24206	2/20/2025
53	CV-24202	2/28/2025
54	CV-2455	3/11/2025
55	CV-24197	3/11/2025
56	CV-24107	3/21/2025
57	CV-24171	4/7/2025
58	CV-24134	4/9/2025
59	CV-24135	4/11/2025
60	CV-24159	4/16/2025
61	CV-24154	4/17/2025
62	CV-2465	4/25/2025
63	CV-2208A	5/1/2025
64	CV-24136	5/1/2025
65	CV-24214	5/1/2025
66	CV-2493	5/6/2025
67	CV-24160	5/6/2025
68	CV-2492	5/7/2025
69	CV-2205	5/8/2025
70	CV-24161	5/8/2025
71	CV-24172	5/8/2025
72	CV-24167	5/8/2025
73	CV-2468	5/9/2025
74	CV-24224	5/12/2025
75	CV-24119	5/14/2025
76	CV-24211	5/15/2025
77	CV-24137	5/15/2025
78	CV-2011A	5/20/2025
79	CV-24207	6/9/2025
80	CV-24222	6/10/2025
81	CV-24186	6/10/2025
82	CV-2010A	6/11/2025
83	CV-24143	6/12/2025
84	CV-2439	6/12/2025
85	CV-24111	6/16/2025
86	CV-24220	6/16/2025
87	CV-24150	6/20/2025
88	CV-55R	6/23/2025
89	CV-2319	7/9/2025
90	CV-24213	7/9/2025
91	CV-24219	7/9/2025
92	CV-24185	7/14/2025
93	CV-24090	7/14/2025
94	CV-24110	7/17/2025
95	CV-2007	7/23/2025
96	CV-24138	7/28/2025
97	CV-2485	8/7/2025
98	CV-24176	8/7/2025
99	CV-24091	8/7/2025
100	CV-24120	8/8/2025
101	CV-24178	8/8/2025
102	CV-24179	8/8/2025
103	CV-24180	8/15/2025
104	CV-24118	9/2/2025
105	CV-24148	9/4/2025
106	CV-24089	9/4/2025

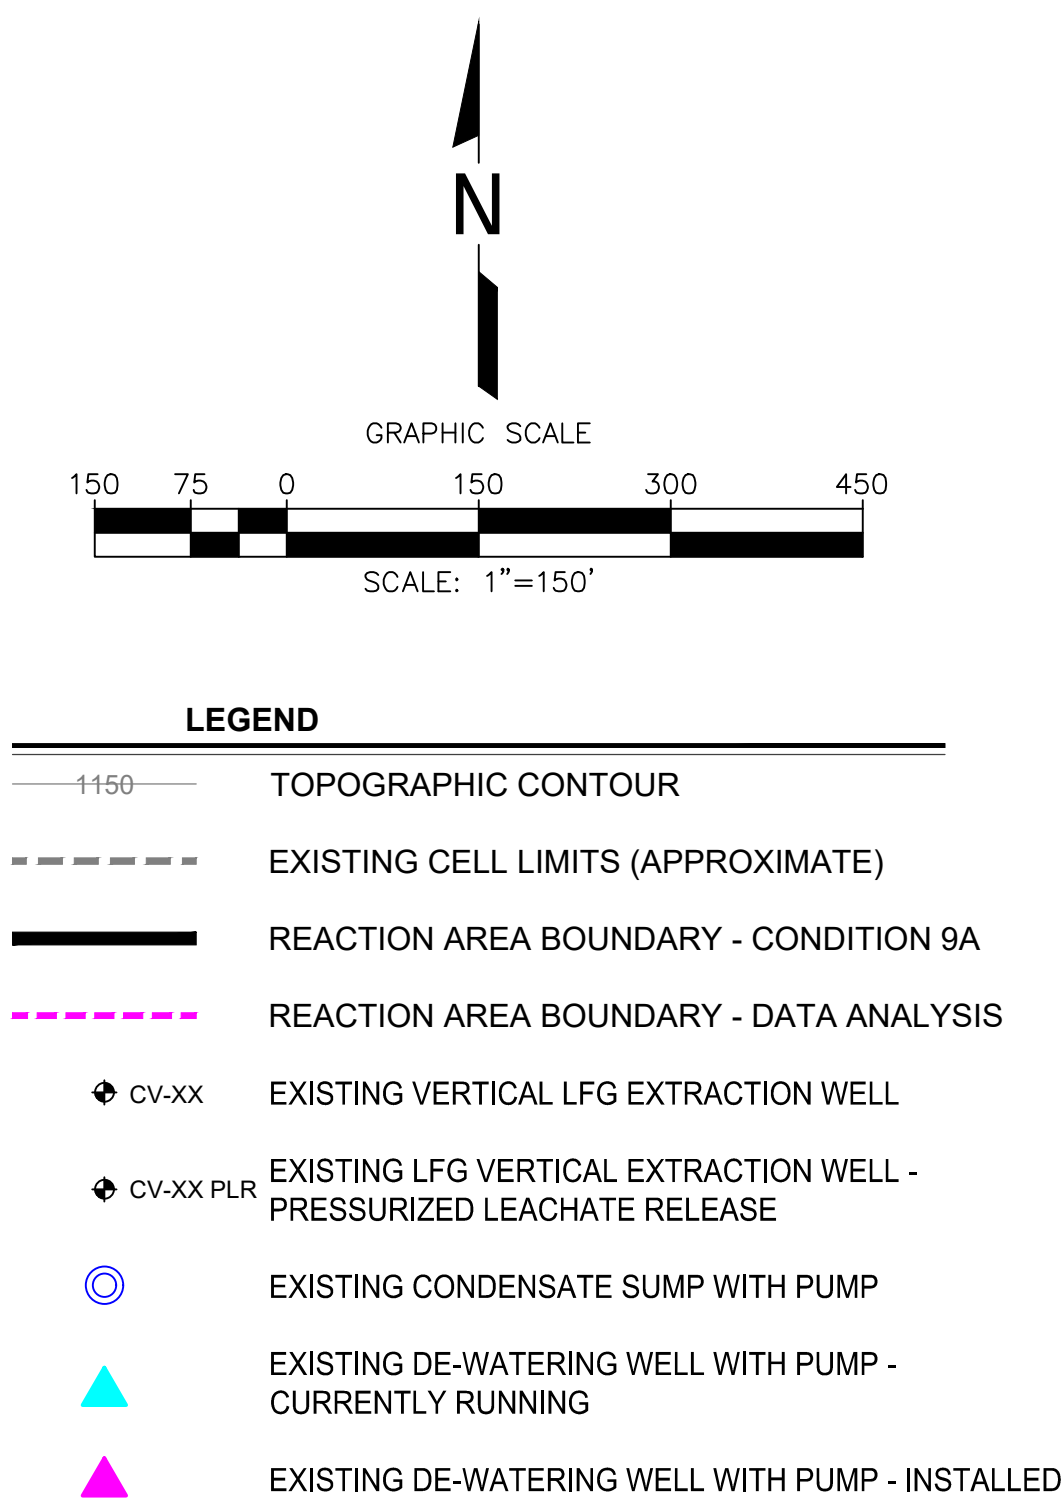

#	Well I.D.
1	CV-114
2	CV-1532A-PLR
3	CV-2206
4	CV-2301
5	CV-2302
6	CV-2305
7	CV-2308
8	CV-2316
9	CV-2321
10	CV-2326
11	CV-2328
12	CV-2337
13	CV-2341
14	CV-2444
15	CV-2352
16	CV-2409
17	CV-2411
18	CV-2412
19	CV-2413
20	CV-2415
21	CV-2422
22	CV-2414-PLR
23	CV-2416
24	CV-2419
25	CV-2421
26	CV-2427
27	CV-2428
28	CV-2432
29	CV-2436
30	CV-2438
31	CV-2440
32	CV-2443
33	CV-2444
34	CV-2446
35	CV-2453
36	CV-2456
37	CV-2457
38	CV-2459
39	CV-2460
40	CV-2461
41	CV-2462
42	CV-2466
43	CV-2469
44	CV-2470
45	CV-2471
46	CV-2472
47	CV-2473
48	CV-2474
49	CV-2475
50	CV-2477
51	CV-2478
52	CV-2481
53	CV-2483
54	CV-2487
55	CV-2490
56	CV-2492
57	CV-24109
58	CV-24124
59	CV-24127
60	CV-24131
61	CV-24139
62	CV-24140
63	CV-24148
64	CV-24162
65	CV-24165
66	CV-24168
67	CV-24170
68	CV-24173
69	CV-24175
70	CV-24209
71	CV-24210
72	CV-24212

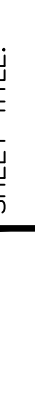SCS ENGINEERS ENVIRONMENTAL CONSULTANTS 3900 KILROY AIRPORT WAY, SUITE 300 CONCORD, CA 94606 PH: (925) 469-8441		CLIENT:  CHIQUITA CANYON LANDFILL CASTAIC, CALIFORNIA		SHEET TITLE: EXISTING DE-WATERING WELL WITH PUMP MAP		NO.		REVISION		DATE	
DATE: 09/05/2025		DWN. BY: SRM CHK. BY: WCH		ACAD. FILE: F:\FIELD SERVICES		PROJECT TITLE: CHIQUITA CANYON LANDFILL CASTAIC, CALIFORNIA		☐		☐	
SCALE: AS SHOWN		PROJ. NO.: 01204123-41 DSN. BY:		APP. BY:		☐		☐		☐	
SHEET: 1		WCH		WCH		☐		☐		☐	