

From: Medina, Steven <SMedina@scsengineers.com>
Sent: Friday, September 19, 2025 1:48 PM
To: bchen@aqmd.gov; ndickel@aqmd.gov; Christina Ojeda
Cc: Han, Jessie; Steve Cassulo; Haley, William (Bill); Amanda Froman; Michael Hearn; Nicole Ward; Christopher.Fear@WasteConnections.com; Viswanathan, Srividhya; Kate Logan; Mark.Adams
Subject: Re: Case No. 6177-4 Stipulated Order for Abatement - Weekly Pump Installation and operation update
Attachments: 2025 CCLF Existing De-Watering Well with Pump Map_2025-09-19.pdf

[EXTERNAL SENDER: Use caution with links/attachments]

All,

In accordance with Condition 65 of the Modified Stipulated Order, below is the summary of the installation and operation of dewatering pumps for the Chiquita Canyon Landfill. This information is subject to change based on further review and verification.

During 09/12/2025 to 09/18/2025, Chiquita completed the installation of, and began operating during the day, eight (8) pumps in a vertical LFG extraction well for a total of one hundred and twelve (112) pumps operating in vertical LFG extraction wells. Additionally, two (2) pumps were taken offline last week, and eight (8) new pumps became operational, leading to a net increase of six (6) pumps. Please refer to the attached, up-to-date map of LFG wells with operating pumps.

During 09/19/2025 to 09/25/2025, given the number of dewatering pumps installed to date, and the maintenance associated with those pumps, Chiquita plans to install and begin operating an additional four (4) pumps in vertical LFG extraction wells in locations along the north and south slope of the reaction area. The pump installation locations for next week are subject to change due to weather and/or safety conditions.

Regards,

STEVEN Ruben Medina, **E.I.T.**

Staff Professional

SCS Engineers

3900 Kilroy Airport Way, Suite 300

Long Beach, CA 90806

858-204-4342 (c)

SMedina@scsengineers.com

Driven by Client Success

www.scsengineers.com

*2024 Conrad Quality Focus
Award Recipient*



GENERAL DRAWING NOTES:


1. EXISTING TOPOGRAPHIC SURVEY INFORMATION SHOWN WAS PROVIDED BY PROPELLOR. AERIAL PHOTOGRAPHY DATED SEPTEMBER 10, 2025.

2. NORTH ARROW SHOWN HERE IS REFERENCE TO THE CALIFORNIA STATE PLANE ZONE V COORDINATE SYSTEM, NAD 83.

3. THE LOCATION OF ANY EXISTING GCCS COMPONENTS AND OTHER FEATURES ARE APPROXIMATE AND SHOULD BE USED FOR INFORMATION PURPOSES ONLY.

4. EXISTING GCCS AS-BUILT DATED SEPTEMBER 19, 2025.

A
B
C
D
E
F
G
H
I
J

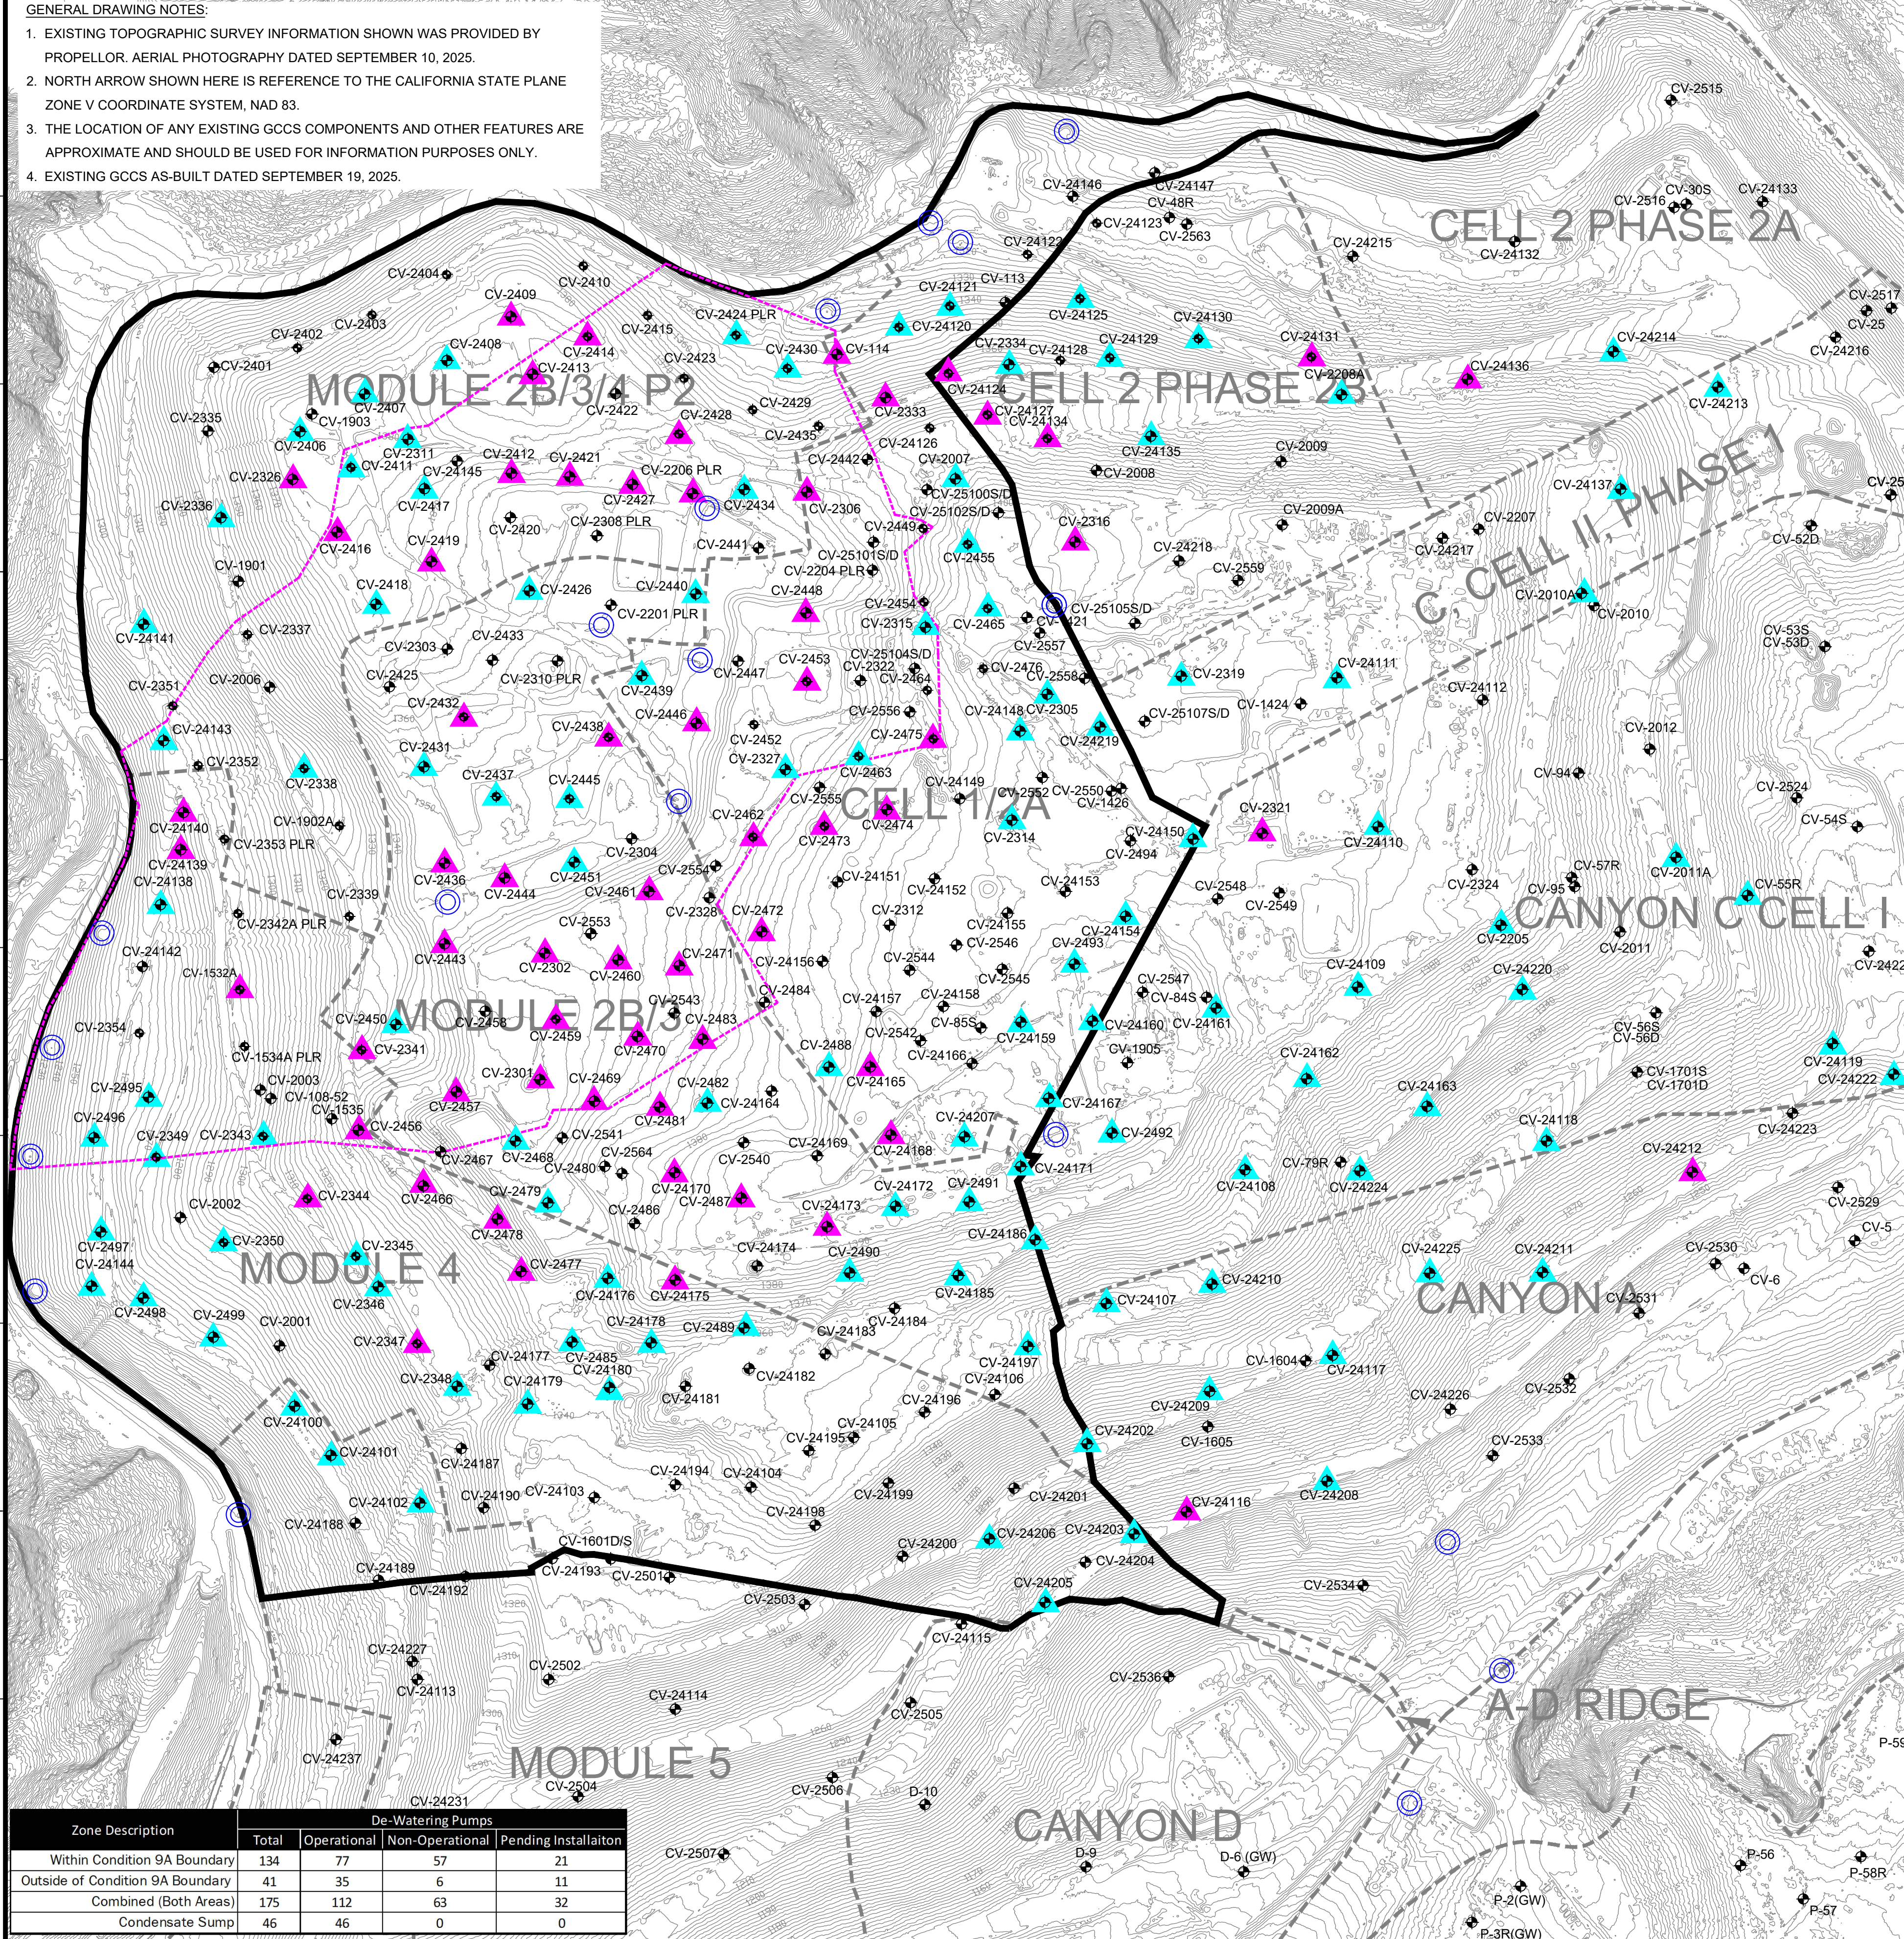

De-Watering Well Pumps that are Currently Running		
#	Well I.D.	Operational Startup Date
1	CV-2334	3/21/2024
2	CV-2424	3/21/2024
3	CV-2314	4/10/2024
4	CV-2336	4/23/2024
5	CV-24141	4/23/2024
6	CV-24144	5/13/2024
7	CV-2406	5/30/2024
8	CV-2496	5/30/2024
9	CV-2497	5/30/2024
10	CV-2408	5/31/2024
11	CV-2411	6/24/2024
12	CV-24102	7/3/2024
13	CV-24109	7/3/2024
14	CV-24162	7/7/2024
15	CV-24100	7/17/2024
16	CV-2499	7/17/2024
17	CV-2315	7/18/2024
18	CV-2498	7/18/2024
19	CV-24101	7/18/2024
20	CV-2343-PLR	7/18/2024
21	CV-2345	7/19/2024
22	CV-2348	7/22/2024
23	CV-2346	7/25/2024
24	CV-2407	8/13/2024
25	CV-2417	8/13/2024
26	CV-2418	8/14/2024
27	CV-24121	8/23/2024
28	CV-2430	8/26/2024
29	CV-24125	8/30/2024
30	CV-24129	8/30/2024
31	CV-24130	8/30/2024
32	CV-24108	9/4/2024
33	CV-2349	9/4/2024
34	CV-2495	9/10/2024
35	CV-2482	9/10/2024
36	CV-2350	9/10/2024
37	CV-24210	9/10/2024
38	CV-2463	9/26/2024
39	CV-2434	9/28/2024
40	CV-2437	10/1/2024
41	CV-2450	10/1/2024
42	CV-2488	10/15/2024
43	CV-2327	12/3/2024
44	CV-2451	12/23/2024
45	CV-2445	1/6/2025
46	CV-24203	1/10/2025
47	CV-24205	1/10/2025
48	CV-24208	1/10/2025
49	CV-24163	1/14/2025
50	CV-24225	1/15/2025
51	CV-24117	1/17/2025
52	CV-2479	1/28/2025
53	CV-2338	2/8/2025
54	CV-24206	2/20/2025
55	CV-24202	2/28/2025
56	CV-24209	2/28/2025
57	CV-2455	3/11/2025
58	CV-24197	3/11/2025
59	CV-24107	3/21/2025
60	CV-24171	4/7/2025
61	CV-24135	4/11/2025
62	CV-24159	4/16/2025
63	CV-24154	4/17/2025
64	CV-2465	4/25/2025
65	CV-2208A	5/1/2025
66	CV-24214	5/1/2025
67	CV-2493	5/6/2025
68	CV-24160	5/6/2025
69	CV-2492	5/7/2025
70	CV-2205	5/8/2025
71	CV-24161	5/8/2025
72	CV-24172	5/8/2025
73	CV-24167	5/8/2025
74	CV-2468	5/9/2025
75	CV-24224	5/12/2025
76	CV-24119	5/14/2025
77	CV-24211	5/15/2025
78	CV-24137	5/15/2025
79	CV-2011A	5/20/2025
80	CV-24207	6/9/2025
81	CV-24222	6/10/2025
82	CV-24186	6/10/2025
83	CV-2010A	6/11/2025
84	CV-24143	6/12/2025
85	CV-2439	6/12/2025
86	CV-24111	6/16/2025
87	CV-24220	6/16/2025
88	CV-24150	6/20/2025
89	CV-55R	6/23/2025
90	CV-2319	7/9/2025
91	CV-24213	7/9/2025
92	CV-24219	7/9/2025
93	CV-24185	7/14/2025
94	CV-2490	7/14/2025
95	CV-24110	7/17/2025
96	CV-2007	7/23/2025
97	CV-24138	7/28/2025
98	CV-2485	8/7/2025
99	CV-24176	8/7/2025
100	CV-2491	8/7/2025
101	CV-24120	8/8/2025
102	CV-24178	8/8/2025
103	CV-24179	8/8/2025
104	CV-24180	8/15/2025
105	CV-24118	9/2/2025
106	CV-24148	9/4/2025
107	CV-2489	9/4/2025
108	CV-2305	9/8/2025
109	CV-2311	9/15/2025
110	CV-2440	9/15/2025
111	CV-2426	9/18/2025
112	CV-2431	9/18/2025

GRAPHIC SCALE

150 75 0 150 300 450

SCALE: 1"=150'

LEGEND

1150 TOPOGRAPHIC CONTOUR

--- EXISTING CELL LIMITS (APPROXIMATE)

--- REACTION AREA BOUNDARY - CONDITION 9A

--- REACTION AREA BOUNDARY - DATA ANALYSIS

CV-XX EXISTING VERTICAL LFG EXTRACTION WELL

CV-XX PLR EXISTING LFG VERTICAL EXTRACTION WELL - PRESSURIZED LEACHATE RELEASE

EXISTING CONDENSATE SUMP WITH PUMP

EXISTING DE-WATERING WELL WITH PUMP - CURRENTLY RUNNING

EXISTING DE-WATERING WELL WITH PUMP - INSTALLED

De-Watering Well Pumps That Are Currently Installed and Not in Operation	
#	Well I.D.
1	CV-114
2	CV-1532A-PLR
3	CV-2206
4	CV-2301
5	CV-2302
6	CV-2306
7	CV-2316
8	CV-2321
9	CV-2326
10	CV-2333
11	CV-2341
12	CV-2344
13	CV-2347
14	CV-2409
15	CV-2412
16	CV-2413
17	CV-2414-PLR
18	CV-2416
19	CV-2419
20	CV-2421
21	CV-2427
22	CV-2428
23	CV-2432
24	CV-2436
25	CV-2438
26	CV-2443
27	CV-2444
28	CV-2446
29	CV-2448
30	CV-2453
31	CV-2456
32	CV-2457
33	CV-2459
34	CV-2460
35	CV-2461
36	CV-2462
37	CV-2466
38	CV-2469
39	CV-2470
40	CV-2471
41	CV-2472
42	CV-2473
43	CV-2474
44	CV-2475
45	CV-2477
46	CV-2478
47	CV-2481
48	CV-2483
49	CV-2487
50	CV-24116
51	CV-24124
52	CV-24127
53	CV-24131
54	CV-24134
55	CV-24136
56	CV-24139
57	CV-24140
58	CV-24165
59	CV-24168
60	CV-24170
61	CV-24173
62	CV-24175
63	CV-24212

Zone Description	De-Watering Pumps			
	Total	Operational	Non-Operational	Pending Installation
Within Condition 9A Boundary	134	77	57	21
Outside of Condition 9A Boundary	41	35	6	11
Combined (Both Areas)	175	112	63	32
Condensate Sump	46	46	0	0

DATE

REVISION

NO

SHEET TITLE: EXISTING DE-WATERING WELL WITH PUMP MAP

PROJECT TITLE: CHIQUITA CANYON LANDFILL CASTAIC, CALIFORNIA

CLIENT: CHIQUITA CANYON LANDFILL CASTAIC, CALIFORNIA

SCS ENGINEERS ENVIRONMENTAL CONSULTANTS

15000 S. MAIN ST., SUITE 300
LONG BEACH, CA 90806
PH: (562) 426-9544

DATE: 09/19/2025

SCALE: AS SHOWN

SHEET: 1