

Archivado: Jueves 9 de octubre de 2025 1:45:25 PM

De: [Medina, Steven](#)

Enviado: Viernes 3 de octubre de 2025 1:57:32 PM

Para: bchen@aqmd.gov

Cc: [Han, Jessie](#)

Asunto: Ref.: Orden de Depuración Estipulada del Caso No. 6177-4 - Actualización sobre la Instalación y Operación Semanal de las Bombas

Importancia: Normal

Sensibilidad: Ninguna

Attachments: [image.png](#); [Outlook-g12wsp3s.png](#); [Outlook-i0rigy0y.png](#); [Outlook-0uw5inlg.png](#); [2025 CCLF Existing De- Watering Well with Pump Map_2025-10-03.pdf](#);

[REMITENTE EXTERNO: Tenga precaución con los enlaces/adjuntos]

Todos,

Según la Condición 65 de la Orden Estipulada Modificada, a continuación se encuentra el resumen de la instalación y operación de las bombas de desagüe para el Vertedero de Chiquita Canyon. Esta información está sujeta a cambios, en base a una mayor revisión y verificación.

Durante el período que transcurrió desde el 26/09/2025 hasta el 02/10/2025, Chiquita completó la instalación y comenzó a operar durante el día dos (2) bombas en pozos verticales de extracción de LFG dando un total de ciento diecinueve (119) bombas operado en pozos verticales de extracción de LFG. Por favor, consulte el mapa actualizado adjunto de los pozos de LFG con bombas operando.

Durante el período que va del 03/10/2025 hasta el 09/10/2025, dada la cantidad de bombas de desagüe instaladas hasta la fecha y el mantenimiento asociado a esas bombas, Chiquita tiene planeado instalar y comenzar a operar otras cuatro (4) bombas en pozos verticales de extracción de LFG en ubicaciones a lo largo de la pendiente norte y sur de la zona reactiva. Las ubicaciones de las instalaciones de las bombas para la semana que viene están sujetas a cambios debido a las condiciones climáticas y/o de seguridad.

Atentamente,

STEVEN Rubén Medina, **E.I.T.**

Personal Profesional

SCS Engineers

3900 Kilroy Airport Way, Suite 300

Long Beach, CA 90806

858-204-4342 (c)


SMedina@scsengineers.com

Dirigidos por el Éxito de los Clientes

www.scsengineers.com

GENERAL DRAWING NOTES:

- EXISTING TOPOGRAPHIC SURVEY INFORMATION SHOWN WAS PROVIDED BY PROPELLOR. AERIAL PHOTOGRAPHY DATED SEPTEMBER 10, 2025.
- NORTH ARROW SHOWN HERE IS REFERENCE TO THE CALIFORNIA STATE PLANE ZONE V COORDINATE SYSTEM, NAD 83.
- THE LOCATION OF ANY EXISTING GCCS COMPONENTS AND OTHER FEATURES ARE APPROXIMATE AND SHOULD BE USED FOR INFORMATION PURPOSES ONLY.
- EXISTING GCCS AS-BUILT DATED SEPTEMBER 26, 2025.

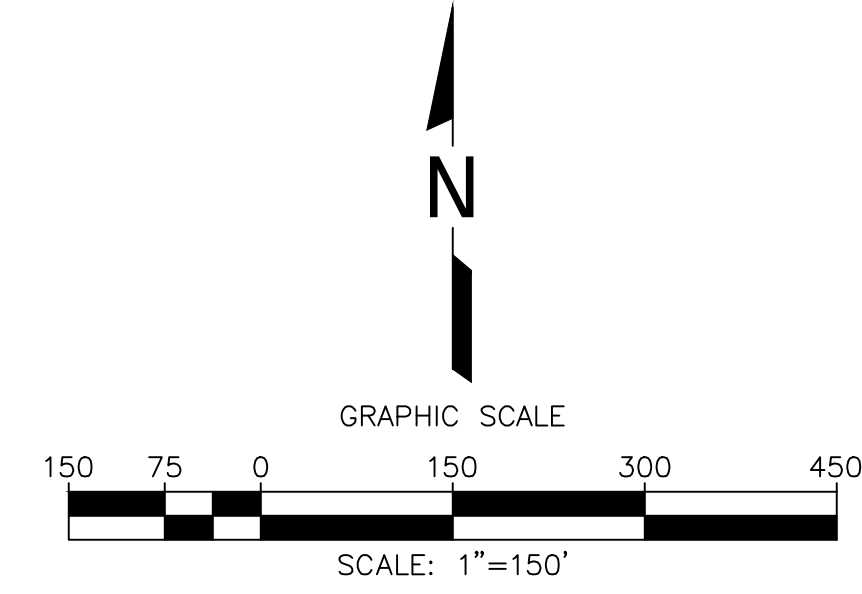

- LEGEND
- 1150 TOPOGRAPHIC CONTOUR
 - EXISTING CELL LIMITS (APPROXIMATE)
 - REACTION AREA BOUNDARY - CONDITION 9A
 - REACTION AREA BOUNDARY - DATA ANALYSIS
 - CV-xx EXISTING VERTICAL LFG EXTRACTION WELL
 - CV-xx PLR EXISTING LFG VERTICAL EXTRACTION WELL - PRESSURIZED LEACHATE RELEASE
 - EXISTING CONDENSATE SUMP WITH PUMP
 - EXISTING DE-WATERING WELL WITH PUMP - CURRENTLY RUNNING
 - EXISTING DE-WATERING WELL WITH PUMP - INSTALLED

De-Watering Well Pumps That Are Currently Installed and Not in Operation	
#	Well I.D.
1	CV-114
2	CV-1532A-PLR
3	CV-2206
4	CV-2301
5	CV-2302
6	CV-2306
7	CV-2316
8	CV-2321
9	CV-2326
10	CV-2341
11	CV-2344
12	CV-2347
13	CV-2412
14	CV-2416
15	CV-2421
16	CV-2427
17	CV-2428
18	CV-2432
19	CV-2436
20	CV-2438
21	CV-2443
22	CV-2446
23	CV-2448
24	CV-2453
25	CV-2456
26	CV-2457
27	CV-2459
28	CV-2460
29	CV-2461
30	CV-2462
31	CV-2466
32	CV-2469
33	CV-2470
34	CV-2471
35	CV-2472
36	CV-2473
37	CV-2474
38	CV-2475
39	CV-2477
40	CV-2478
41	CV-2481
42	CV-2483
43	CV-2487
44	CV-24116
45	CV-24124
46	CV-24131
47	CV-24134
48	CV-24136
49	CV-24139
50	CV-24165
51	CV-24168
52	CV-24170
53	CV-24173
54	CV-24175
55	CV-24212

Zone Description	De-Watering Pumps			
	Total	Operational	Non-Operational	Pending Installation
Within Condition 9A Boundary	134	84	50	21
Outside of Condition 9A Boundary	40	35	5	11
Combined (Both Areas)	174	119	55	32
Condensate Sump	46	46	0	0

DATE

REVISION

NO

SHEET TITLE:
EXISTING DE-WATERING WELL WITH PUMP MAP

PROJECT TITLE:
CHICUITA CANYON LANDFILL
CASTAIC, CALIFORNIA

CLIENT:
SCS ENGINEERS
ENVIRONMENTAL CONSULTANTS
15000 WILSON AVENUE, SUITE 300
LONG BEACH, CA 90806
PH: (562) 426-9544

DATE: 10/03/2025

SCALE: AS SHOWN

SHEET: 1

DATE

REVISION

NO

SHEET TITLE:
EXISTING DE-WATERING WELL WITH PUMP MAP

PROJECT TITLE:
CHICUITA CANYON LANDFILL
CASTAIC, CALIFORNIA

CLIENT:
SCS ENGINEERS
ENVIRONMENTAL CONSULTANTS
15000 WILSON AVENUE, SUITE 300
LONG BEACH, CA 90806
PH: (562) 426-9544

DATE: 10/03/2025

SCALE: AS SHOWN

SHEET: 1

C:\Users\5160sm\Desktop\VCCL MASTER GCCS & LMS ASBUT_2025-10-03.dwg Oct 13, 2025 - 12:15pm By: smedina