

Archived: Thursday, October 16, 2025 10:42:08 AM
From: [Medina, Steven](#)
Sent: Friday, October 10, 2025 12:40:26 PM
To: bchen@aqmd.gov
Cc: [Han, Jessie](#)
Subject: Re: Case No. 6177-4 Stipulated Order for Abatement - Weekly Pump Installation and operation update
Importance: Normal
Sensitivity: None
Attachments: [image.png](#) [Outlook-gl2wsp3s.png](#) [Outlook-i0rigy0y.png](#) [Outlook-0uw5inlg.png](#) [Outlook-o4w04kfh.png](#)
[2025 CCLF Existing De-Watering Well with Pump Map_2025-10-10.pdf](#)

[EXTERNAL SENDER: Use caution with links/attachments]

All,

In accordance with Condition 65 of the Modified Stipulated Order, below is the summary of the installation and operation of dewatering pumps for the Chiquita Canyon Landfill. This information is subject to change based on further review and verification.

During 10/03/2025 to 10/09/2025, Chiquita completed the installation of, and began operating during the day, ten (10) pumps in a vertical LFG extraction well for a total of one hundred and twenty-eight (128) pumps operating in vertical LFG extraction wells. Additionally, one (1) pump was taken offline last week, and ten (10) new pumps became operational, leading to a net increase of nine (9) pumps. Please refer to the attached, up-to-date map of LFG wells with operating pumps.

During 10/10/2025 to 10/16/2025, given the number of dewatering pumps installed to date, and the maintenance associated with those pumps, Chiquita plans to install and begin operating an additional four (4) pumps in vertical LFG extraction wells in locations along the north and south slope of the reaction area. The pump installation locations for next week are subject to change due to weather and/or safety conditions.

Regards,

STEVEN Ruben Medina, **E.I.T.**

Staff Professional

SCS Engineers

3900 Kilroy Airport Way, Suite 300

Long Beach, CA 90806

858-204-4342 (c)


SMedina@scsengineers.com

Driven by Client Success

www.scsengineers.com

□

- GENERAL DRAWING NOTES:
1. EXISTING TOPOGRAPHIC SURVEY INFORMATION SHOWN WAS PROVIDED BY PROPELLOR. AERIAL PHOTOGRAPHY DATED SEPTEMBER 24, 2025.
 2. NORTH ARROW SHOWN HERE IS REFERENCE TO THE CALIFORNIA STATE PLANE ZONE V COORDINATE SYSTEM, NAD 83.
 3. THE LOCATION OF ANY EXISTING GCCS COMPONENTS AND OTHER FEATURES ARE APPROXIMATE AND SHOULD BE USED FOR INFORMATION PURPOSES ONLY.
 4. EXISTING GCCS AS-BUILT DATED OCTOBER 10, 2025.

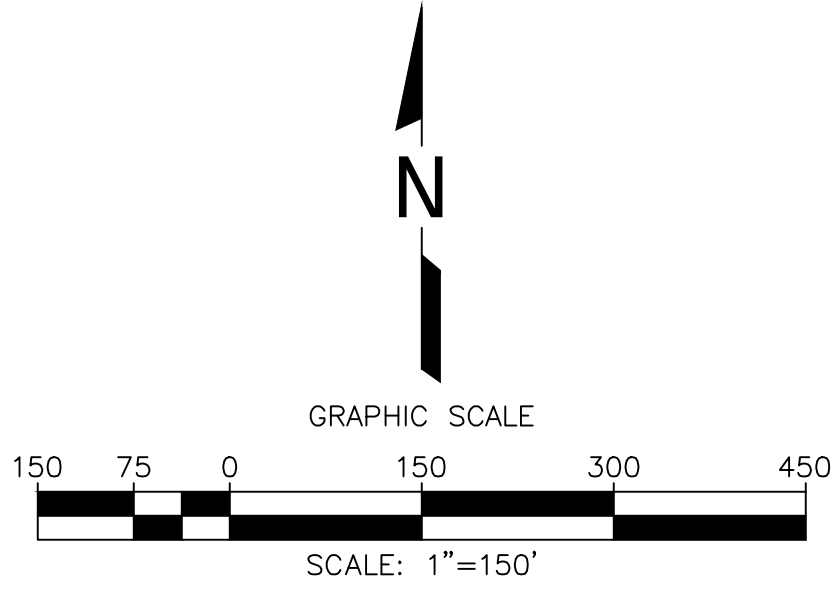

- LEGEND
- 1150 TOPOGRAPHIC CONTOUR
 - EXISTING CELL LIMITS (APPROXIMATE)
 - REACTION AREA BOUNDARY - CONDITION 9A
 - REACTION AREA BOUNDARY - DATA ANALYSIS
 - CV-XX EXISTING VERTICAL LFG EXTRACTION WELL
 - CV-XX PLR EXISTING LFG VERTICAL EXTRACTION WELL - PRESSURIZED LEACHATE RELEASE
 - EXISTING CONDENSATE SUMP WITH PUMP
 - EXISTING DE-WATERING WELL WITH PUMP - CURRENTLY RUNNING
 - EXISTING DE-WATERING WELL WITH PUMP - INSTALLED

De-Watering Well Pumps That Are Currently Installed and Not in Operation	
#	Well I.D.
1	CV-114
2	CV-2206
3	CV-2301
4	CV-2302
5	CV-2306
6	CV-2316
7	CV-2321
8	CV-2326
9	CV-2344
10	CV-2412
11	CV-2416
12	CV-2421
13	CV-2427
14	CV-2428
15	CV-2432
16	CV-2436
17	CV-2438
18	CV-2443
19	CV-2446
20	CV-2448
21	CV-2453
22	CV-2456
23	CV-2457
24	CV-2459
25	CV-2460
26	CV-2461
27	CV-2462
28	CV-2469
29	CV-2470
30	CV-2471
31	CV-2472
32	CV-2473
33	CV-2474
34	CV-2475
35	CV-2477
36	CV-2481
37	CV-2483
38	CV-2487
39	CV-2499
40	CV-24124
41	CV-24131
42	CV-24134
43	CV-24139
44	CV-24165
45	CV-24168
46	CV-24168
47	CV-24170
48	CV-24173
49	CV-24175
50	CV-24212

Zone Description	De-Watering Pumps			
	Total	Operational	Non-Operational	Pending Installation
Within Condition 9A Boundary	137	91	46	36
Outside of Condition 9A Boundary	41	37	4	8
Combined (Both Areas)	178	128	50	44
Condensate Sump	47	45	2	16

C:\Users\5160sm\Desktop\VCCL MASTER EXISTING GCCS MAP ONLY 2025-10-10.dwg Oct 10, 2025 - 11:44am By: smedina

DATE

REVISION

NO

SHEET TITLE:
EXISTING DE-WATERING WELL WITH PUMP MAP

PROJECT TITLE:
CHICUITA CANYON LANDFILL
CASTAIC, CALIFORNIA

CLIENT:
SCS ENGINEERS
ENVIRONMENTAL CONSULTANTS
15000 WILSON AVENUE, SUITE 300
LONG BEACH, CA 90806
PH: (562) 426-9544

DATE: 10/10/2025

SCALE: AS SHOWN

SHEET: 1

