

Archived: Thursday, October 23, 2025 10:32:35 AM
From: [Han, Jessie](#)
Sent: Friday, October 17, 2025 5:00:19 PM
To: bchen@aqmd.gov
Cc: [Steve Cassulo](#)
Subject: RE: Case No. 6177-4 Stipulated Order for Abatement - Weekly Pump Installation and operation update
Importance: Normal
Sensitivity: None
Attachments: [2025 CCLF Existing De-Watering Well with Pump Map_2025-10-17.pdf](#) 

[EXTERNAL SENDER: Use caution with links/attachments]

All - In accordance with Condition 65 of the Modified Stipulated Order, below is the summary of the installation and operation of dewatering pumps for the Chiquita Canyon Landfill. This information is subject to change based on further review and verification.


During 10/10/2025 to 10/16/2025, Chiquita completed the installation of, and began operating during the day, seven (7) pumps in a vertical LFG extraction well for a total of one hundred and thirty-three (133) pumps operating in vertical LFG extraction wells. Additionally, two (2) pumps were taken offline last week leading to a net increase of five (5) pumps. Please refer to the attached, up-to-date map of LFG wells with operating pumps.

During 10/17/2025 to 10/23/2025, given the number of dewatering pumps installed to date, and the maintenance associated with those pumps, Chiquita plans to install and begin operating an additional four (4) pumps in vertical LFG extraction wells in locations along the north and south slope of the reaction area. The pump installation locations for next week are subject to change due to weather and/or safety conditions.

Jessie Han
SCS Engineers
3900 Kilroy Airport Way, Suite 300
Long Beach, CA 90806
Mobile: 562-508-2497
JHan@scsengineers.com

Driven by Client Success
www.scsengineers.com

1. EXISTING TOPOGRAPHIC SURVEY INFORMATION SHOWN WAS PROVIDED BY PROPELLOR. AERIAL PHOTOGRAPHY DATED SEPTEMBER 24, 2025.
2. NORTH ARROW SHOWN HERE IS REFERENCE TO THE CALIFORNIA STATE PLANE ZONE V COORDINATE SYSTEM, NAD 83.
3. THE LOCATION OF ANY EXISTING GCCS COMPONENTS AND OTHER FEATURES ARE APPROXIMATE AND SHOULD BE USED FOR INFORMATION PURPOSES ONLY.
4. EXISTING GCCS AS-BUILT DATED OCTOBER 10, 2025.

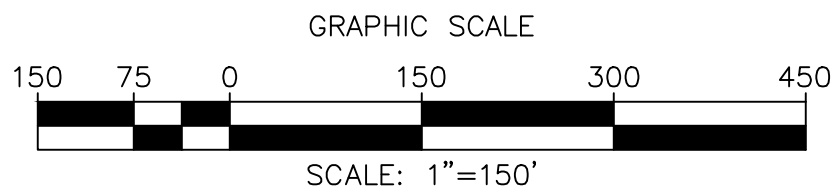

	TOPOGRAPHIC CONTOUR
	EXISTING CELL LIMITS (APPROXIMATE)
	REACTION AREA BOUNDARY - CONDITION 9A
	REACTION AREA BOUNDARY - DATA ANALYSIS
	EXISTING VERTICAL LFG EXTRACTION WELL
	EXISTING LFG VERTICAL EXTRACTION WELL - PRESSURIZED LEACHATE RELEASE
	EXISTING CONDENSATE SUMP WITH PUMP
	EXISTING DE-WATERING WELL WITH PUMP - CURRENTLY RUNNING
	EXISTING DE-WATERING WELL WITH PUMP - INSTALLED

De-Watering Well Pumps That Are Currently Installed and Not in Operation	
#	Well I. D.
1	CV-114
2	CV-2206
3	CV-2301
4	CV-2302
5	CV-2306
6	CV-2316
7	CV-2321
8	CV-2326
9	CV-2344
10	CV-2412
11	CV-2416
12	CV-2421
13	CV-2427
14	CV-2428
15	CV-2432
16	CV-2436
17	CV-2443
18	CV-2446
19	CV-2448
20	CV-2453
21	CV-2456
22	CV-2457
23	CV-2459
24	CV-2460
25	CV-2461
26	CV-2462
27	CV-2469
28	CV-2470
29	CV-2471
30	CV-2472
31	CV-2473
32	CV-2474
33	CV-2475
34	CV-2477
35	CV-2481
36	CV-2483
37	CV-2487
38	CV-2499
39	CV-24116
40	CV-24134
41	CV-24139
42	CV-24165
43	CV-24168
44	CV-24170
45	CV-24173
46	CV-24175
47	CV-24212

Zone Description	De-Watering Pumps			
	Total	Operational	Non-Operational	Pending Installation
Within Condition 9A Boundary	137	96	41	36
Outside of Condition 9A Boundary	44	40	4	8
Combined (Both Areas)	181	136	45	44
Condensate Sump	47	45	2	16

SCS ENGINEERS ENVIRONMENTAL CONSULTANTS 3300 MILROY AIRPORT WAY, SUITE 300 LONG BEACH, CA 90805 PH: (562) 426-8544	DATE: 10/17/2025	
	SCALE: AS SHOWN	
	SHEET: 1	
	PROJ. NO. 012004-123.41	ACAP FILE # FIELD SERVICES
	TSN: BY: WCH	APP. BY: WCH
	CHK. BY: WCH	WCH



CHIQUITA CANYON LANDFILL
CASTAIC, CALIFORNIA

CLIENT:

CHIQUITA CANYON LANDFILL
CASTAIC, CALIFORNIA

SHEET TITLE:	NO.	REVISION	DATE
EXISTING DE-WATERING WELL WITH PUMP MAP	△		
	△		
	△		
	△		
	△		
PROJECT TITLE:			
CHIQUITA CANYON LANDFILL CASTAIC, CALIFORNIA			