


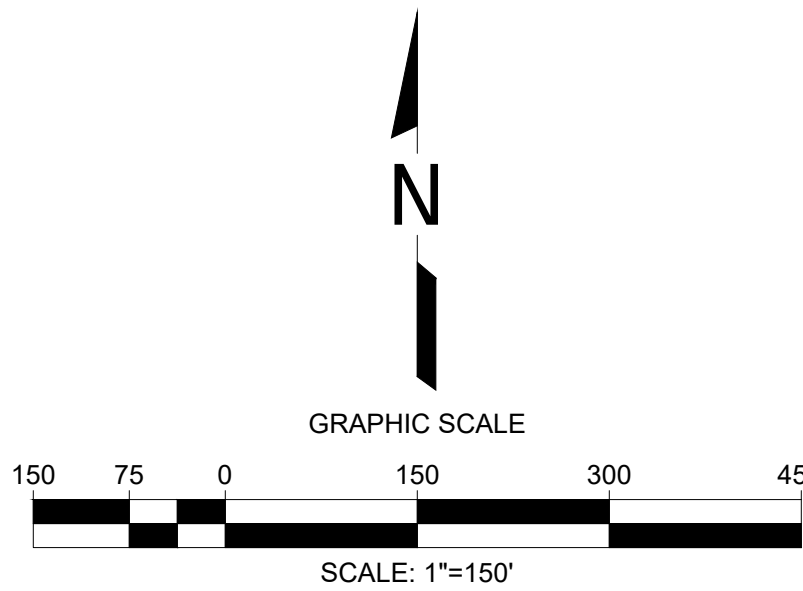

TOPOGRAPHIC CONTOUR	
	EXISTING CELL LIMITS (APPROXIMATE)
CV-XX	EXISTING LFG VERTICAL EXTRACTION WELL
CV-XX PLR	EXISTING LFG VERTICAL EXTRACTION WELL - PRESSURIZED LEACHATE RELEASE
BH-GB	EXISTING GABION LFG COLLECTOR WELL
SW-XX	EXISTING SOIL VAPOR EXTRACTION WELL
FP-XX	EXISTING SURFACE COLLECTOR WELL/HEAD
H-XX	EXISTING HORIZONTAL WELLS
A-XX	EXISTING REMOTE VERTICAL WELL/HEAD
GP-XX	EXISTING PERIMETER MIGRATION PROBE
TP-XX	EXISTING TEMPERATURE PROBE
	EXISTING ISOLATION VALVE
AC	EXISTING ACTIVATED CARBON VESSEL
	EXISTING CONDENSATE SUMP
	EXISTING HDPE LINER RISER
	EXISTING CORRUGATED LINER RISER
36"	EXISTING 36" LFG COLLECTION HEADER PIPING
30"	EXISTING 30" LFG COLLECTION HEADER PIPING
24"	EXISTING 24" LFG COLLECTION HEADER PIPING
20"	EXISTING 20" LFG COLLECTION HEADER PIPING
18"	EXISTING 18" LFG COLLECTION HEADER PIPING
12"	EXISTING 12" LFG COLLECTION HEADER PIPING
10"	EXISTING 10" LFG COLLECTION HEADER PIPING
8"	EXISTING 8" LFG COLLECTION LATERAL PIPING
4/6"	EXISTING 4/6" LFG COLLECTION LATERAL PIPING
2"	EXISTING 2/3" LFG COLLECTION LATERAL PIPING
---	BELOW-GRADE PIPES ARE SHOWN DASHED
	REACTION AREA BOUNDARY (APPROXIMATE) - BASED ON DATA REVIEW
—	EXISTING BLIND FLANGE
	EXISTING FRAC TANKS

- GENERAL DRAWING NOTES:**
1. EXISTING TOPOGRAPHIC SURVEY INFORMATION SHOWN WAS PROVIDED BY PROPELLER, AERIAL PHOTOGRAPHY DATED OCTOBER 08, 2025.
 2. NORTH ARROW SHOWN HERE IS REFERENCE TO THE CALIFORNIA STATE PLANE ZONE V COORDINATE SYSTEM, NAD 83.
 3. THE LOCATION OF ANY EXISTING PIPING, VALVES, TIE-IN LOCATIONS AND OTHER FEATURES ARE APPROXIMATE AND SHOULD BE USED FOR INFORMATION PURPOSES ONLY. ACTUAL FIELD CONDITIONS MAY VARY AND SUBJECT TO CHANGE BASED ON FUTURE PILL OPERATIONS, WASTE PLACEMENT, TOPOGRAPHIC FEATURES, AND OTHER SITE-SPECIFIC FACTORS.
 4. EXISTING GGCS AS-BUILT DATED OCTOBER 22, 2025.