

Archivado: Jueves 16 de octubre de 2025 10:42:08 AM

De: [Medina, Steven](#)

Enviado: Viernes 10 de octubre de 2025 12:40:26 PM

Para: bchen@aqmd.gov

Cc: [Han, Jessie](#)

Asunto: Ref.: Orden de Depuración Estipulada del Caso No. 6177-4 - Actualización sobre la Instalación y Operación Semanal de las Bombas

Importancia: Normal

Sensibilidad: Ninguna

Adjuntos: [image.png](#); [Outlook-g12wsp3s.png](#); [Outlook-i0rigy0y.png](#); [Outlook-0uw5injg.png](#); [Outlook-o4w04kfh.png](#); [2025 CCLF Existing De-Watering Well with Pump Map_2025-10-10.pdf](#);

[REMITENTE EXTERNO: Tenga precaución con los enlaces/adjuntos]

Todos,

Según la Condición 65 de la Orden Estipulada Modificada, a continuación se encuentra el resumen de la instalación y operación de las bombas de desagüe para el Vertedero de Chiquita Canyon. Esta información está sujeta a cambios, en base a una mayor revisión y verificación.

Durante el período que transcurrió desde el 03/10/2025 hasta el 09/10/2025, Chiquita completó la instalación y comenzó a operar durante el día diez (10) bombas en pozos verticales de extracción de LFG dando un total de ciento veintiocho (128) bombas operado en pozos verticales de extracción de LFG. Además, la semana pasada se retiró una (1) bomba de la línea y se pusieron operativas diez (10) bombas nuevas, generando un aumento neto de nueve (9) bombas. Por favor, consulte el mapa actualizado adjunto de los pozos de LFG con bombas operando.

Durante el período que va del 10/10/2025 hasta el 16/10/2025, dada la cantidad de bombas de desagüe instaladas hasta la fecha y el mantenimiento asociado a esas bombas, Chiquita tiene planeado instalar y comenzar a operar otras cuatro (4) bombas en pozos verticales de extracción de LFG en ubicaciones a lo largo de la pendiente norte y sur de la zona reactiva. Las ubicaciones de las instalaciones de las bombas para la semana que viene están sujetas a cambios debido a las condiciones climáticas y/o de seguridad.

Atentamente,

STEVEN Rubén Medina, **E.I.T.**

Personal Profesional

SCS Engineers

3900 Kilroy Airport Way, Suite 300

Long Beach, CA 90806

858-204-4342 (c)


SMedina@scsengineers.com

Dirigidos por el Éxito de los Clientes

www.scsengineers.com

□

- GENERAL DRAWING NOTES:
1. EXISTING TOPOGRAPHIC SURVEY INFORMATION SHOWN WAS PROVIDED BY PROPELLOR. AERIAL PHOTOGRAPHY DATED SEPTEMBER 24, 2025.
 2. NORTH ARROW SHOWN HERE IS REFERENCE TO THE CALIFORNIA STATE PLANE ZONE V COORDINATE SYSTEM, NAD 83.
 3. THE LOCATION OF ANY EXISTING GCCS COMPONENTS AND OTHER FEATURES ARE APPROXIMATE AND SHOULD BE USED FOR INFORMATION PURPOSES ONLY.
 4. EXISTING GCCS AS-BUILT DATED OCTOBER 10, 2025.

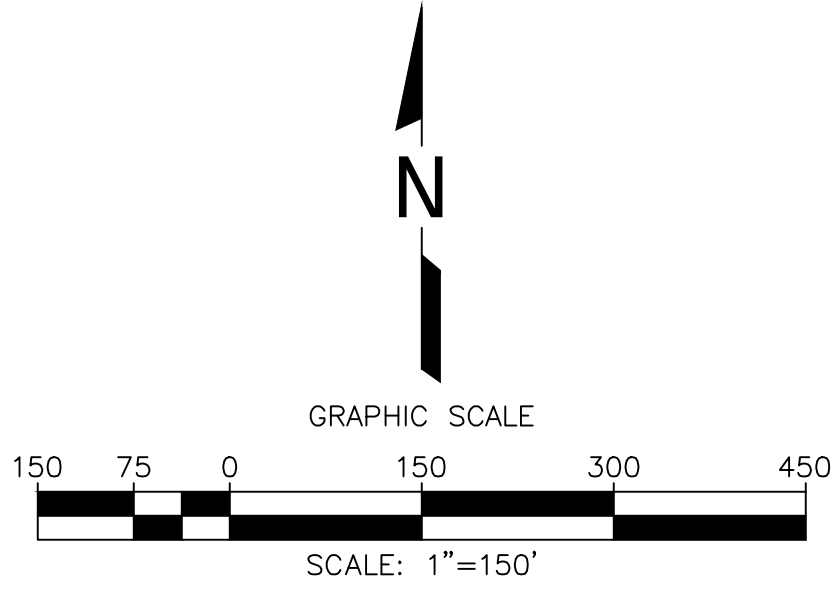

- LEGEND
- 1150 TOPOGRAPHIC CONTOUR
 - EXISTING CELL LIMITS (APPROXIMATE)
 - REACTION AREA BOUNDARY - CONDITION 9A
 - REACTION AREA BOUNDARY - DATA ANALYSIS
 - CV-XX EXISTING VERTICAL LFG EXTRACTION WELL
 - CV-XX PLR EXISTING LFG VERTICAL EXTRACTION WELL - PRESSURIZED LEACHATE RELEASE
 - EXISTING CONDENSATE SUMP WITH PUMP
 - EXISTING DE-WATERING WELL WITH PUMP - CURRENTLY RUNNING
 - EXISTING DE-WATERING WELL WITH PUMP - INSTALLED

De-Watering Well Pumps That Are Currently Installed and Not in Operation	
#	Well I.D.
1	CV-114
2	CV-2206
3	CV-2301
4	CV-2302
5	CV-2306
6	CV-2316
7	CV-2321
8	CV-2326
9	CV-2344
10	CV-2412
11	CV-2416
12	CV-2421
13	CV-2427
14	CV-2428
15	CV-2432
16	CV-2436
17	CV-2438
18	CV-2443
19	CV-2446
20	CV-2448
21	CV-2453
22	CV-2456
23	CV-2457
24	CV-2459
25	CV-2460
26	CV-2461
27	CV-2462
28	CV-2469
29	CV-2470
30	CV-2471
31	CV-2472
32	CV-2473
33	CV-2474
34	CV-2475
35	CV-2477
36	CV-2481
37	CV-2483
38	CV-2487
39	CV-2499
40	CV-24124
41	CV-24131
42	CV-24134
43	CV-24139
44	CV-24165
45	CV-24168
46	CV-24168
47	CV-24170
48	CV-24173
49	CV-24175
50	CV-24212

Zone Description	De-Watering Pumps			
	Total	Operational	Non-Operational	Pending Installation
Within Condition 9A Boundary	137	91	46	36
Outside of Condition 9A Boundary	41	37	4	8
Combined (Both Areas)	178	128	50	44
Condensate Sump	47	45	2	16

C:\Users\5160sm\Desktop\VCCL MASTER EXISTING GCCS MAP ONLY 2025-10-10.dwg Oct 10, 2025 - 11:44am By: smedina

DATE

REVISION

NO.

SHEET TITLE:
EXISTING DE-WATERING WELL WITH PUMP MAP

PROJECT TITLE:
CHICUITA CANYON LANDFILL
CASTAIC, CALIFORNIA

CLIENT:
SCS ENGINEERS
ENVIRONMENTAL CONSULTANTS
1500 N. GARDEN AVENUE, SUITE 300
LONG BEACH, CA 90806
PH: (562) 426-9544

DATE: 10/10/2025

SCALE: AS SHOWN

SHEET: 1

DATE

REVISION

NO.

SHEET TITLE:
EXISTING DE-WATERING WELL WITH PUMP MAP

PROJECT TITLE:
CHICUITA CANYON LANDFILL
CASTAIC, CALIFORNIA

CLIENT:
SCS ENGINEERS
ENVIRONMENTAL CONSULTANTS
1500 N. GARDEN AVENUE, SUITE 300
LONG BEACH, CA 90806
PH: (562) 426-9544

DATE: 10/10/2025

SCALE: AS SHOWN

SHEET: 1