

Archived: Thursday, November 6, 2025 11:51:15 AM
From: [Medina, Steven](#)
Mail received time: Fri, 31 Oct 2025 19:05:09
Sent: Fri, 31 Oct 2025 19:02:57
To: bchen@aqmd.gov
Cc: [Han, Jessie](#)
Subject: Re: Case No. 6177-4 Stipulated Order for Abatement - Weekly Pump Installation and operation update
Importance: Normal
Sensitivity: None
Attachments: Outlook-g5f5vg0p.png Outlook-4s5xxzjv.png 2025 CCLF Existing De-Watering Well with Pump Map_2025-10-31.pdf

[EXTERNAL SENDER: Use caution with links/attachments]

All,

In accordance with Condition 65 of the Modified Stipulated Order, below is the summary of the installation and operation of dewatering pumps for the Chiquita Canyon Landfill. This information is subject to change based on further review and verification.

During 10/24/2025 to 10/30/2025, Chiquita completed the installation of, and began operating during the day, three (3) pumps in a vertical LFG extraction well for a total of one hundred and thirty-nine (139) pumps operating in vertical LFG extraction wells. Please refer to the attached, up-to-date map of LFG wells with operating pumps.

During 10/31/2025 to 11/06/2025, given the number of dewatering pumps installed to date, and the maintenance associated with those pumps, Chiquita plans to install and begin operating an additional four (4) pumps in vertical LFG extraction wells in locations along the north and south slope of the reaction area. The pump installation locations for next week are subject to change due to weather and/or safety conditions.

Regards,

STEVEN Ruben Medina, **E.I.T.**

Staff Professional

SCS Engineers

3900 Kilroy Airport Way, Suite 300

Long Beach, CA 90806

858-204-4342 (c)

SMedina@scsengineers.com

Driven by Client Success

www.scsengineers.com

□


GENERAL DRAWING NOTES:

1. EXISTING TOPOGRAPHIC SURVEY INFORMATION SHOWN WAS PROVIDED BY PROPELLOR. AERIAL PHOTOGRAPHY DATED OCTOBER 22, 2025.

2. NORTH ARROW SHOWN HERE IS REFERENCE TO THE CALIFORNIA STATE PLANE ZONE V COORDINATE SYSTEM, NAD 83.

3. THE LOCATION OF ANY EXISTING GCCS COMPONENTS AND OTHER FEATURES ARE APPROXIMATE AND SHOULD BE USED FOR INFORMATION PURPOSES ONLY.

4. EXISTING GCCS AS-BUILT DATED OCTOBER 31, 2025.

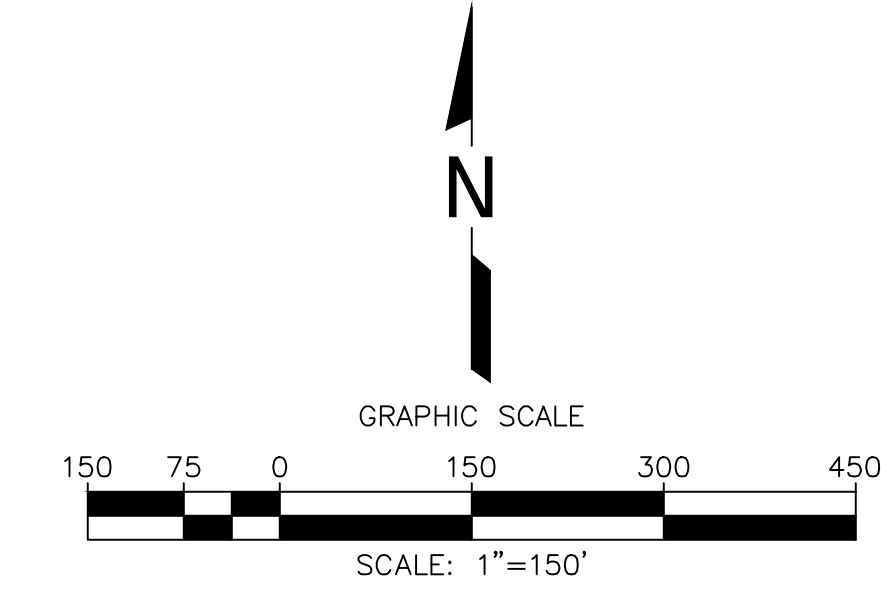

- LEGEND**
- 1150 TOPOGRAPHIC CONTOUR
 - EXISTING CELL LIMITS (APPROXIMATE)
 - REACTION AREA BOUNDARY - CONDITION 9A
 - REACTION AREA BOUNDARY - DATA ANALYSIS
 - CV-XX EXISTING VERTICAL LFG EXTRACTION WELL
 - CV-XX PLR EXISTING LFG VERTICAL EXTRACTION WELL - PRESSURIZED LEACHATE RELEASE
 - EXISTING CONDENSATE SUMP WITH PUMP
 - EXISTING DE-WATERING WELL WITH PUMP - CURRENTLY RUNNING
 - EXISTING DE-WATERING WELL WITH PUMP - INSTALLED

De-Watering Well Pumps That Are Currently Installed and Not in Operation

#	Well I.D.
1	CV-114
2	CV-2206
3	CV-2301
4	CV-2302
5	CV-2306
6	CV-2316
7	CV-2321
8	CV-2326
9	CV-2344
10	CV-2412
11	CV-2416
12	CV-2421
13	CV-2427
14	CV-2428
15	CV-2432
16	CV-2436
17	CV-2443
18	CV-2446
19	CV-2448
20	CV-2453
21	CV-2456
22	CV-2457
23	CV-2459
24	CV-2460
25	CV-2461
26	CV-2462
27	CV-2469
28	CV-2470
29	CV-2471
139	CV-2581

Zone Description	De-Watering Pumps			
	Total	Operational	Non-Operational	Pending Installation
Within Condition 9A Boundary	139	97	42	32
Outside of Condition 9A Boundary	46	42	4	6
Combined (Both Areas)	185	139	46	38
Condensate Sump	48	46	2	16

DATE

REVISION

NO

SHEET TITLE: EXISTING DE-WATERING WELL WITH PUMP MAP

PROJECT TITLE: CHICUITA CANYON LANDFILL CASTAIC, CALIFORNIA

CLIENT: CHICUITA CANYON LANDFILL CASTAIC, CALIFORNIA

SCS ENGINEERS

ENVIRONMENTAL CONSULTANTS

15000 W. 15TH AVE., SUITE 300

LONG BEACH, CA 90806

PH: (562) 426-9544

ACAD FILE: F:\FIELD SERVICES

APP. BY: WCH

CHK. BY: WCH

DATE: 10/31/2025

SCALE: AS SHOWN

SHEET: 1