

Archived: Wednesday, November 19, 2025 11:57:35 AM
From: [Medina, Steven](#)
Mail received time: Fri, 14 Nov 2025 22:34:51
Sent: Fri, 14 Nov 2025 22:32:23
To: bchen@aqmd.gov
Cc: [Han, Jessie](#)
Subject: Re: Case No. 6177-4 Stipulated Order for Abatement - Weekly Pump Installation and operation update
Importance: Normal
Sensitivity: None
Attachments: Outlook-g5f5vg0p.png Outlook-4s5xxzjv.png Outlook-brcwwkl1.png Outlook-pejsuar5.png 2025 CCLF Existing De-Watering Well with Pump Map_2025-11-14.pdf

[EXTERNAL SENDER: Use caution with links/attachments]

All,

In accordance with Condition 65 of the Modified Stipulated Order, below is the summary of the installation and operation of dewatering pumps for the Chiquita Canyon Landfill. This information is subject to change based on further review and verification.

During 11/07/2025 to 11/13/2025, Chiquita completed the installation of, and began operating during the day, seven (7) pumps in a vertical LFG extraction well for a total of one hundred and forty-six (146) pumps operating in vertical LFG extraction wells. Additionally, two (2) pumps were taken offline last week, and seven (7) new pumps became operational, leading to a net increase of five (5) pumps. Please refer to the attached, up-to-date map of LFG wells with operating pumps.

During 11/14/2025 to 11/20/2025, given the number of dewatering pumps installed to date, and the maintenance associated with those pumps, Chiquita plans to install and begin operating an additional four (4) pumps in vertical LFG extraction wells in locations along the north and south slope of the reaction area. The pump installation locations for next week are subject to change due to weather and/or safety conditions.


Regards,

STEVEN Ruben Medina, **E.I.T.**
Staff Professional
SCS Engineers
3900 Kilroy Airport Way, Suite 300
Long Beach, CA 90806
858-204-4342 (c)
SMedina@scsengineers.com

Driven by Client Success
www.scsengineers.com


GENERAL DRAWING NOTES

1. EXISTING TOPOGRAPHIC SURVEY INFORMATION SHOWN WAS PROVIDED BY PROPELLOR. AERIAL PHOTOGRAPHY DATED NOVEMBER 05, 2025.
2. NORTH ARROW SHOWN HERE IS REFERENCE TO THE CALIFORNIA STATE PLANE ZONE V COORDINATE SYSTEM, NAD 83.
3. THE LOCATION OF ANY EXISTING GCCS COMPONENTS AND OTHER FEATURES ARE APPROXIMATE AND SHOULD BE USED FOR INFORMATION PURPOSES ONLY.
4. EXISTING GCCS AS-BUILT DATED OCTOBER 31, 2025.

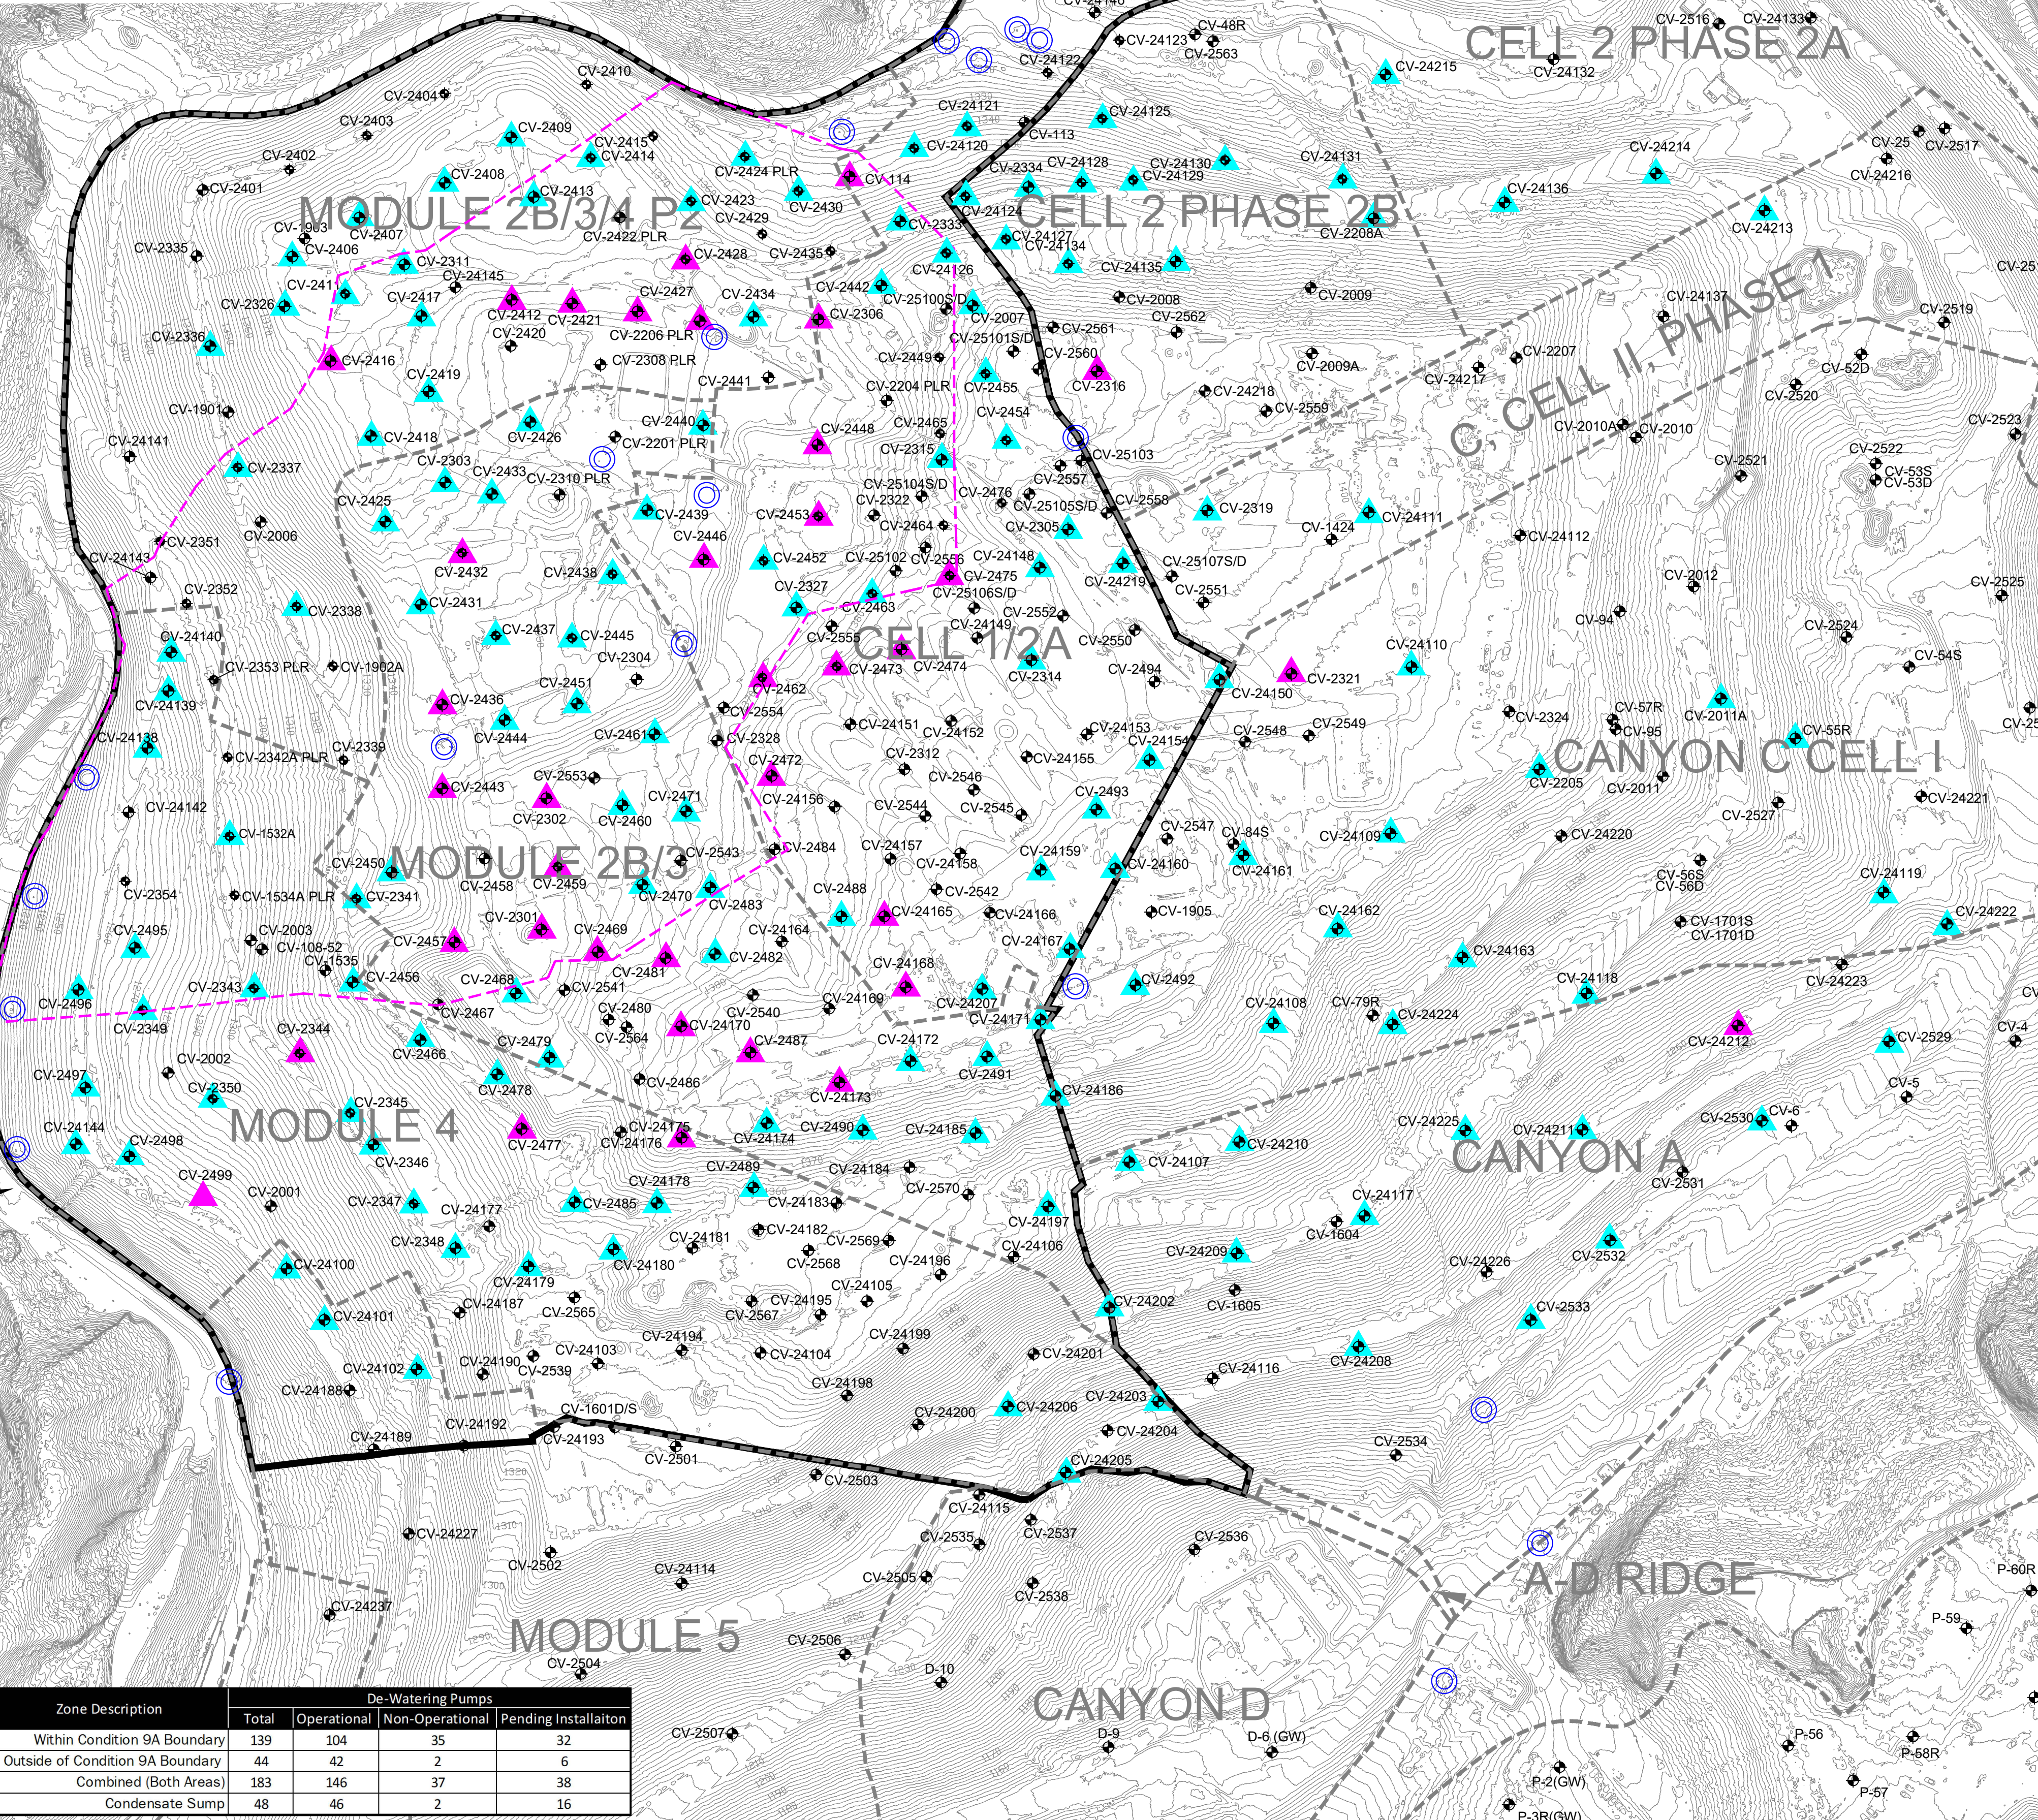

Zone Description	De-Watering Pumps			
	Total	Operational	Non-Operational	Pending Installation
Within Condition 9A Boundary	139	104	35	32
Outside of Condition 9A Boundary	44	42	2	6
Combined (Both Areas)	183	146	37	38
Condensate Sump	48	46	2	16

De-Watering Well Pumps that are Currently Running		
#	Well ID	Operational Start/Up Date
1	CV-2334	3/21/2024
2	CV-2424	3/21/2024
3	CV-2414	4/1/2024
4	CV-2337	4/22/2024
5	CV-2336	4/23/2024
6	CV-2326	4/30/2024
7	CV-24144	5/13/2024
8	CV-2414	5/20/2024
9	CV-24127	5/23/2024
10	CV-2406	5/30/2024
11	CV-2486	5/30/2024
12	CV-2487	5/30/2024
13	CV-2488	5/30/2024
14	CV-2411	6/24/2024
15	CV-2419	6/26/2024
16	CV-24102	7/3/2024
17	CV-24109	7/3/2024
18	CV-24162	7/3/2024
19	CV-24100	7/17/2024
20	CV-2315	7/18/2024
21	CV-2486	7/18/2024
22	CV-24101	7/18/2024
23	CV-2343-PLR	7/18/2024
24	CV-2453	7/18/2024
25	CV-2436	7/22/2024
26	CV-2347	7/24/2024
27	CV-2346	7/25/2024
28	CV-2407	8/13/2024
29	CV-2417	8/13/2024
30	CV-2418	8/14/2024
31	CV-2341	8/15/2024
32	CV-2486	8/19/2024
33	CV-24121	8/23/2024
34	CV-2434	8/23/2024
35	CV-2430	8/26/2024
36	CV-2423	8/26/2024
37	CV-2409	8/30/2024
38	CV-24125	8/30/2024
39	CV-2429	8/30/2024
40	CV-24130	8/30/2024
41	CV-24131	8/30/2024
42	CV-24108	9/4/2024
43	CV-2349	9/4/2024
44	CV-2485	9/8/2024
45	CV-2482	9/10/2024
46	CV-2350	9/10/2024
47	CV-2410	9/10/2024
48	CV-2478	9/4/2024
49	CV-2463	9/26/2024
50	CV-2464	9/26/2024
51	CV-2437	9/26/2024
52	CV-2450	10/1/2024
53	CV-2488	10/15/2024
54	CV-2333	10/15/2024
55	CV-2407	12/1/2024
56	CV-2443	12/16/2024
57	CV-2412	12/21/2024
58	CV-2451	12/23/2024
59	CV-2482	12/23/2024
60	CV-2471	12/24/2024
61	CV-2485	1/6/2025
62	CV-24203	1/10/2025
63	CV-24205	1/10/2025
64	CV-24208	1/10/2025
65	CV-24263	1/10/2025
66	CV-24225	1/15/2025
67	CV-24117	1/17/2025
68	CV-2460	1/17/2025
69	CV-2479	1/28/2025
70	CV-2483	1/29/2025
71	CV-2470	2/1/2025
72	CV-2338	2/8/2025
73	CV-24206	2/20/2025
74	CV-1532A-PLR	2/28/2025
75	CV-24202	2/28/2025
76	CV-2409	2/28/2025
77	CV-2455	3/11/2025
78	CV-24197	3/11/2025
79	CV-24171	4/7/2025
80	CV-2434	4/8/2025
82	CV-24135	4/11/2025
83	CV-24159	4/16/2025
84	CV-24174	4/15/2025
85	CV-24154	4/17/2025
86	CV-2485	4/25/2025
87	CV-2308A	5/1/2025
88	CV-2414	5/1/2025
89	CV-24136	5/2/2025
90	CV-2493	5/6/2025
91	CV-24160	5/6/2025
92	CV-2492	5/12/2025
93	CV-2205	5/8/2025
94	CV-24161	5/8/2025
95	CV-24172	5/8/2025
96	CV-24167	5/8/2025
97	CV-2488	5/12/2025
98	CV-24224	5/12/2025
99	CV-24119	5/14/2025
100	CV-24211	5/15/2025
101	CV-2011A	5/20/2025
102	CV-2486	6/1/2025
103	CV-2456	5/29/2025
104	CV-24207	6/9/2025
105	CV-24222	6/10/2025
106	CV-24186	6/10/2025
107	CV-2439	6/10/2025
108	CV-2439	6/12/2025
109	CV-24140	6/14/2025
110	CV-2461	6/16/2025
111	CV-24111	6/16/2025
112	CV-24144	6/20

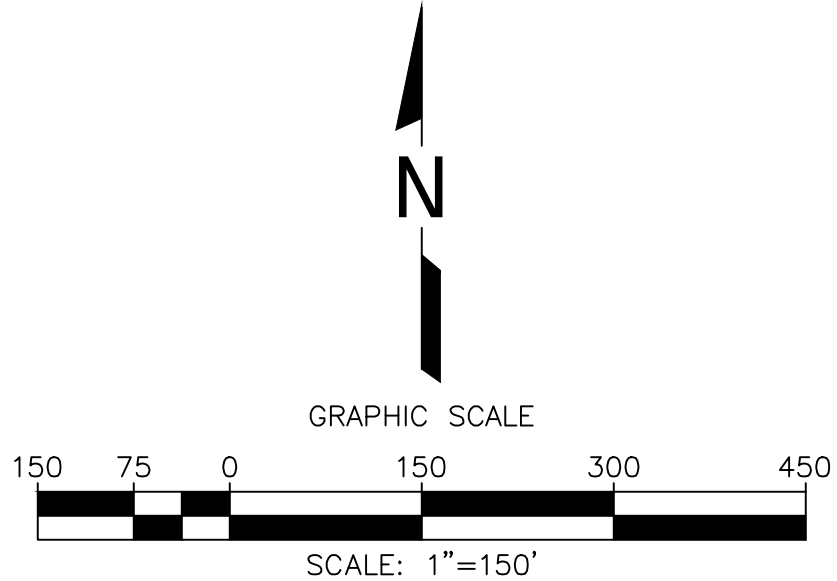

LEGEND

- | | |
|--|---|
| | TOPOGRAPHIC CONTOUR |
| | EXISTING CELL LIMITS (APPROXIMATE) |
| | REACTION AREA BOUNDARY - CONDITION 9A |
| | REACTION AREA BOUNDARY - DATA ANALYSIS |
| | EXISTING VERTICAL LFG EXTRACTION WELL |
| | EXISTING LFG VERTICAL EXTRACTION WELL -
PRESSURIZED LEACHATE RELEASE |
| | EXISTING CONDENSATE SUMP WITH PUMP |
| | EXISTING DE-WATERING WELL WITH PUMP -
CURRENTLY RUNNING |
| | EXISTING DE-WATERING WELL WITH PUMP - INSTALLED |

De-Watering Well Pumps That Are Currently Installed and Not in Operation	
#	Well I.D.
1	CV-114
2	CV-2206
3	CV-2301
4	CV-2302
5	CV-2306
6	CV-2316
7	CV-2321
8	CV-2344
9	CV-2412
10	CV-2416
11	CV-2421
12	CV-2427
13	CV-2428
14	CV-2432
15	CV-2436
16	CV-2443
17	CV-2446
18	CV-2448
19	CV-2453
20	CV-2457
21	CV-2459
22	CV-2462
23	CV-2469
24	CV-2472
25	CV-2473
26	CV-2474
27	CV-2475
28	CV-2477
29	CV-2481
30	CV-2487
31	CV-2499
32	CV-24165
33	CV-24168
34	CV-24170
35	CV-24173
36	CV-24175
37	CV-24212

SCS ENGINEERS ENVIRONMENTAL CONSULTANTS 3800 KILROY AVENUE, SUITE 300 LONG BEACH, CA 90806 TEL (562) 426-6644	CLIENT:		 CHIQUITA CANYON LANDFILL CASTAIC, CALIFORNIA	SHEET TITLE: EXISTING DE-WATERING WELL WITH PUMP MAP	NO.	REVISION	DATE
	PROJECT TITLE:						
	PROJECT TITLE:						
	PROJECT TITLE:						
	PROJECT TITLE:						
DATE: 11/14/2025		SCALE: AS SHOWN		SHEET: 1			