

Archived: Thursday, December 11, 2025 4:15:50 PM
From: [Medina, Steven](#)
Sent: Friday, December 5, 2025 12:52:00 PM
To: bchen@aqmd.gov
Cc: [Haley, William \(Bill\)](#)
Subject: Re: Case No. 6177-4 Stipulated Order for Abatement - Weekly Pump Installation and operation update
Importance: Normal
Sensitivity: None
Attachments: Outlook-joa5u2wz.png 2025 CCLF Existing De-Watering Well with Pump Map_2025-12-05.pdf

[EXTERNAL SENDER: Use caution with links/attachments]

All,

In accordance with Condition 65 of the Modified Stipulated Order, below is the summary of the installation and operation of dewatering pumps for the Chiquita Canyon Landfill. This information is subject to change based on further review and verification.

During 11/28/2025 to 12/4/2025, Chiquita completed the installation of, and began operating during the day, three (3) pumps in a vertical LFG extraction well for a total of one hundred and forty-nine (149) pumps operating in vertical LFG extraction wells. Additionally, two (2) pumps were taken offline last week, and three (3) new pumps became operational, leading to a net increase of one (1) pump. Please refer to the attached, up-to-date map of LFG wells with operating pumps.

During 12/5/2025 to 12/11/2025, given the number of dewatering pumps installed to date, and the maintenance associated with those pumps, Chiquita plans to install and begin operating an additional four (4) pumps in vertical LFG extraction wells in locations along the north and south slope of the reaction area. The pump installation locations for next week are subject to change due to weather and/or safety conditions.

Regards,

STEVEN Ruben Medina, **E.I.T.**

Staff Professional

SCS Engineers

3900 Kilroy Airport Way, Suite 300

Long Beach, CA 90806

858-204-4342 (c)



SMedina@scsengineers.com

Driven by Client Success

www.scsengineers.com

□

1. EXISTING TOPOGRAPHIC SURVEY INFORMATION SHOWN WAS PROVIDED BY PROPELLOR. AERIAL PHOTOGRAPHY DATED NOVEMBER 05, 2025.
2. NORTH ARROW SHOWN HERE IS REFERENCE TO THE CALIFORNIA STATE PLANE ZONE V COORDINATE SYSTEM, NAD 83.
3. THE LOCATION OF ANY EXISTING GCCS COMPONENTS AND OTHER FEATURES ARE APPROXIMATE AND SHOULD BE USED FOR INFORMATION PURPOSES ONLY.
4. EXISTING GCCS AS-BUILT DATED NOVEMBER 21, 2025.

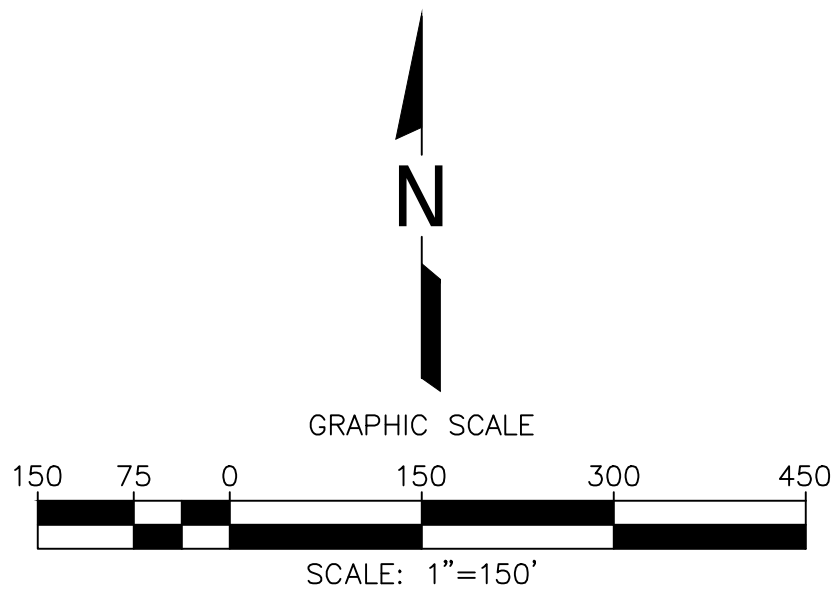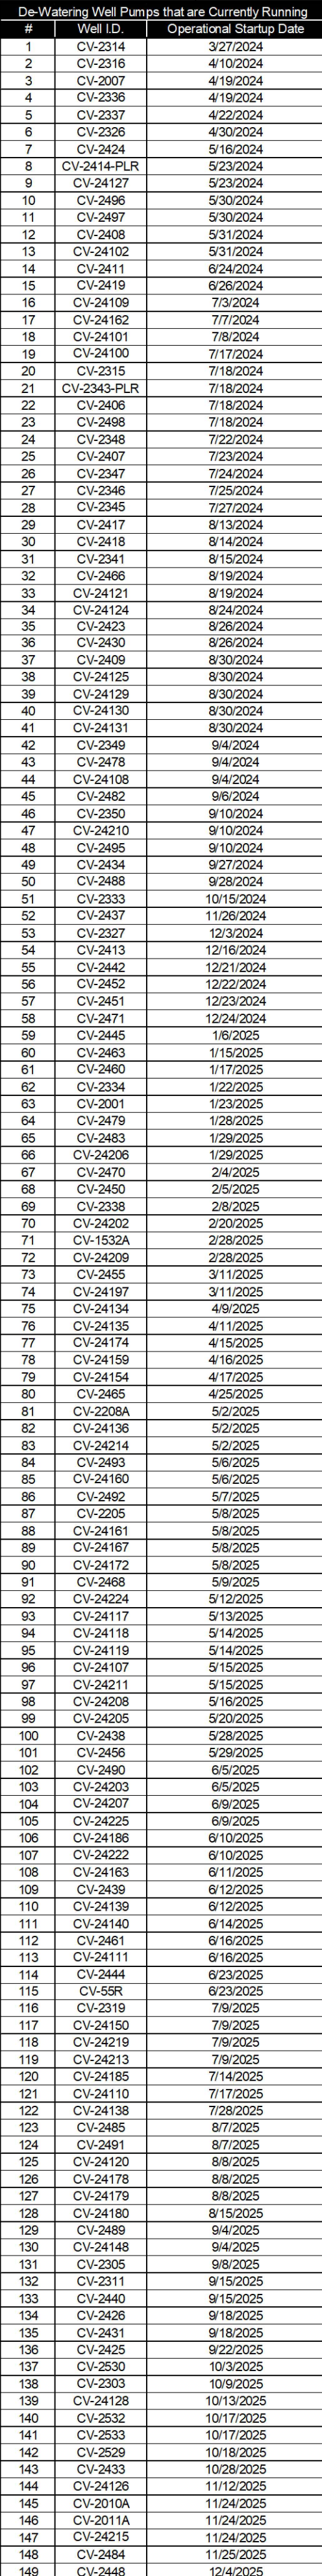

	TOPOGRAPHIC CONTOUR
	EXISTING CELL LIMITS (APPROXIMATE)
	REACTION AREA BOUNDARY - CONDITION 9A
	REACTION AREA BOUNDARY - DATA ANALYSIS
	EXISTING VERTICAL LFG EXTRACTION WELL
	EXISTING LFG VERTICAL EXTRACTION WELL - PRESSURIZED LEACHATE RELEASE
	EXISTING CONDENSATE SUMP WITH PUMP
	EXISTING DE-WATERING WELL WITH PUMP - CURRENTLY RUNNING
	EXISTING DE-WATERING WELL WITH PUMP - INSTALLED

De-Watering Well Pumps That Are Currently Installed and Not in Operation	
#	Well I.D.
1	CV-114
2	CV-2206
3	CV-2301
4	CV-2302
5	CV-2306
6	CV-2321
7	CV-2344
8	CV-2412
9	CV-2416
10	CV-2421
11	CV-2427
12	CV-2428
13	CV-2432
14	CV-2436
15	CV-2443
16	CV-2446
17	CV-2453
18	CV-2457
19	CV-2459
20	CV-2462
21	CV-2469
22	CV-2472
23	CV-2473
24	CV-2474
25	CV-2475
26	CV-2477
27	CV-2481
28	CV-2487
29	CV-2499
30	CV-24165
31	CV-24168
32	CV-24170
33	CV-24173
34	CV-24175
35	CV-24212

Zone Description	De-Watering Pumps			
	Total	Operational	Non-Operational	Pending Installation
Within Condition 9A Boundary	138	105	33	31
Outside of Condition 9A Boundary	46	44	2	4
Combined (Both Areas)	184	149	35	35
Condensate Sump	48	46	2	16

SCS ENGINEERS							
ENVIRONMENTAL CONSULTANTS							
3900 KILROY AVENUE SUITE 300 KILROY, CALIFORNIA 94086 PH: (510) 426-5544							
DATE:		12/05/2025		PROJ. NO.: 01204123.41		DWN. BY: SRM	
SCALE:		AS SHOWN		ACAD FILE: N:\CADD\SSBUIL-MASTERS		CHK. BY: WCH	
SHEET:		1		DSN. BY: -		APP. BY: WCH	