
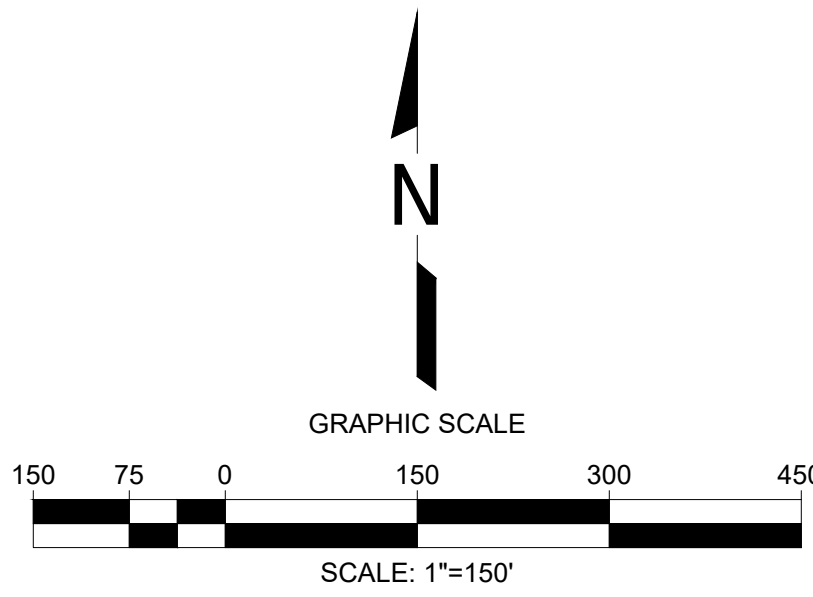


N:\CAD\ASBUILT - MASTERS\CHIOUITA\GCCS\LCLE MASTER EXISTING GCCS MAP 2026-01-21.dwg Jan 21, 2026 - 11:14am By: smedina

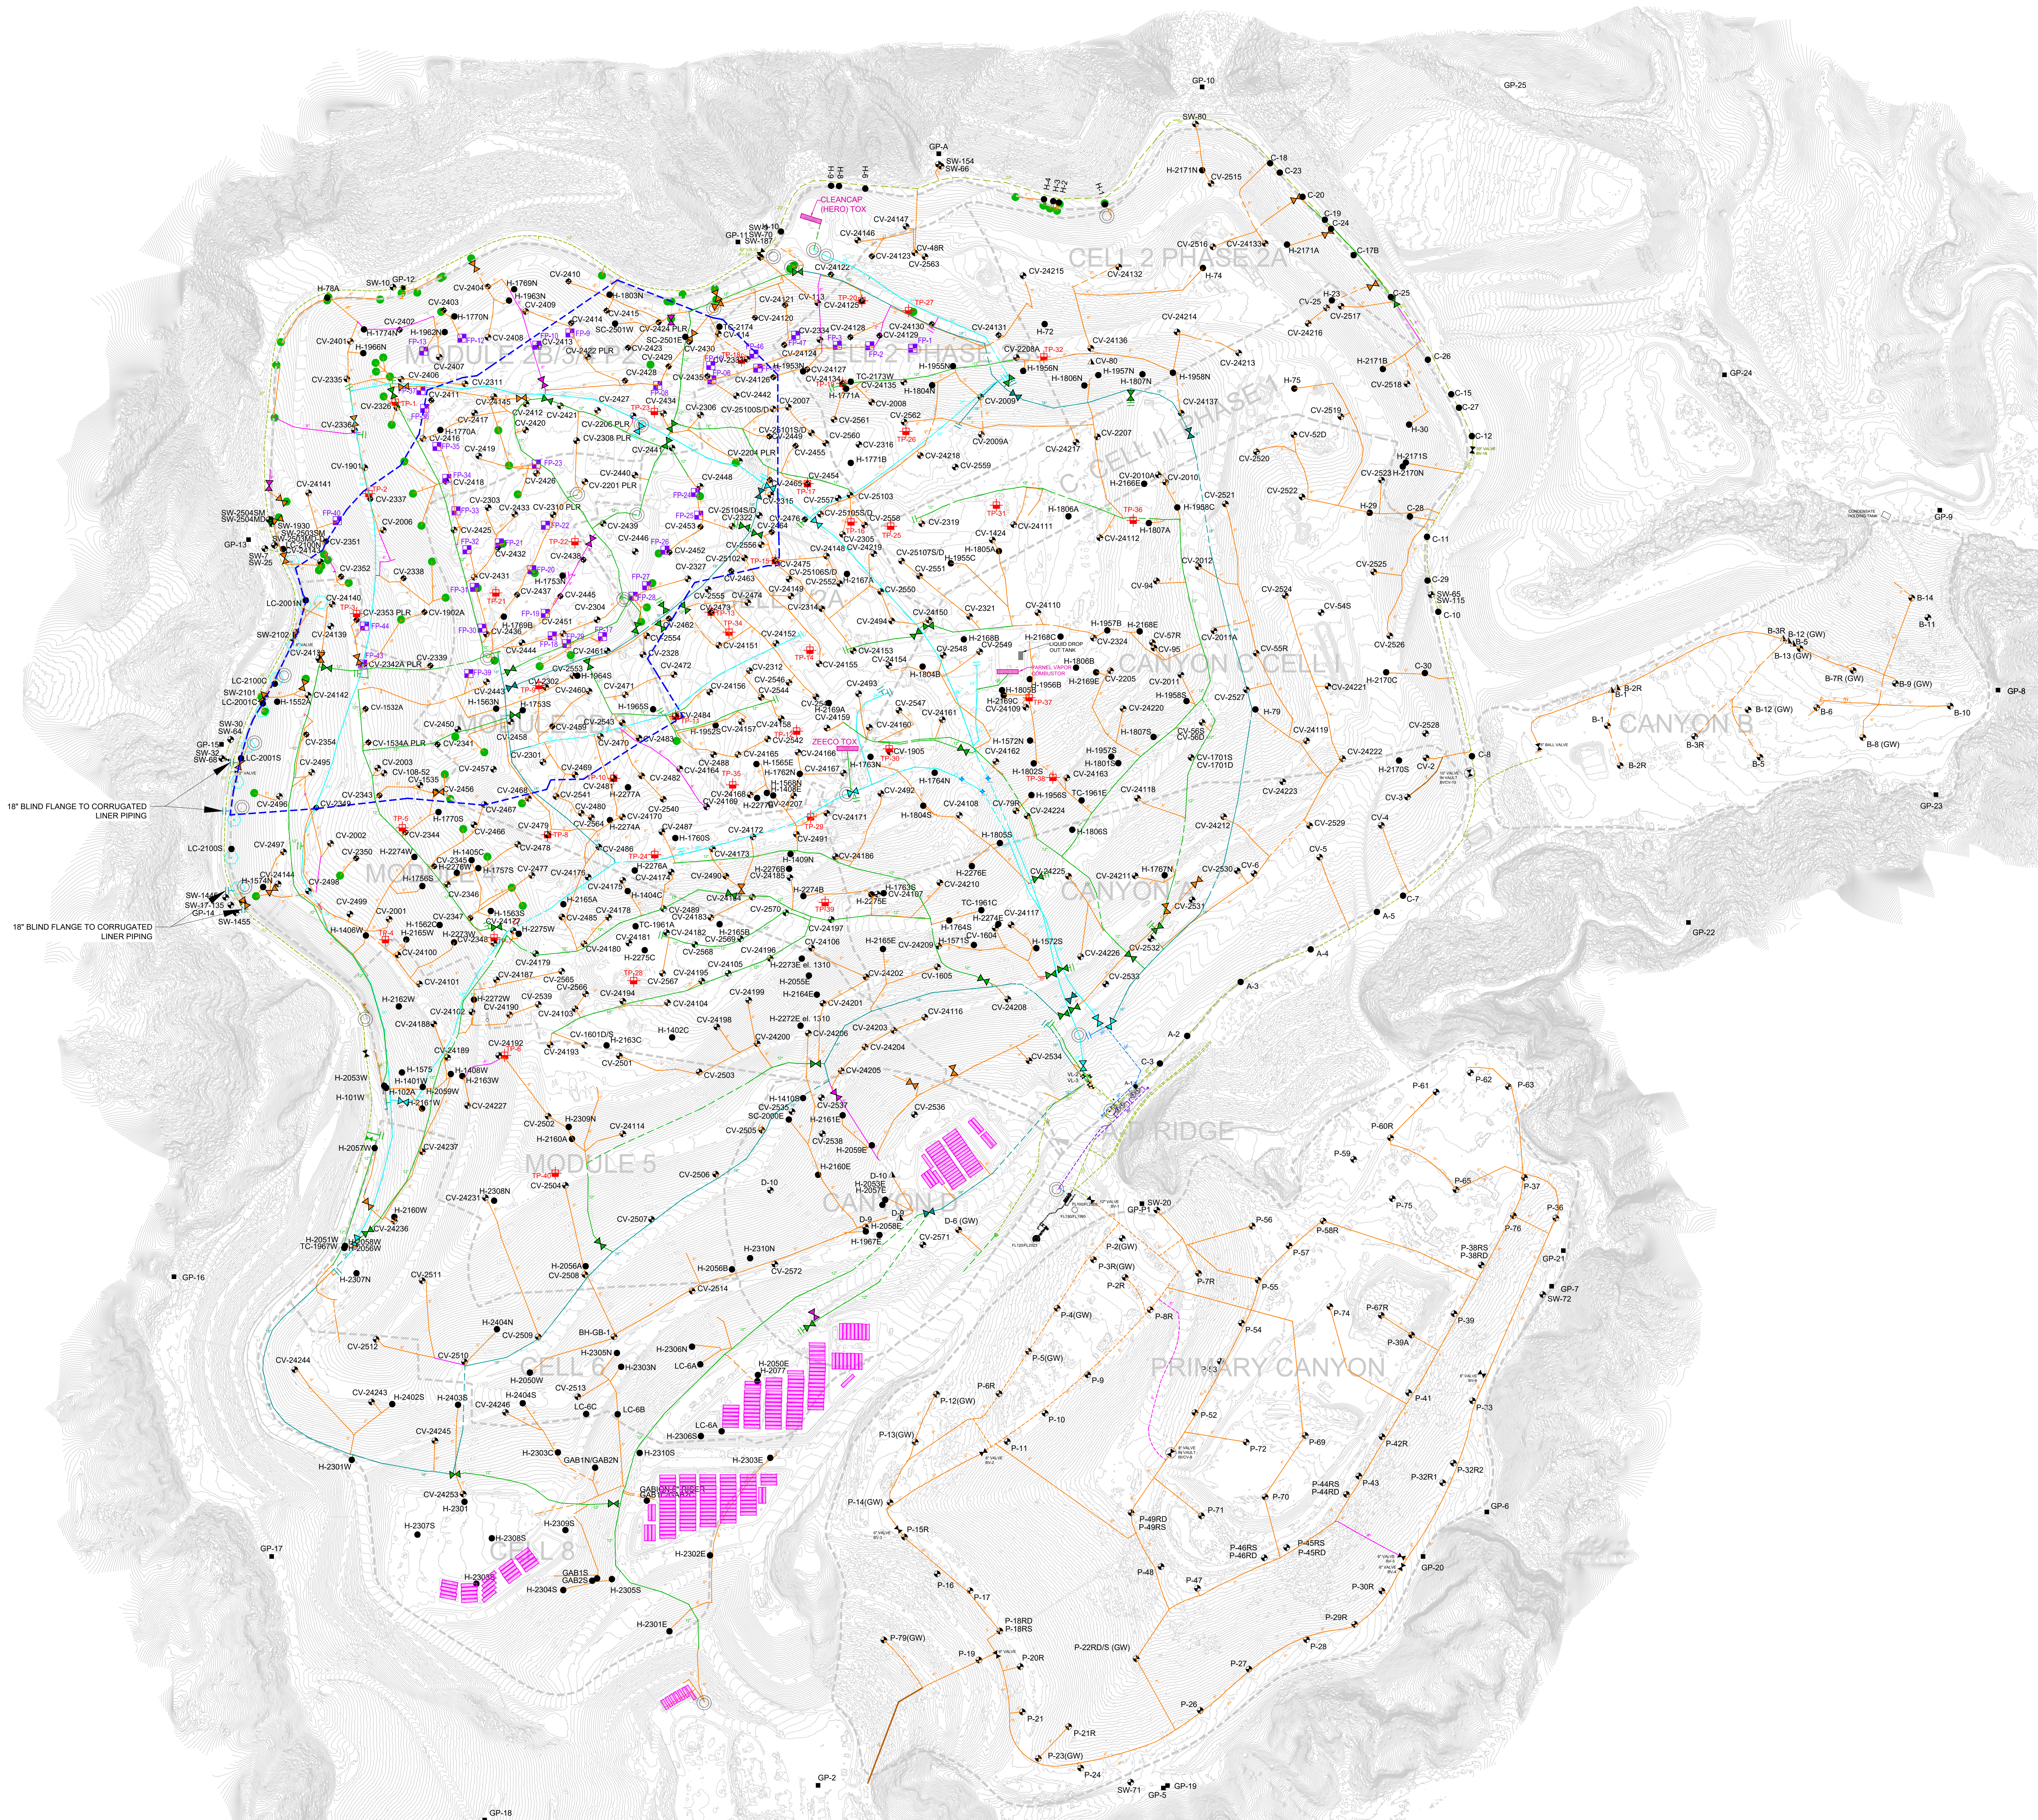

- LEGEND**
- TOPOGRAPHIC CONTOUR
 - EXISTING CELL LIMITS (APPROXIMATE)
 - EXISTING LFG VERTICAL EXTRACTION WELL
 - EXISTING LFG VERTICAL EXTRACTION WELL - PRESSURIZED LEACHATE RELEASE
 - EXISTING GABION LFG COLLECTOR WELL
 - EXISTING SOIL VAPOR EXTRACTION WELL
 - EXISTING SURFACE COLLECTOR WELLHEAD
 - EXISTING HORIZONTAL WELLS
 - EXISTING REMOTE VERTICAL WELLHEAD
 - EXISTING PERIMETER MIGRATION PROBE
 - EXISTING TEMPERATURE PROBE
 - EXISTING ISOLATION VALVE
 - EXISTING ACTIVATED CARBON VESSEL
 - EXISTING CONDENSATE SUMP
 - EXISTING HDPE LINER RISER
 - EXISTING CORRUGATED LINER RISER
 - EXISTING 36" LFG COLLECTION HEADER PIPING
 - EXISTING 30" LFG COLLECTION HEADER PIPING
 - EXISTING 24" LFG COLLECTION HEADER PIPING
 - EXISTING 20" LFG COLLECTION HEADER PIPING
 - EXISTING 18" LFG COLLECTION HEADER PIPING
 - EXISTING 12" LFG COLLECTION HEADER PIPING
 - EXISTING 10" LFG COLLECTION HEADER PIPING
 - EXISTING 8" LFG COLLECTION LATERAL PIPING
 - EXISTING 4" LFG COLLECTION LATERAL PIPING
 - EXISTING 2" LFG COLLECTION LATERAL PIPING
 - BELOW-GRADE PIPES ARE SHOWN DASHED
 - REACTION AREA BOUNDARY (APPROXIMATE) - BASED ON DATA REVIEW
 - EXISTING BLIND FLANGE
 - EXISTING FRAC TANKS

- GENERAL DRAWING NOTES:**
- EXISTING TOPOGRAPHIC SURVEY INFORMATION SHOWN WAS PROVIDED BY PROPELLOR, AERIAL PHOTOGRAPHY DATED JANUARY 14, 2026.
 - NORTH ARROW SHOWN HERE IS REFERENCE TO THE CALIFORNIA STATE PLANE ZONE V COORDINATE SYSTEM, NAD 83.
 - THE LOCATION OF ANY EXISTING PIPING, VALVES, TIE-IN LOCATIONS AND OTHER FEATURES ARE APPROXIMATE AND SHOULD BE USED FOR INFORMATION PURPOSES ONLY. ACTUAL FIELD CONDITIONS MAY VARY AND SUBJECT TO CHANGE BASED ON FUTURE FILL OPERATIONS, TOPOGRAPHIC FEATURES, AND OTHER SITE-SPECIFIC FACTORS.
 - EXISTING GCCS AS-BUILT DATED JANUARY 21, 2026.

SCS ENGINEERS
ENVIRONMENTAL CONSULTANTS

DATE: 01/21/2026
SCALE: AS SHOWN



CHIOUITA CANYON LANDFILL
CASTAIC, CALIFORNIA

SHEET TITLE:
PROJECT TITLE:

EXISTING GCCS MAP

CHIOUITA CANYON LANDFILL
CASTAIC, CALIFORNIA

REVISION

DATE