
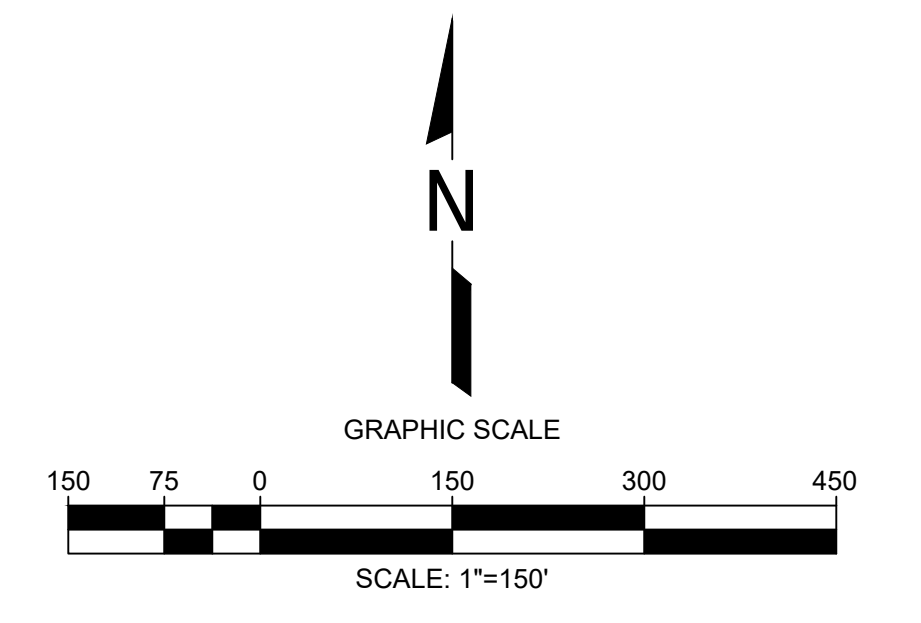


N:\CAD\ASBUILT - MASTERS\CHIOUITA\GCCS\CLCF MASTER EXISTING GCCS MAP_2026-03-04.dwg Mar 04, 2026 - 7:07am Bv.smedina

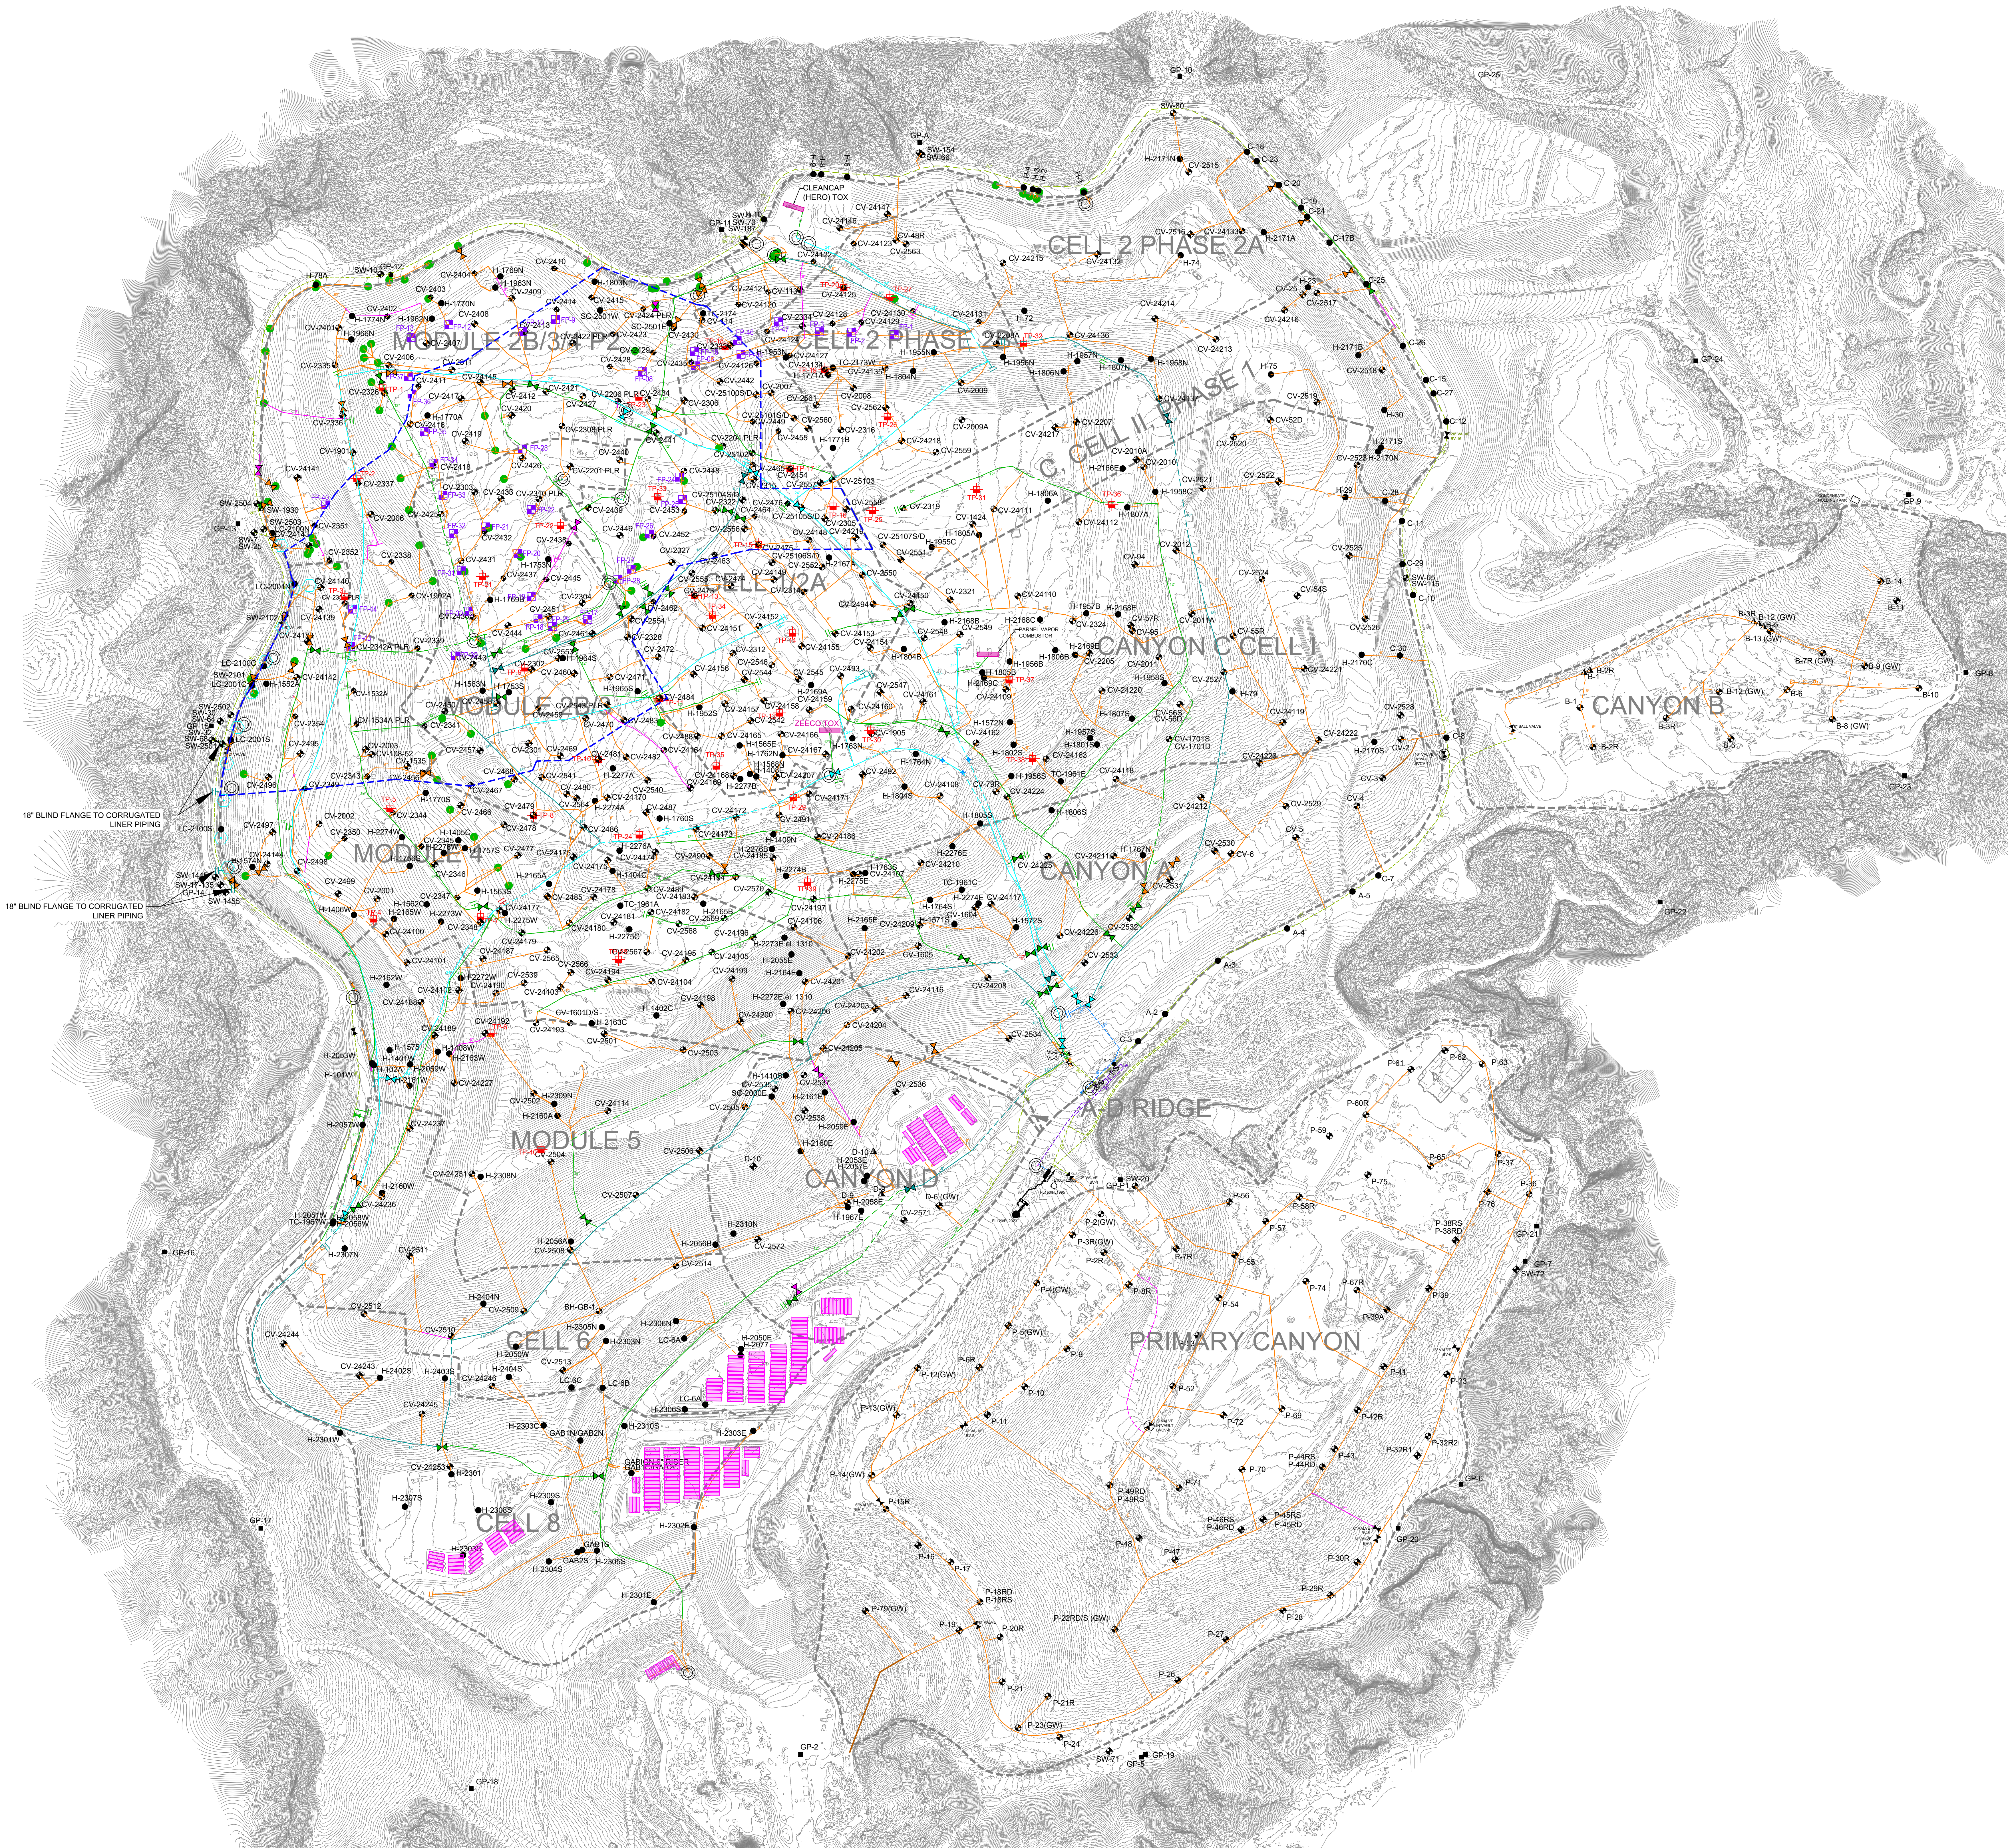

- LEGEND**
- TOPOGRAPHIC CONTOUR
 - - - EXISTING CELL LIMITS (APPROXIMATE)
 - ◆ CV-XX EXISTING LFG VERTICAL EXTRACTION WELL
 - ◆ CV-XX-PLR EXISTING LFG VERTICAL EXTRACTION WELL - PRESSURIZED LEACHATE RELEASE
 - ◆ BH-GW EXISTING GASBON LFG COLLECTOR WELL
 - ◆ SW-XX EXISTING SOIL VAPOR EXTRACTION WELL
 - ◆ FP-XX EXISTING SURFACE COLLECTOR WELLHEAD
 - H-XX EXISTING HORIZONTAL WELLS
 - EXISTING REMOTE VERTICAL WELLHEAD
 - ▲ C-XX EXISTING PERIMETER MIGRATION PROBE
 - ◆ TP-XX EXISTING TEMPERATURE PROBE
 - ⊗ EXISTING ISOLATION VALVE
 - ⊙ EXISTING ACTIVATED CARBON VESSEL
 - ⊙ EXISTING CONDENSATE SUMP
 - EXISTING HDPE LINER RISER
 - EXISTING CORRUGATED LINER RISER
 - 36" EXISTING 36" LFG COLLECTION HEADER PIPING
 - 30" EXISTING 30" LFG COLLECTION HEADER PIPING
 - 24" EXISTING 24" LFG COLLECTION HEADER PIPING
 - 20" EXISTING 20" LFG COLLECTION HEADER PIPING
 - 18" EXISTING 18" LFG COLLECTION HEADER PIPING
 - 12" EXISTING 12" LFG COLLECTION HEADER PIPING
 - 10" EXISTING 10" LFG COLLECTION HEADER PIPING
 - 8" EXISTING 8" LFG COLLECTION LATERAL PIPING
 - 4" EXISTING 4" LFG COLLECTION LATERAL PIPING
 - 2" EXISTING 2" LFG COLLECTION LATERAL PIPING
 - - - BELOW-GRADE PIPES ARE SHOWN DASHED
 - - - REACTION AREA BOUNDARY (APPROXIMATE) - BASED ON DATA REVIEW
 - ⊕ EXISTING BLIND FLANGE
 - EXISTING FRAC TANKS

- GENERAL DRAWING NOTES**
- EXISTING TOPOGRAPHIC SURVEY INFORMATION WAS PROVIDED BY PROPELLER, AERIAL PHOTOGRAPHY DATED FEBRUARY 10, 2026.
 - NORTH ARROW SHOWN HERE IS REFERENCE TO THE CALIFORNIA STATE PLANE ZONE V COORDINATE SYSTEM, NAD 83.
 - THE LOCATION OF ANY EXISTING PIPING, VALVES, TIE-IN LOCATIONS AND OTHER FEATURES ARE APPROXIMATE AND SHOULD BE USED FOR INFORMATION PURPOSES ONLY. ACTUAL FIELD CONDITIONS MAY VARY AND SUBJECT TO CHANGE BASED ON TOPOGRAPHIC FEATURES AND OTHER SITE-SPECIFIC FACTORS.
 - EXISTING GCCS AS-BUILT DATED MARCH 04, 2026.

DATE:	
REVISION:	
NO.	
EXISTING GCCS MAP	
CHIOUITA CANYON LANDFILL CASTAIC, CALIFORNIA	
CHIOUITA CANYON LANDFILL CASTAIC, CALIFORNIA	
CLIENT:	
SCS ENGINEERS ENVIRONMENTAL CONSULTANTS	
DATE:	03/04/2026
SCALE:	AS SHOWN
1 of 1	