
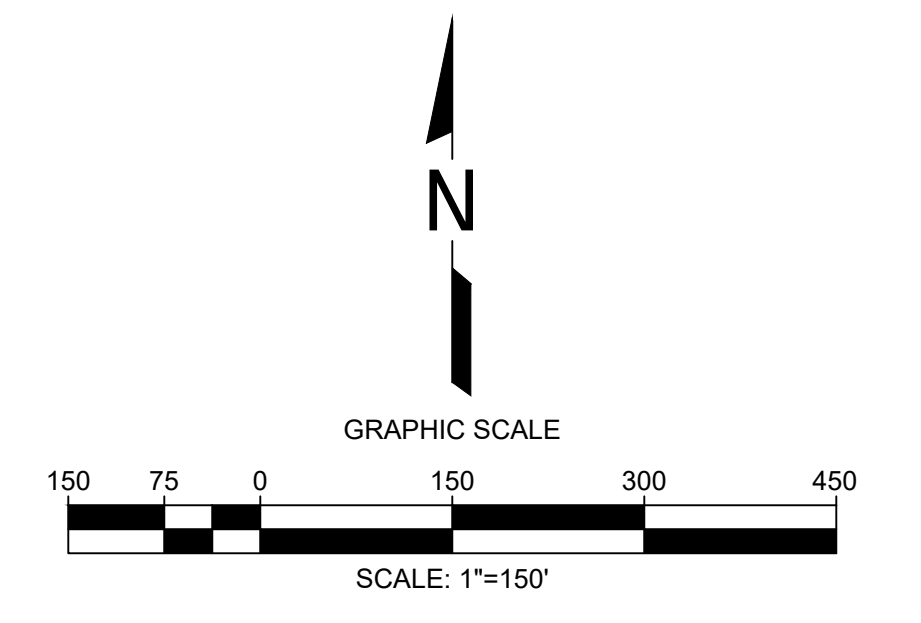



\\CAD\ASBUILT - MASTERS\CHIOUITA\GCCS\CCCLF MASTER EXISTING GCCS MAP_2026-04-08.dwg Apr 15, 2026 1:55pm By: akaram

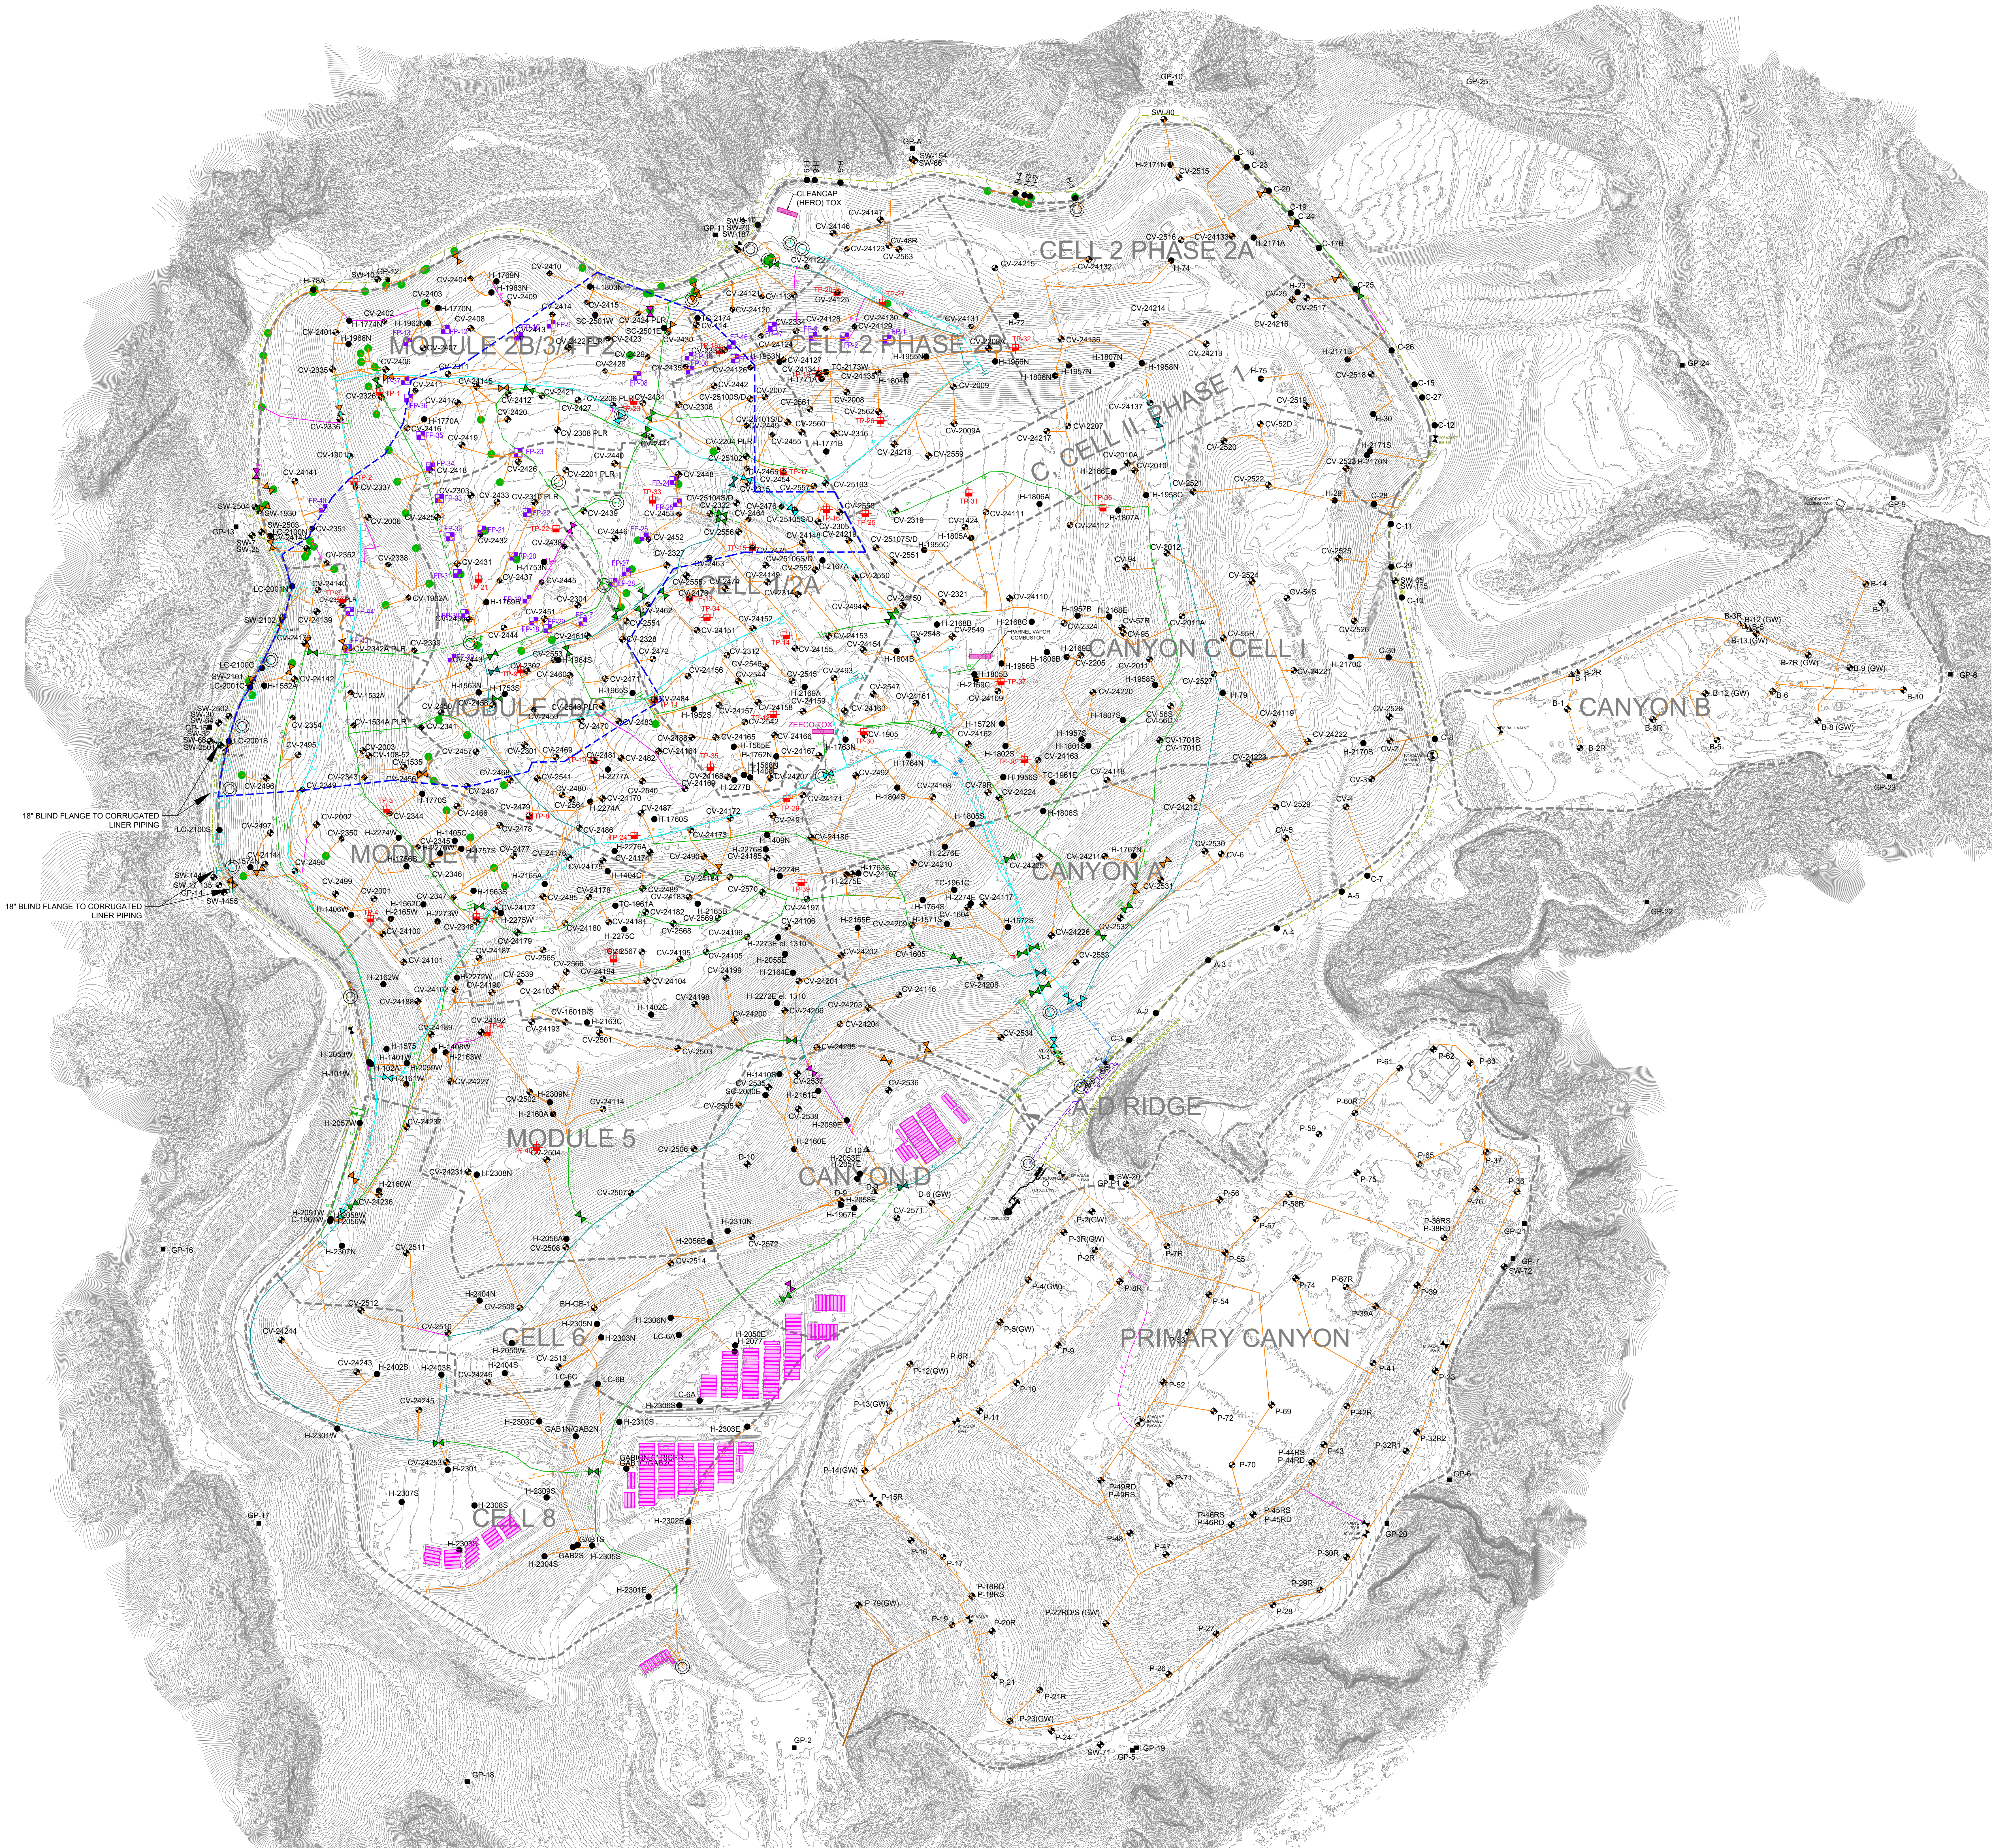

LEGEND

1150	TOPOGRAPHIC CONTOUR
---	EXISTING CELL LIMITS (APPROXIMATE)
◆ CV-XX	EXISTING LFG VERTICAL EXTRACTION WELL
◆ CV-XX-PLR	EXISTING LFG VERTICAL EXTRACTION WELL - PRESSURIZED LEACHATE RELEASE
◆ BH-GW	EXISTING GABION LFG COLLECTOR WELL
◆ SW-XX	EXISTING SOIL VAPOR EXTRACTION WELL
◆ FP-XX	EXISTING SURFACE COLLECTOR WELL HEAD
● H-XX	EXISTING HORIZONTAL WELLS
▲ C-XX	EXISTING REMOTE VERTICAL WELL HEAD
■ GP-XX	EXISTING PERIMETER MIGRATION PROBE
◆ TP-XX	EXISTING TEMPERATURE PROBE
⊗	EXISTING ISOLATION VALVE
⊙	EXISTING ACTIVATED CARBON VESSEL
⊙	EXISTING CONDENSATE SUMP
●	EXISTING HDPE LINER RISER
○	EXISTING CORRUGATED LINER RISER
—	EXISTING 36" LFG COLLECTION HEADER PIPING
—	EXISTING 30" LFG COLLECTION HEADER PIPING
—	EXISTING 24" LFG COLLECTION HEADER PIPING
—	EXISTING 20" LFG COLLECTION HEADER PIPING
—	EXISTING 18" LFG COLLECTION HEADER PIPING
—	EXISTING 12" LFG COLLECTION HEADER PIPING
—	EXISTING 10" LFG COLLECTION HEADER PIPING
—	EXISTING 8" LFG COLLECTION LATERAL PIPING
—	EXISTING 4" LFG COLLECTION LATERAL PIPING
—	EXISTING 2" LFG COLLECTION LATERAL PIPING
---	BELOW-GRADE PIPES ARE SHOWN DASHED
---	REACTION AREA BOUNDARY (APPROXIMATE) - BASED ON DATA REVIEW
—	EXISTING BLIND FLANGE
■	EXISTING FRAC TANKS

- GENERAL DRAWING NOTES**
- EXISTING TOPOGRAPHIC SURVEY INFORMATION SHOWN WAS PROVIDED BY PROPELLOR, AERIAL PHOTOGRAPHY DATED APRIL 08, 2026.
 - NORTH ARROW SHOWN HERE IS REFERENCE TO THE CALIFORNIA STATE PLANE ZONE V COORDINATE SYSTEM, NAD 83.
 - THE LOCATION OF ANY EXISTING PIPING, VALVES, TIE-IN LOCATIONS AND OTHER FEATURES ARE APPROXIMATE AND SHOULD BE USED FOR INFORMATION PURPOSES ONLY. ACTUAL FIELD CONDITIONS MAY VARY AND SUBJECT TO CHANGE BASED ON TOPOGRAPHIC FEATURES AND OTHER SITE-SPECIFIC FACTORS.
 - EXISTING GCCS AS-BUILT DATED APRIL 08, 2026.

DATE	
REVISION	
NO.	
EXISTING GCCS MAP	
CHIQUITA CANYON LANDFILL CASTAIC, CALIFORNIA	
SHEET TITLE:	
PROJECT TITLE:	
CLIENT:	
 CHIQUITA CANYON LANDFILL CASTAIC, CALIFORNIA	
DATE:	04/15/2026
SCALE:	AS SHOWN
1 of 1	