
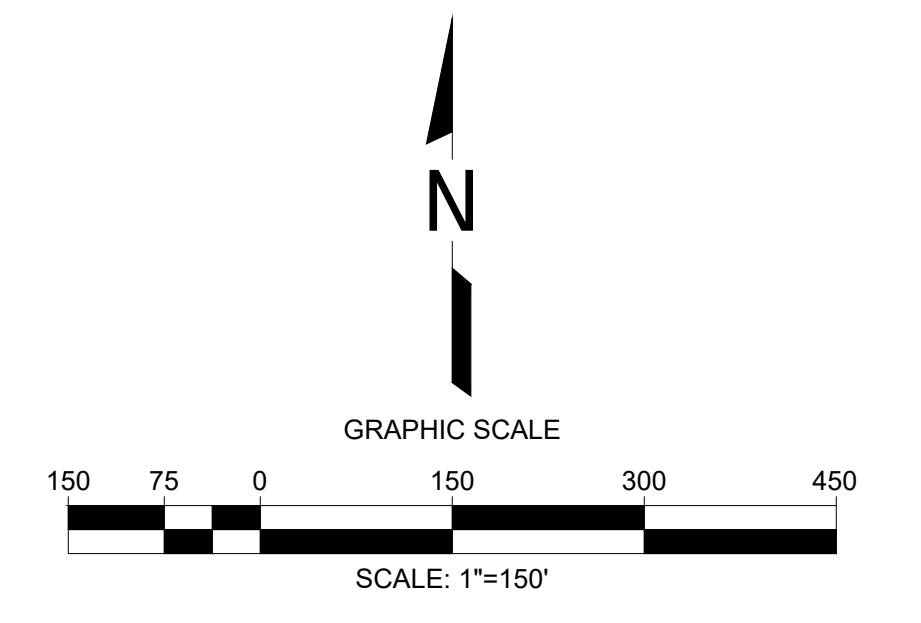


N:\CAD\ASBUILT - MASTERS\CHIOUITA\GCCS\CCCLF MASTER EXISTING GCCS MAP_2026-04-01.dwg Apr 01, 2026 - 8:10am By: smcdina

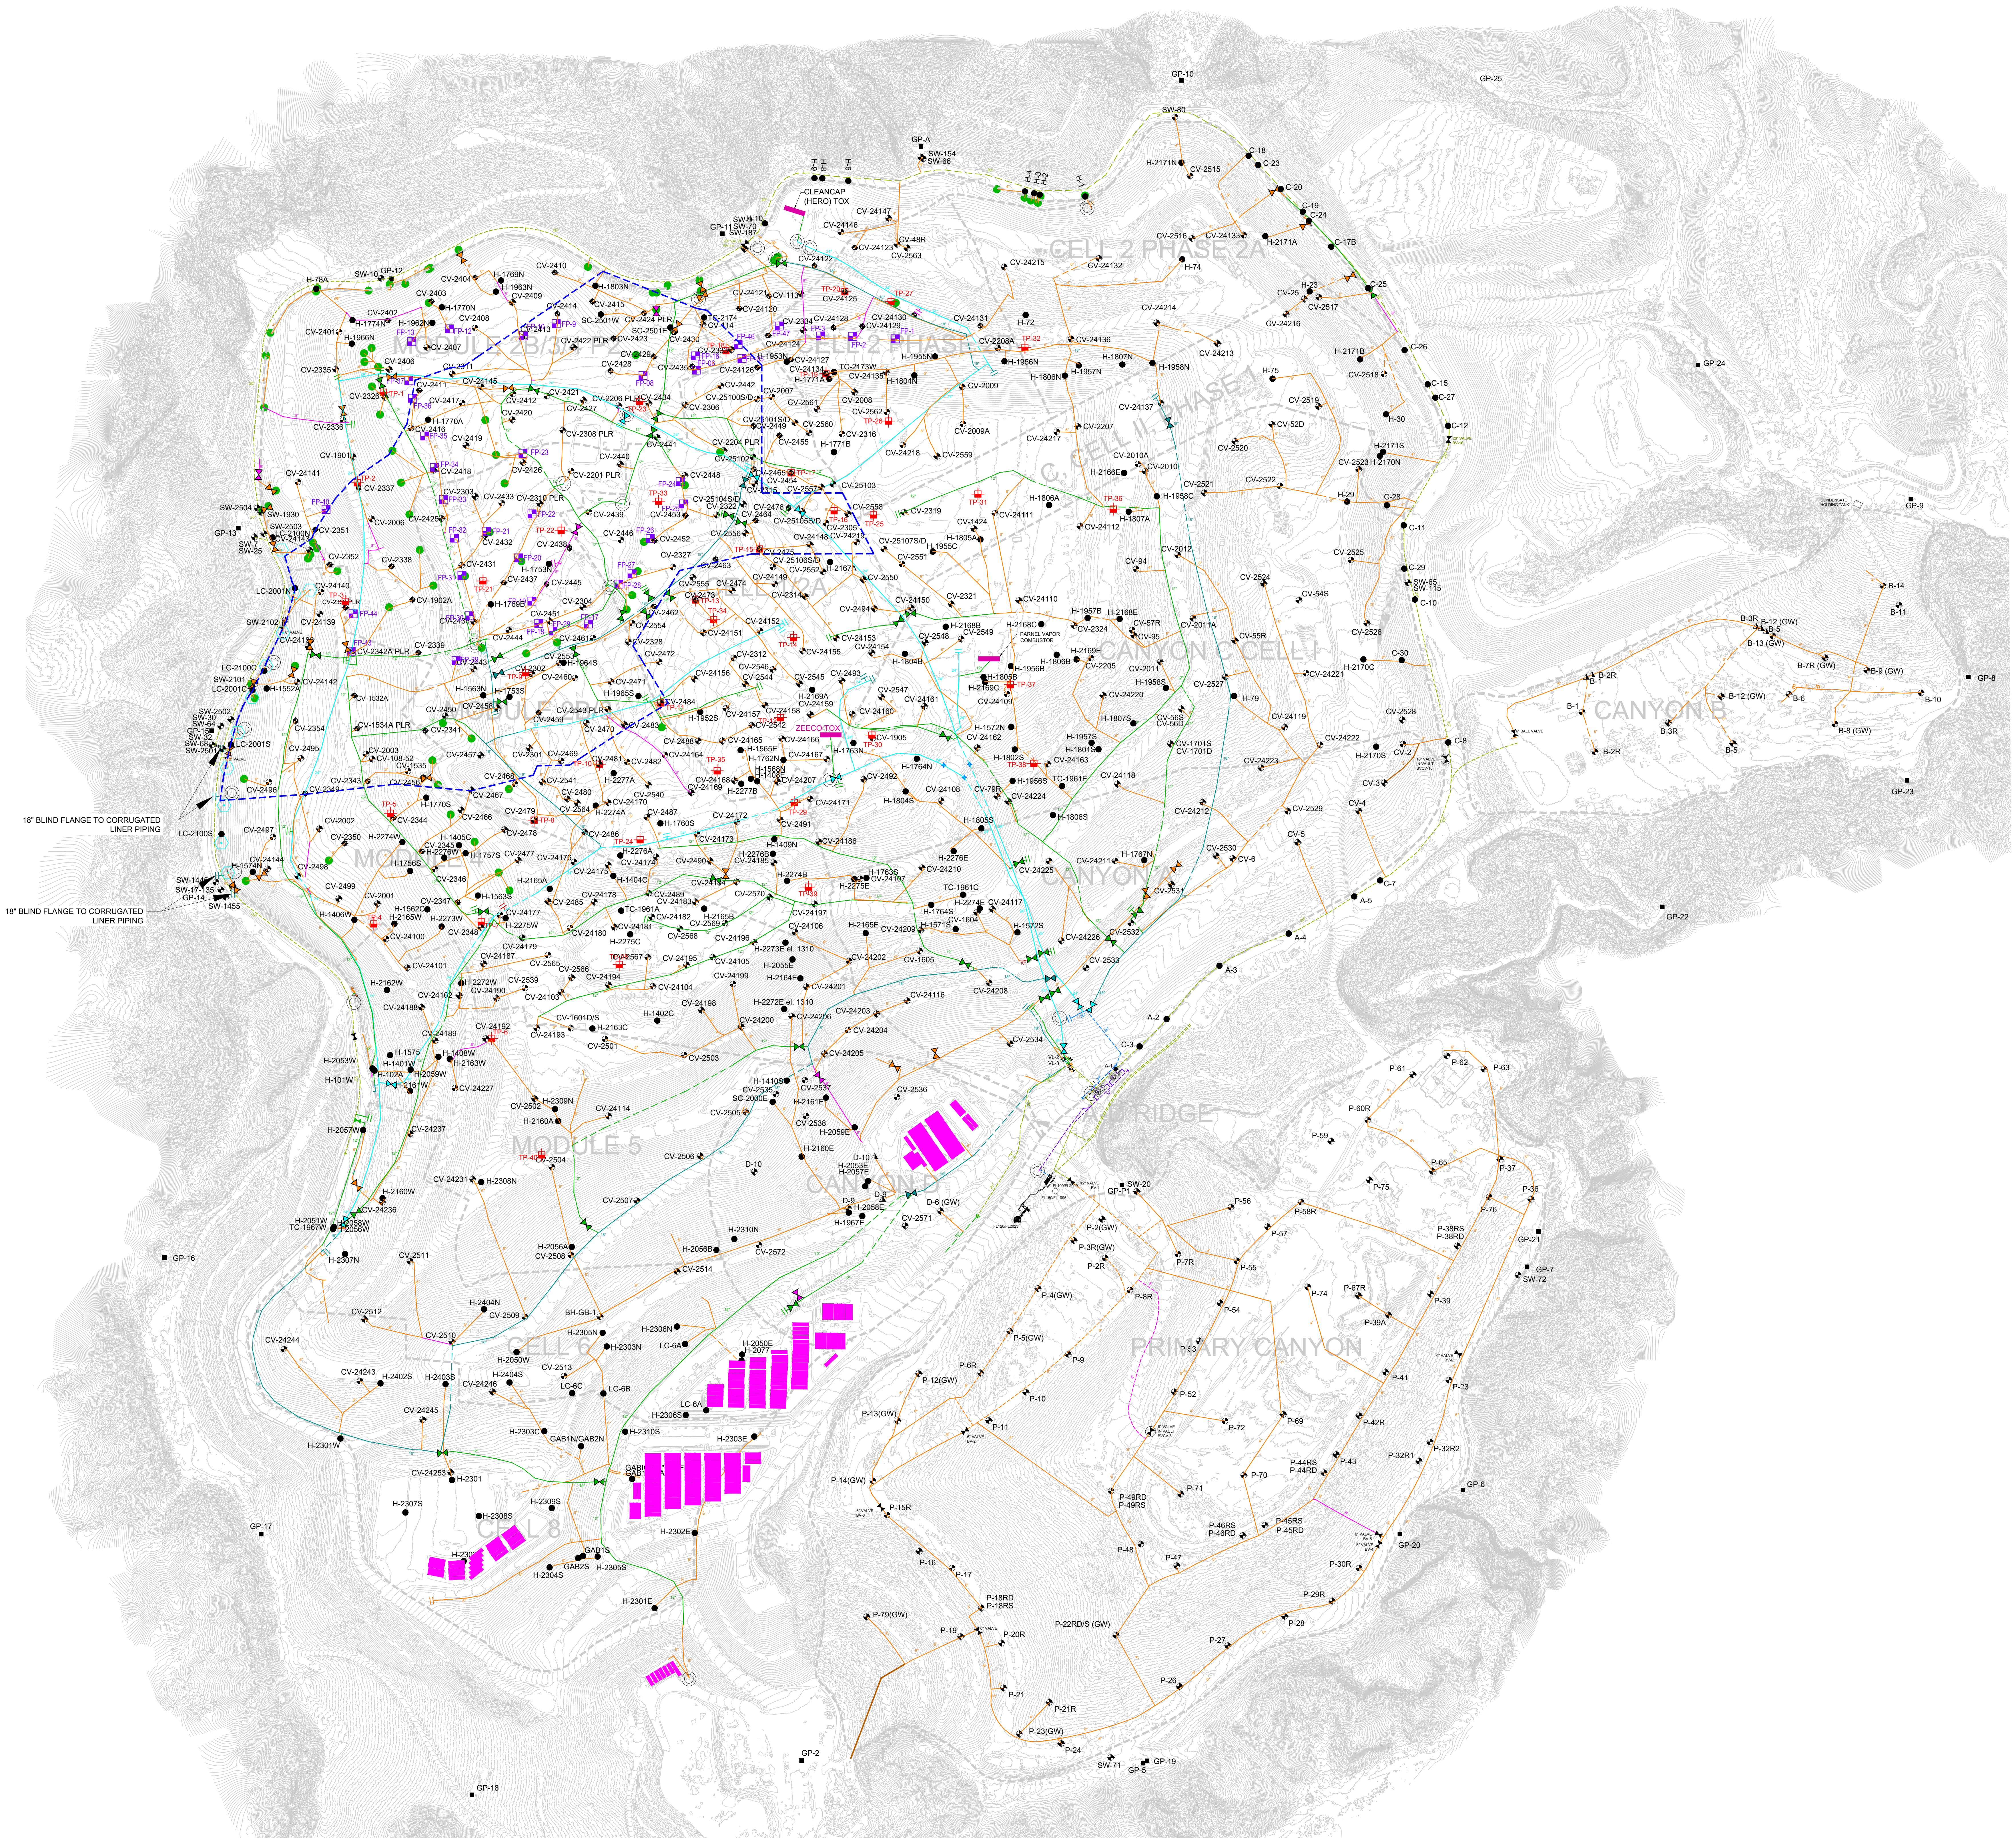

- LEGEND**
- TOPOGRAPHIC CONTOUR
 - - - - EXISTING CELL LIMITS (APPROXIMATE)
 - CV-XX EXISTING LFG VERTICAL EXTRACTION WELL
 - CV-XX-PLR EXISTING LFG VERTICAL EXTRACTION WELL - PRESSURIZED LEACHATE RELEASE
 - BH-GB EXISTING GASBION LFG COLLECTOR WELL
 - SW-XX EXISTING SOIL VAPOR EXTRACTION WELL
 - FP-XX EXISTING SURFACE COLLECTOR WELLHEAD
 - H-XX EXISTING HORIZONTAL WELLS
 - RM-XX EXISTING REMOTE VERTICAL WELLHEAD
 - MP-XX EXISTING PERIMETER MIGRATION PROBE
 - TP-XX EXISTING TEMPERATURE PROBE
 - IV EXISTING ISOLATION VALVE
 - AC EXISTING ACTIVATED CARBON VESSEL
 - CS EXISTING CONDENSATE SUMP
 - GR EXISTING HDPE LINER RISER
 - CR EXISTING CORRUGATED LINER RISER
 - 36" EXISTING 36" LFG COLLECTION HEADER PIPING
 - 30" EXISTING 30" LFG COLLECTION HEADER PIPING
 - 24" EXISTING 24" LFG COLLECTION HEADER PIPING
 - 20" EXISTING 20" LFG COLLECTION HEADER PIPING
 - 18" EXISTING 18" LFG COLLECTION HEADER PIPING
 - 12" EXISTING 12" LFG COLLECTION HEADER PIPING
 - 10" EXISTING 10" LFG COLLECTION HEADER PIPING
 - 8" EXISTING 8" LFG COLLECTION LATERAL PIPING
 - 4/8" EXISTING 4/8" LFG COLLECTION LATERAL PIPING
 - 2" EXISTING 2" LFG COLLECTION LATERAL PIPING
 - - - - BELOW-GRADE PIPES ARE SHOWN DASHED
 - - - - REACTION AREA BOUNDARY (APPROXIMATE) - BASED ON DATA REVIEW
 - IF EXISTING BLIND FLANGE
 - EXISTING FRAC TANKS

- GENERAL DRAWING NOTES**
- EXISTING TOPOGRAPHIC SURVEY INFORMATION WAS PROVIDED BY PROPELLOR, AERIAL PHOTOGRAPHY DATED MARCH 04, 2026.
 - NORTH ARROW SHOWN HERE IS REFERENCE TO THE CALIFORNIA STATE PLANE ZONE V COORDINATE SYSTEM, NAD 83.
 - THE LOCATION OF ANY EXISTING PIPING, VALVES, TIE-IN LOCATIONS AND OTHER FEATURES ARE APPROXIMATE AND SHOULD BE USED FOR INFORMATION PURPOSES ONLY. ACTUAL FIELD CONDITIONS MAY VARY AND SUBJECT TO CHANGE BASED ON TOPOGRAPHIC FEATURES AND OTHER SITE-SPECIFIC FACTORS.
 - EXISTING GCCS AS-BUILT DATED APRIL 01, 2026.

DATE		REVISION		NO.		SHEET TITLE:	EXISTING GCCS MAP
				PROJECT TITLE:			
				CHIOUITA CANYON LANDFILL CASTAIC, CALIFORNIA			
				CLIENT:			
				SCS ENGINEERS ENVIRONMENTAL CONSULTANTS			
				DATE:			
				04/01/2026			
				SCALE:			
				AS SHOWN			
				1 of 1			