
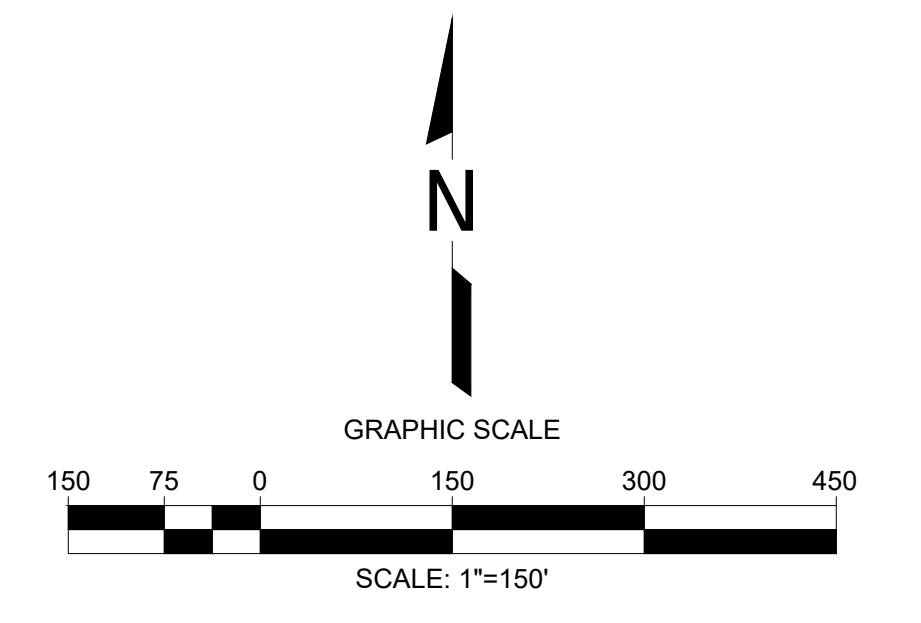


\\LBC-FS01\Data\CAD\ASBUILT - MASTERS\CHIOUITA\GCCS\CCF\_MASTER\_EXISTING\_GCCS\_MAP\_2026-05-27.dwg, May 27, 2026 - 3:17pm By: smedina

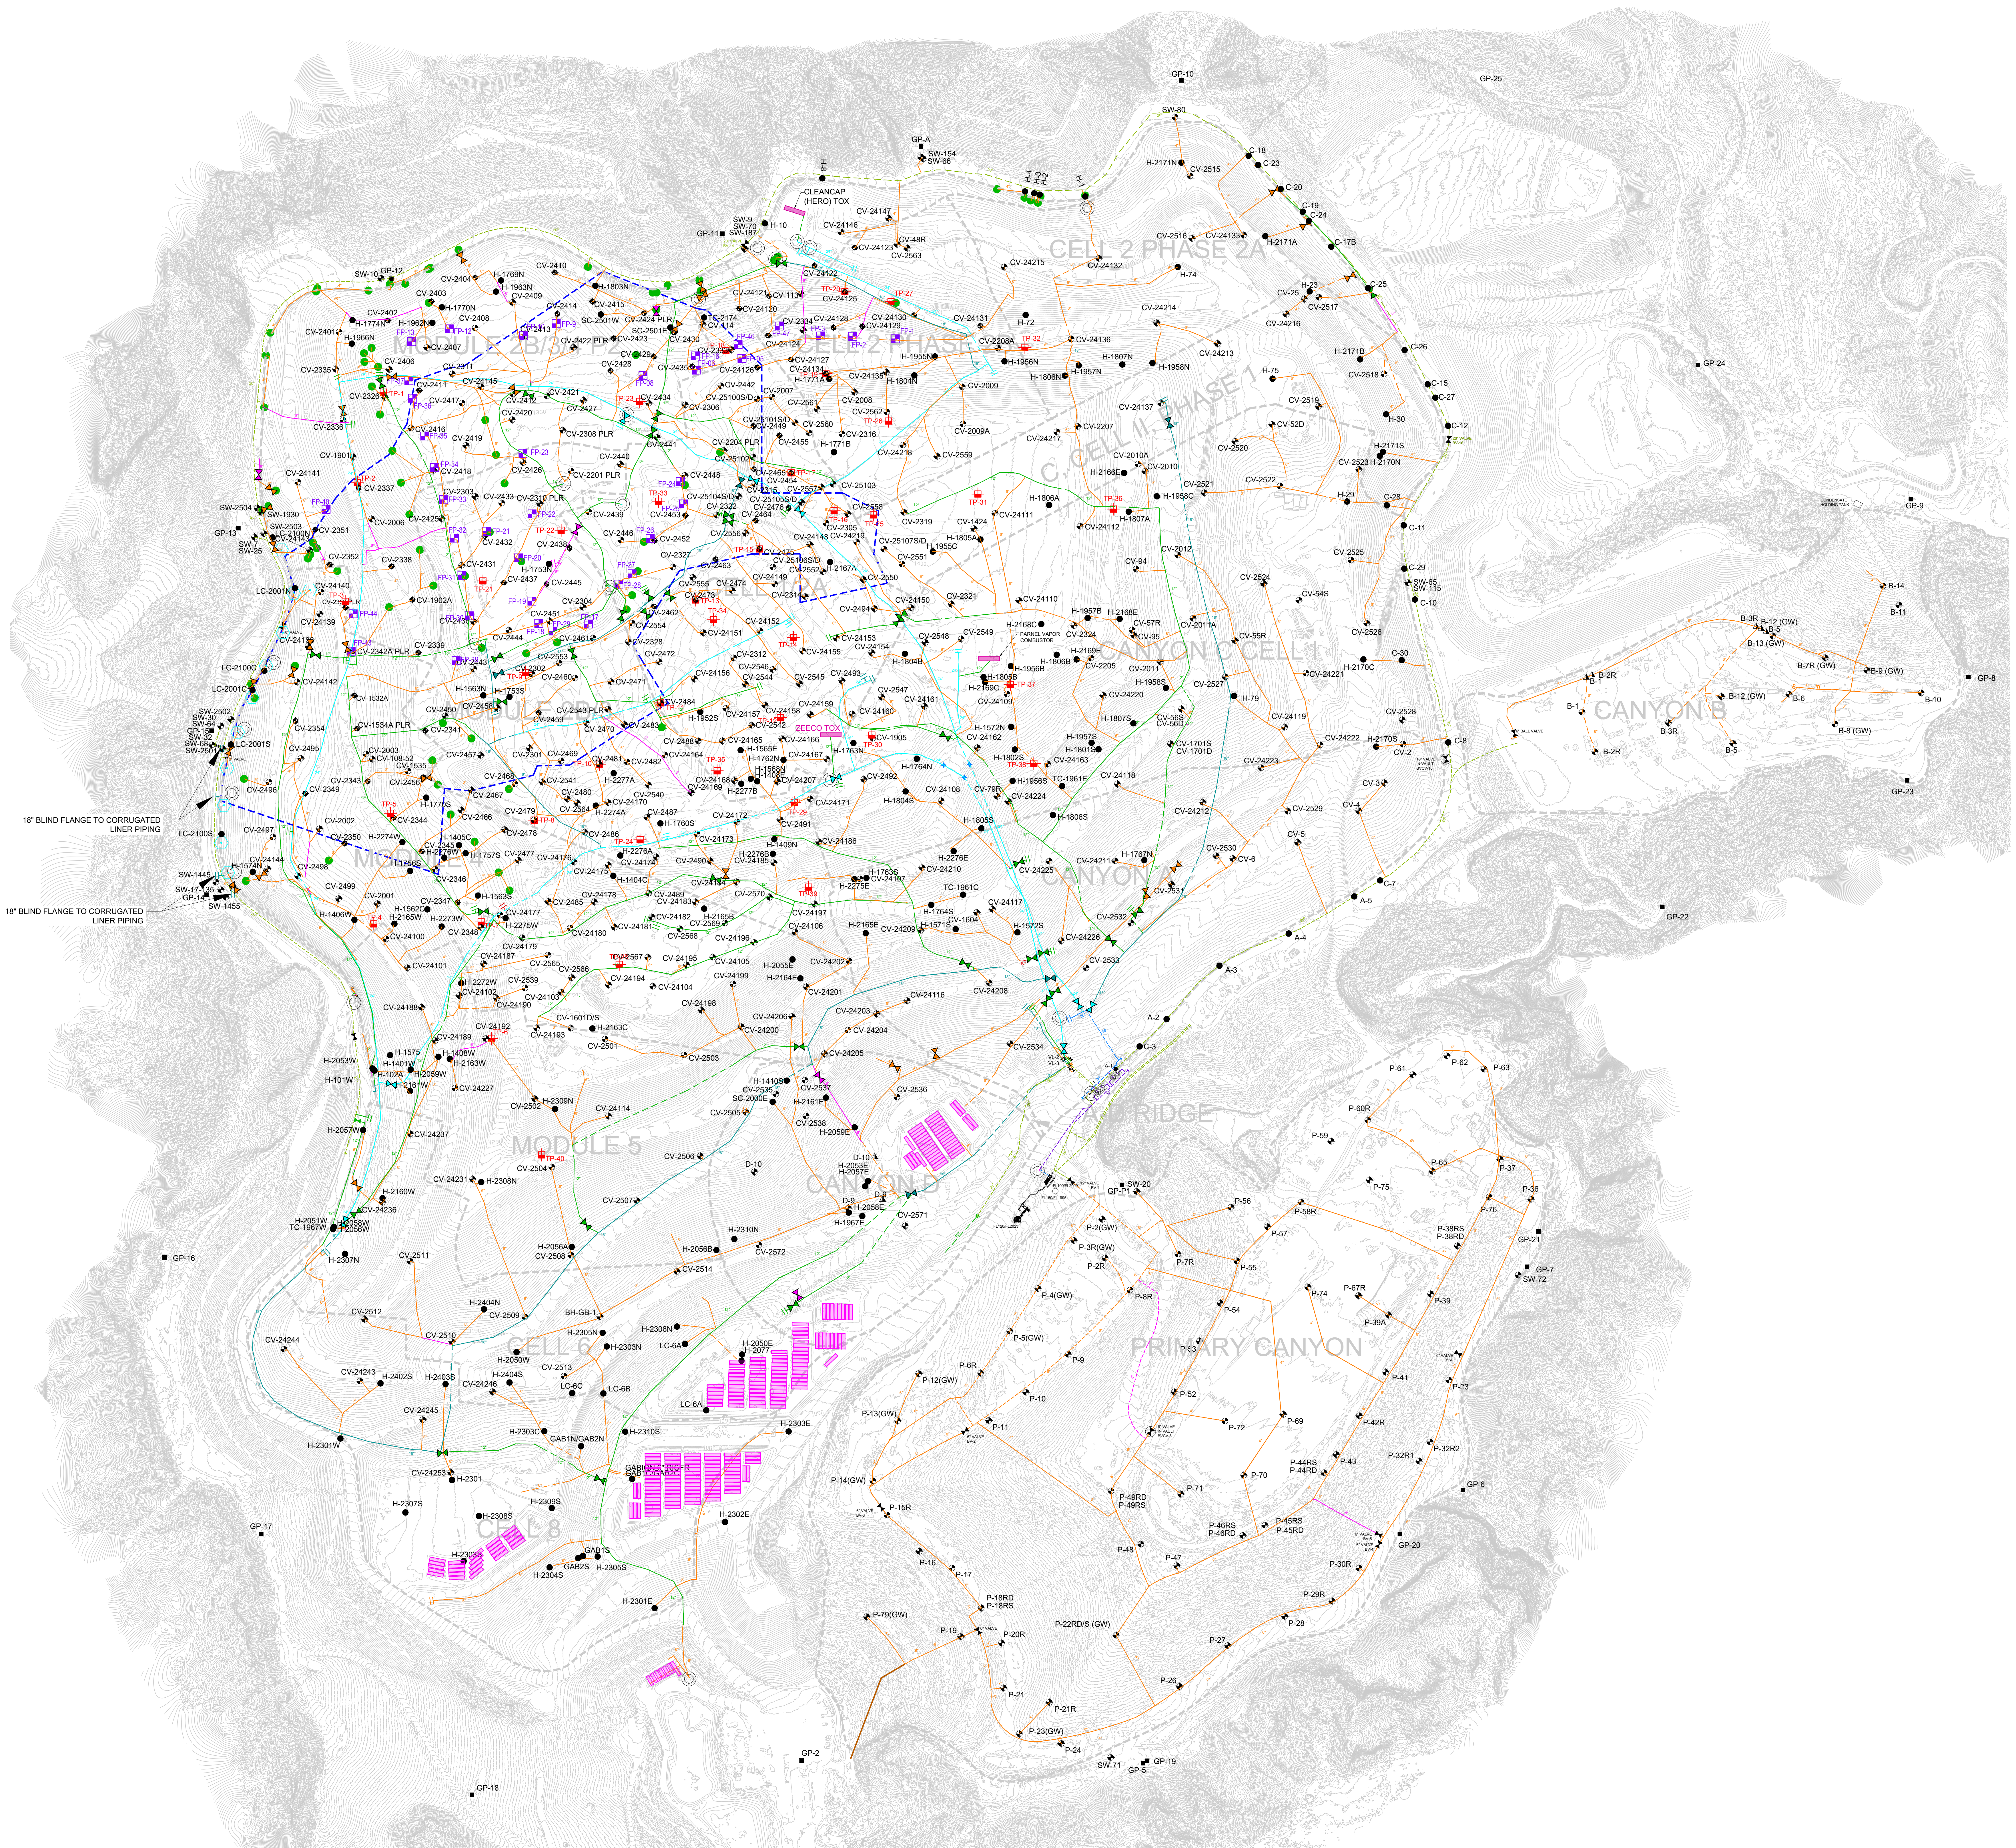

- LEGEND**
- TOPOGRAPHIC CONTOUR
  - - - - - EXISTING CELL LIMITS (APPROXIMATE)
  - ▼ CV/B/D/P-XX EXISTING LFG VERTICAL EXTRACTION WELL - MAIN CANYON, CANYON B, CANYON D, PRIMARY CANYON
  - ▼ CV-VX PLR EXISTING LFG VERTICAL EXTRACTION WELL - PRESSURIZED LEACHATE RELEASE
  - ▼ BH-GB EXISTING GABION LFG COLLECTOR WELL
  - ▼ SW-XX EXISTING SOIL VAPOR EXTRACTION WELL
  - ▼ FR-XX EXISTING SURFACE COLLECTOR WELHEAD
  - H/T/C-XX EXISTING HORIZONTAL, TRENCH, SLOPE, COLLECTOR WELL
  - ▲ C-XX EXISTING REMOTE VERTICAL WELLHEAD
  - GP-XX EXISTING PERIMETER MIGRATION PROBE
  - TP-XX EXISTING TEMPERATURE PROBE
  - EXISTING ISOLATION VALVE
  - EXISTING ACTIVATED CARBON VESSEL
  - EXISTING CONDENSATE SUMP
  - EXISTING HDPE LINER RISER
  - EXISTING CORRUGATED LINER RISER
  - 36" EXISTING 36" LFG COLLECTION HEADER PIPING
  - 30" EXISTING 30" LFG COLLECTION HEADER PIPING
  - 24" EXISTING 24" LFG COLLECTION HEADER PIPING
  - 20" EXISTING 20" LFG COLLECTION HEADER PIPING
  - 18" EXISTING 18" LFG COLLECTION HEADER PIPING
  - 12" EXISTING 12" LFG COLLECTION HEADER PIPING
  - 10" EXISTING 10" LFG COLLECTION HEADER PIPING
  - 8" EXISTING 8" LFG COLLECTION LATERAL PIPING
  - 4" EXISTING 4" LFG COLLECTION LATERAL PIPING
  - - - - - BELOW-GRADE PIPES ARE SHOWN DASHED
  - - - - - REACTION AREA BOUNDARY (APPROXIMATE) - BASED ON DATA REVIEW
  - EXISTING BLIND FLANGE
  - EXISTING FRAC TANKS

- GENERAL DRAWING NOTES**
1. EXISTING TOPOGRAPHIC SURVEY INFORMATION SHOWN BY PROPELLOR, AERIAL PHOTOGRAPHY DATED MAY 06, 2026.
  2. NORTH ARROW SHOWN HERE IS REFERENCE TO THE CALIFORNIA STATE PLANE ZONE V COORDINATE SYSTEM, NAD 83.
  3. THE LOCATION OF ANY EXISTING PIPING, VALVES, TIE-IN LOCATIONS AND OTHER FEATURES ARE APPROXIMATE AND SHOULD BE USED FOR INFORMATION PURPOSES ONLY. ACTUAL FIELD CONDITIONS MAY VARY AND SUBJECT TO CHANGE BASED ON TOPOGRAPHIC FEATURES AND OTHER SITE-SPECIFIC FACTORS.
  4. EXISTING GCCS AS-BUILT DATED MAY 27, 2026.

DATE		REVISION							
NO.	DATE	BY	CHK	APP	DATE	EXISTING GCCS MAP <b>CHIOUITA CANYON LANDFILL</b> CASTAIC, CALIFORNIA			
PROJECT TITLE:									
<b>SCS ENGINEERS</b> ENVIRONMENTAL CONSULTANTS 13000 BENTLEY AVENUE, SUITE 300 CASTAIC, CA 91304 PH: (661) 256-6644									
DATE:	05/27/2026				SCALE:	AS SHOWN			
1 of 1									