
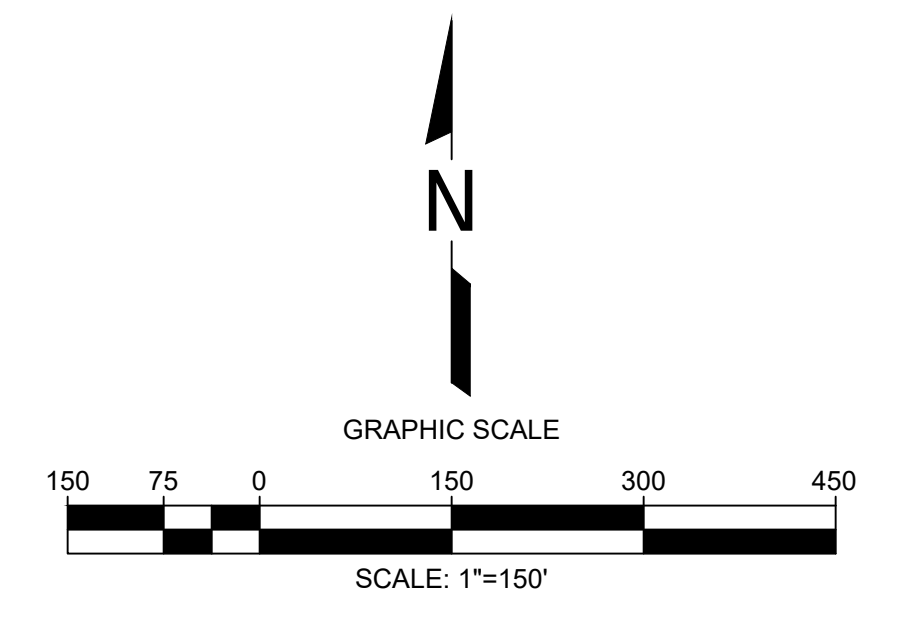


N:\CAD\ASBULT - MASTERS\CHIOUITA\GCCS\CLCF MASTER EXISTING GCCS MAP\_2026-06-03.dwg Jun 03, 2026 1:20:10pm By: raulramirez

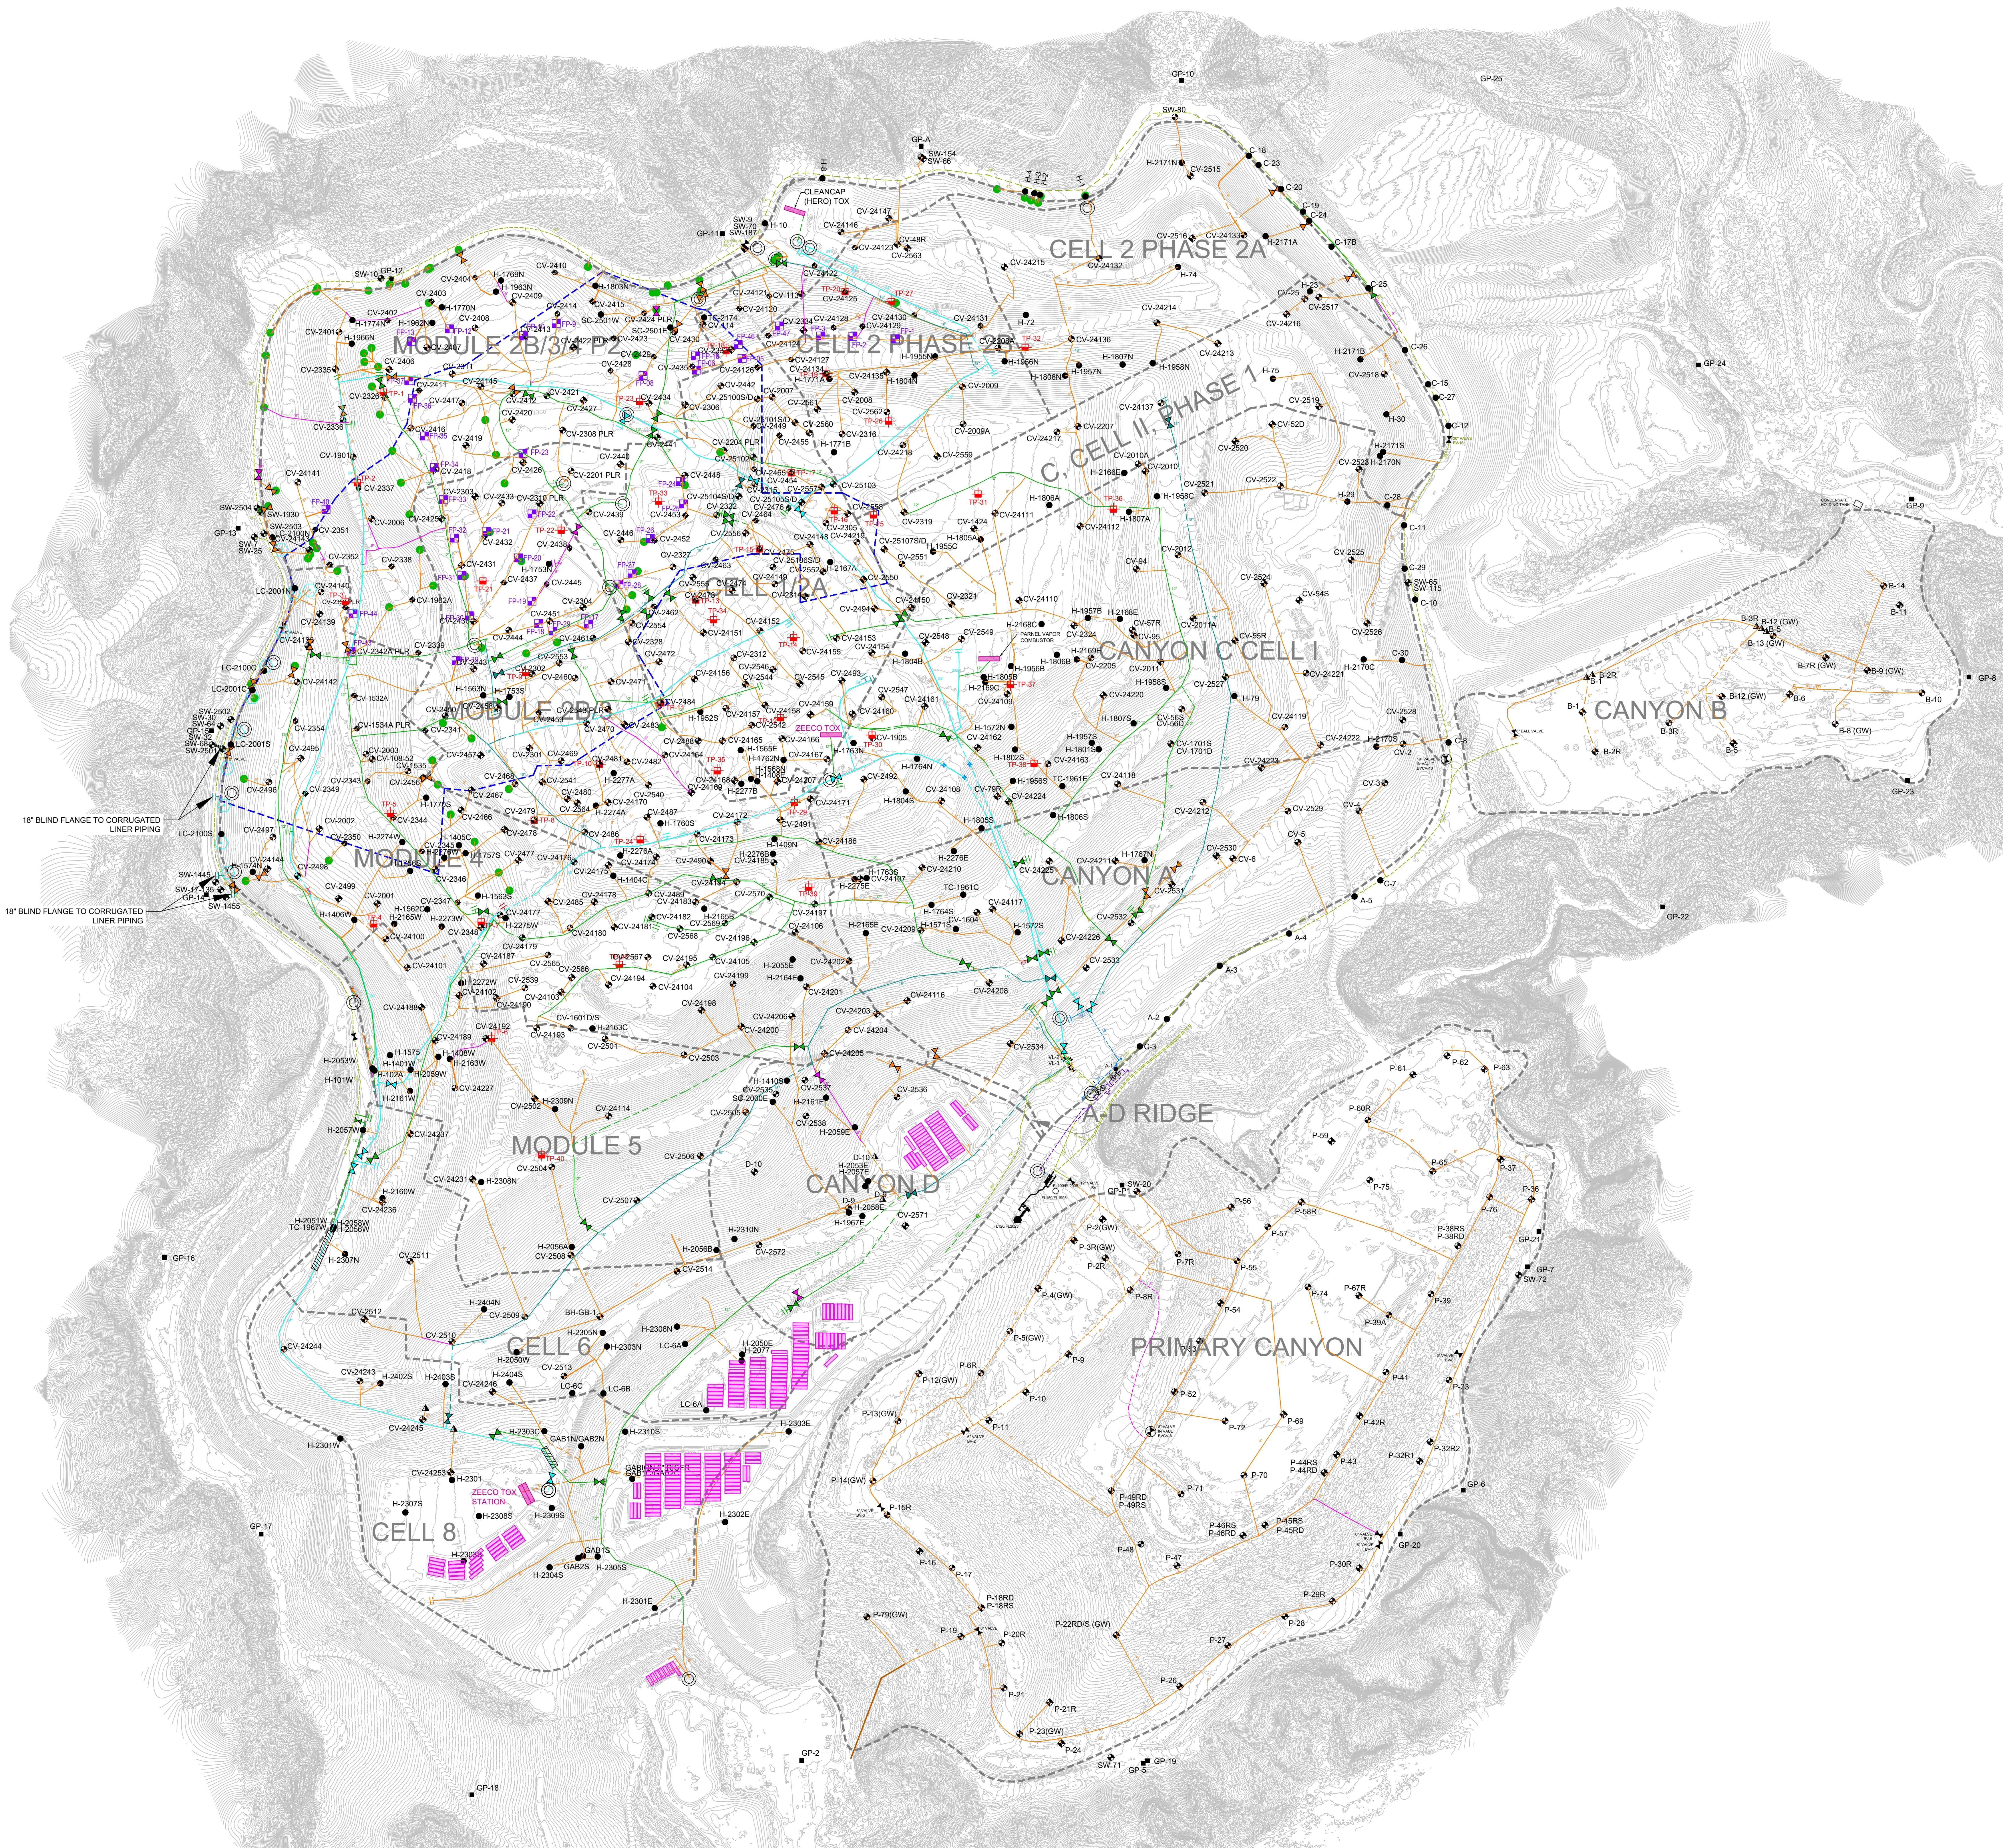

- LEGEND**
- TOPOGRAPHIC CONTOUR
  - - - - EXISTING CELL LIMITS (APPROXIMATE)
  - CV/BDF-XX EXISTING LFG VERTICAL EXTRACTION WELL - MAIN CANYON, CANYON B, CANYON D, PRIMARY CANYON
  - CV-XX EXISTING LFG VERTICAL EXTRACTION WELL - PRESSURIZED LEACHATE RELEASE
  - BH-GB EXISTING GABION LFG COLLECTOR WELL
  - SW-XX EXISTING SOIL VAPOR EXTRACTION WELL
  - FR-XX EXISTING SURFACE COLLECTOR WELLHEAD
  - HT/SC-XX EXISTING HORIZONTAL, TRENCH, SLOPE, COLLECTOR WELL
  - ▲ C-XX EXISTING REMOTE VERTICAL WELLHEAD
  - GP-XX EXISTING PERIMETER MIGRATION PROBE
  - TP-XX EXISTING TEMPERATURE PROBE
  - EXISTING ISOLATION VALVE
  - AC EXISTING ACTIVATED CARBON VESSEL
  - EXISTING CONDENSATE SUMP
  - EXISTING HDPE LINER RISER
  - EXISTING CORRUGATED LINER RISER
  - 36" EXISTING 36" LFG COLLECTION HEADER PIPING
  - 30" EXISTING 30" LFG COLLECTION HEADER PIPING
  - 24" EXISTING 24" LFG COLLECTION HEADER PIPING
  - 20" EXISTING 20" LFG COLLECTION HEADER PIPING
  - 18" EXISTING 18" LFG COLLECTION HEADER PIPING
  - 12" EXISTING 12" LFG COLLECTION HEADER PIPING
  - 10" EXISTING 10" LFG COLLECTION HEADER PIPING
  - 8" EXISTING 8" LFG COLLECTION LATERAL PIPING
  - 4" EXISTING 4" LFG COLLECTION LATERAL PIPING
  - - - - BELOW-GRADE PIPES ARE SHOWN DASHED
  - - - - REACTION AREA BOUNDARY (APPROXIMATE) - BASED ON DATA REVIEW
  - EXISTING BLIND FLANGE
  - EXISTING FRAC TANKS

- GENERAL DRAWING NOTES**
- EXISTING TOPOGRAPHIC SURVEY INFORMATION SHOWN WAS PROVIDED BY PROPELLOR. AERIAL PHOTOGRAPHY DATED MAY 06, 2026.
  - NORTH ARROW SHOWN HERE IS REFERENCE TO THE CALIFORNIA STATE PLANE ZONE V COORDINATE SYSTEM, NAD 83.
  - THE LOCATION OF ANY EXISTING PIPING, VALVES, TIE-IN LOCATIONS AND OTHER FEATURES ARE APPROXIMATE AND SHOULD BE USED FOR INFORMATION PURPOSES ONLY. ACTUAL FIELD CONDITIONS MAY VARY AND SUBJECT TO CHANGE BASED ON TOPOGRAPHIC FEATURES AND OTHER SITE-SPECIFIC FACTORS.
  - EXISTING GCCS AS-BUILT DATED JUNE 3, 2026.

DATE	
REVISION	
NO.	
EXISTING GCCS MAP	
CHIOUITA CANYON LANDFILL CASTAIC, CALIFORNIA	
CLIENT: CHIOUITA CANYON LANDFILL CASTAIC, CALIFORNIA	
DATE:	06/03/2026
SCALE:	AS SHOWN
SCS ENGINEERS ENVIRONMENTAL CONSULTANTS	
PROJECT NO.:	19071000644
DRAWN BY:	SEW
CHECK BY:	
DATE:	
SCALE:	
1 of 1	