
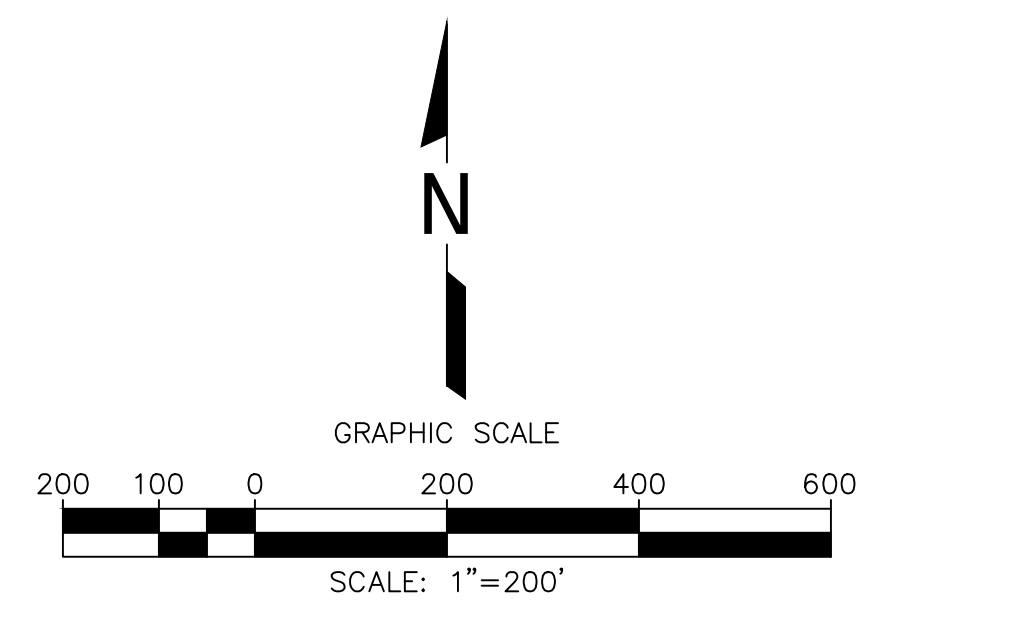


1 2 3 4 5 6 7 8 9 10 11 12 13 14 15

A
B
C
D
E
F
G
H
I
J

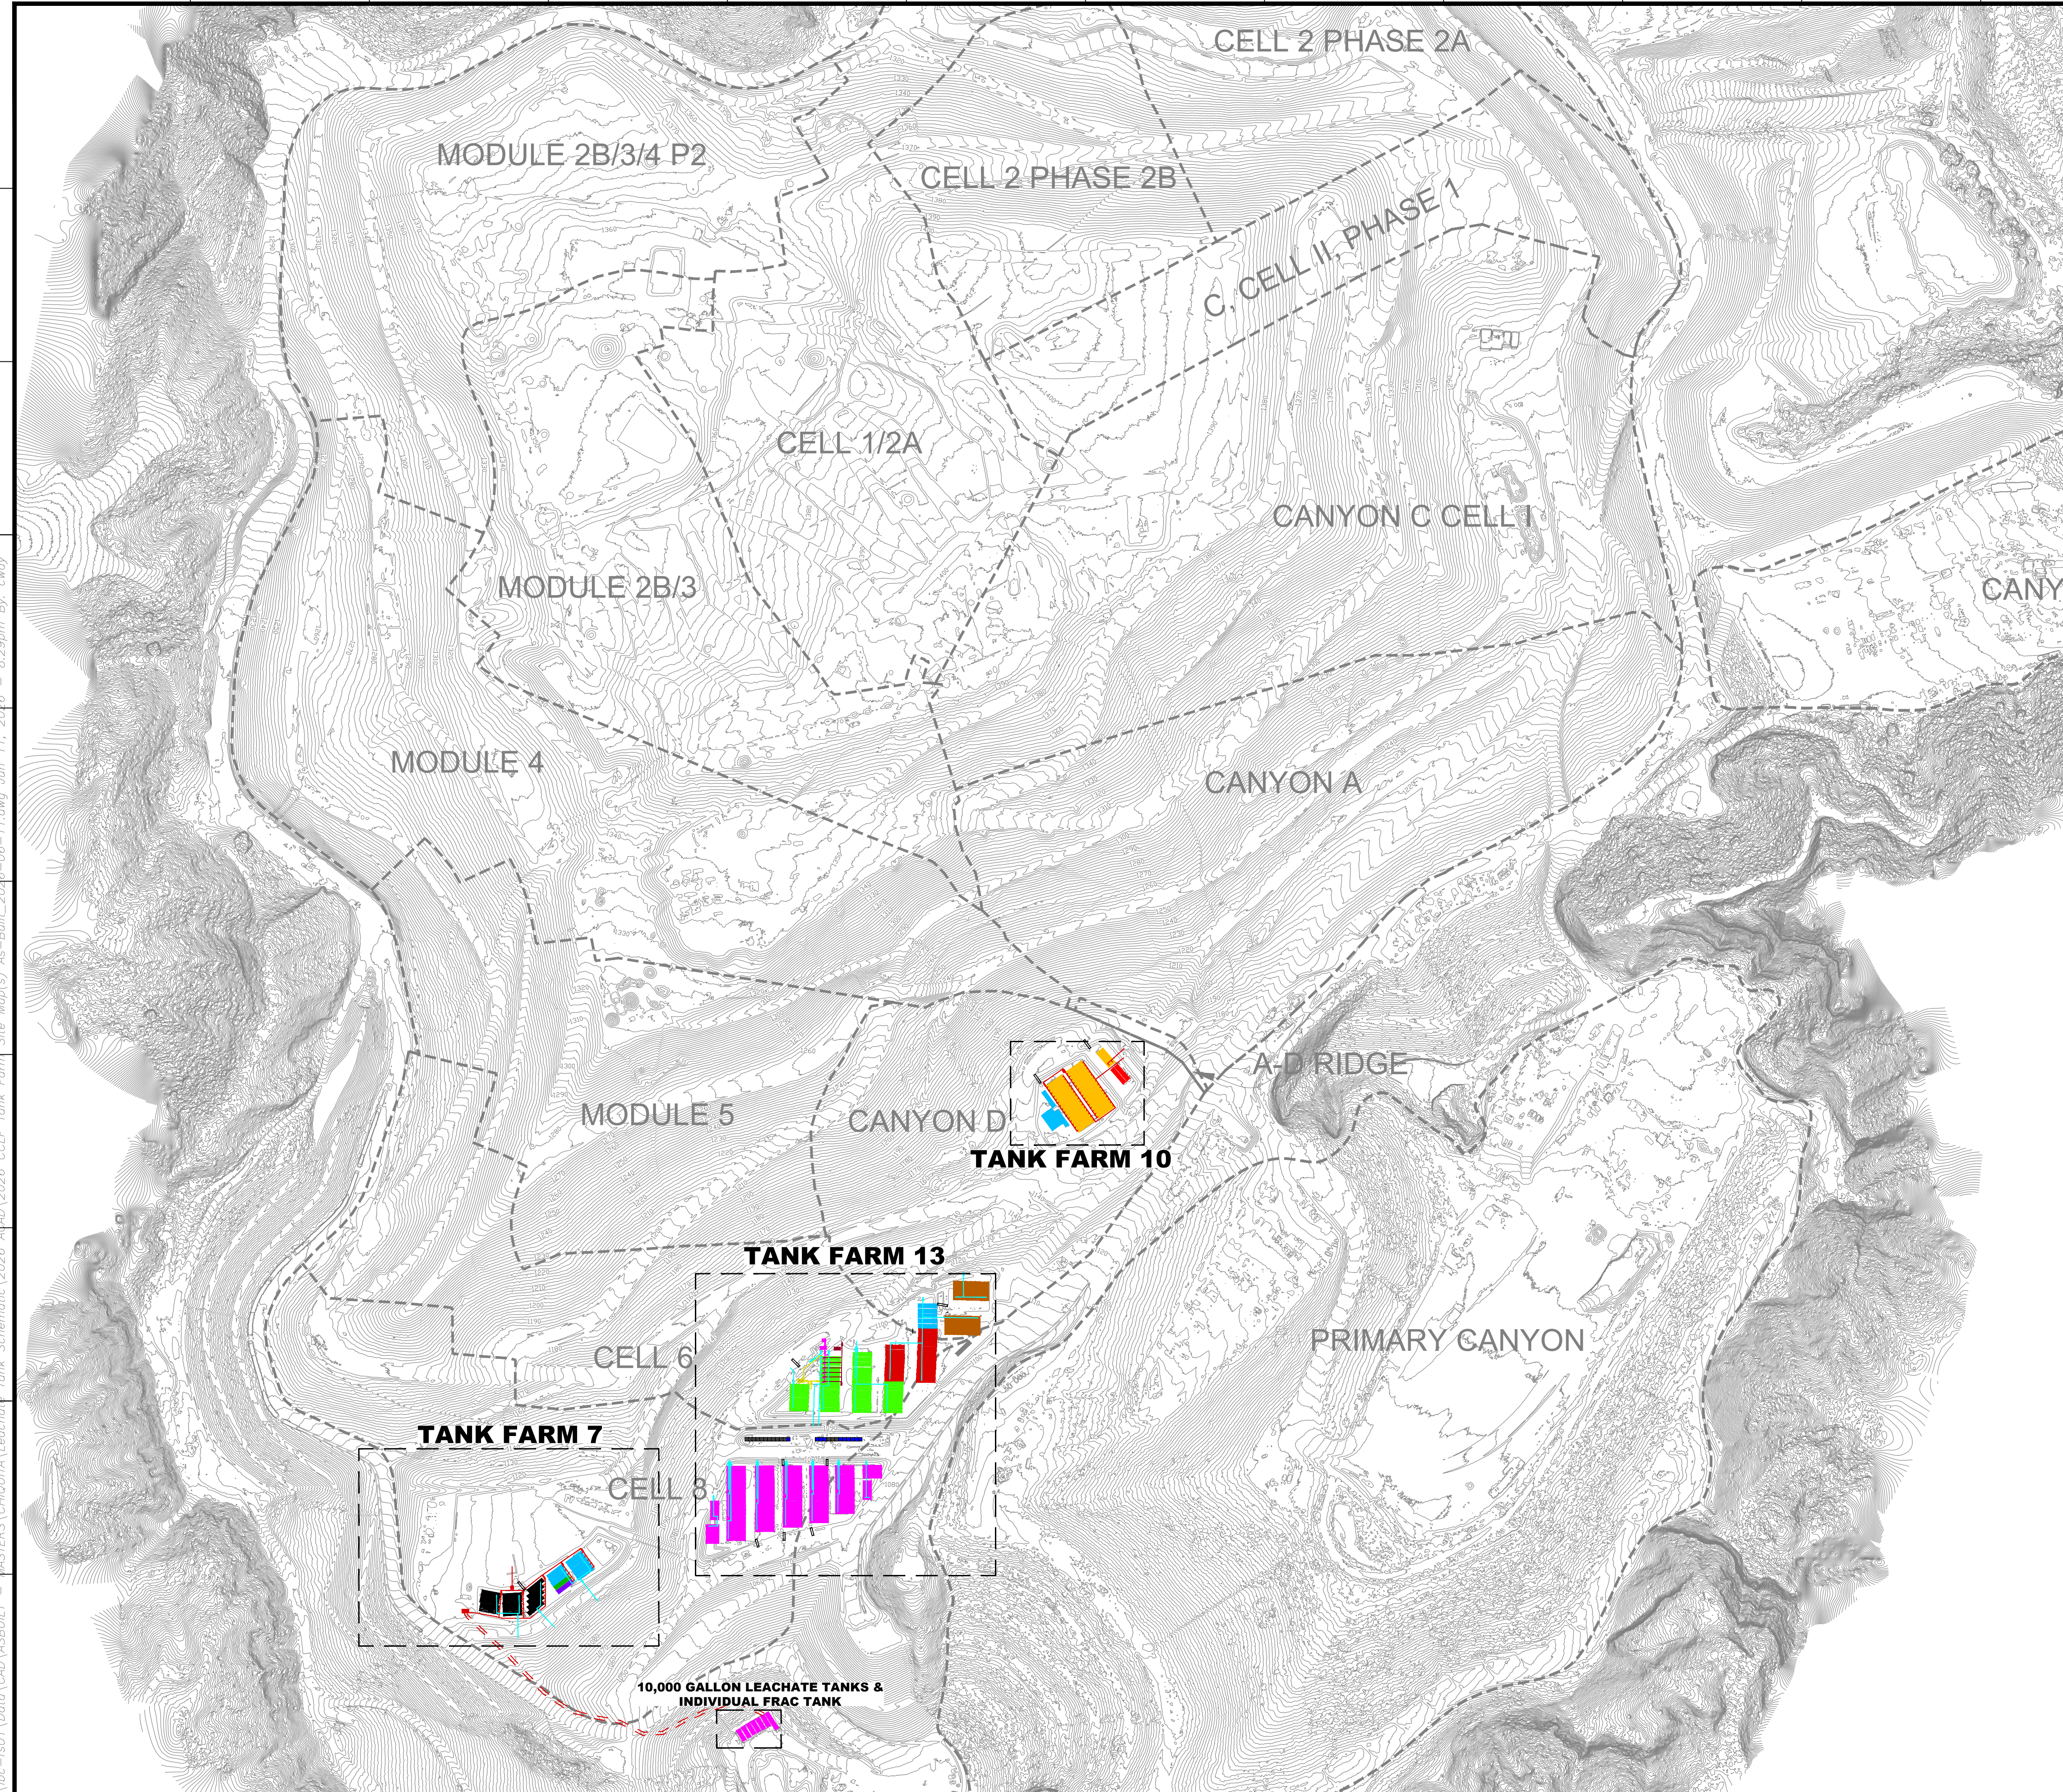

LEGEND
 - - - - - EXISTING CELL LIMITS (APPROXIMATE)
 [Color swatches] EXISTING FRAK TANK (COLOR BASED ON TANK TYPE)

\\lbc-fs01\Data\CAD\ASBUILT - MASTERS\CHIQUITA\Leachate Tank Schematic\2026 APAD\2026 CCLF Tank Farm Site Map(s)_As-Built_2026-06-11.dwg Jun 11, 2026 - 8:29pm By: cway



DATE	
REVISION	
NO.	
SHEET TITLE:	TANK FARM LOCATION MAP
PROJECT TITLE:	CHIQUITA CANYON LANDFILL CASTAIC, CALIFORNIA
CLIENT:	CHIQUITA CANYON LANDFILL CASTAIC, CALIFORNIA
DATE:	06/10/2026
SCALE:	AS SHOWN
SHEET:	1

GENERAL DRAWING NOTES:
 1. EXISTING TOPOGRAPHIC SURVEY INFORMATION SHOWN WAS PROVIDED BY PROPELLOR. AERIAL PHOTOGRAPHY DATED JUNE 2, 2026.
 2. NORTH ARROW SHOWN HERE IS REFERENCE TO THE CALIFORNIA STATE PLANE ZONE V COORDINATE SYSTEM, NAD 83.

SCS ENGINEERS
 ENVIRONMENTAL CONSULTANTS
 3940 LA BAY, APT. 301, CASTAIC, CA 91304
 LONG BEACH, CA 90808
 PH: (562) 426-5544
 PROJ. NO: 01204123.45
 DSN. BY: RR
 CHK. BY:

1 2 3 4 5 6 7 8 9 10 11 12 13 14 15

A
B
C
D
E
F
G
H
I
J

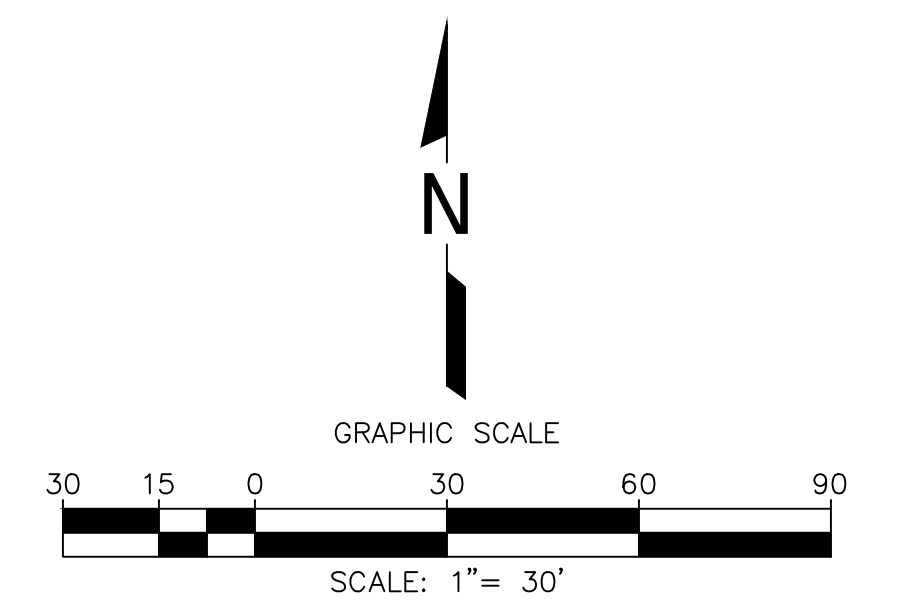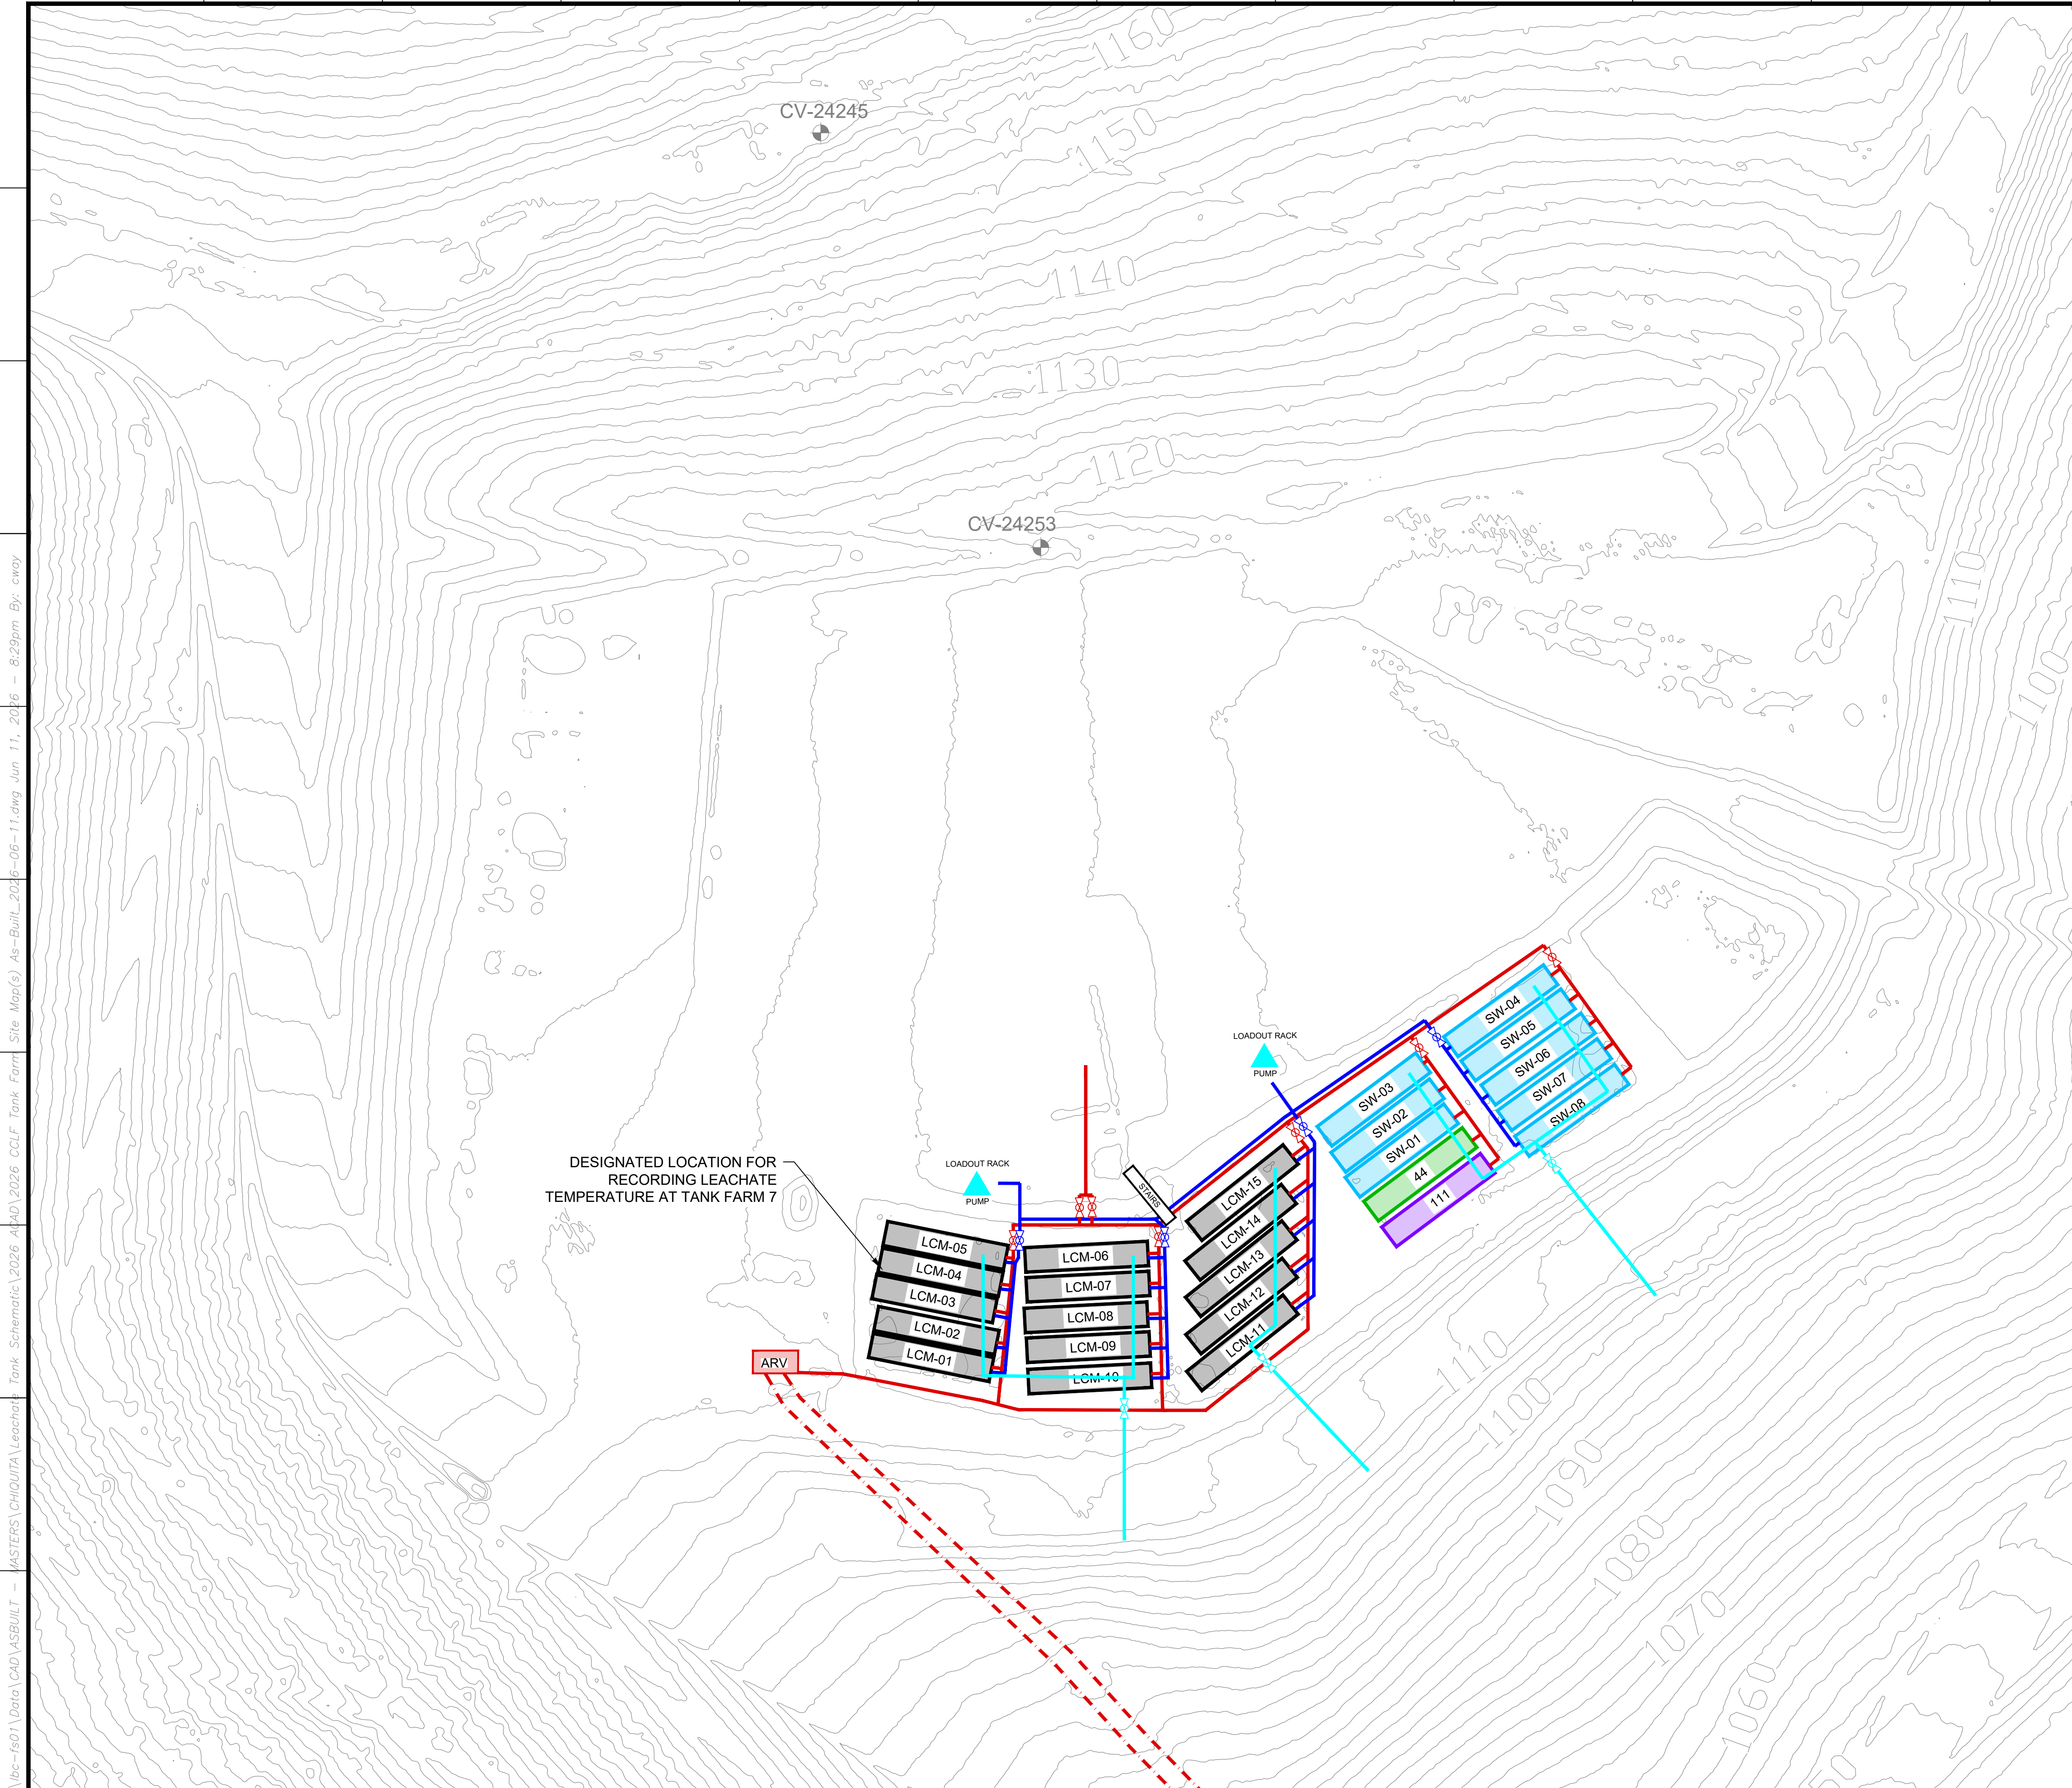

LEGEND


	TOPOGRAPHIC CONTOUR
	EXISTING FRAC TANK - CONDENSATE
	EXISTING FRAC TANK - B SUMP
	EXISTING FRAC TANK - STORM WATER
	EXISTING FRAC TANK - LCM
	EXISTING VACUUM PIPE
	EXISTING INLET FORCEMAIN PIPE
	EXISTING FORCEMAIN LINE
	EXISTING LOADOUT PULL PIPE
	EXISTING PUMP / TRUCK LOADOUT

DESIGNATED LOCATION FOR RECORDING LEACHATE TEMPERATURE AT TANK FARM 7

\\lbc-fs01\Data\CAD\ASBUILT - MASTERS\CHIQUITA Leachate Tank Schematic\2026 APAD\2026 CCLF Tank Farm Site Map(s)_As-Built_2026-06-11.dwg Jun 11, 2026 - 8:29pm By: cway

NO.	REVISION	DATE

SHEET TITLE: TANK FARM 7
PROJECT TITLE: CHIQUITA CANYON LANDFILL
CASTAIC, CALIFORNIA

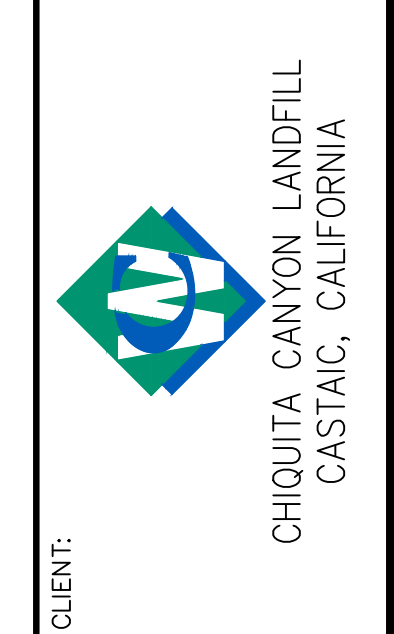

CLIENT: CHIQUITA CANYON LANDFILL
CASTAIC, CALIFORNIA

DATE: 06/10/2026
SCALE: AS SHOWN
SHEET: 2

GENERAL DRAWING NOTES:



- EXISTING TOPOGRAPHIC SURVEY INFORMATION SHOWN WAS PROVIDED BY PROPELLOR. AERIAL PHOTOGRAPHY DATED JUNE 2, 2026.
- NORTH ARROW SHOWN HERE IS REFERENCE TO THE CALIFORNIA STATE PLANE ZONE V COORDINATE SYSTEM, NAD 83.

SCS ENGINEERS
ENVIRONMENTAL CONSULTANTS
3940 ALBO, WILSON AVENUE, SUITE 300
LONG BEACH, CA 90808
PH: (562) 426-9544

PROJ. NO: 01204123-45
DWN. BY: SRM / CNW
CHK. BY: FJ/ENGINEERS

1 2 3 4 5 6 7 8 9 10 11 12 13 14 15

A
B
C
D
E
F
G
H
I
J

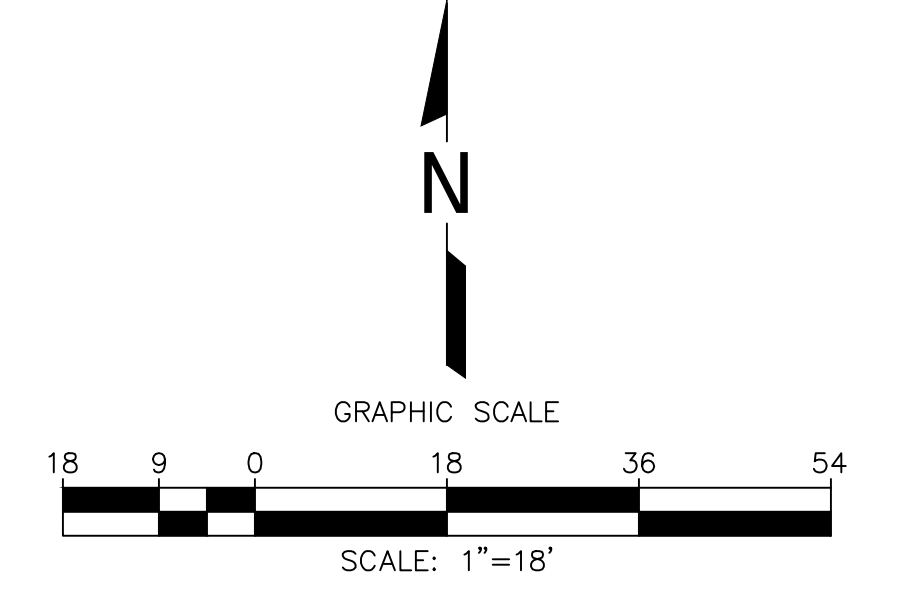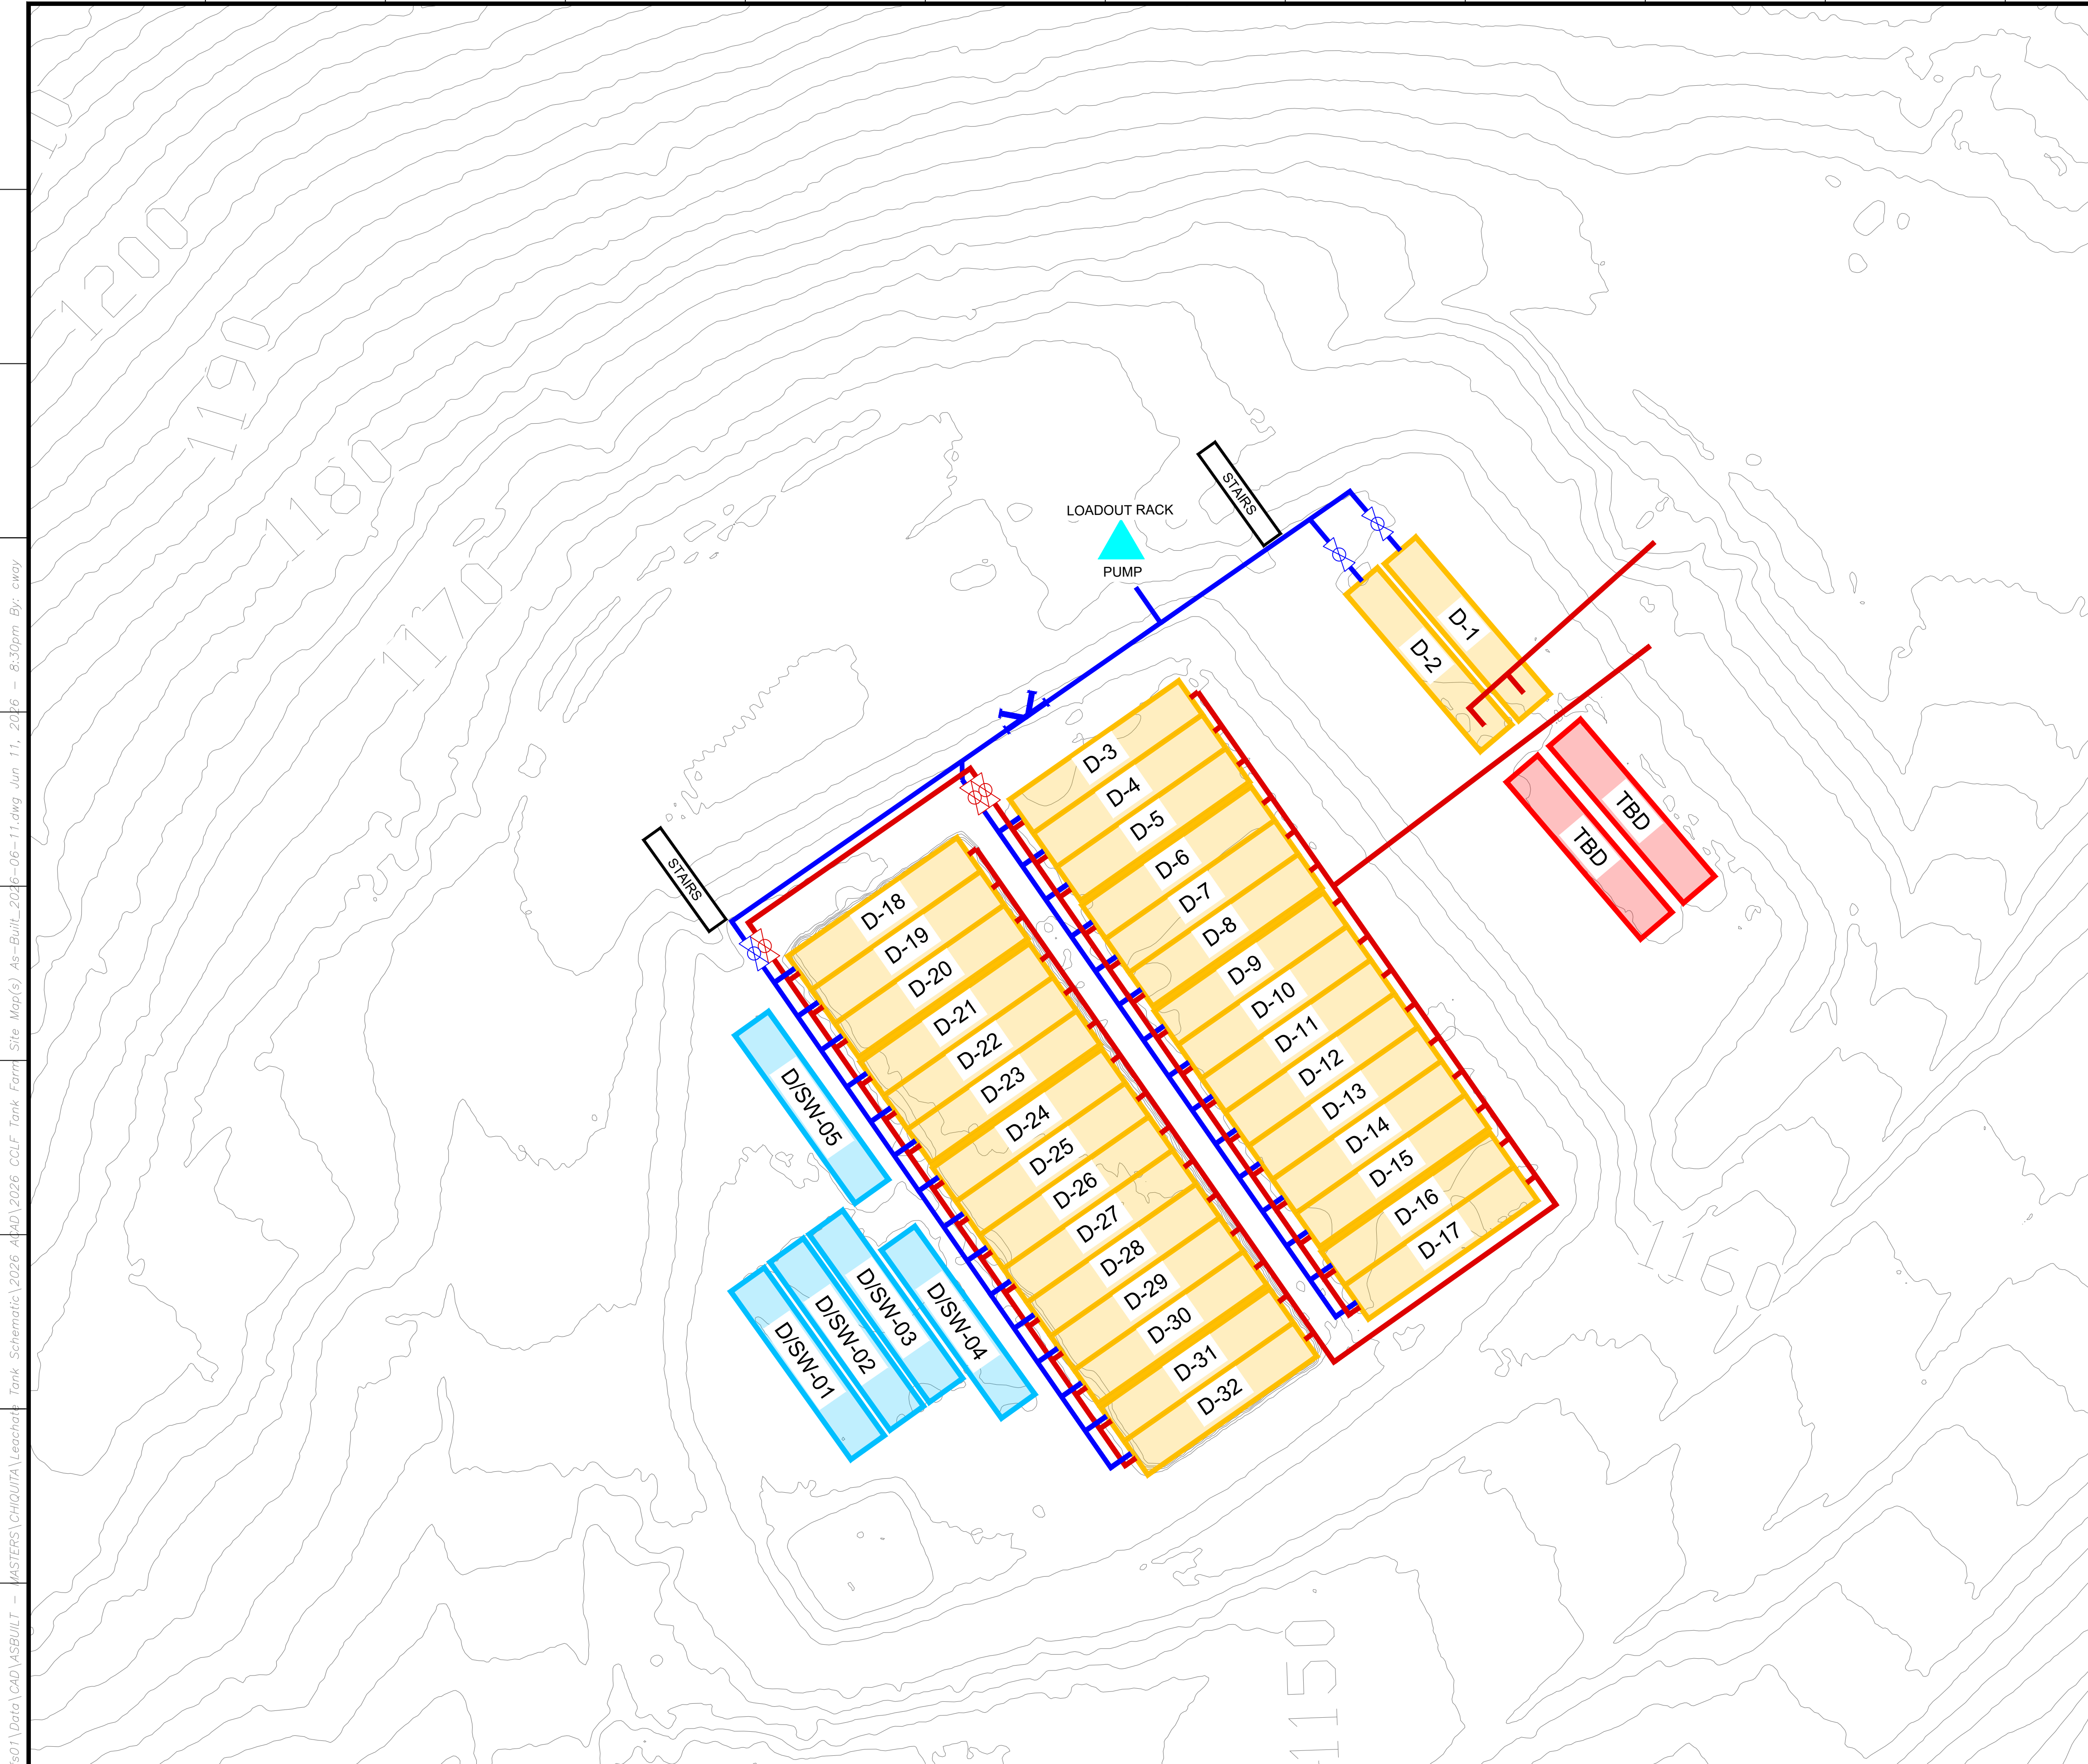

LEGEND

	TOPOGRAPHIC CONTOUR
	EXISTING FRAC TANK - IN SERVICE
	EXISTING FRAC TANK - NOT IN SERVICE
	EXISTING FRAC TANK - STORM WATER
	EXISTING INLET FORCEMAIN PIPE
	EXISTING LOADOUT PULL PIPE
	EXISTING PUMP / TRUCK LOADOUT
	EXISTING CLEANOUT

\\lbc-fs01\Data\CAD\ASBUILT - MASTERS\CHIQUITA\Leachart Tank Schematic\2026 APAD\2026 CCLF Tank Farm Site Map(s)_As-Built_2026-06-11.dwg Jun 11, 2026 - 8:30pm By: cway

NO.	REVISION	DATE

SHEET TITLE: TANK FARM 10
 PROJECT TITLE: CHIQUITA CANYON LANDFILL
 CASTAIC, CALIFORNIA





SCS ENGINEERS
 ENVIRONMENTAL CONSULTANTS
 200 N. GARDEN, SUITE 300
 LONG BEACH, CA 90808
 PH: (562) 426-9544
 PROJ. NO: 01204123.41
 DSN. BY: SRM / CNW
 CHK. BY: FJ/ENGINEERS
 APP. BY:

DATE: 06/10/2026
 SCALE: AS SHOWN
 SHEET: 3

GENERAL DRAWING NOTES:
 1. EXISTING TOPOGRAPHIC SURVEY INFORMATION SHOWN WAS PROVIDED BY PROPELLOR. AERIAL PHOTOGRAPHY DATED JUNE 2, 2026.
 2. NORTH ARROW SHOWN HERE IS REFERENCE TO THE CALIFORNIA STATE PLANE ZONE V COORDINATE SYSTEM, NAD 83.


1 2 3 4 5 6 7 8 9 10 11 12 13 14 15

A
B
C
D
E
F
G
H
I
J

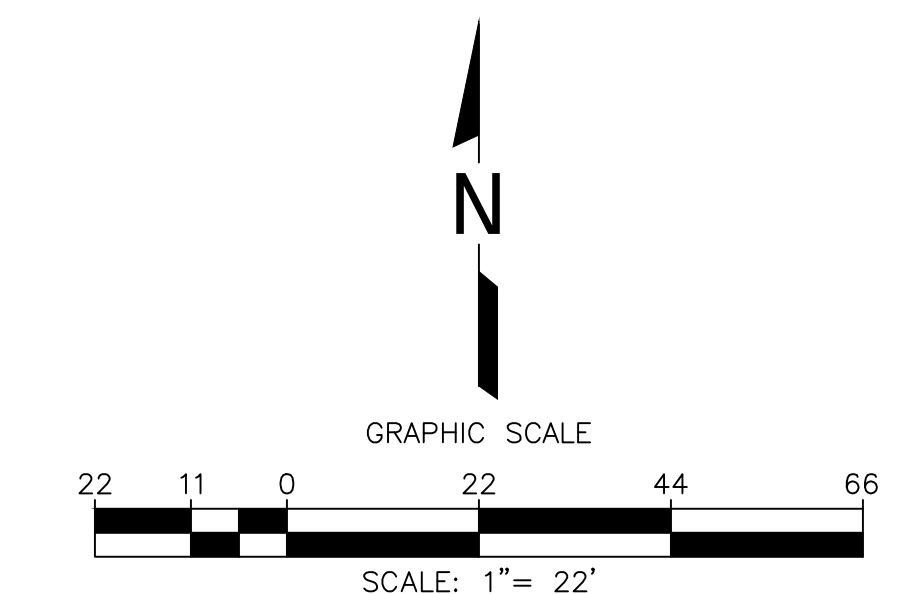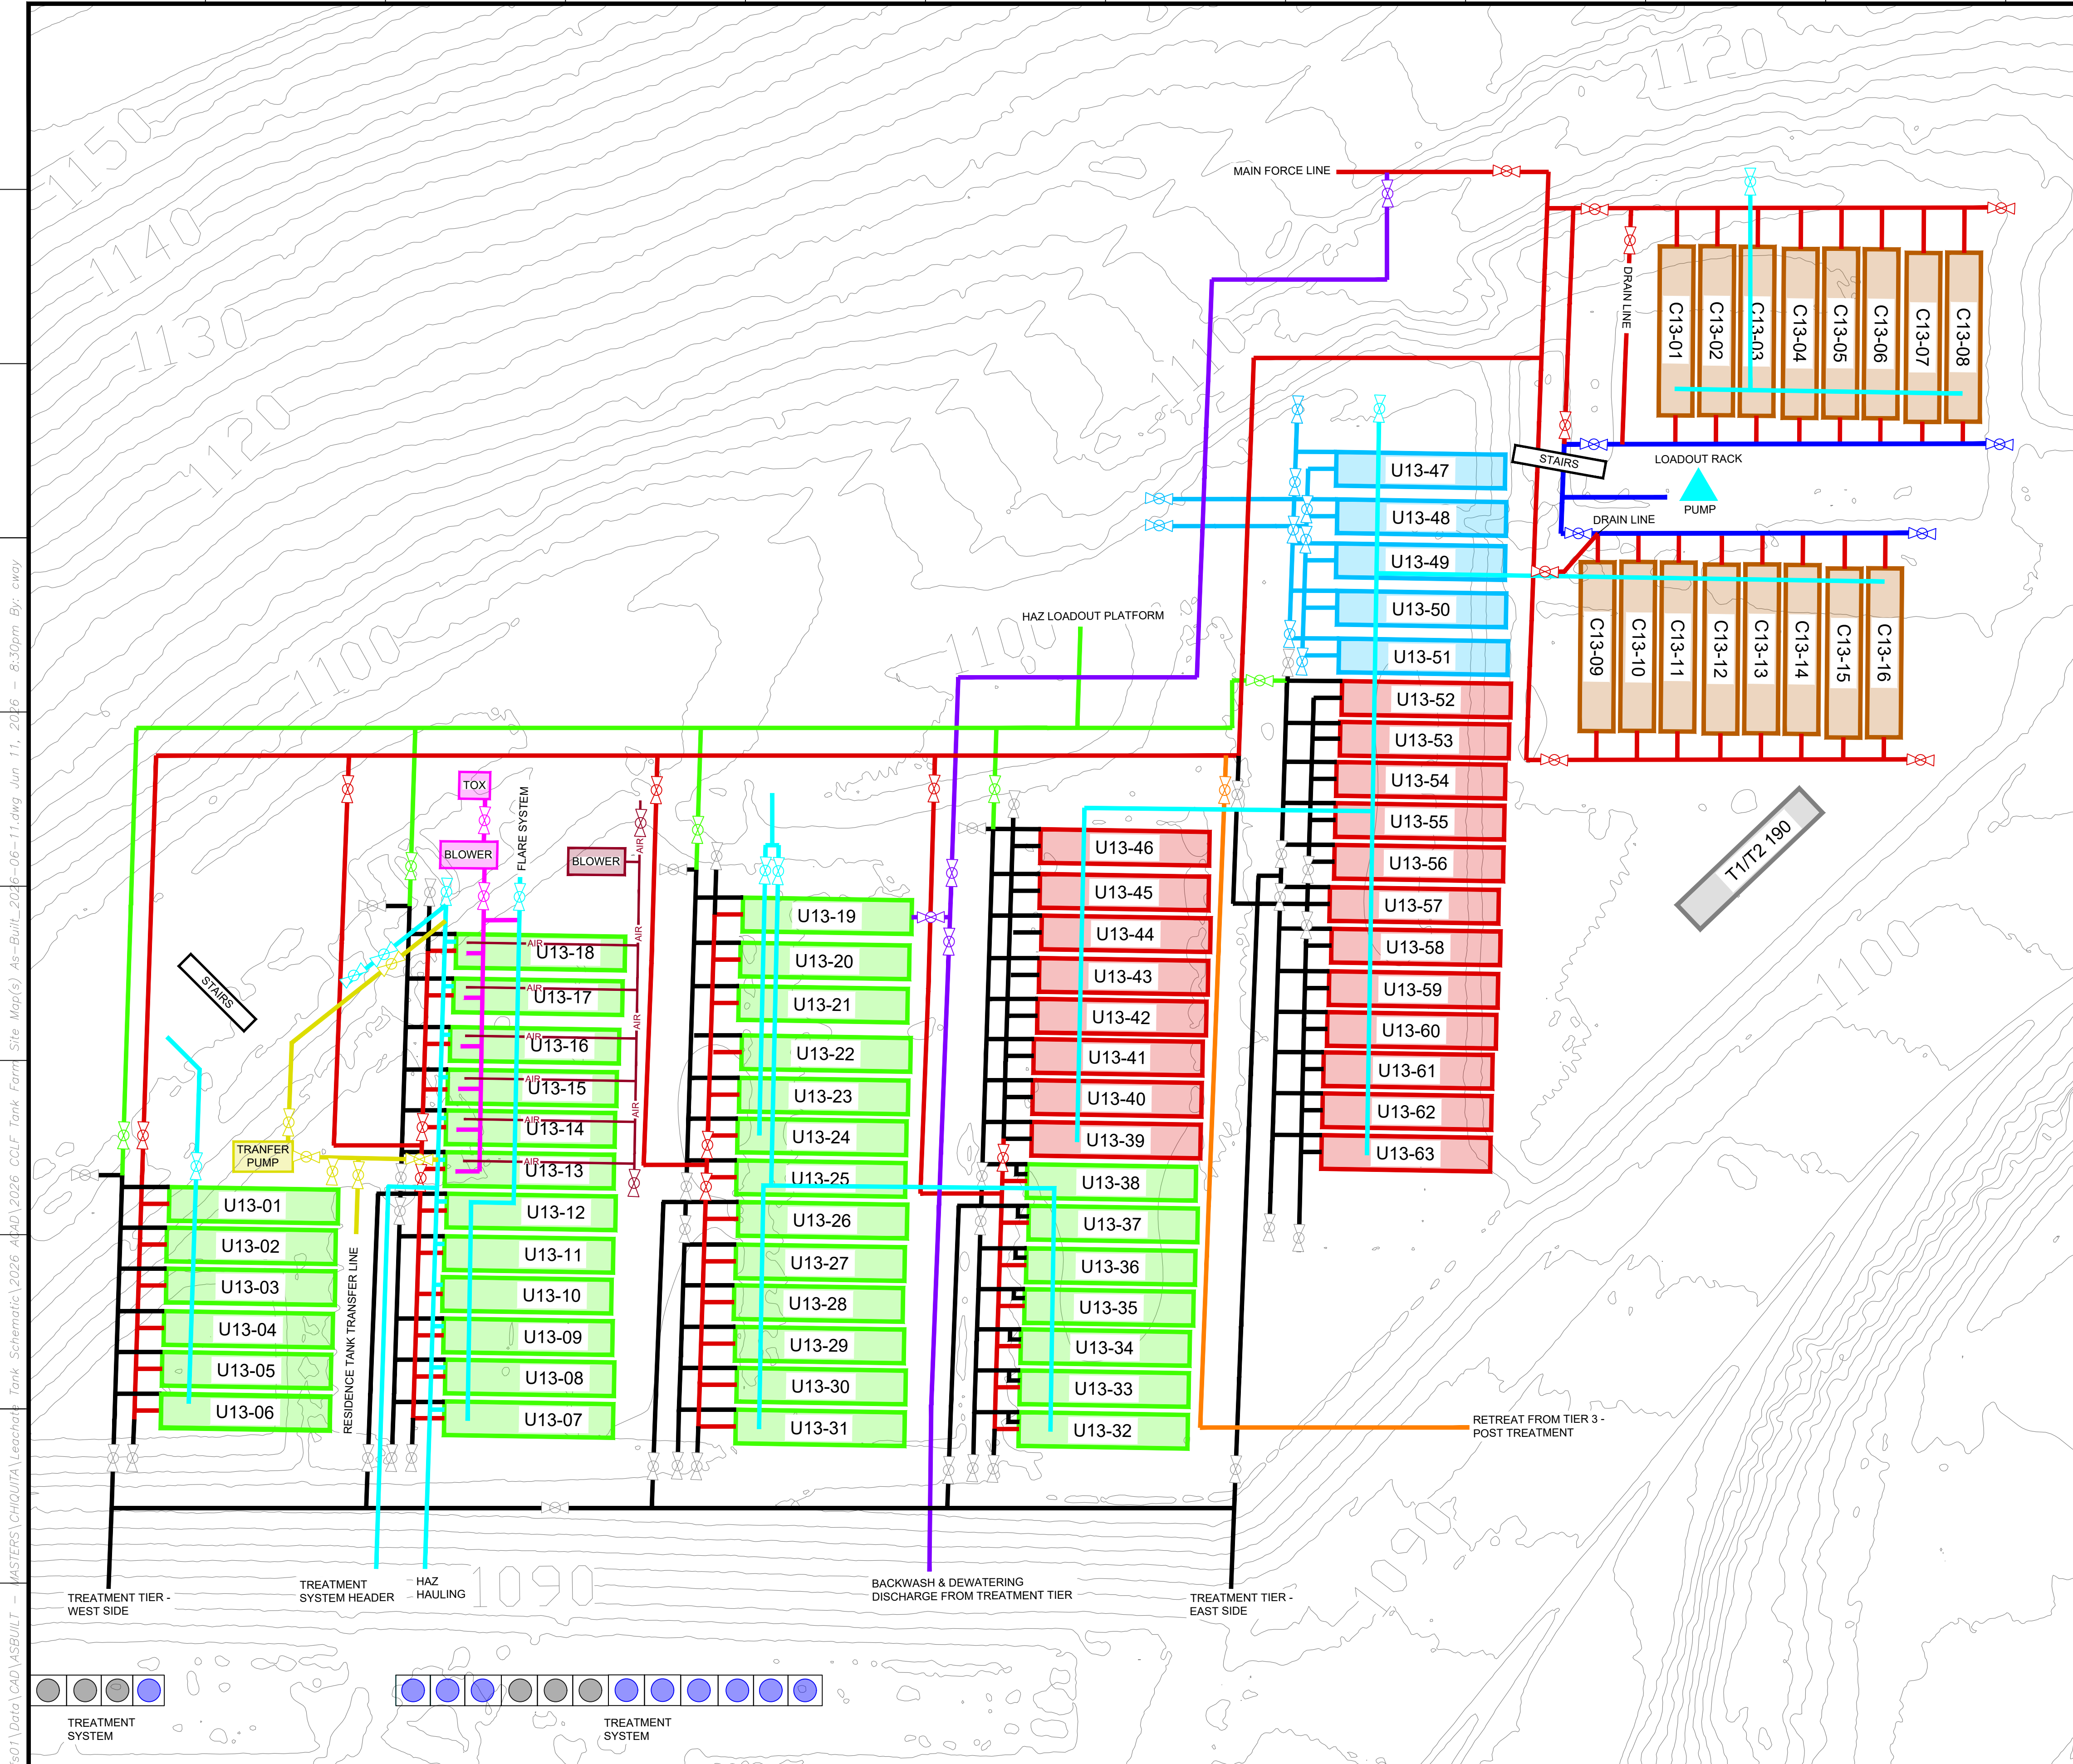

LEGEND

1150	TOPOGRAPHIC CONTOUR
4"	EXISTING HAZ LOADOUT PIPE
4"	EXISTING TREATMENT PIPE
4"	EXISTING RETREAT PIPE
8"	EXISTING INLET FORCEMAIN PIPE
4"	EXISTING BACKWASH & DEWATERING PIPE
4"	EXISTING SLUDGE TANKS FILL/PULL PIPE
4"	EXISTING VACUUM PIPE
3" / 6" AIR	EXISTING BLOWER PIPE
4"	EXISTING RECIRC PIPE
4"	EXISTING DRAIN PIPE
4"	EXISTING LOADOUT PULL PIPE
Symbol	EXISTING POLYVALVE (COLOR BASED ON PIPE TYPE)
Symbol	EXISTING PUMP / TRUCK LOADOUT
Symbol	EXISTING FRAC TANK - CLARIFIER
Symbol	EXISTING FRAC TANK - INFLUENT
Symbol	EXISTING FRAC TANK - RESERVE INFLUENT
Symbol	EXISTING FRAC TANK - SLUDGE
Symbol	EXISTING FRAC TANK - H2S CONDENSATE

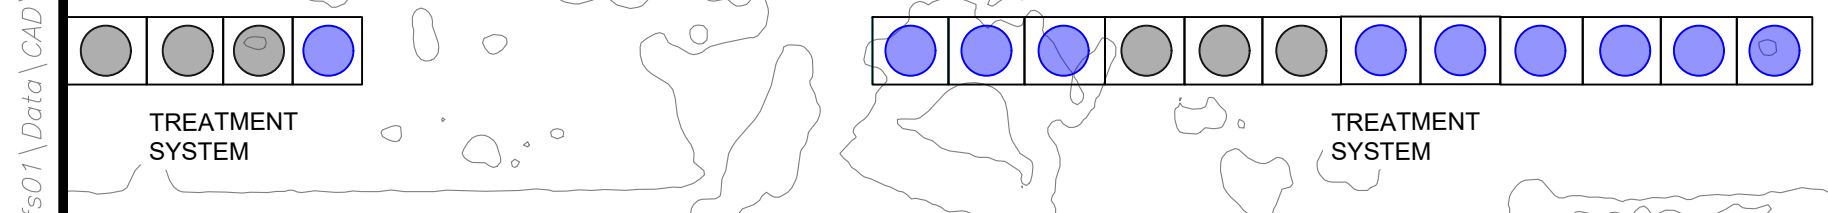

NO.	REVISION	DATE

SHEET TITLE: TANK FARM 13 PRE-TREATMENT
PROJECT TITLE: CHIQUITA CANYON LANDFILL CASTAIC, CALIFORNIA

CLIENT: CHIQUITA CANYON LANDFILL CASTAIC, CALIFORNIA

SCS ENGINEERS
ENVIRONMENTAL CONSULTANTS
3200 ALAMO, SUITE 300
LONG BEACH, CA 90808
PH: (562) 426-9544
FAX: (562) 426-9544
PROJ. NO: 01204123-45
DWN. BY: RR / CNW
CHK. BY: FJ/ENGINEERS

DATE: 06/09/2026
SCALE: AS SHOWN
SHEET: 4

GENERAL DRAWING NOTES:
1. EXISTING TOPOGRAPHIC SURVEY INFORMATION SHOWN WAS PROVIDED BY PROPELLOR. AERIAL PHOTOGRAPHY DATED JUNE 2, 2026.
2. NORTH ARROW SHOWN HERE IS REFERENCE TO THE CALIFORNIA STATE PLANE ZONE V COORDINATE SYSTEM, NAD 83.

\\bc-fs01\Data\CAD\ASBUILT - MASTERS\CHIQUITA Leachate Tank Schematic\2026 APAD\2026 CCLF Tank Farm Site Map(s)_As-Built_2026-06-11.dwg Jun 11, 2026 8:50pm By: cwy

