

Archived: Friday, July 24, 2026 10:57:42 AM
From: [Sarah Phillips](#)
Sent: Mon, 20 Jul 2026 23:13:41
To: [Zmily, ZanaLee@DTSC](#)
Cc: [McGuire, Christopher@DTSC](#)
Subject: CCL: Updated Tank Farm and Wellfield Maps
Importance: Normal
Sensitivity: None
Attachments: [image.png](#) [image.png](#) [2026-07-14_CCLF_MASTER LMS Map.pdf](#) [2026 CCLF Tank Farm Site Map\(s\)](#)
[As-Built_2026-06-11_v0.1.pdf](#)

All,

On behalf of Chiquita Canyon, LLC, attached please find the most up to date tank farm and wellfield maps, which are being submitted pursuant to DTSC’s June 20, 2025 compliance requirement letter and consistent with Chiquita’s July 25, 2025 response. Please let us know if you have questions.

 
Regards,
Sarah



Sarah Phillips

248.930.2779

Corporate Compliance Manager

Waste Connections



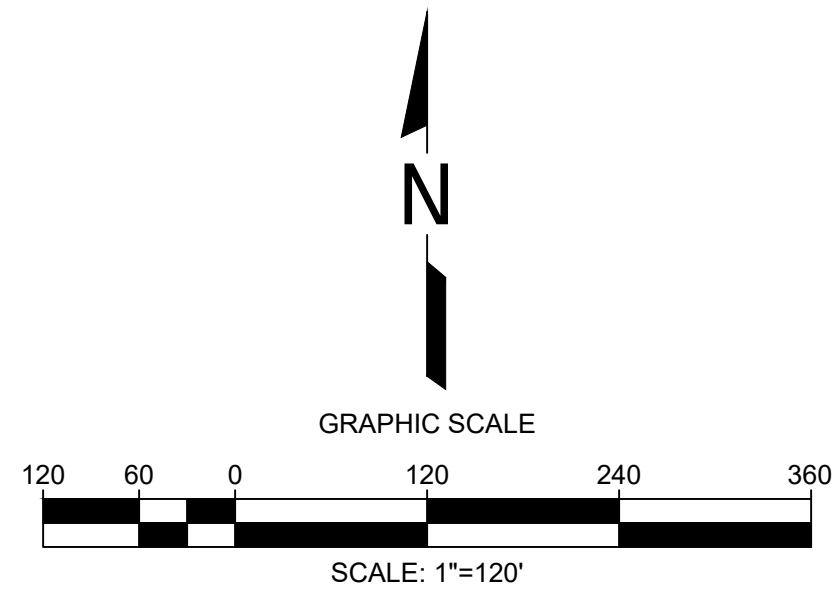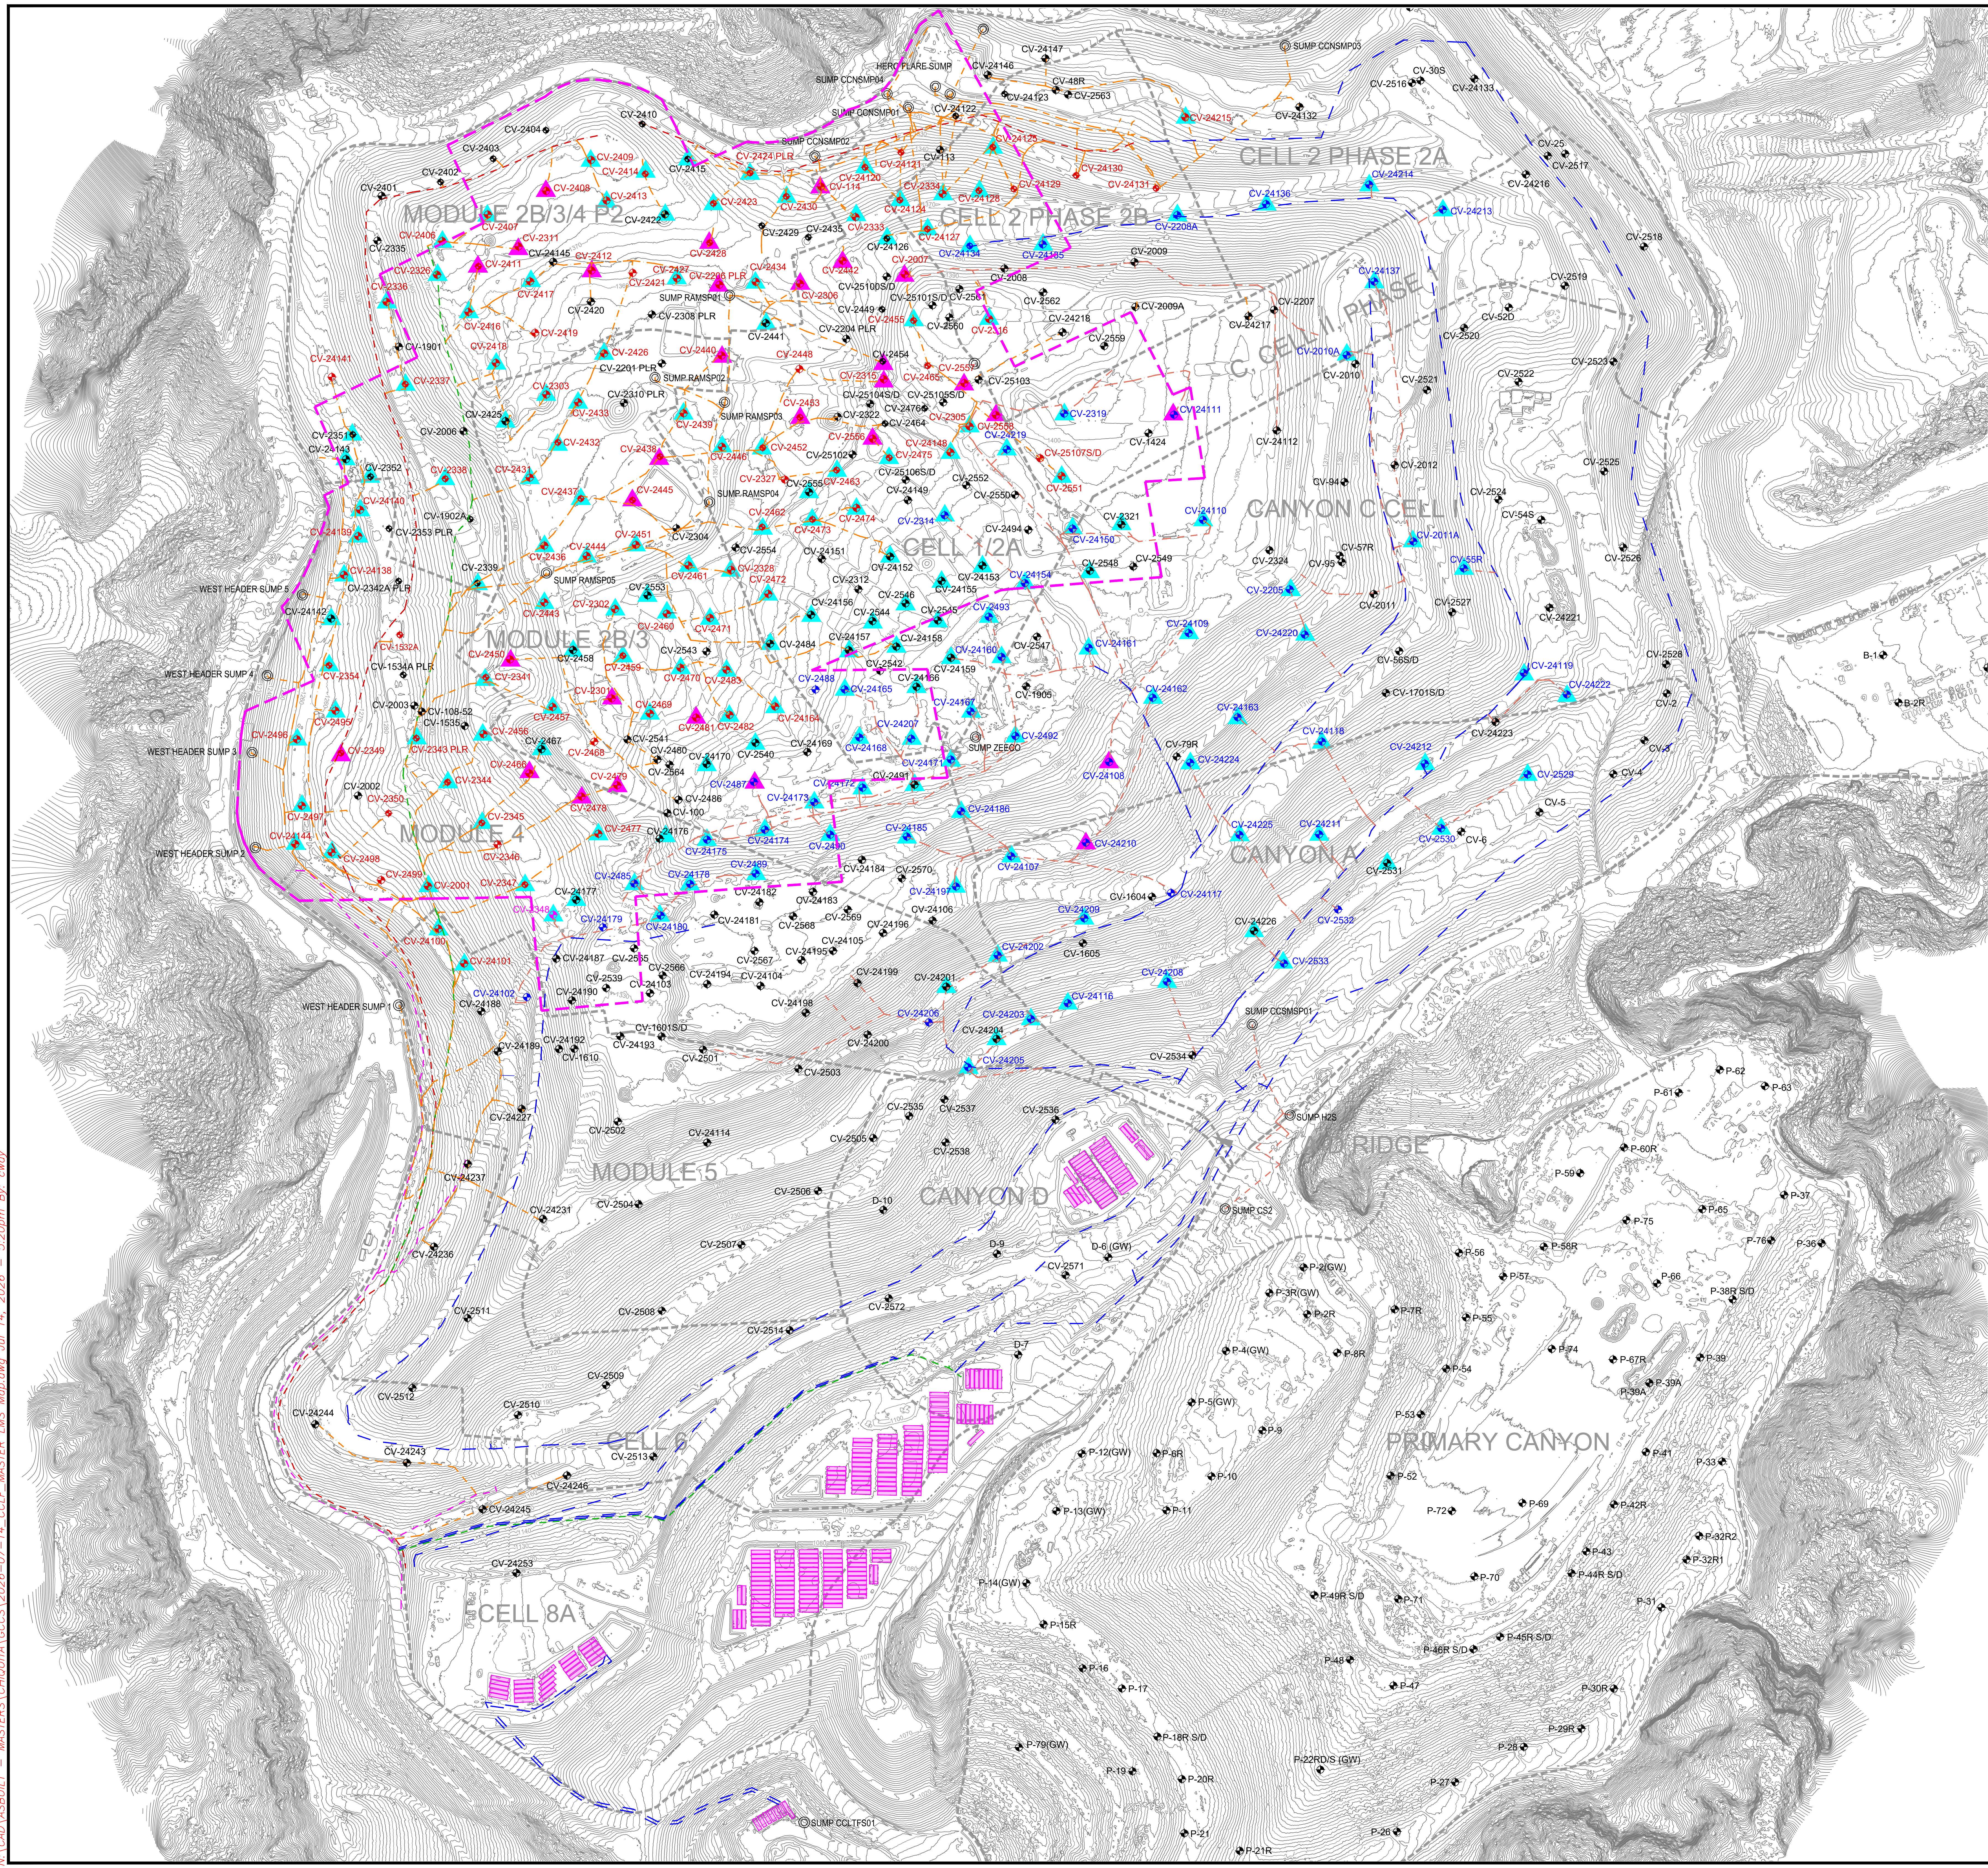



LEGEND	
	EXISTING TOPOGRAPHIC CONTOUR
	REACTION MITIGATION AREA BOUNDARY
	EXISTING CELL LIMITS (APPROXIMATE)
	EXISTING 8" (A) FORCEMAIN
	EXISTING 6" (A) FORCEMAIN
	EXISTING 4" (A) FORCEMAIN
	EXISTING 6" (B) FORCEMAIN
	EXISTING 6" (C) FORCEMAIN
	EXISTING 4" (C) FORCEMAIN
	EXISTING FRAC TANK
	EXISTING DE-WATERING WELL - PUMP INSTALLED AND RUNNING
	EXISTING DE-WATERING WELL - PUMP INSTALLED, NOT RUNNING
	EXISTING VERTICAL EXTRACTION WELL - PRESSURIZED LEACHATE RELEASE
	EXISTING VERTICAL LFG EXTRACTION WELL (PER LOCATION)
	EXISTING CONDENSATE SUMP
	GROUP A SAMPLE PORT
	GROUP B SAMPLE PORT
	GROUP C SAMPLE PORT


[illegible]


GENERAL DRAWING NOTES:


1. EXISTING TOPOGRAPHIC SURVEY INFORMATION SHOWN WAS PROVIDED BY PROPELLER AERIAL PHOTOGRAPHY, DATED JULY 08, 2026.
2. EXISTING GCCS AS-BUILT LOCATIONS ARE DATED JUNE 24, 2026.
3. NORTH ARROW SHOWN HERE IS REFERENCE TO THE CALIFORNIA STATE PLANE ZONE V COORDINATE SYSTEM, NAD 83.
4. THE LOCATION OF ANY EXISTING PIPING, VALVES, TIE-IN LOCATIONS AND OTHER FEATURES ARE APPROXIMATE AND SHOULD BE USED FOR INFORMATION PURPOSES ONLY. ACTUAL FIELD CONDITIONS MAY VARY AND SUBJECT TO CHANGE BASED ON TOPOGRAPHIC FEATURES, AND OTHER SITE-SPECIFIC FACTORS.

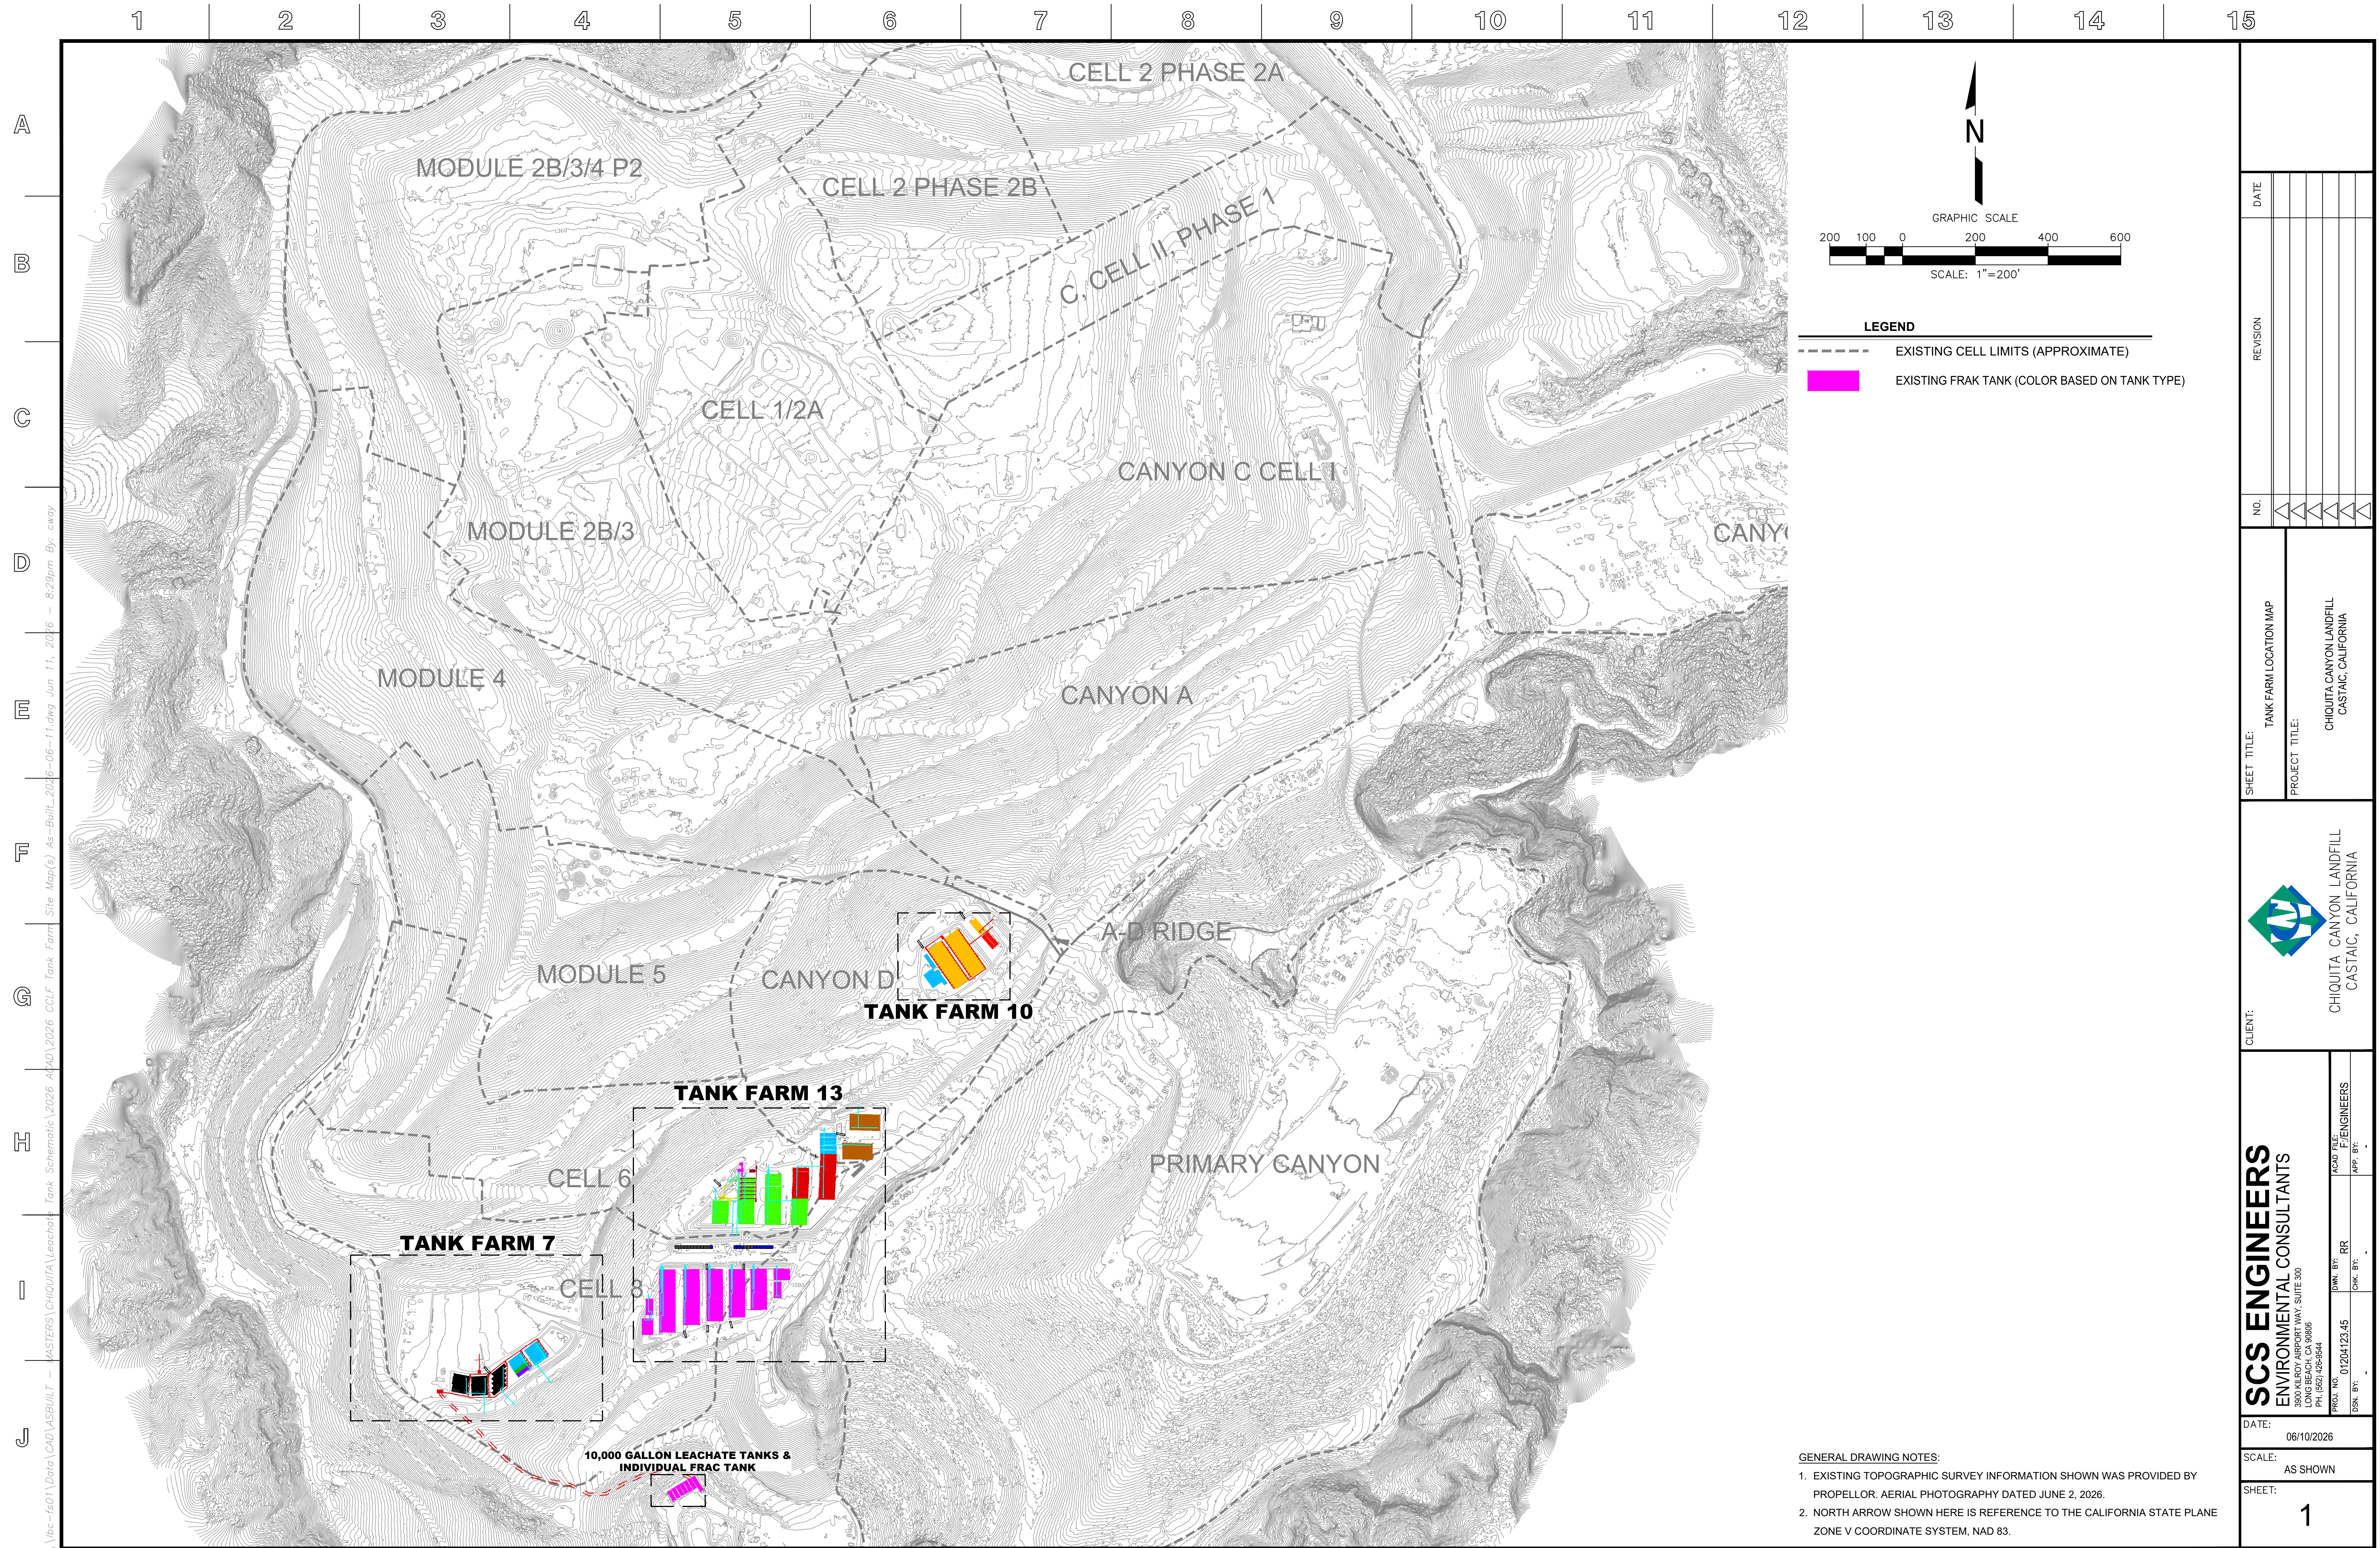

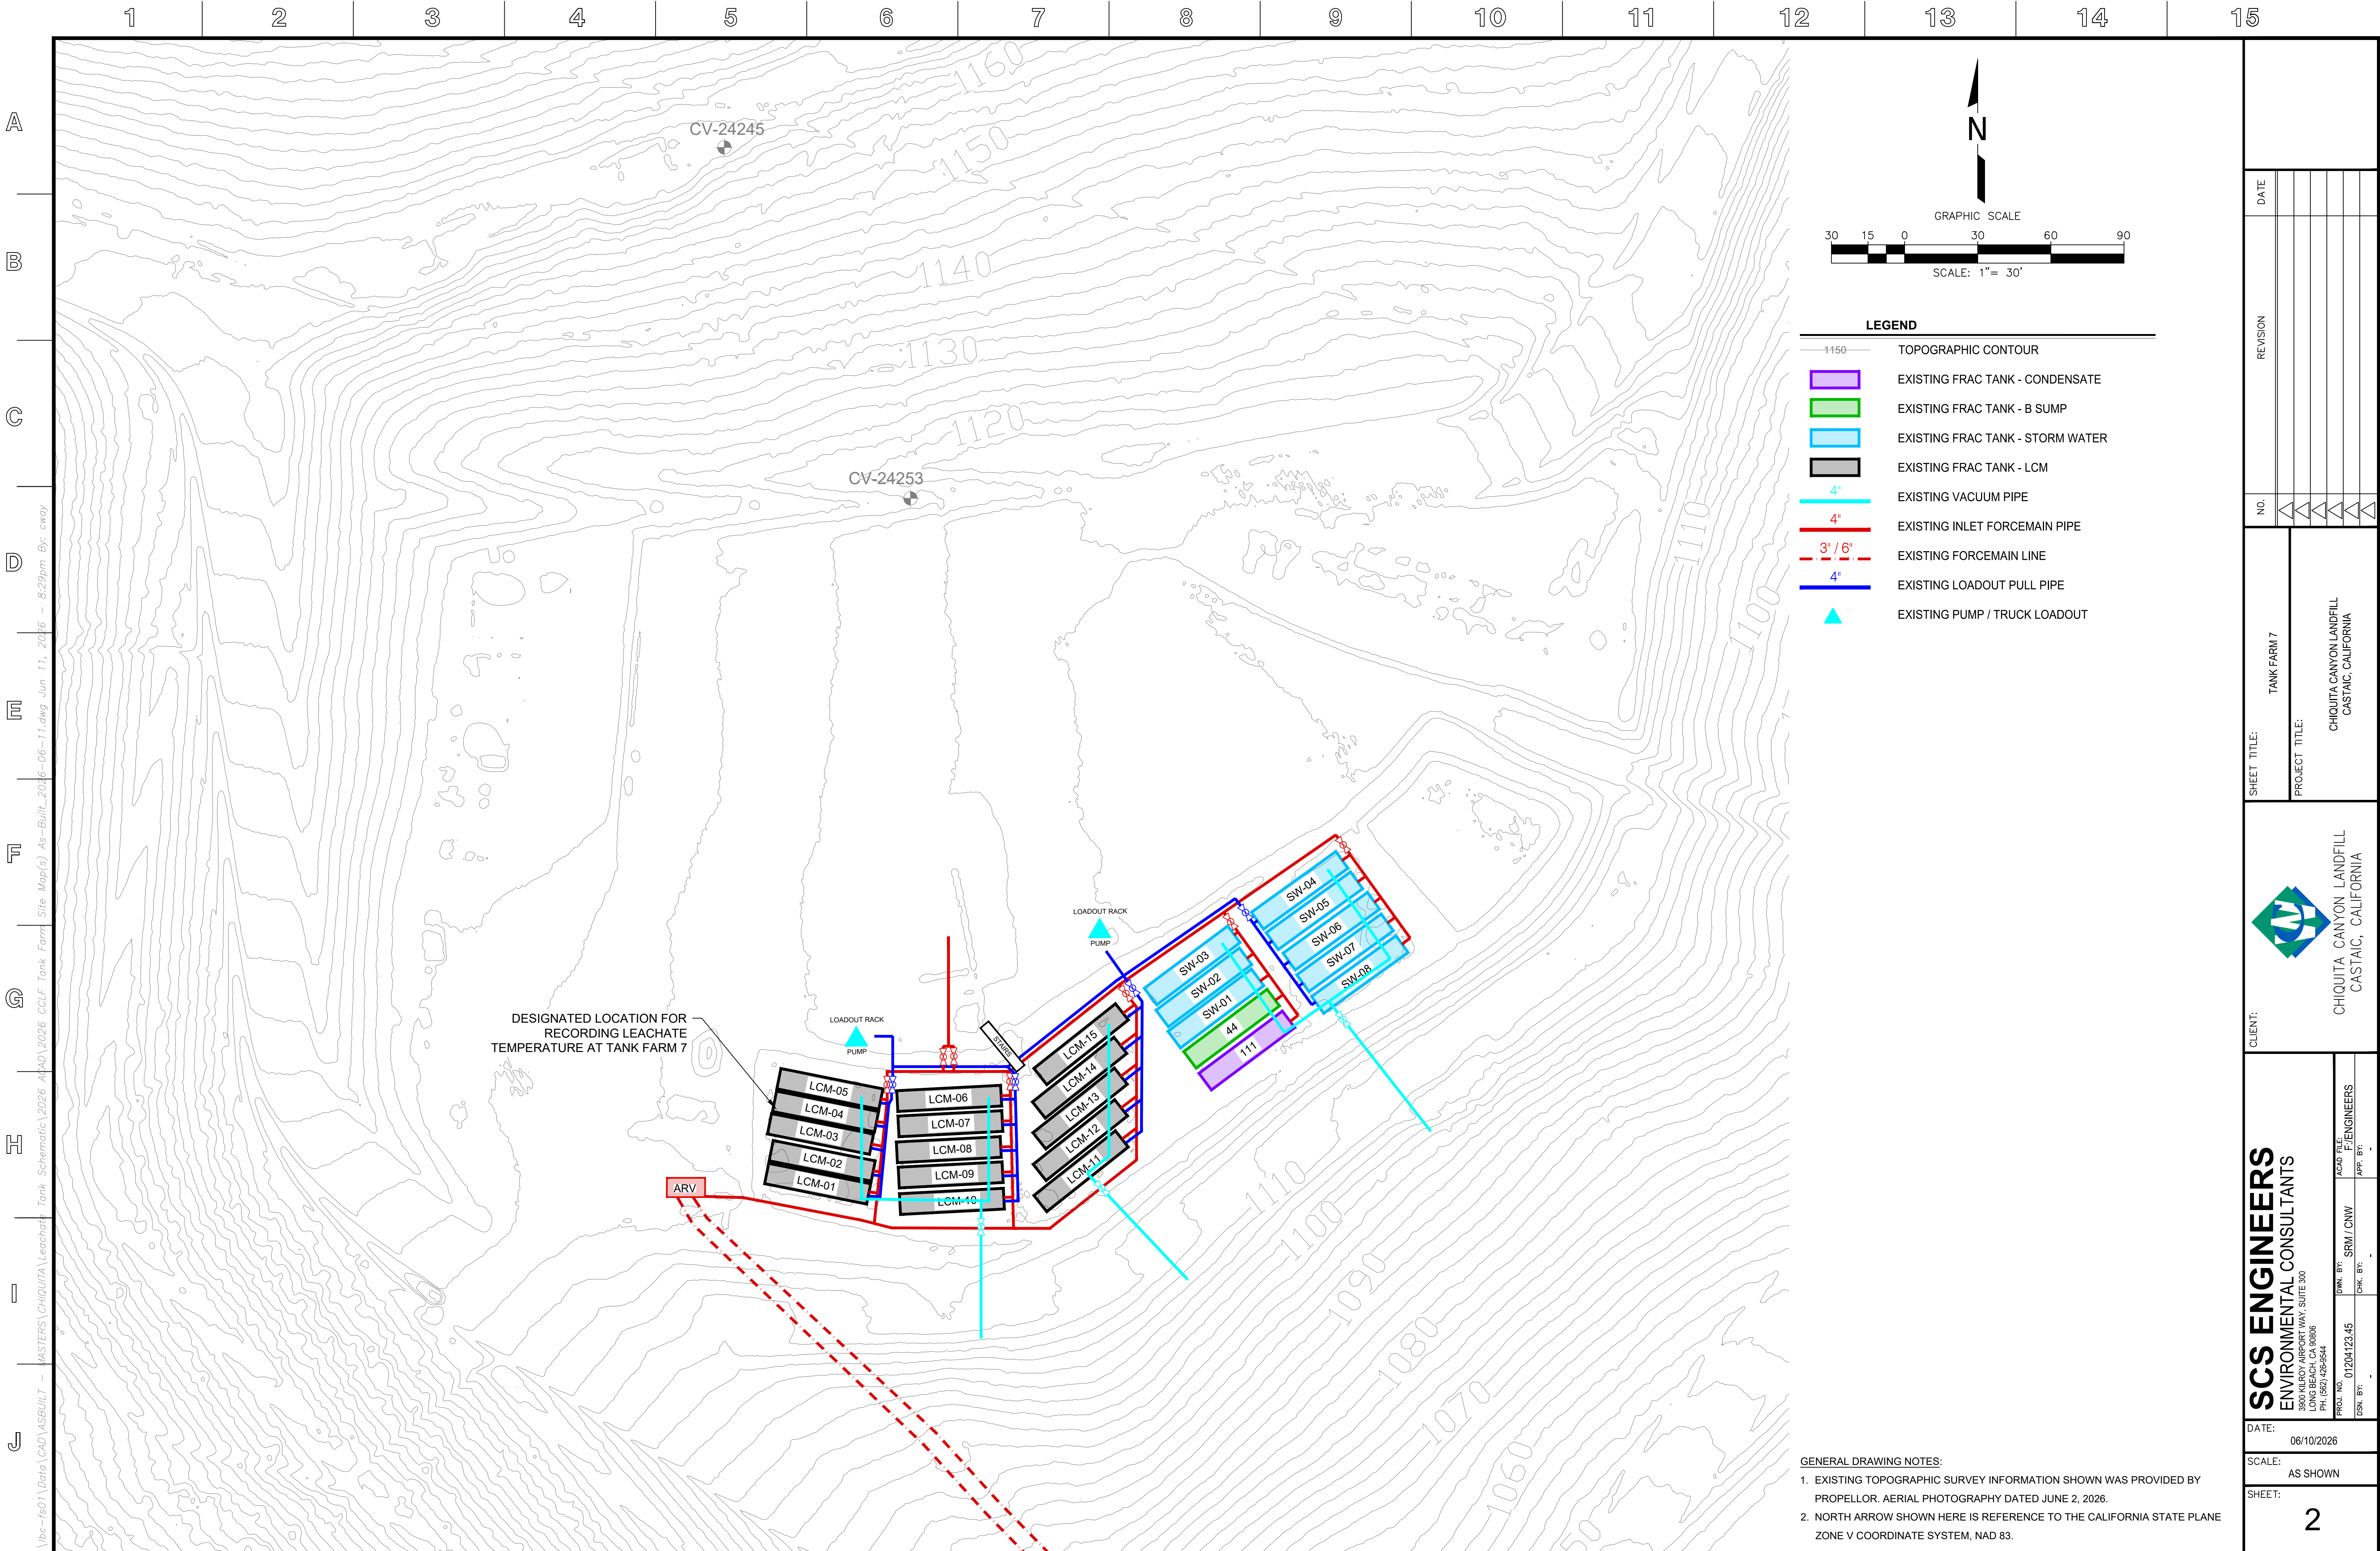

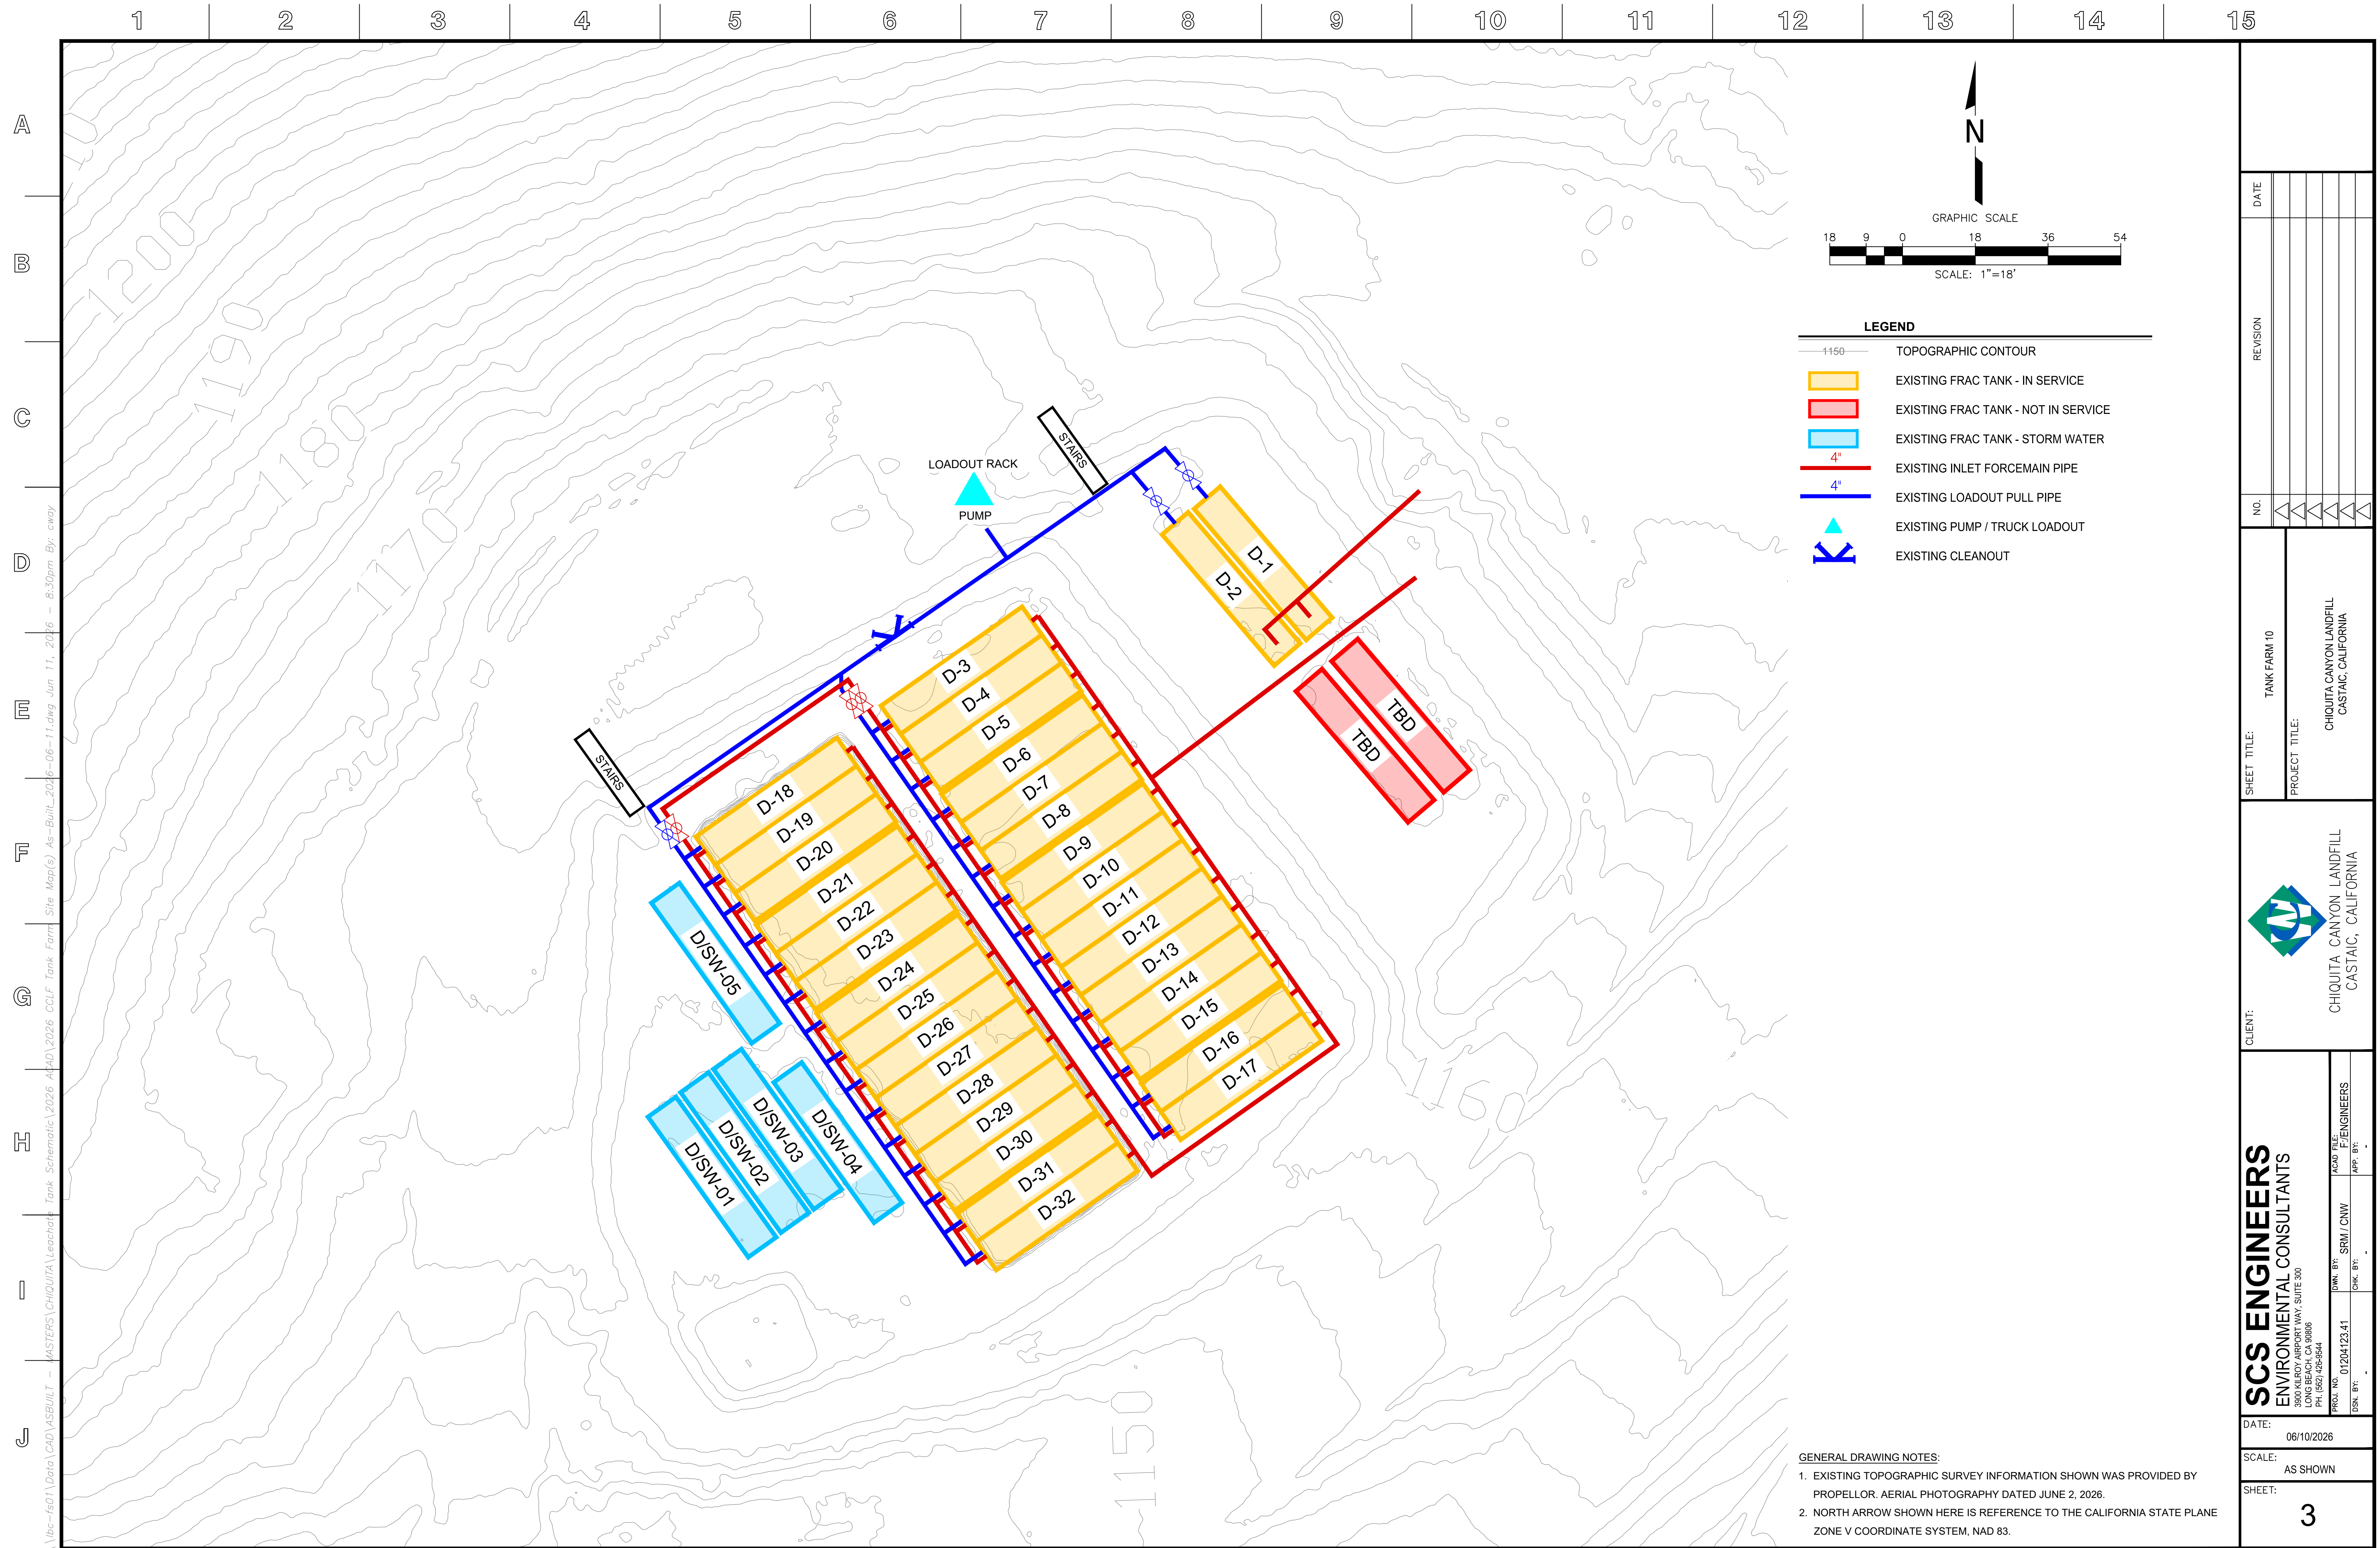

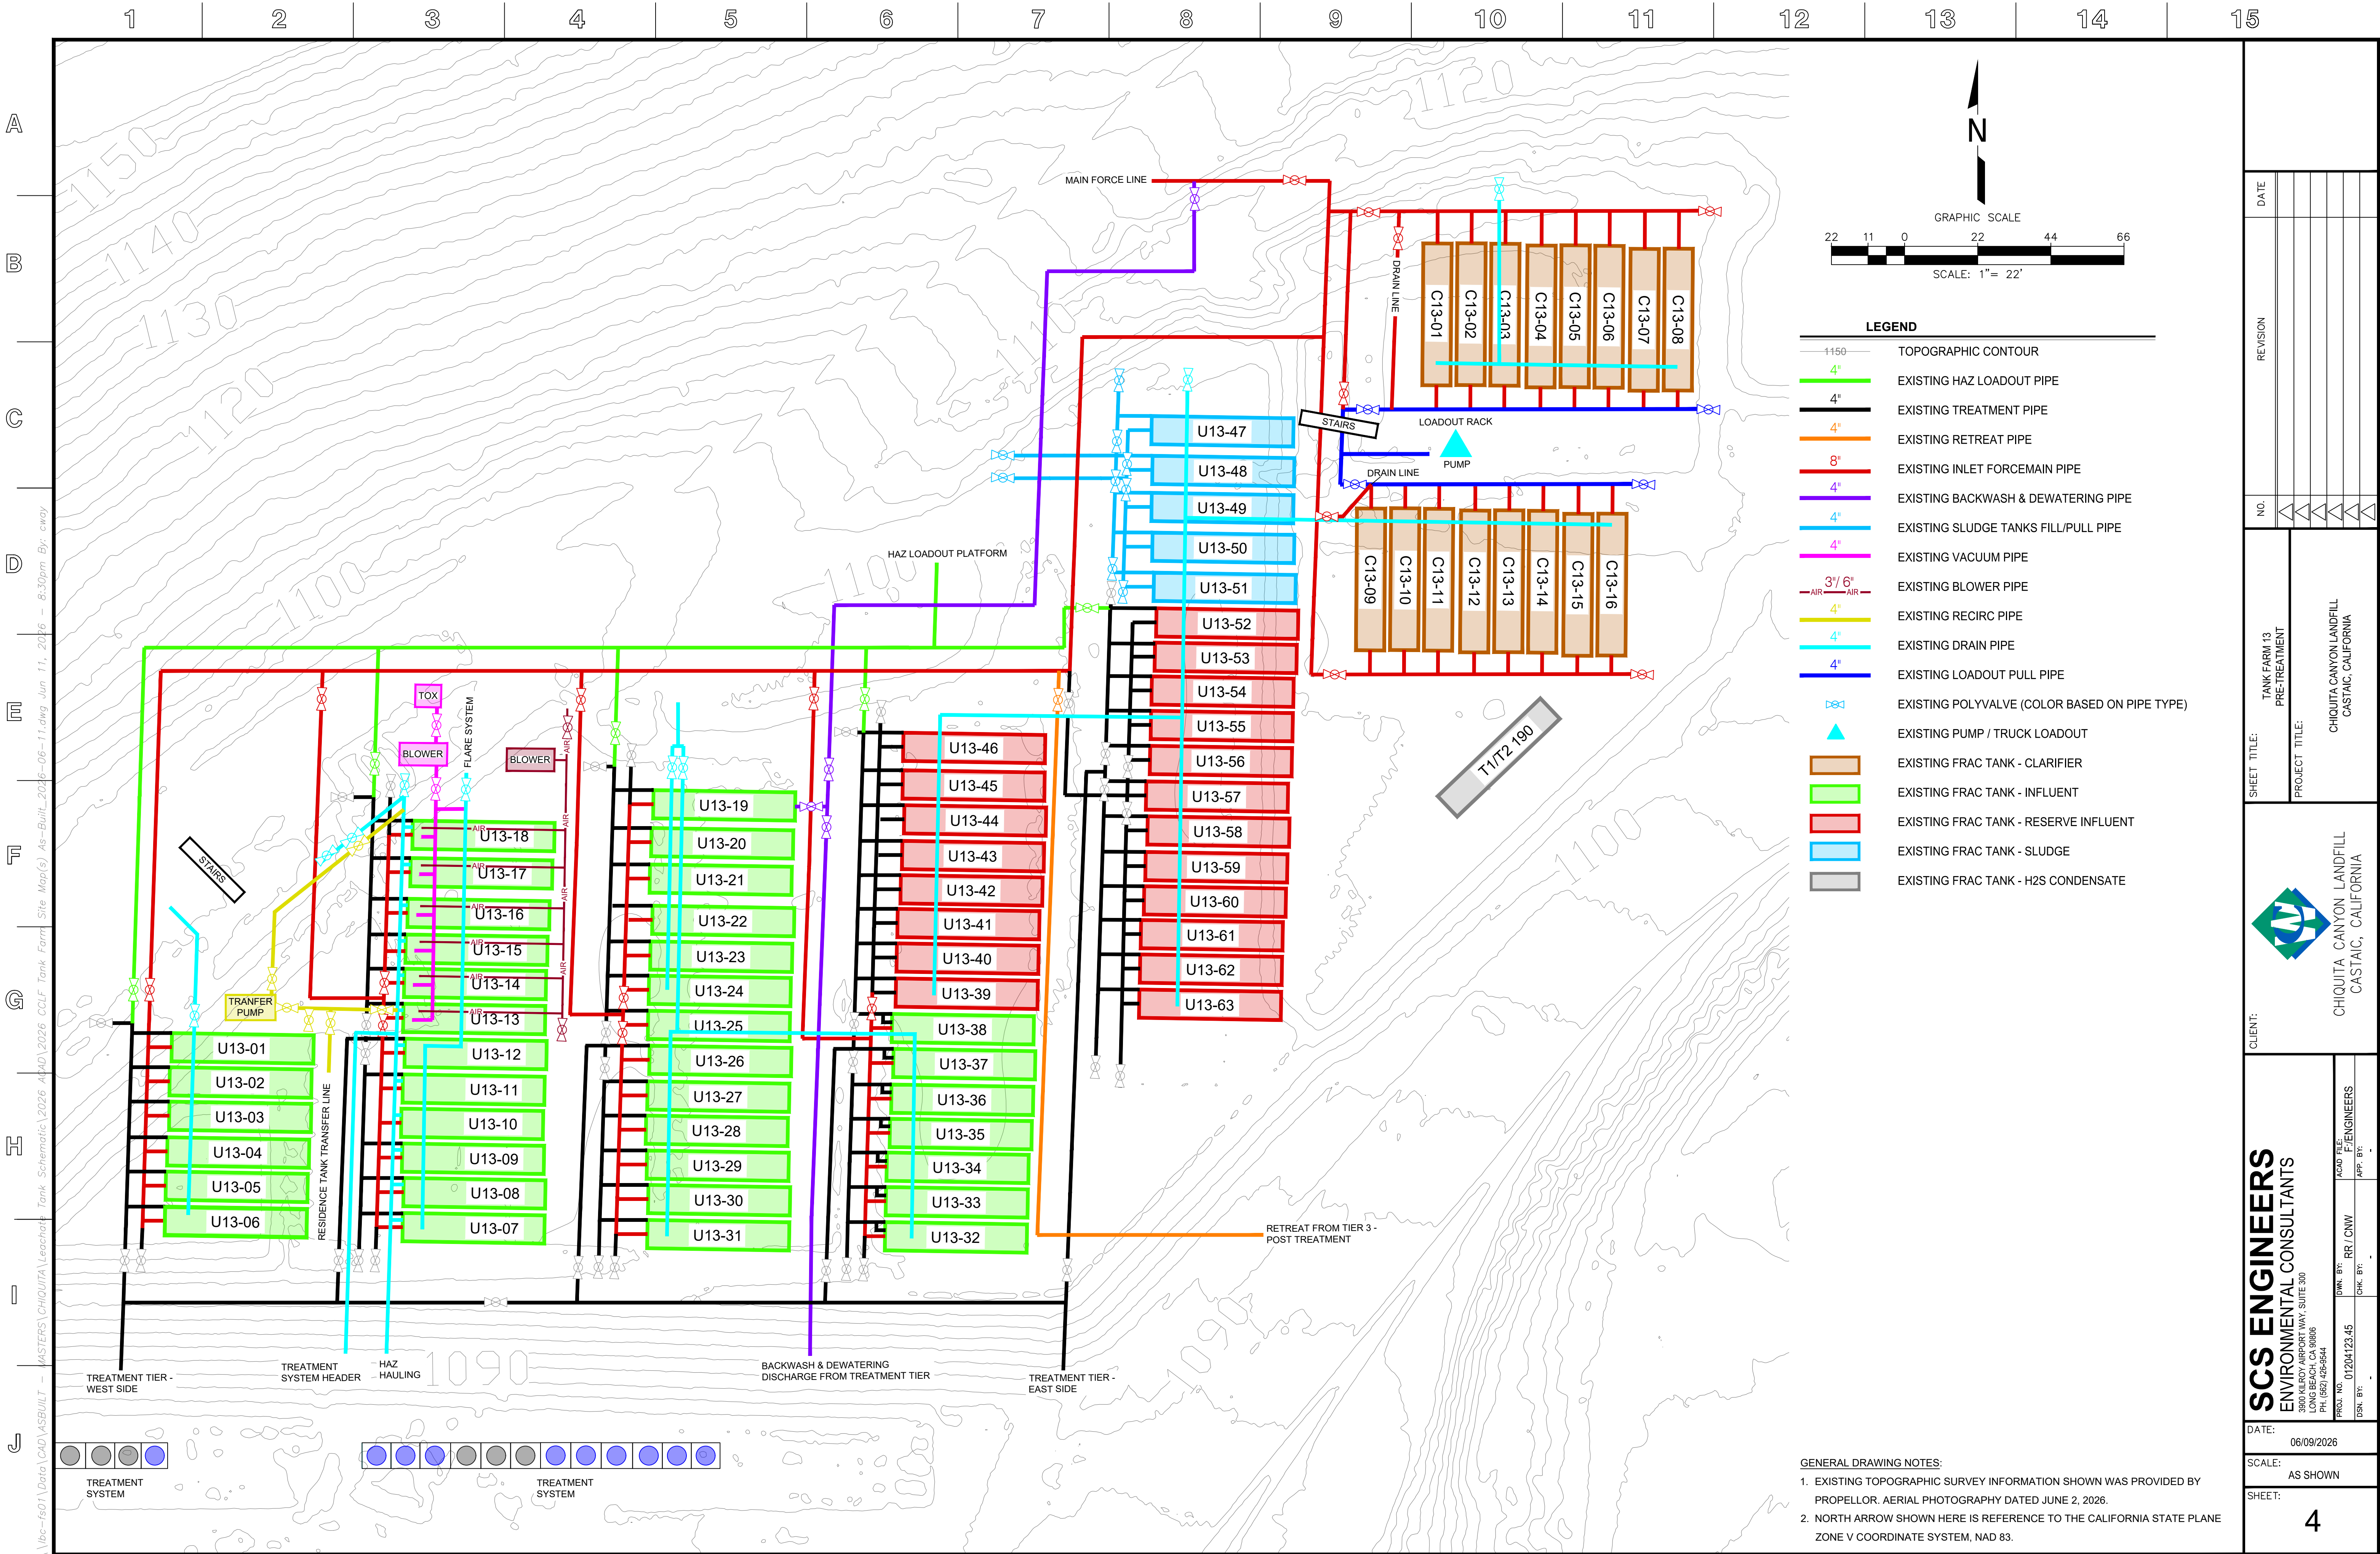

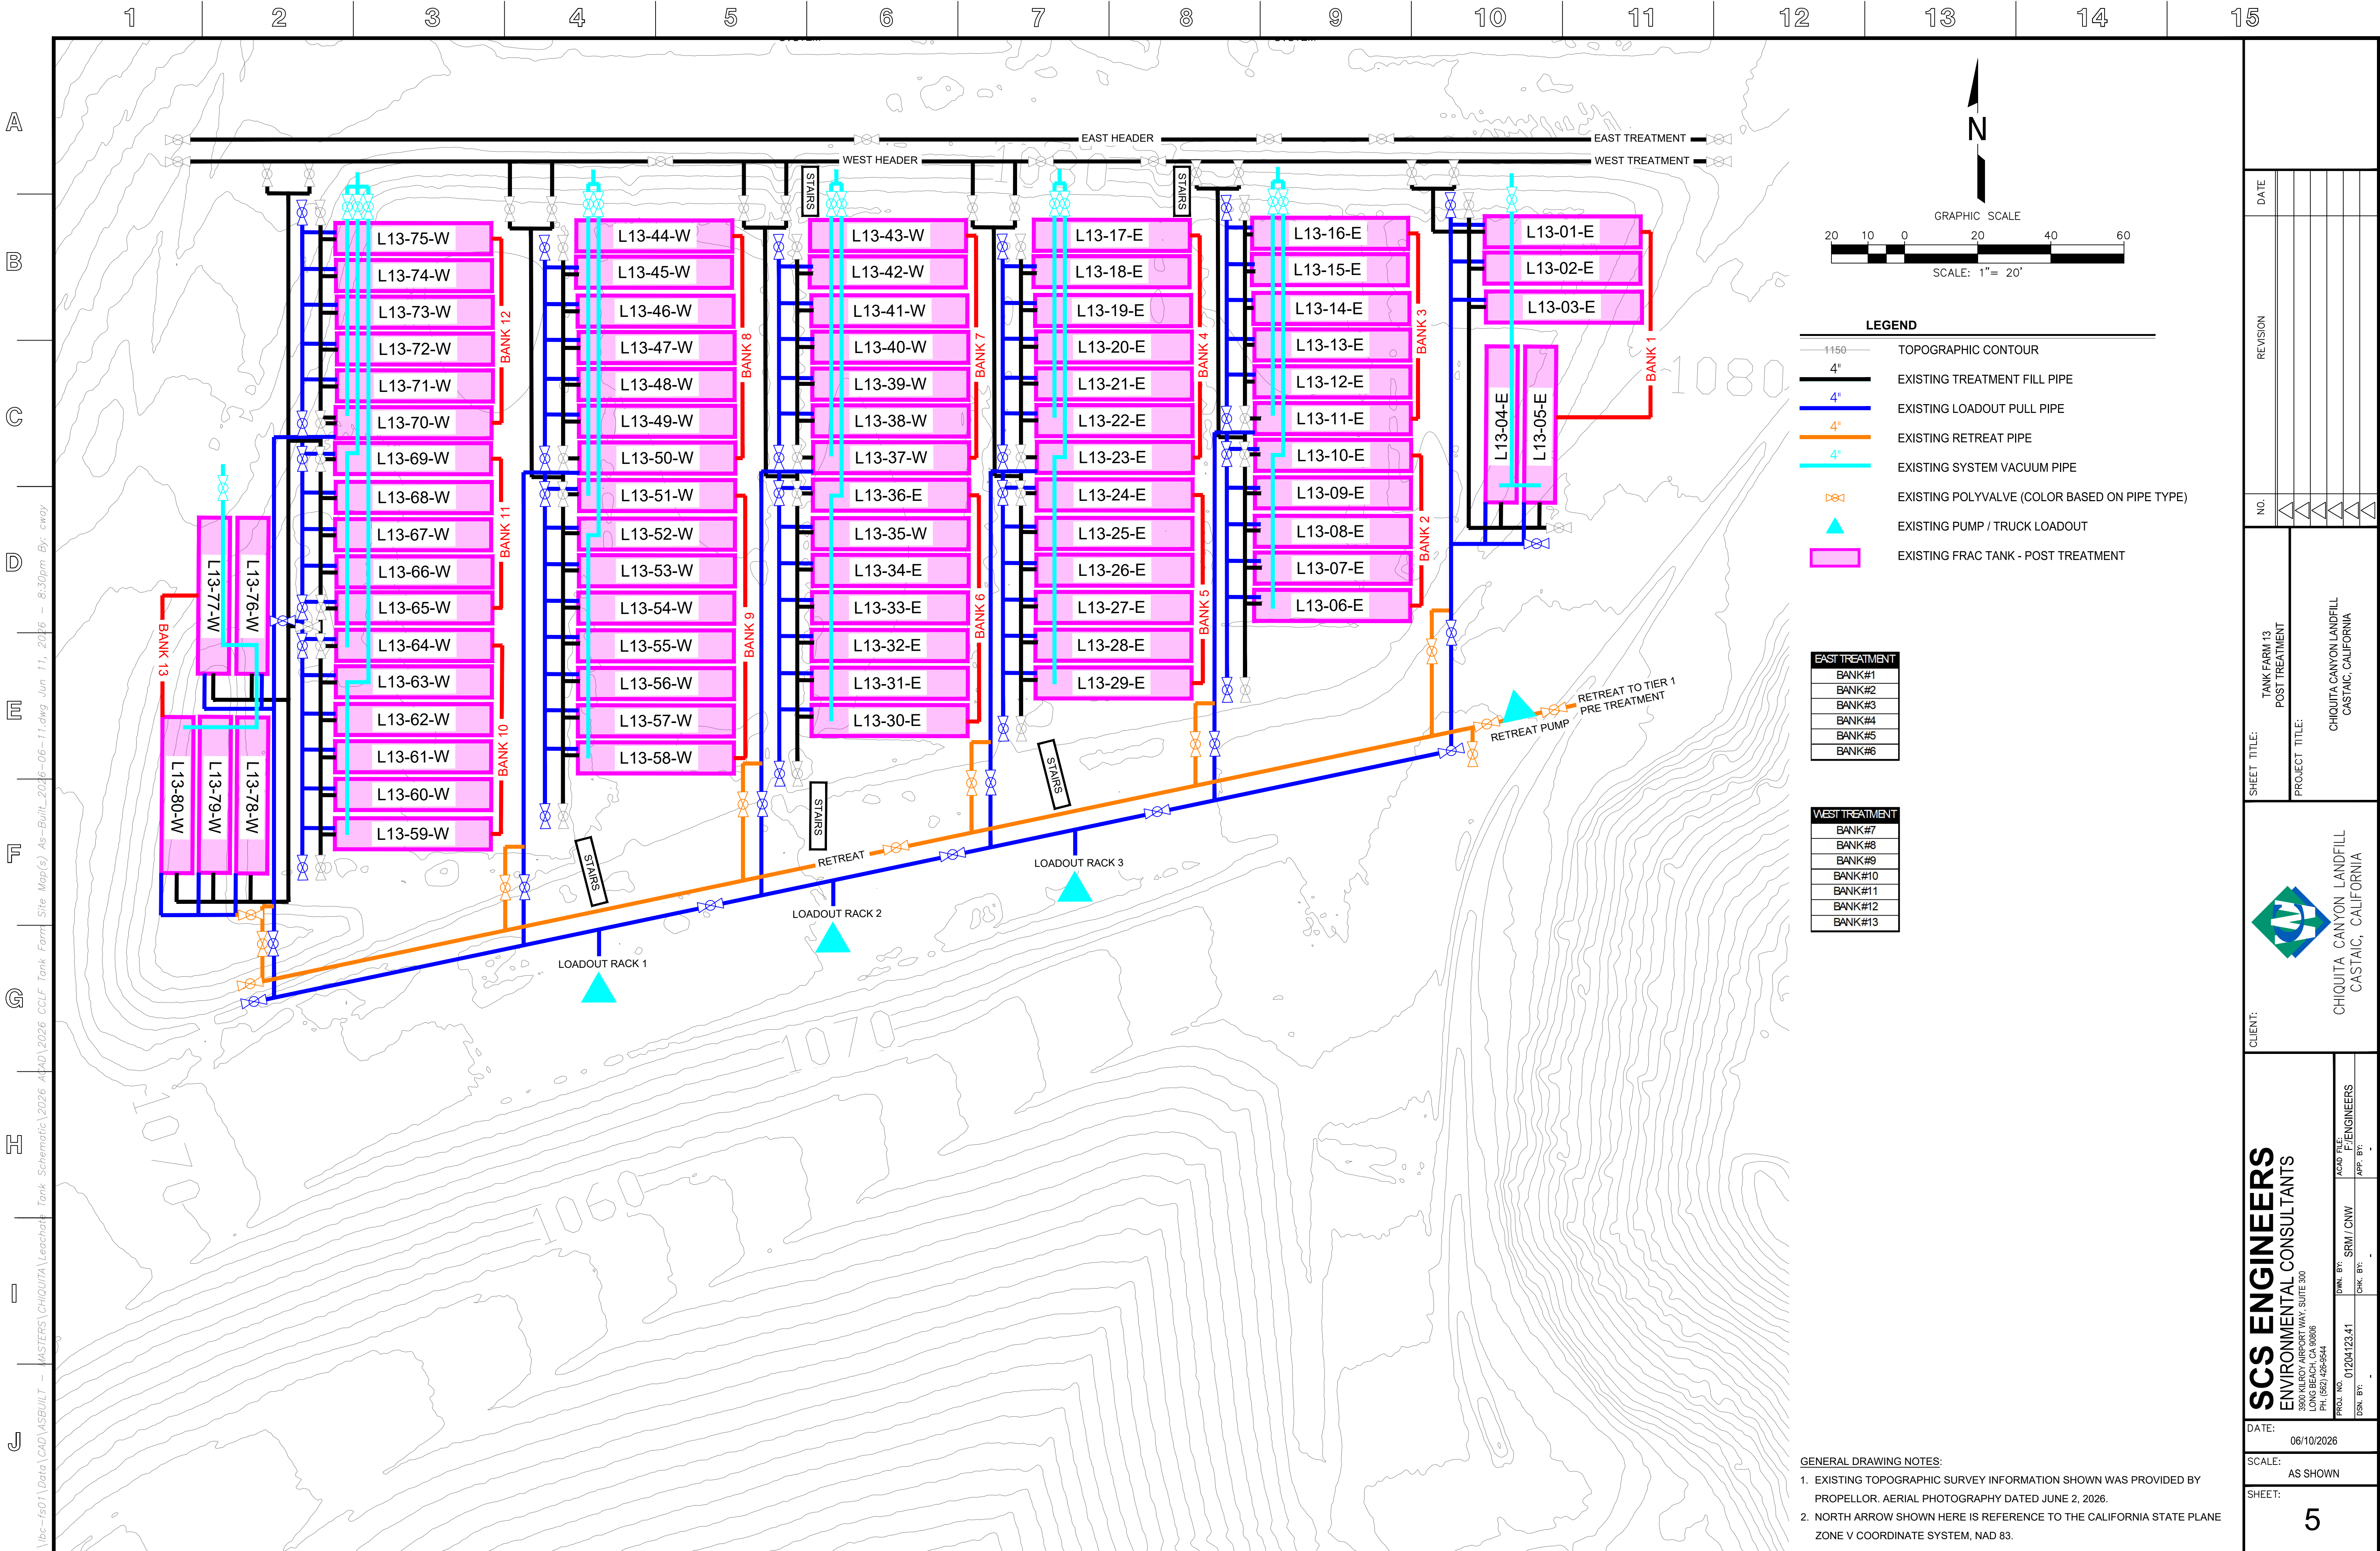

\\bc-fs01\Data\CAD\ASBUILT - MASTERS\CHIQUITA\Leachate Tank Farm Site Map(s) As-Built_2026-06-11.dwg Jun 11, 2026 - 8:30pm By: cway

DATE	
REVISION	
NO.	
SHEET TITLE: TANK FARM 13 POST TREATMENT	
PROJECT TITLE: CHIQUITA CANYON LANDFILL CASTAIC, CALIFORNIA	
CLIENT: CHIQUITA CANYON LANDFILL CASTAIC, CALIFORNIA	
SCS ENGINEERS ENVIRONMENTAL CONSULTANTS 1800 ALABAMA STREET, SUITE 300 LONG BEACH, CA 90806 PH: (562) 426-9544	
DATE: 06/10/2026	SCALE: AS SHOWN
SHEET: 5	