

Archivado: Viernes 24 de julio de 2026 a la 10:57:42 AM
De: [Sarah Phillips](#)
Enviado: Lunes 20 de julio de 2026 23:13:41
Para: [Zmily, Zanalée@DTSC](#)
Cc: [McGuire, Christopher@DTSC](#)
Asunto: CCL: Mapas Actualizados de los Parques de Tanques y del Campo de Pozos
Importancia: Normal
Sensibilidad: Ninguna
Adjuntos: [image.png](#); [image.png](#); [2026-07-14_CCLF_MASTER LMS Map.pdf](#); [2026 CCLF Tank Farm Site Map\(s\) As-Built_2026-06-11_v0.1.pdf](#);

Hola a todos,

En nombre de Chiquita Canyon, LLC, adjuntamos los mapas más recientes del parque de tanques y del campo de pozos, que se están presentando conforme a la carta de requerimientos de cumplimiento del DTSC del 20 de junio de 2025, consistente con la respuesta de Chiquita del 25 de julio de 2025. Háganos saber si tiene alguna pregunta.

Atentamente,
Sarah


Sarah Phillips


248.930.2779


Gerente de Cumplimiento Corporativo


Waste Connections




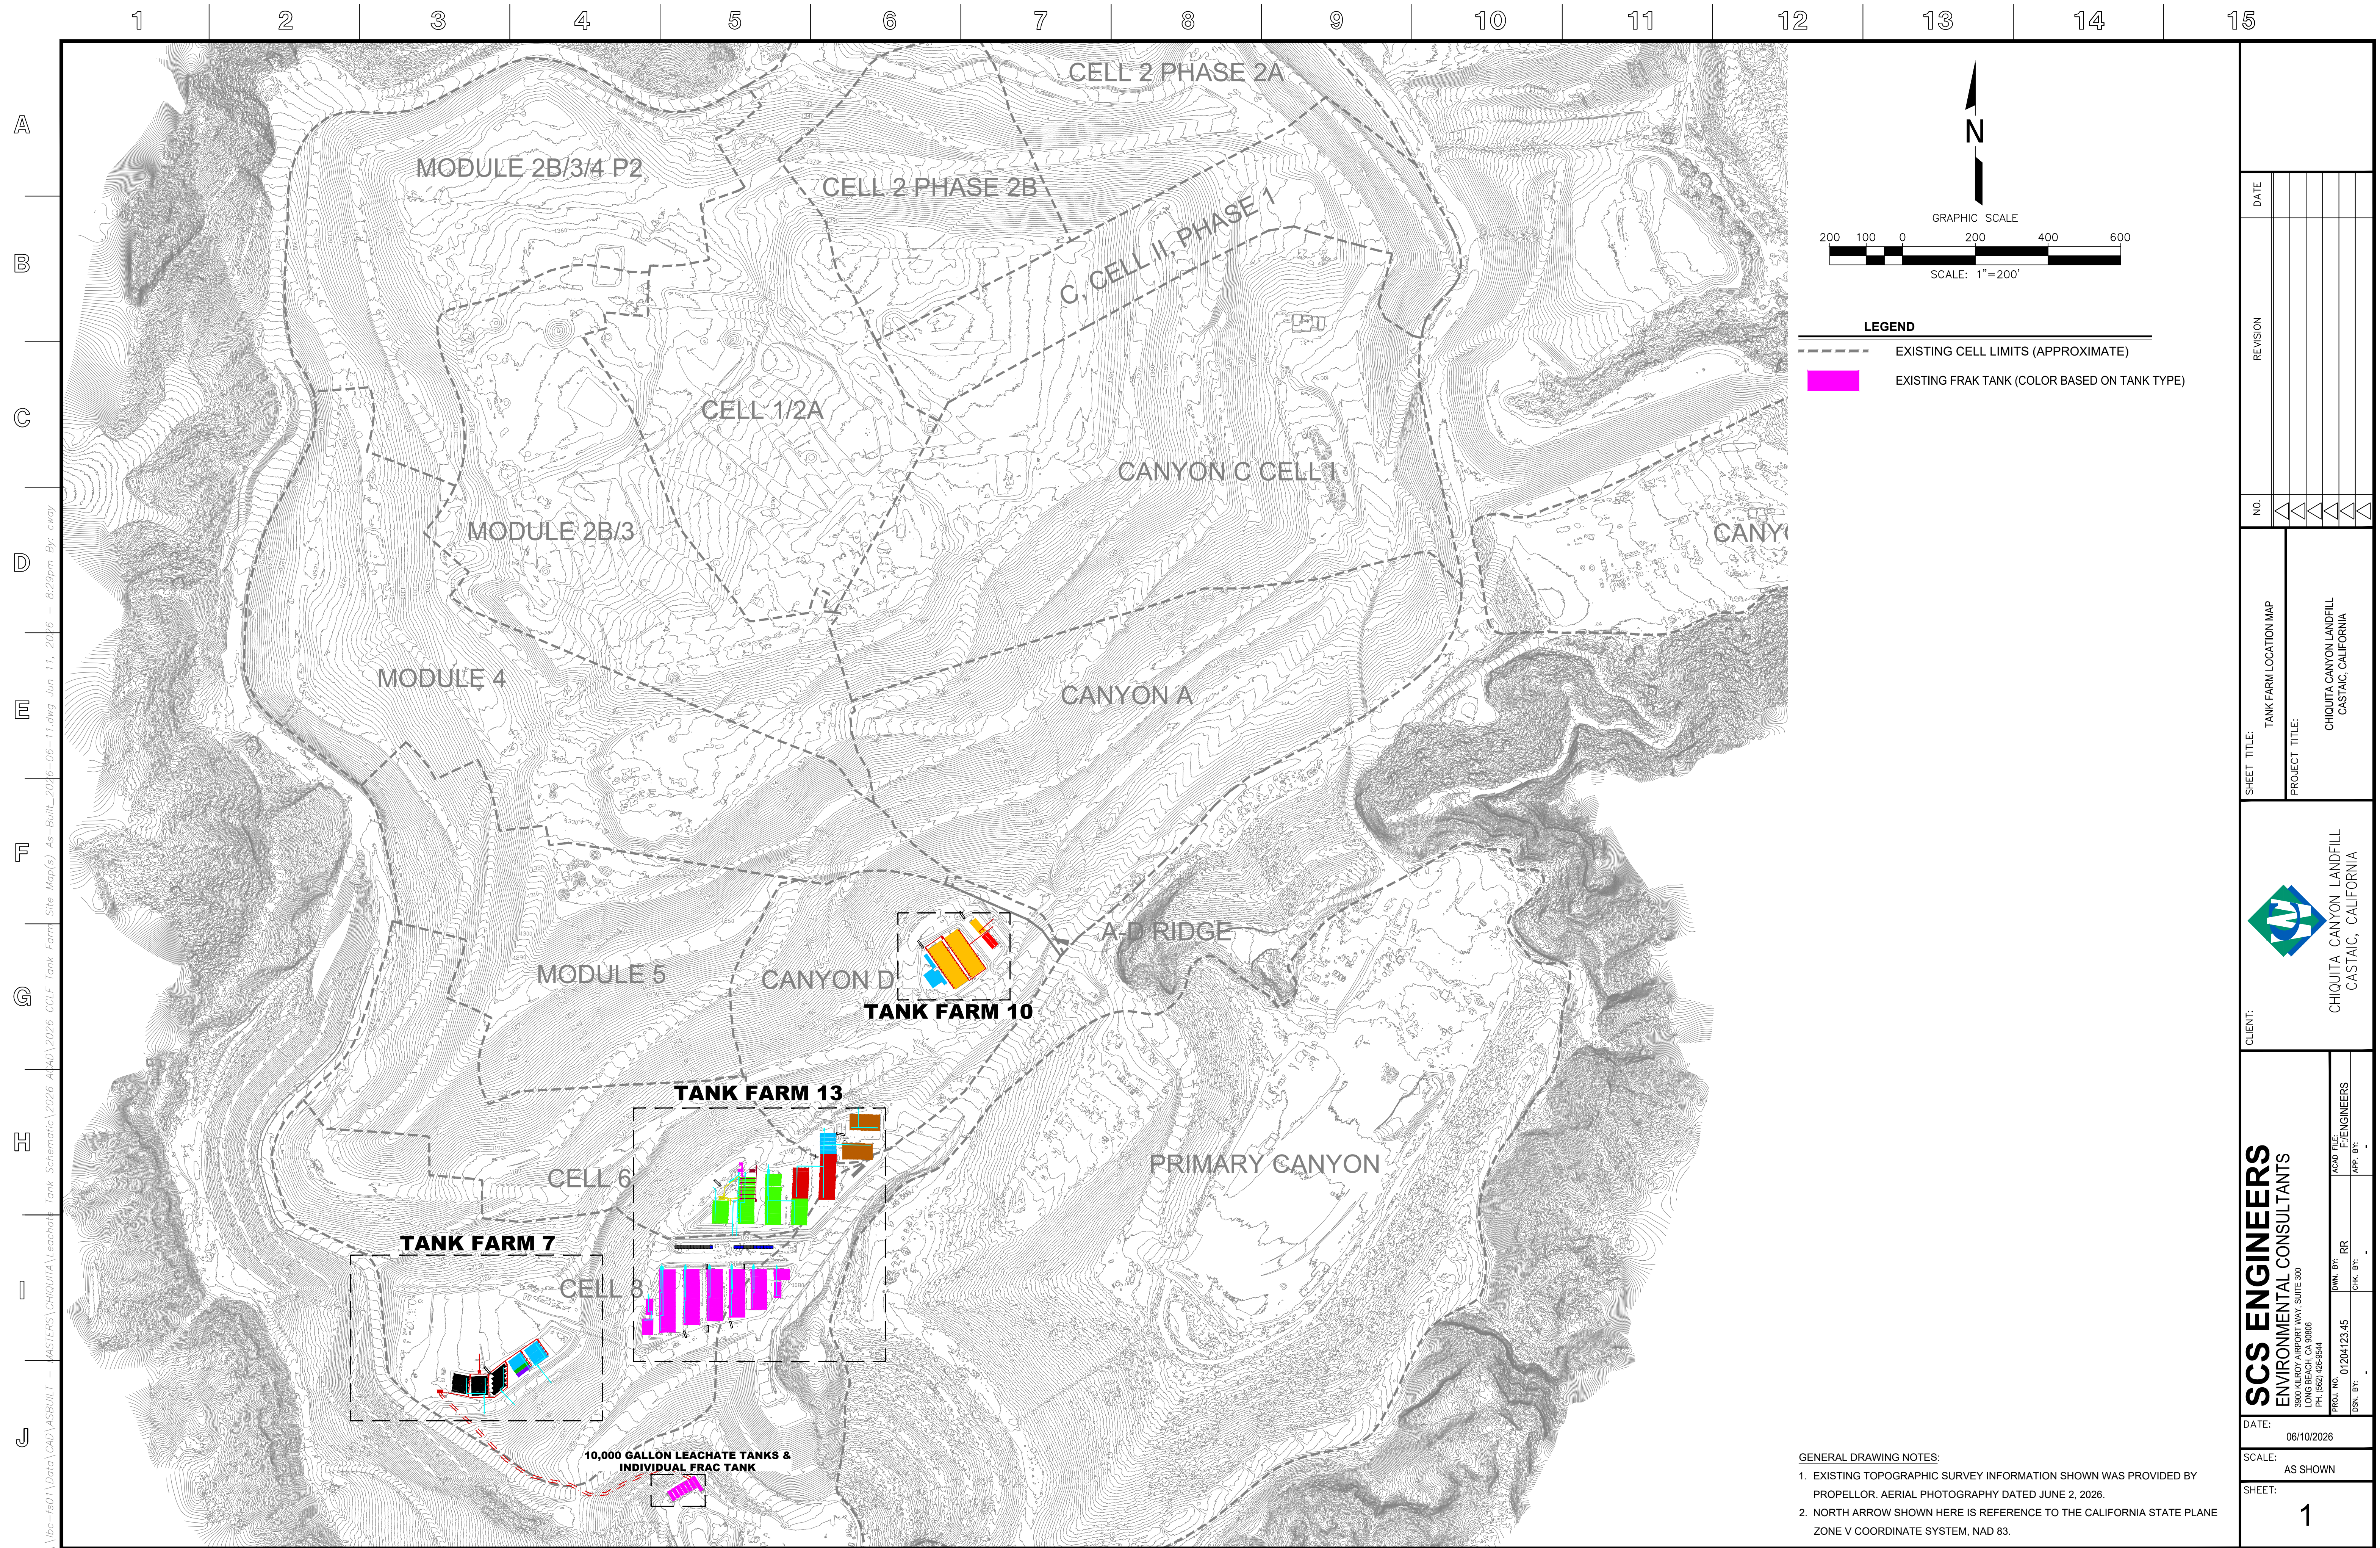

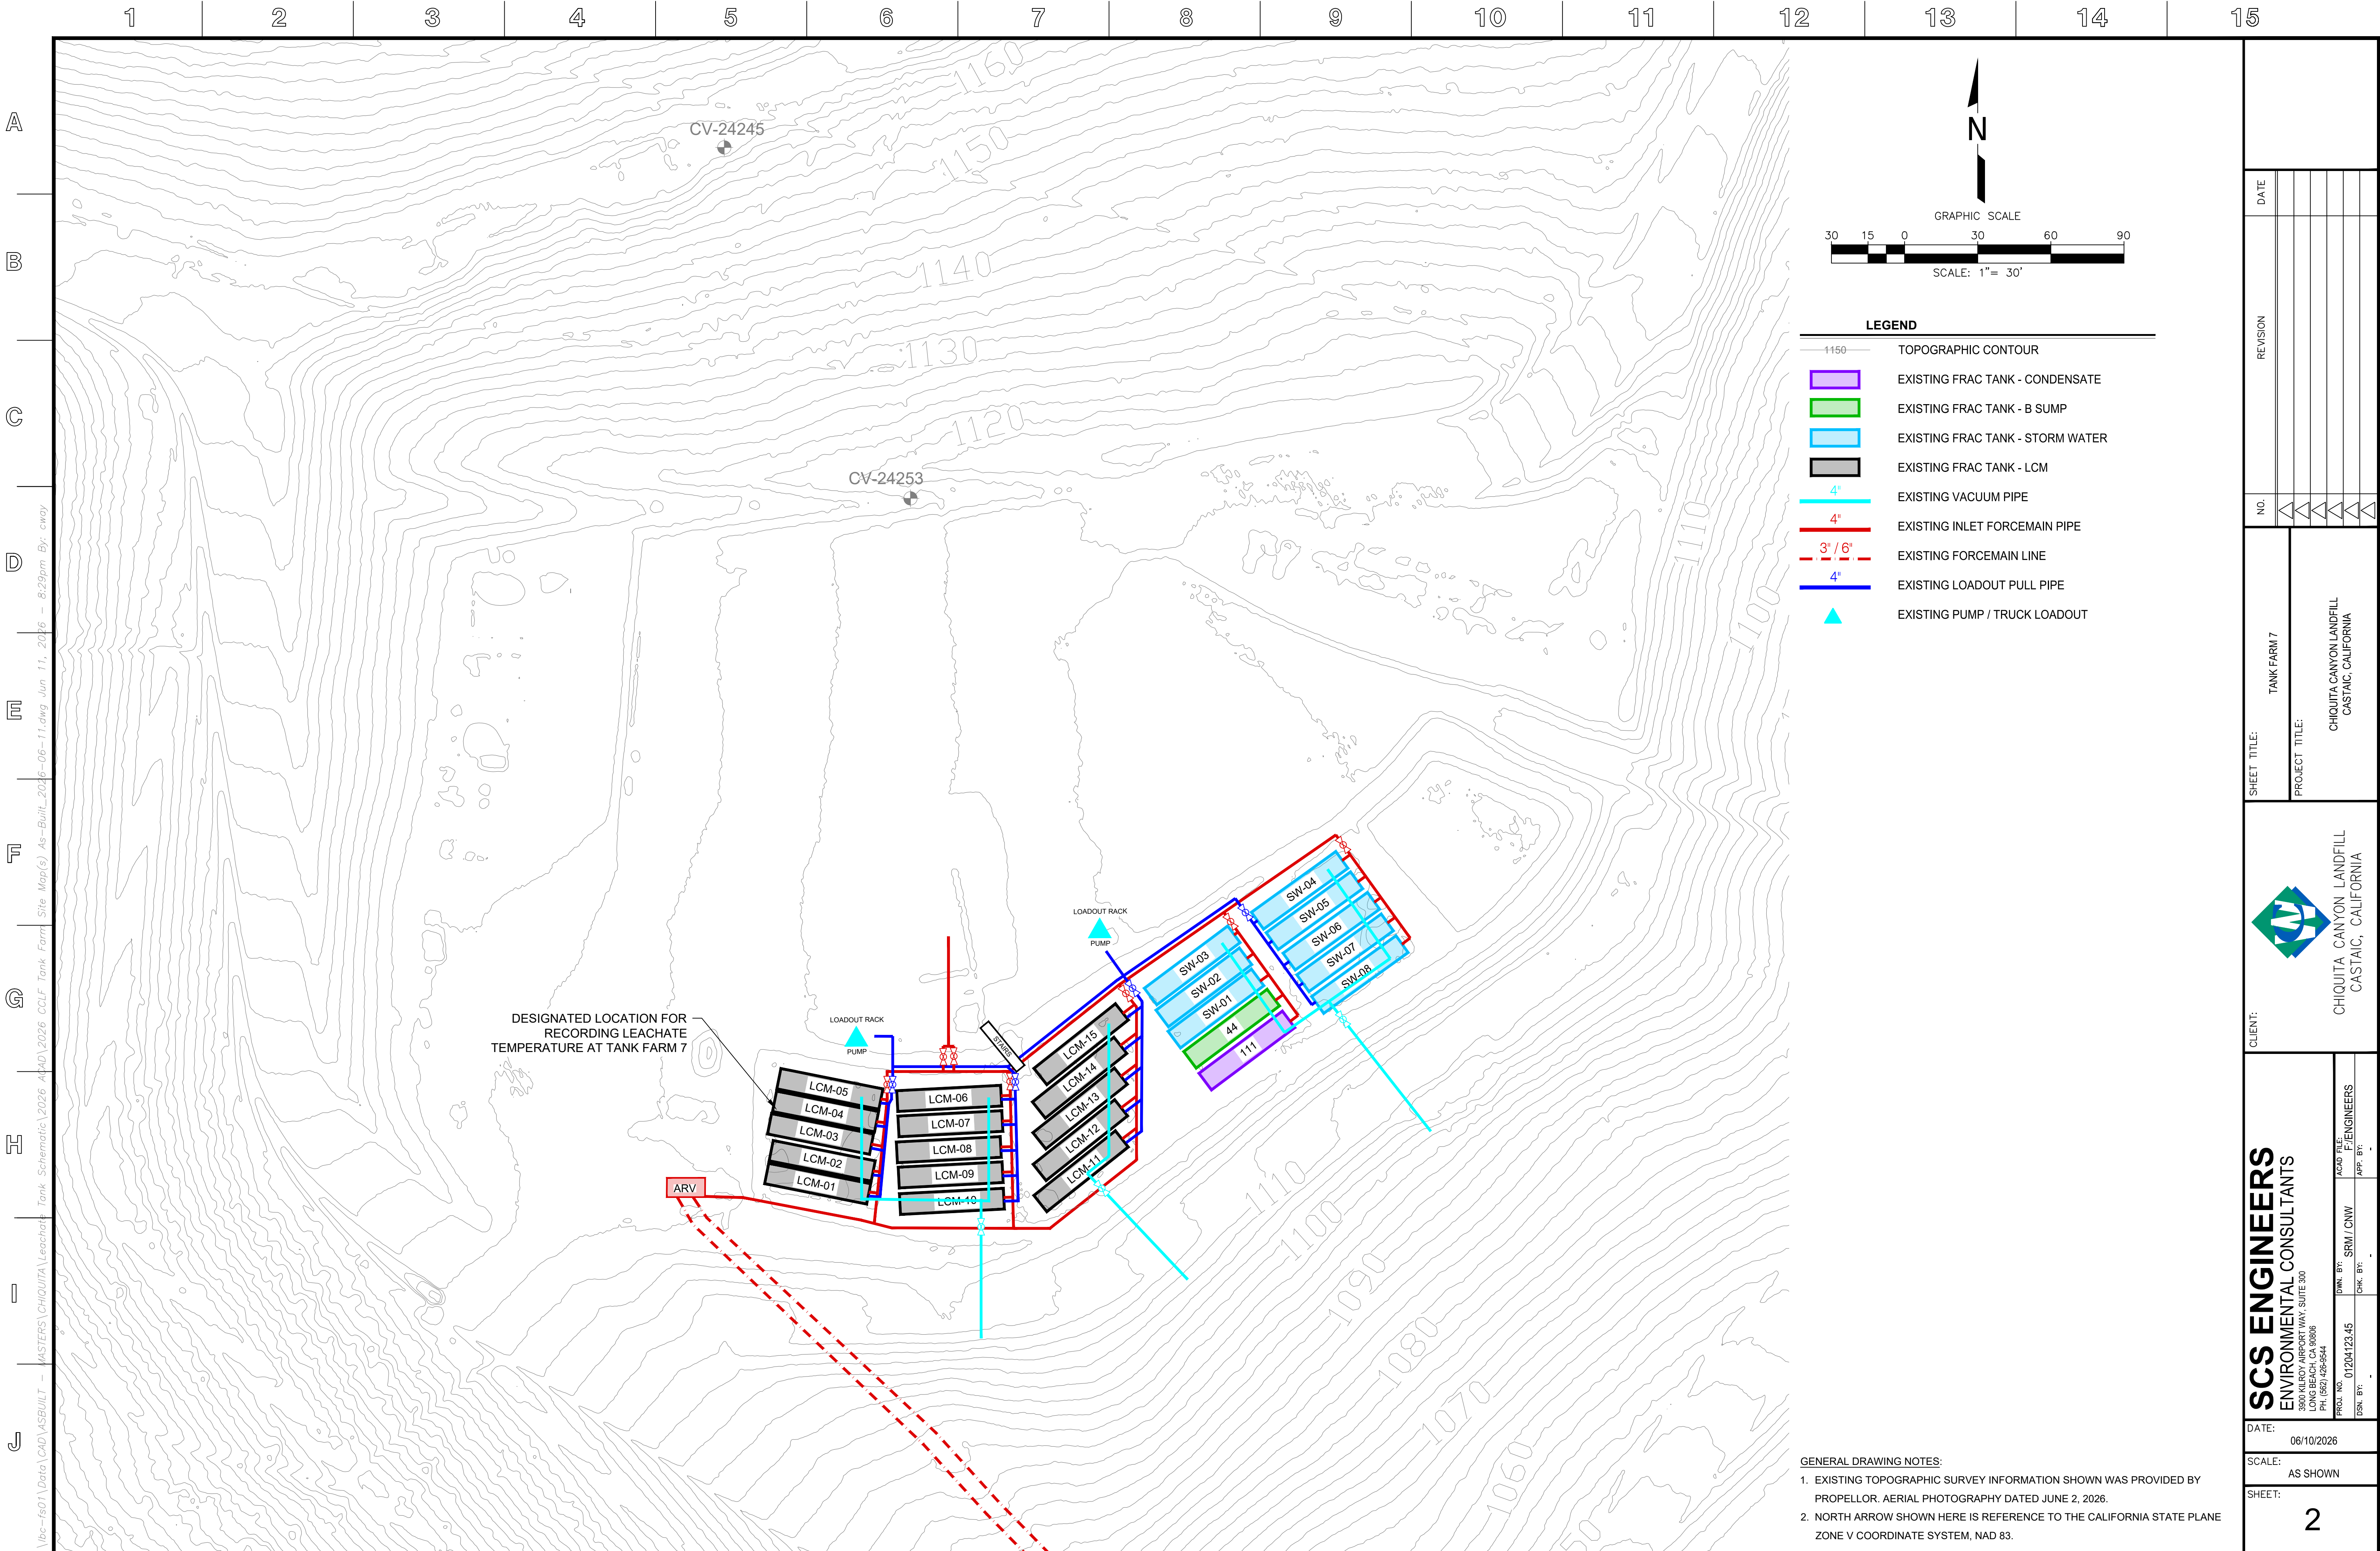

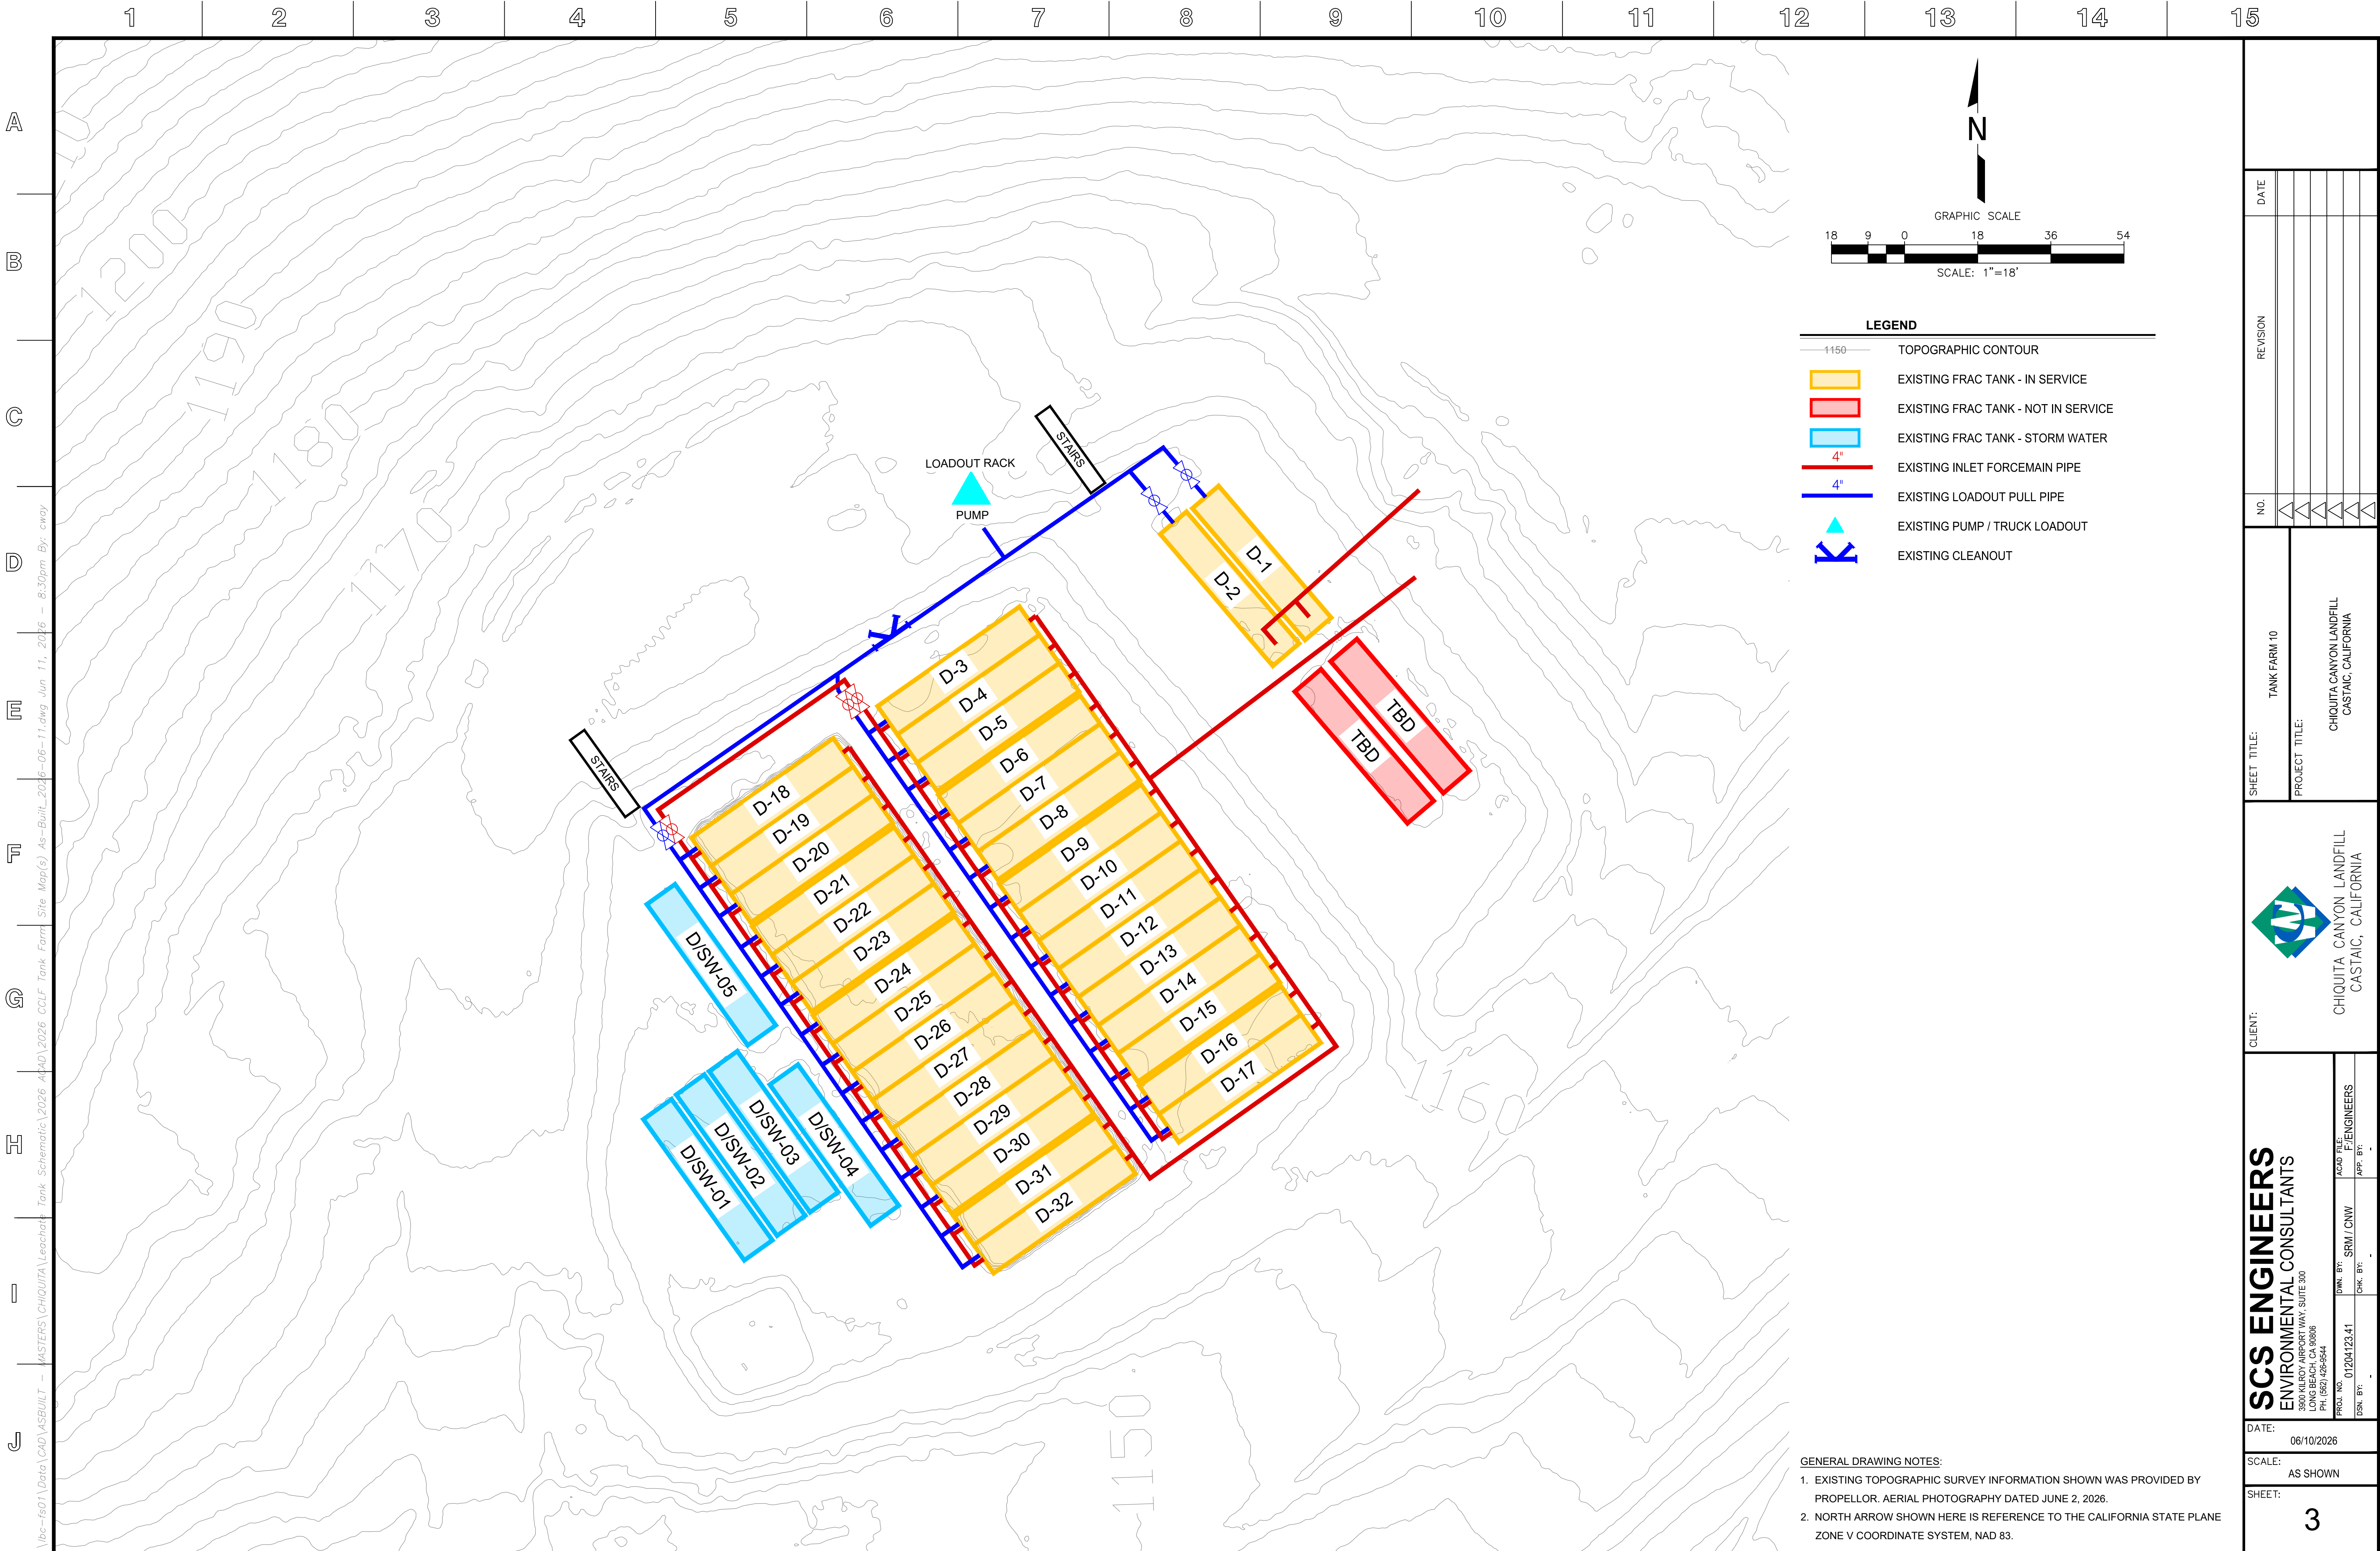

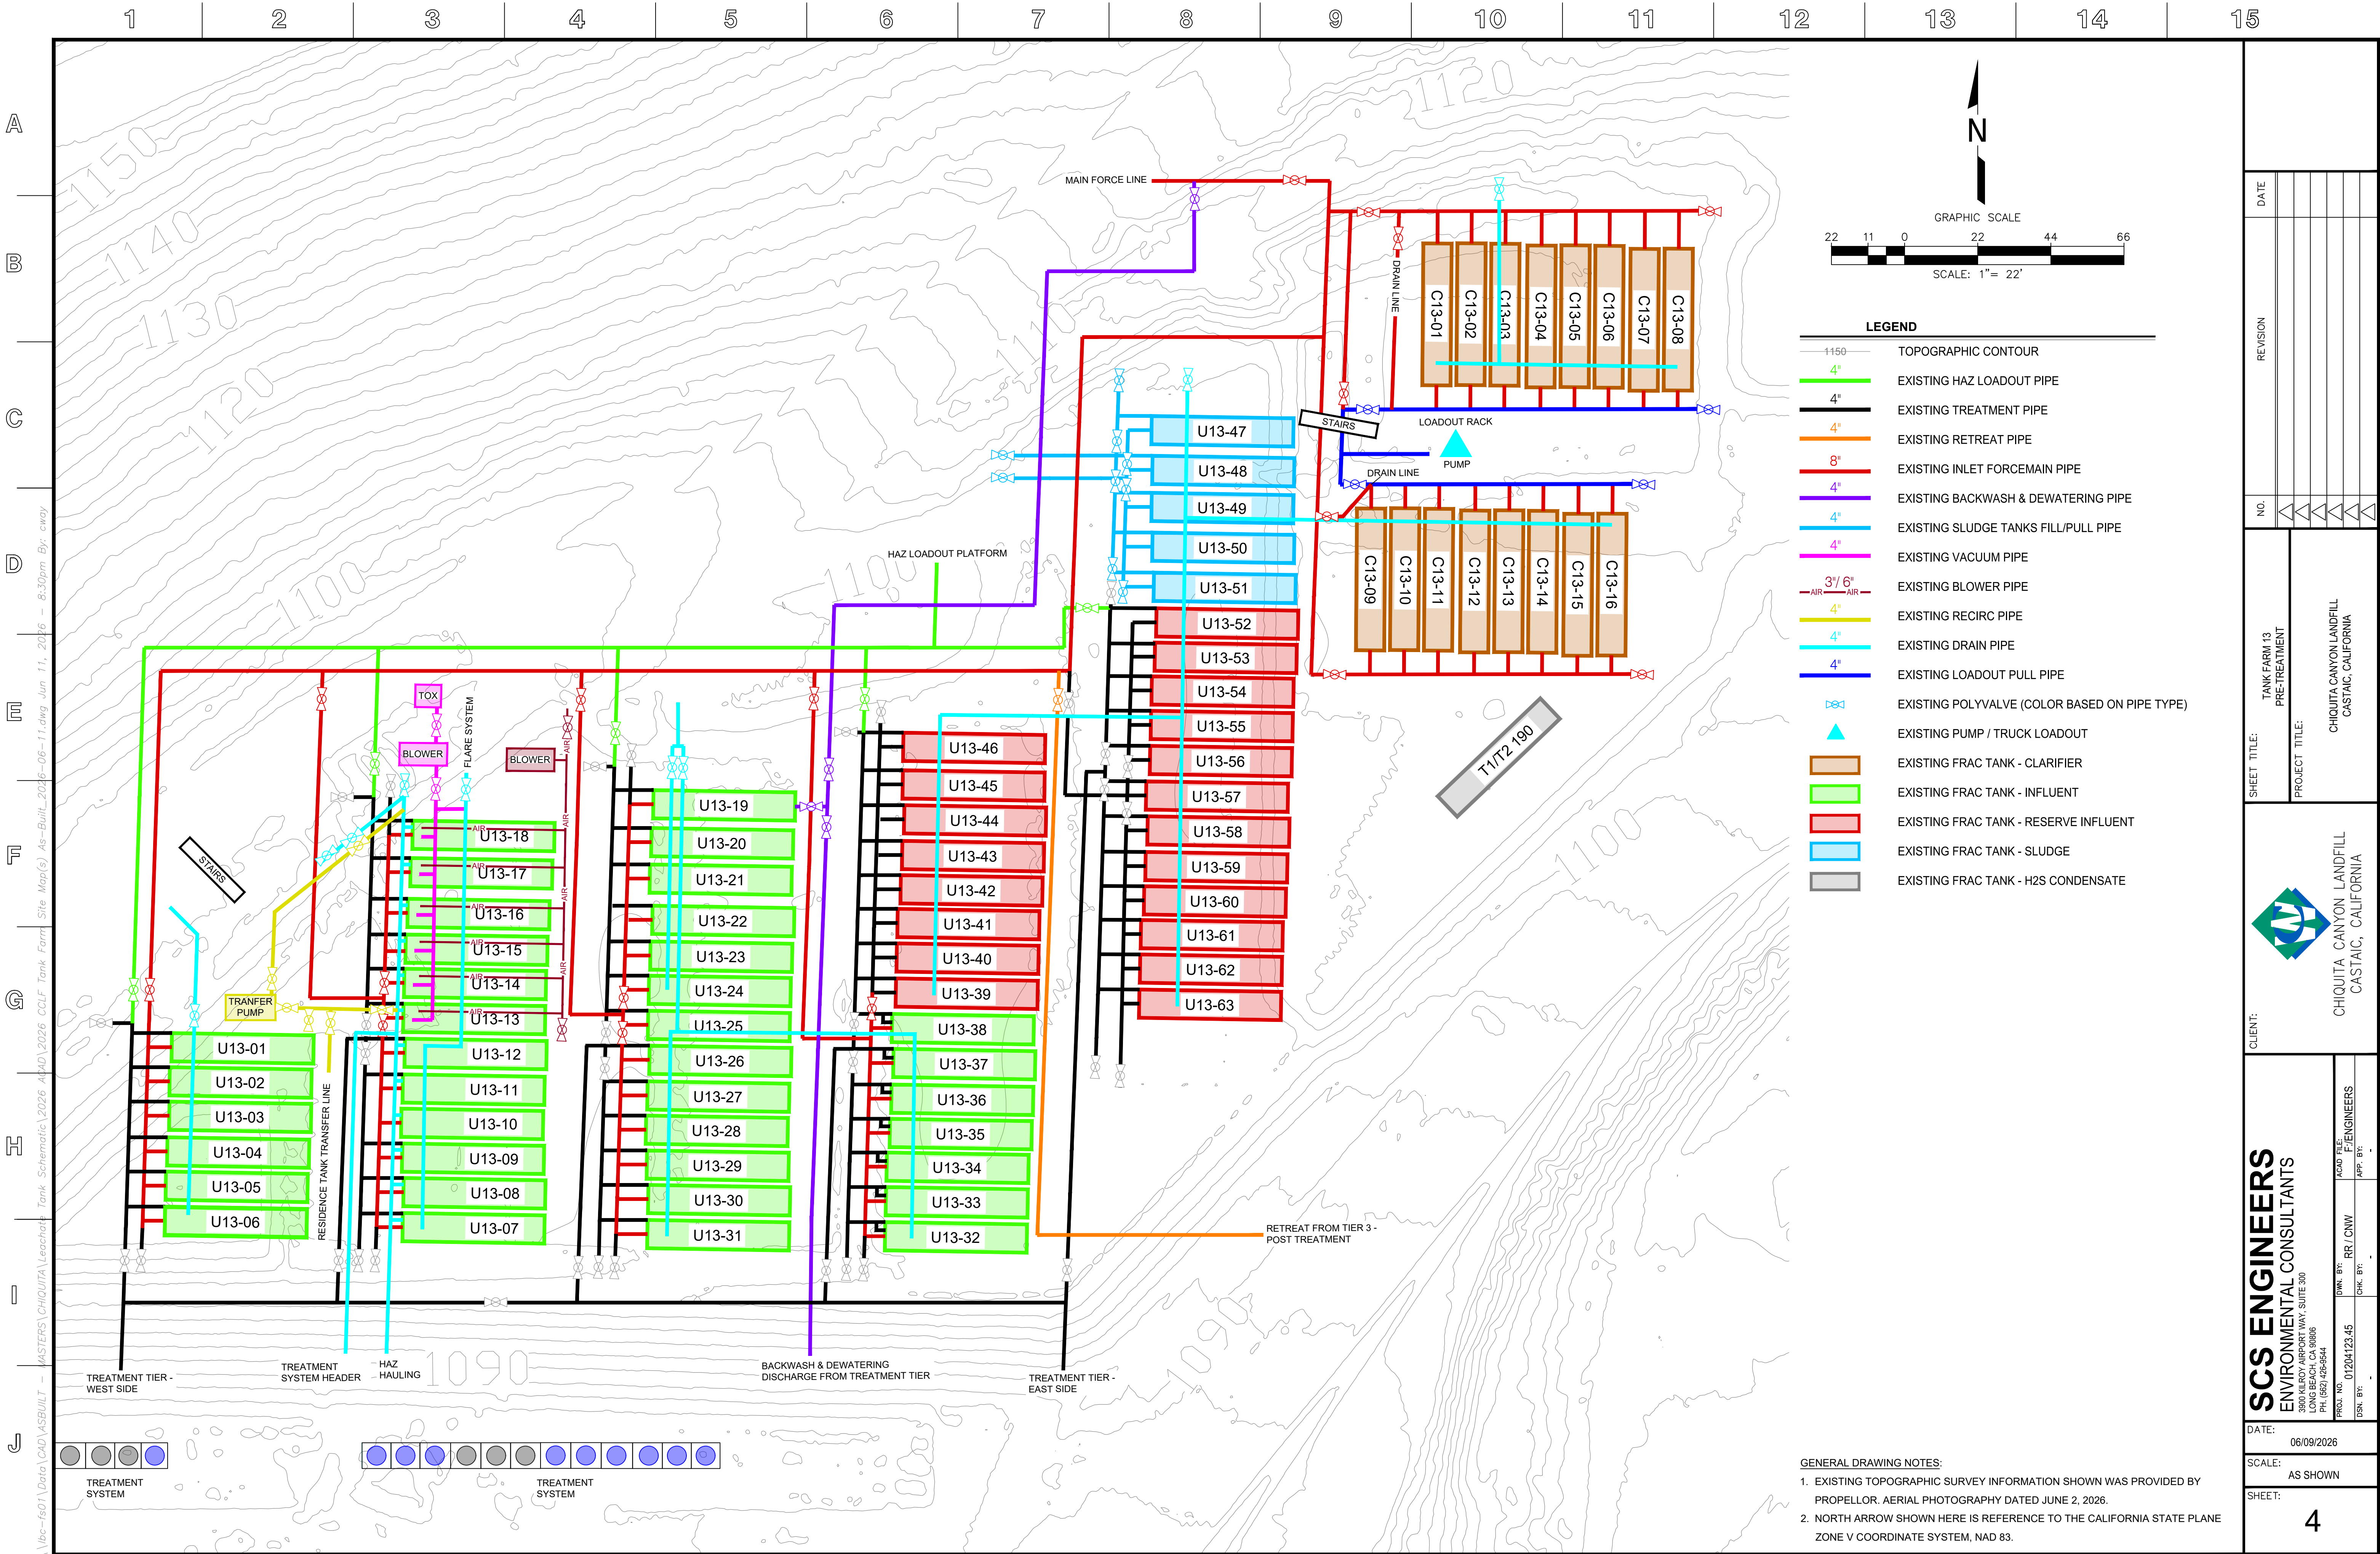

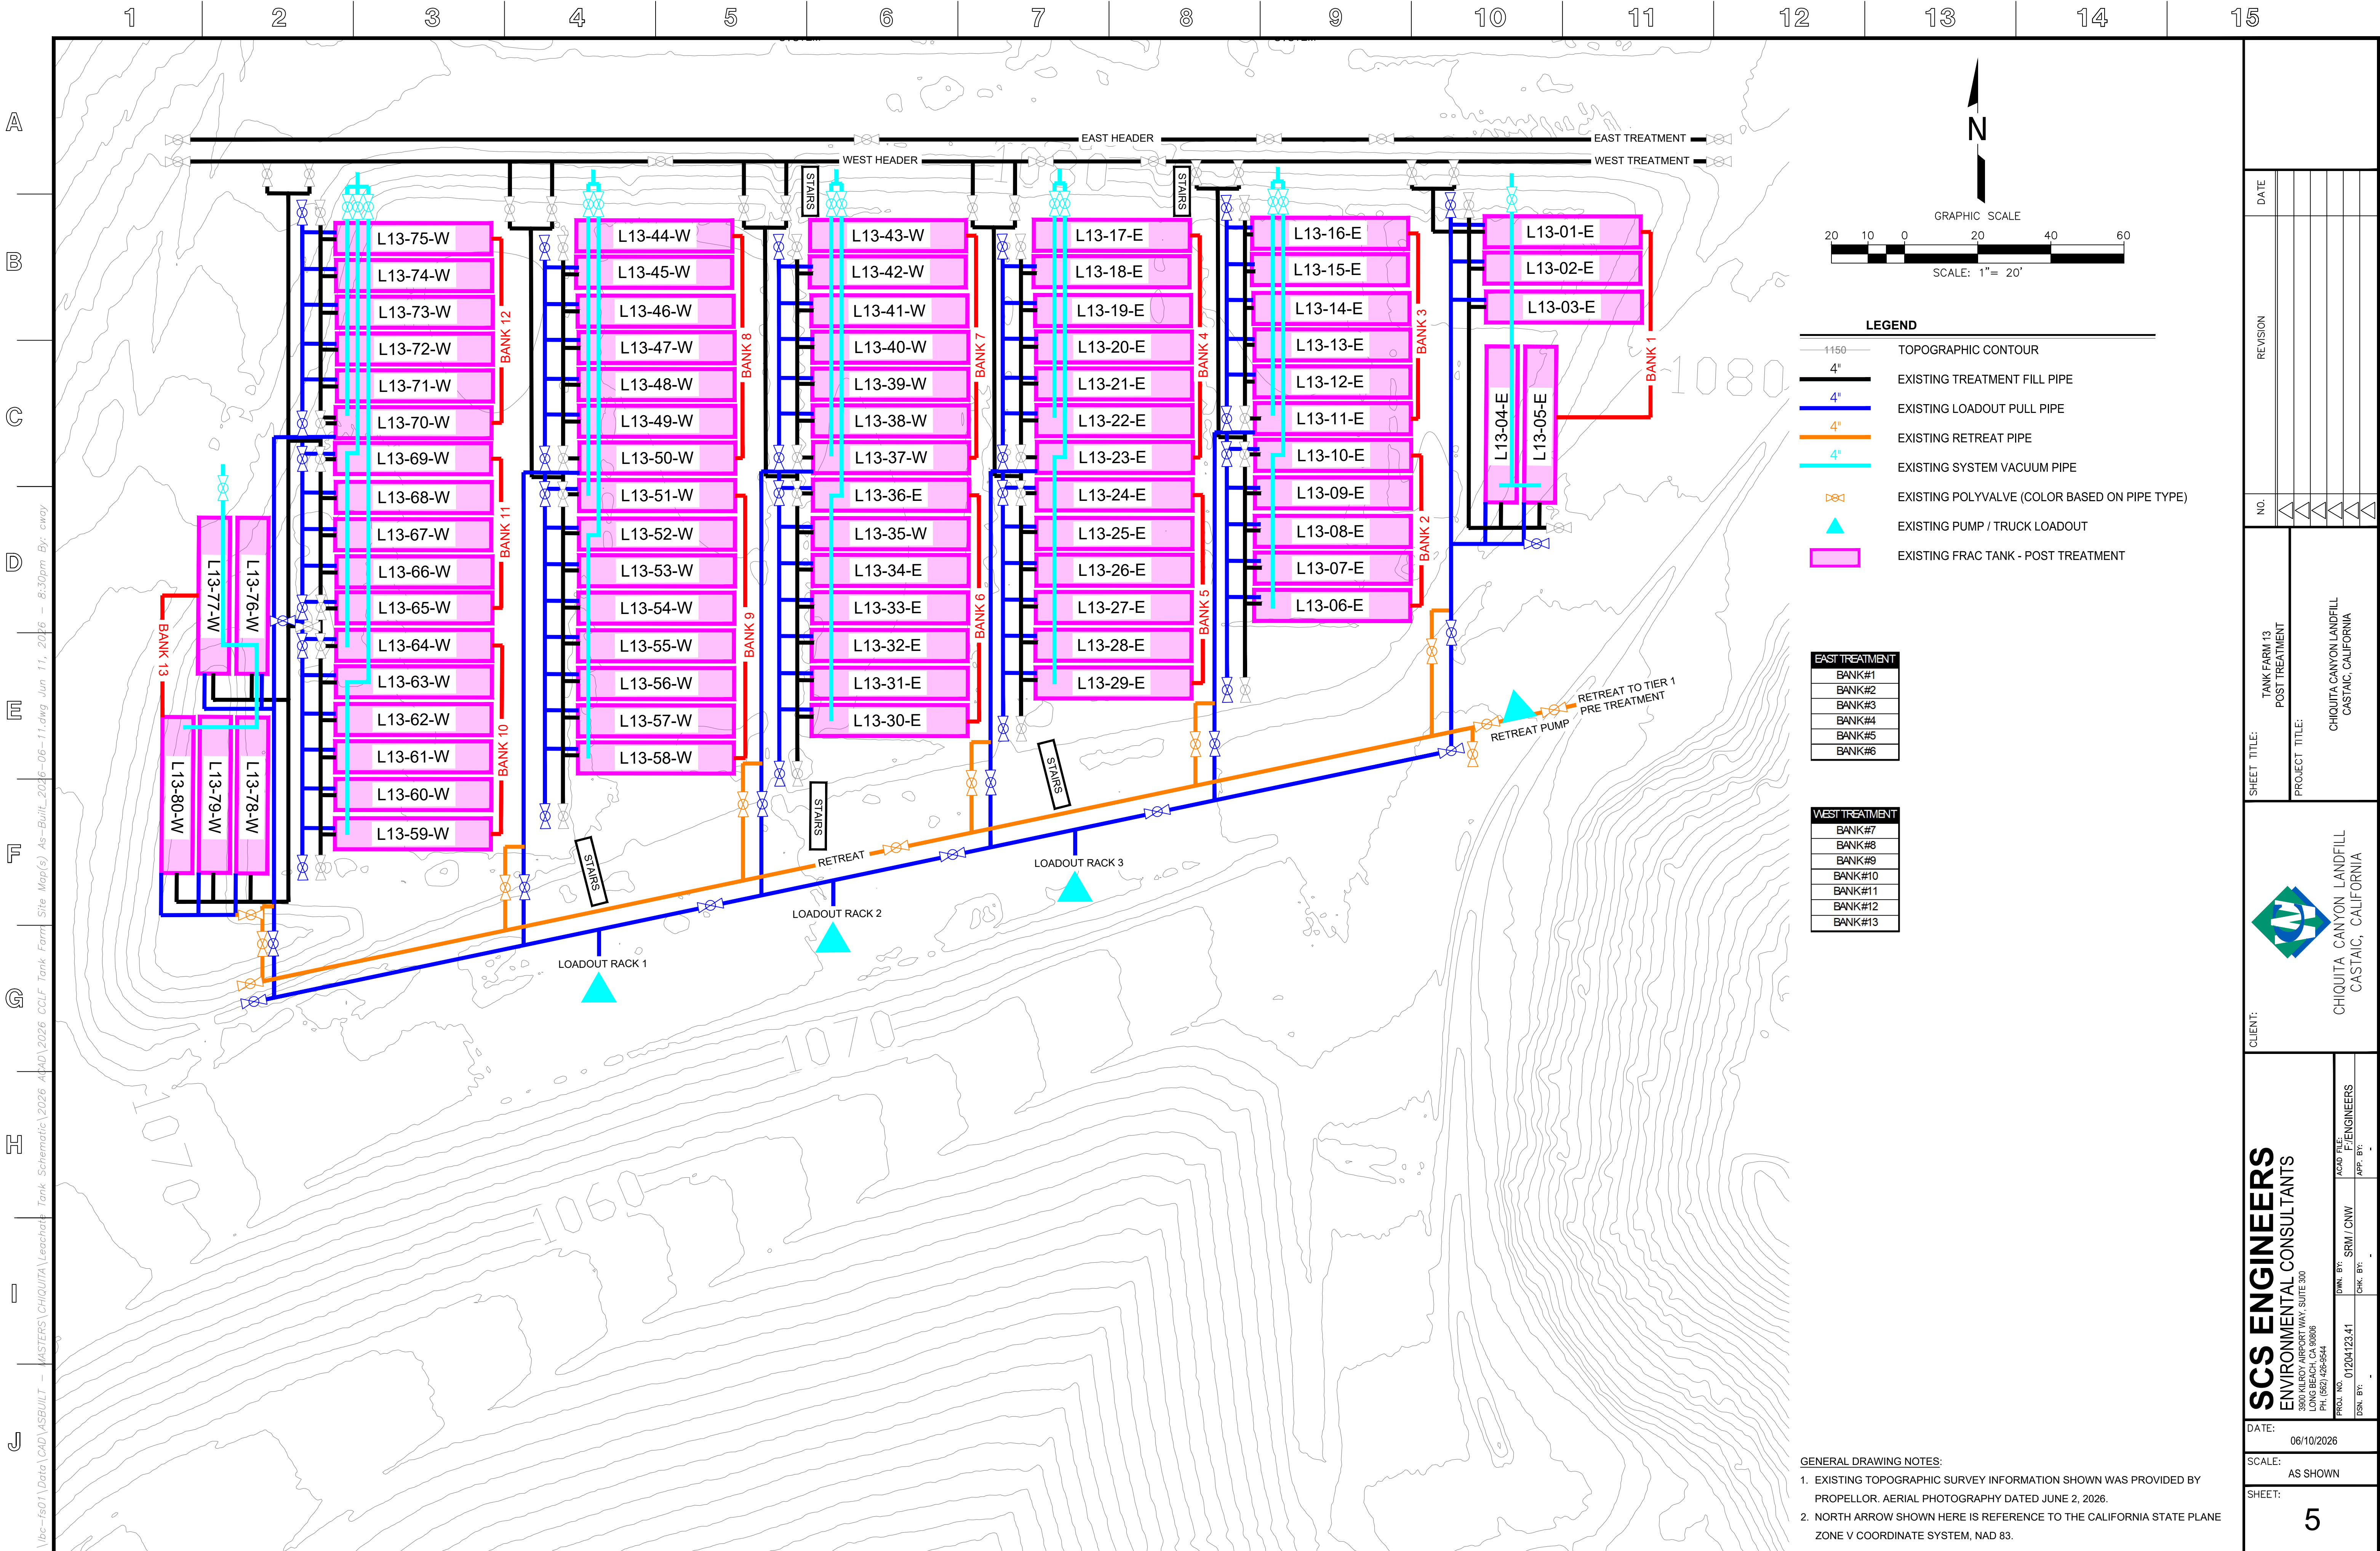

\\bc-fs01\\Data\\CAD\\ASBUILT - MASTERS\\CHIQUITA\\Leachate Tank Farm\\Site Map(s) As-Built_2026-06-11.dwg Jun 11, 2026 - 8:30pm By: cway

DATE	
REVISION	
NO.	
SHEET TITLE: TANK FARM 13 POST TREATMENT	
PROJECT TITLE: CHIQUITA CANYON LANDFILL CASTAIC, CALIFORNIA	
CLIENT: CHIQUITA CANYON LANDFILL CASTAIC, CALIFORNIA	
SCS ENGINEERS ENVIRONMENTAL CONSULTANTS 1800 ALABAMA AVE. SUITE 300 LONG BEACH, CA 90806 PH: (562) 426-9544	
DATE: 06/10/2026	SCALE: AS SHOWN
SHEET: 5	