



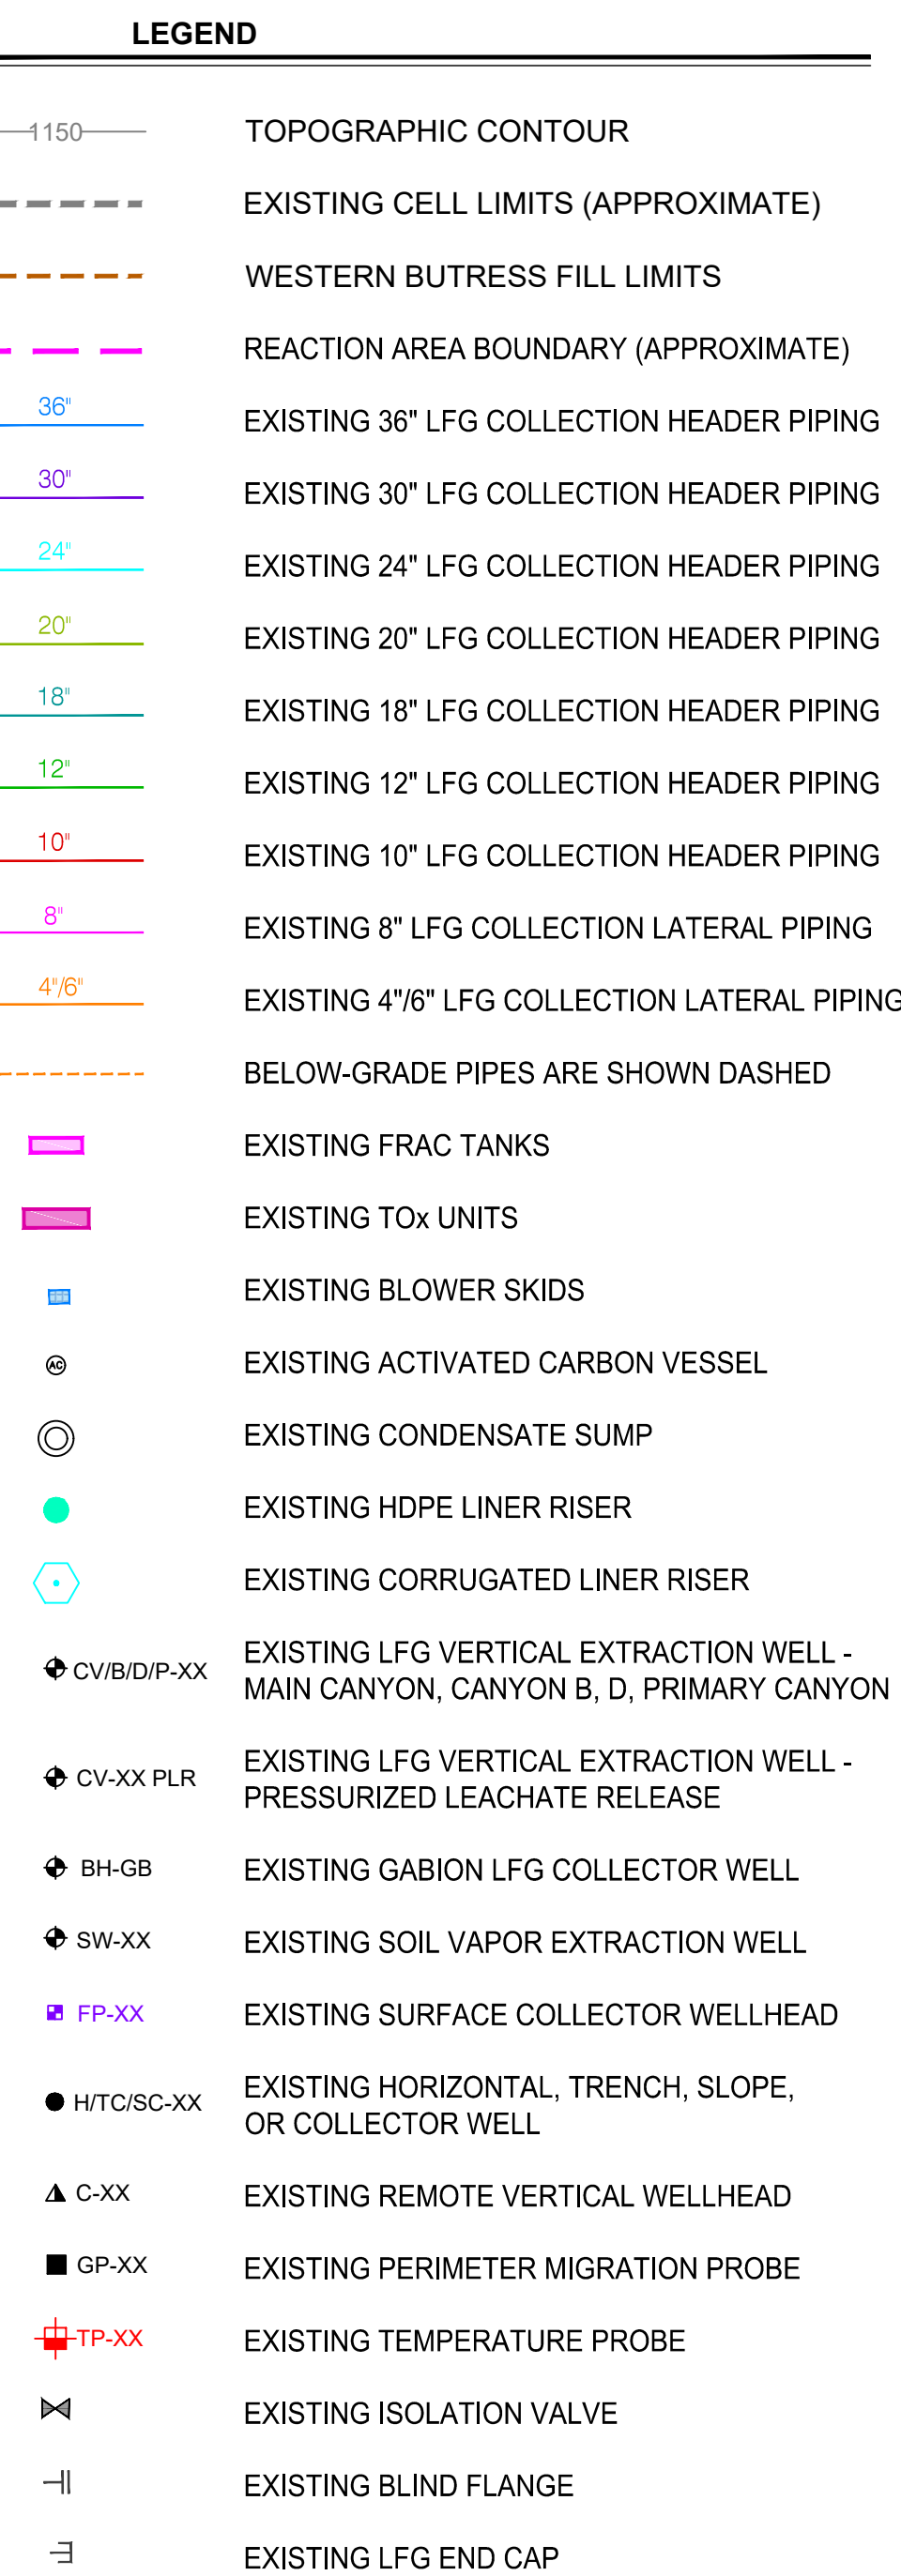

GENERAL DRAWING NOTES:

1. EXISTING GGCS AS-BUILT DATED SEPTEMBER 22, 2026.
2. EXISTING TOPOGRAPHIC SURVEY INFORMATION SHOWN WAS PROVIDED BY PROPPELLER DATED SEPTEMBER 16, 2026.
3. APPROXIMATE REACTION MITIGATION AREA BOUNDARY ADJUSTMENTS DATED SEPTEMBER 10, 2026, BASED ON AUGUST 2026 WELLFIELD DATA, PER SOFA CONDITION 8(g) AS DEFINED IN 9A.
4. NORTH ARROW SHOWN HERE IS REFERENCE TO THE CALIFORNIA STATE PLANE ZONE V COORDINATE SYSTEM, NAD 83.
5. THE LOCATION OF ANY EXISTING PILING, VALVES, TIE-IN LOCATIONS AND OTHER FEATURES ARE APPROXIMATE AND SHOULD BE USED FOR INFORMATIONAL PURPOSES ONLY. ACTUAL FIELD CONDITIONS MAY VARY AND ARE SUBJECT TO CHANGE BASED ON TOPOGRAPHIC FEATURES AND SITE-SPECIFIC FACTORS.

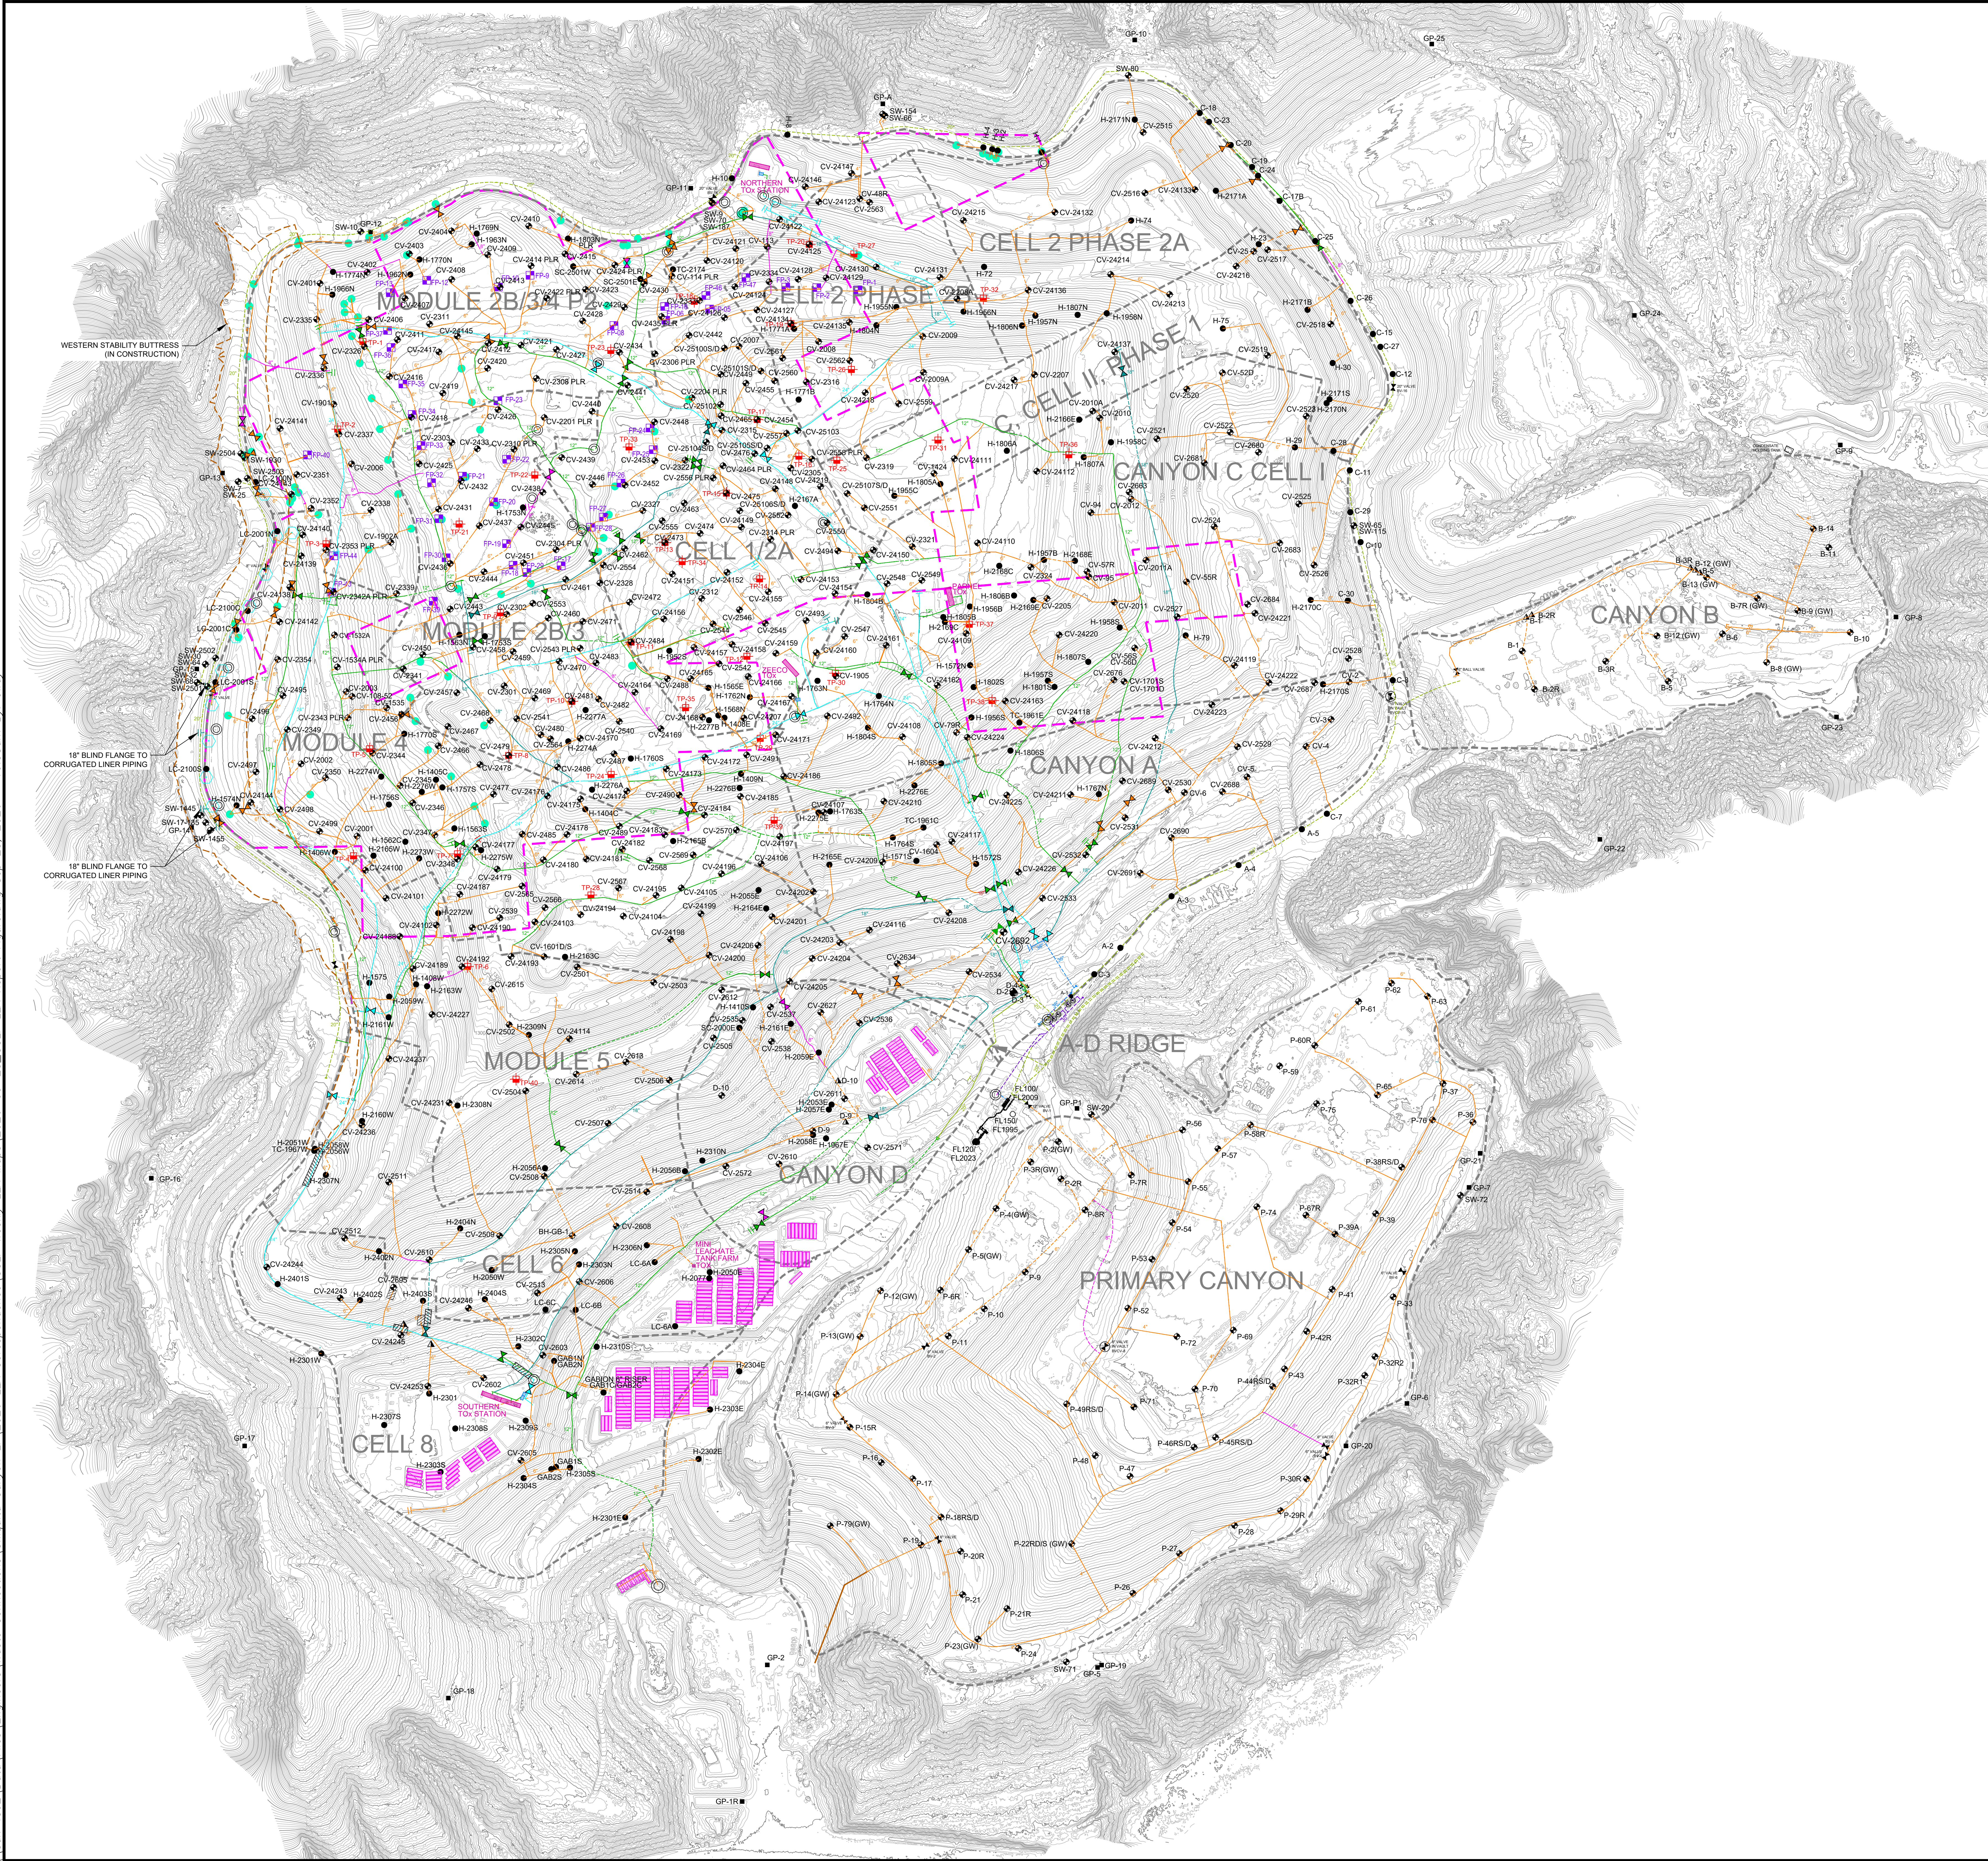

CANYON LANDFILL
WIC, CALIFORNIA