


**Archived:** Wednesday, February 11, 2026 1:47:20 PM  
**From:** [Han, Jessie](#)  
**Sent:** Friday, February 6, 2026 5:58:39 PM  
**To:** [bchen@aqmd.gov](mailto:bchen@aqmd.gov)  
**Cc:** [Haley, William \(Bill\)](#)  
**Subject:** RE: Case No. 6177-4 Stipulated Order for Abatement - Weekly Pump Installation and operation update  
**Importance:** Normal  
**Sensitivity:** None  
**Attachments:** [2026 CCLF Existing De-Watering Well with Pump Map\\_2026-02-06.pdf](#) 

---

[EXTERNAL SENDER: Use caution with links/attachments]

---

All,

In accordance with Condition 65 of the Modified Stipulated Order, below is the summary of the installation and operation of dewatering pumps for the Chiquita Canyon Landfill. This information is subject to change based on further review and verification.

During 01/30/2026 to 02/05/2026, Chiquita completed the installation of, and began operating during the day, three (3) pumps in a vertical LFG extraction well for a total of one hundred and fifty-five (155) pumps operating in vertical LFG extraction wells. Additionally, one (1) pump was taken offline last week, and five (5) new pumps became operational, leading to a net increase of seven (7) pumps. Please refer to the attached, up-to-date map of LFG wells with operating pumps.

During 02/06/2026 to 02/12/2026, given the number of dewatering pumps installed to date, and the maintenance associated with those pumps, Chiquita plans to install and begin operating an additional two (2) pumps in vertical LFG extraction wells in locations along the north and south slope of the reaction area. The pump installation locations for next week are subject to change due to weather and/or safety conditions.


Jessie Han  
Project Manager  
**SCS Engineers**  
3900 Kilroy Airport Way, Suite 300  
Long Beach, CA 90806  
Mobile: 562-508-2497  
[JHan@scsengineers.com](mailto:JHan@scsengineers.com)

**Driven by Client Success**  
[www.scsengineers.com](http://www.scsengineers.com)

**GENERAL DRAWING NOTES:**

- EXISTING TOPOGRAPHIC SURVEY INFORMATION SHOWN WAS PROVIDED BY PROPELLOR. AERIAL PHOTOGRAPHY DATED FEBRUARY 04, 2026.
- NORTH ARROW SHOWN HERE IS REFERENCE TO THE CALIFORNIA STATE PLANE ZONE V COORDINATE SYSTEM, NAD 83.
- THE LOCATION OF ANY EXISTING GCCS COMPONENTS AND OTHER FEATURES ARE APPROXIMATE AND SHOULD BE USED FOR INFORMATION PURPOSES ONLY.
- EXISTING GCCS AS-BUILT DATED FEBRUARY 06, 2026.

#	Well ID	Operational Startup Date
1	CV-2314	3/27/2024
2	CV-2315	4/10/2024
3	CV-2007	4/19/2024
4	CV-2336	4/19/2024
5	CV-2337	4/22/2024
6	CV-2332	4/26/2024
7	CV-2328	4/26/2024
8	CV-2326	4/30/2024
9	CV-2424	5/16/2024
10	CV-2414-PLR	5/23/2024
11	CV-24127	5/23/2024
12	CV-2496	5/30/2024
13	CV-2497	5/30/2024
14	CV-2498	5/31/2024
15	CV-24102	5/31/2024
16	CV-2411	6/24/2024
17	CV-2419	6/26/2024
18	CV-24109	7/3/2024
19	CV-24162	7/7/2024
20	CV-24101	7/8/2024
21	CV-2343-PLR	7/18/2024
22	CV-2495	7/18/2024
23	CV-2498	7/18/2024
24	CV-2348	7/22/2024
25	CV-2407	7/23/2024
26	CV-2347	7/24/2024
27	CV-2346	7/25/2024
28	CV-2345	7/27/2024
29	CV-2417	8/13/2024
30	CV-2418	8/14/2024
31	CV-2477	8/14/2024
32	CV-2341	8/15/2024
33	CV-2496	8/19/2024
34	CV-24121	8/19/2024
35	CV-2494	8/24/2024
36	CV-2423	8/26/2024
37	CV-2430	8/26/2024
38	CV-2409	8/26/2024
39	CV-24125	8/30/2024
40	CV-24129	8/30/2024
41	CV-24131	8/30/2024
42	CV-2349	8/4/2024
43	CV-2478	8/4/2024
44	CV-24108	8/4/2024
45	CV-2482	8/6/2024
46	CV-2493	8/10/2024
47	CV-24210	8/10/2024
48	CV-2495	8/10/2024
49	CV-2474	8/19/2024
50	CV-2497	11/26/2025
51	CV-2413	9/10/2025
52	CV-2442	12/21/2024
53	CV-2452	12/22/2024
54	CV-2451	12/23/2024
55	CV-2471	12/24/2024
56	CV-2445	1/6/2025
57	CV-2463	1/15/2025
58	CV-2490	1/17/2025
59	CV-2493	1/28/2025
60	CV-2334	1/22/2025
61	CV-2001	1/23/2025
62	CV-2479	1/28/2025
63	CV-2453	1/28/2025
64	CV-24206	1/29/2025
65	CV-2470	2/4/2025
66	CV-2450	2/5/2025
67	CV-2338	2/6/2025
68	CV-24202	2/20/2025
69	CV-1532A	2/28/2025
70	CV-24209	2/28/2025
71	CV-2455	3/11/2025
72	CV-24197	3/11/2025
73	CV-2412	3/25/2025
74	CV-24134	4/9/2025
75	CV-2495	4/11/2025
76	CV-24174	4/15/2025
77	CV-24154	4/17/2025
78	CV-2208A	5/22/2025
79	CV-24158	5/22/2025
80	CV-24214	5/2/2025
81	CV-2493	5/6/2025
82	CV-24160	5/6/2025
83	CV-2344	5/6/2025
84	CV-2492	5/7/2025
85	CV-24161	5/8/2025
86	CV-24167	5/8/2025
87	CV-2422	5/8/2025
88	CV-2469	5/8/2025
89	CV-2469	5/9/2025
90	CV-24224	5/12/2025
91	CV-24117	5/13/2025
92	CV-24158	5/14/2025
93	CV-24119	5/14/2025
94	CV-24107	5/15/2025
95	CV-24211	5/15/2025
96	CV-24208	5/15/2025
97	CV-24205	5/20/2025
98	CV-2438	5/28/2025
99	CV-2496	5/28/2025
100	CV-2490	5/29/2025
101	CV-24203	6/5/2025
102	CV-24207	6/9/2025
103	CV-24225	6/9/2025
104	CV-24196	6/10/2025
105	CV-24222	6/10/2025
106	CV-24163	6/11/2025
107	CV-2439	6/12/2025
108	CV-24139	6/12/2025
109	CV-24140	6/14/2025
110	CV-2461	6/16/2025
111	CV-2444	6/23/2025
112	CV-2485	6/23/2025
113	CV-24213	7/9/2025
114	CV-24185	7/14/2025
115	CV-24138	7/28/2025
116	CV-2485	8/7/2025
117	CV-2491	8/7/2025
118	CV-24120	8/8/2025
119	CV-24178	8/8/2025
120	CV-24180	8/15/2025
121	CV-2489	8/4/2025
122	CV-2311	9/15/2025
123	CV-2426	9/18/2025
124	CV-2431	9/18/2025
125	CV-2425	9/22/2025
126	CV-2530	10/3/2025
127	CV-2303	10/9/2025
128	CV-24128	10/13/2025
129	CV-2532	10/17/2025
130	CV-2529	10/18/2025
131	CV-2433	10/28/2025
132	CV-2010A	11/24/2025
133	CV-2011A	11/24/2025
134	CV-24215	11/24/2025
135	CV-2484	11/25/2025
136	CV-2434	1/25/2026
137	CV-24164	1/21/2026
138	CV-24156	12/17/2025
139	CV-24157	12/18/2025
140	CV-24158	12/19/2025
141	CV-24152	12/22/2025
142	CV-2551	12/30/2025
143	CV-2556	12/30/2025
144	CV-25107D	12/30/2025
145	CV-2418	12/31/2025
146	CV-2448	1/5/2026
147	CV-2557	1/5/2026
148	CV-2558	1/5/2026
149	CV-2467	2/3/2026
150	CV-2440	2/3/2026
151	CV-24148	2/4/2026
152	CV-24153	2/4/2026
153	CV-24155	2/4/2026
154	CV-24170	2/4/2026
155	CV-2446	2/5/2026

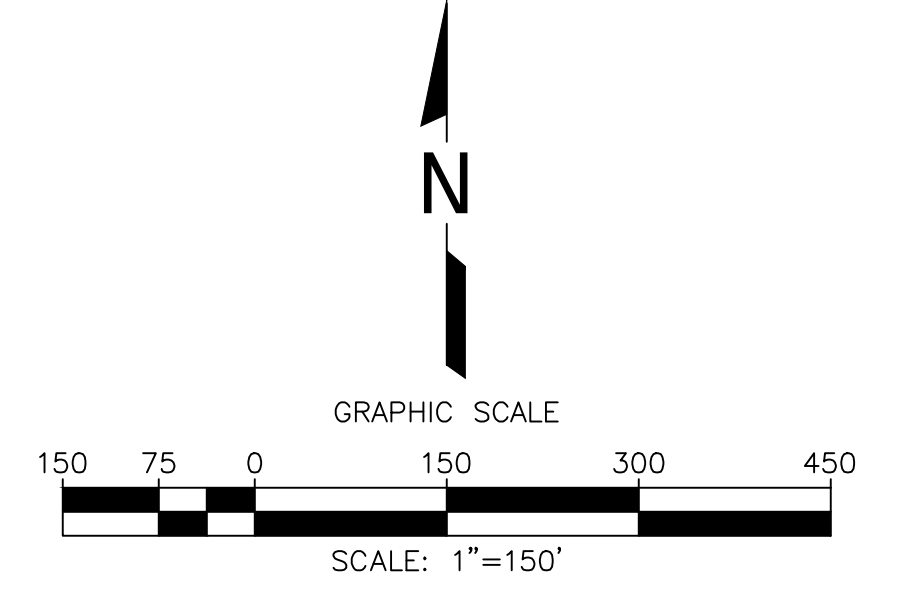

- LEGEND**
- 1150 TOPOGRAPHIC CONTOUR
  - EXISTING CELL LIMITS (APPROXIMATE)
  - REACTION AREA BOUNDARY - CONDITION 9A
  - REACTION AREA BOUNDARY - DATA ANALYSIS
  - ⊕ CV-XX EXISTING VERTICAL LFG EXTRACTION WELL
  - ⊕ CV-XX-PLR EXISTING LFG VERTICAL EXTRACTION WELL - PRESSURIZED LEACHATE RELEASE
  - ⊙ EXISTING CONDENSATE SUMP WITH PUMP
  - ▲ EXISTING DE-WATERING WELL WITH PUMP - CURRENTLY RUNNING
  - ▲ EXISTING DE-WATERING WELL WITH PUMP - INSTALLED

#	Well ID
1	CV-114
2	CV-2205
3	CV-2301
4	CV-2305
5	CV-2306
6	CV-2315
7	CV-2319
8	CV-2333
9	CV-2344
10	CV-2416
11	CV-2432
12	CV-2436
13	CV-2443
14	CV-2453
15	CV-2457
16	CV-2462
17	CV-2465
18	CV-2472
19	CV-2473
20	CV-2475
21	CV-2487
22	CV-2499
23	CV-24100
24	CV-24110
25	CV-24111
26	CV-24150
28	CV-24165
29	CV-24168
30	CV-24173
31	CV-24175
32	CV-24212
33	CV-24219
34	CV-2533
35	CV-2458

\\lb-iso1\Data\CAD\ASBUILT - MASTERS\CHIQUITA GCCS\226 ACAD\2026 CCLF Existing De-Watering Well with Pump Map\_2026-02-06.lwg Feb 06, 2026 - 7:44pm By: ekarom

Zone Description	De-Watering Pumps			
	Total	Operational	Non-Operational	Pending Installation
Within Condition 9A Boundary	142	113	29	34
Outside of Condition 9A Boundary	48	42	6	7
Combined (Both Areas)	190	155	35	41
Condensate Sump	50	48	2	14

DATE:	02/06/2026					
SCALE:	AS SHOWN					
SHEET:	1					
CLIENT: CHIQUITA CANYON LANDFILL CASTAIC, CALIFORNIA						
PROJECT TITLE: CHIQUITA CANYON LANDFILL CASTAIC, CALIFORNIA						
SHEET TITLE: EXISTING DE-WATERING WELL WITH PUMP MAP						
NO.	<table border="1" style="width: 100%;"> <tr><td> </td><td> </td><td> </td><td> </td><td> </td></tr> </table>					
AGAP FILE:	N:\CAD\ASBUILT-MASTERS					
APP. BY:	AEK					
CHK. BY:	AEK					
DRN. BY:	AEK					
PROJ. NO:	01204123.41					