

**From:** Medina, Steven <SMedina@scsengineers.com>  
**Sent:** Friday, February 13, 2026 4:55 PM  
**To:** bchen@aqmd.gov; ndickel@aqmd.gov; Christina Ojeda  
**Cc:** Han, Jessie; Haley, William (Bill); Christopher.Fear@WasteConnections.com; Viswanathan, Srividhya; Mark.Adams; Dylan Smith; Sarah Phillips  
**Subject:** Re: Case No. 6177-4 Stipulated Order for Abatement - Weekly Pump Installation and operation update  
**Attachments:** 2026 CCLF Existing De-Watering Well with Pump Map\_2026-02-13.pdf

[EXTERNAL SENDER: Use caution with links/attachments]

---

All,

In accordance with Condition 65 of the Modified Stipulated Order, below is the summary of the installation and operation of dewatering pumps for the Chiquita Canyon Landfill. This information is subject to change based on further review and verification.

During 02/06/2026 to 02/12/2026, Chiquita completed the installation of, and began operating during the day, sixteen (16) pumps in a vertical LFG extraction well for a total of one hundred and thirty-eight (138) pumps operating in vertical LFG extraction wells. Additionally, thirty-three (33) pumps were taken offline last week, and sixteen (16) new pumps became operational, leading to a net decrease of seventeen (17) pumps. Please refer to the attached, up-to-date map of LFG wells with operating pumps. The number of pumps installed and taken offline was higher than usual due to the ongoing EVOH liner deployment and a communication issue affecting the Lorentz pump telemetry data.

During 02/13/2026 to 02/19/2026, given the number of dewatering pumps installed to date, and the maintenance associated with those pumps, Chiquita plans to install and begin operating an additional five (5) pumps in vertical LFG extraction wells in locations along the north and south slope of the reaction area. The pump installation locations for next week are subject to change due to weather and/or safety conditions.

Regards,

**STEVEN** Ruben Medina, **E.I.T.**

Staff Professional

**SCS Engineers**

3900 Kilroy Airport Way, Suite 300

Long Beach, CA 90806


858-204-4342 (c)

[SMedina@scsengineers.com](mailto:SMedina@scsengineers.com)

**Driven by Client Success**


[www.scsengineers.com](http://www.scsengineers.com)

*2024 Conrad Quality Focus  
Award Recipient*

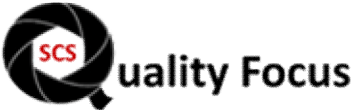

**GENERAL DRAWING NOTES:**

- EXISTING TOPOGRAPHIC SURVEY INFORMATION SHOWN WAS PROVIDED BY PROPELLOR. AERIAL PHOTOGRAPHY DATED FEBRUARY 04, 2026.
- NORTH ARROW SHOWN HERE IS REFERENCE TO THE CALIFORNIA STATE PLANE ZONE V COORDINATE SYSTEM, NAD 83.
- THE LOCATION OF ANY EXISTING GCCS COMPONENTS AND OTHER FEATURES ARE APPROXIMATE AND SHOULD BE USED FOR INFORMATION PURPOSES ONLY.
- EXISTING GCCS AS-BUILT DATED FEBRUARY 06, 2026.

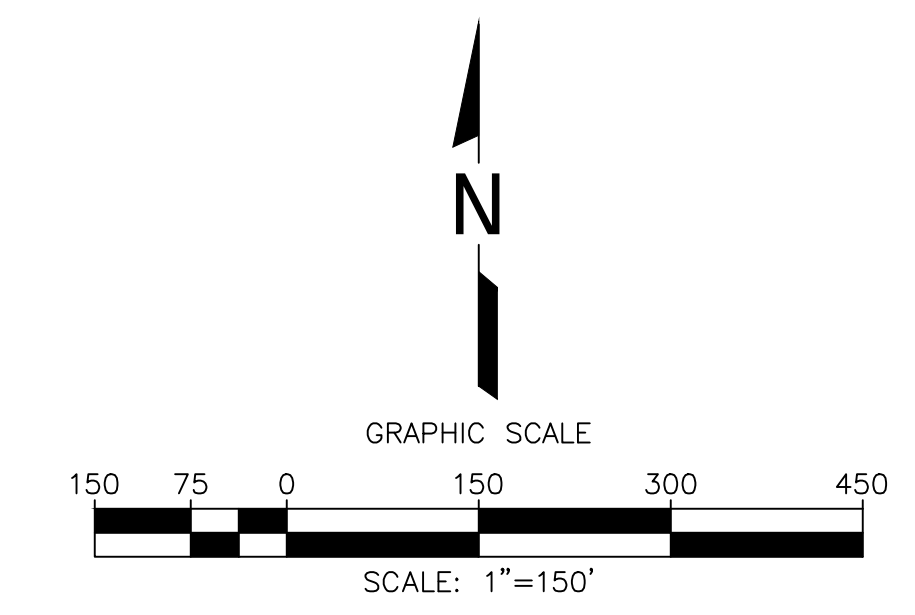

- LEGEND**
- 1150 TOPOGRAPHIC CONTOUR
  - EXISTING CELL LIMITS (APPROXIMATE)
  - REACTION AREA BOUNDARY - CONDITION 9A
  - REACTION AREA BOUNDARY - DATA ANALYSIS
  - ⊕ CV-XX EXISTING VERTICAL LFG EXTRACTION WELL
  - ⊕ CV-XX PLR EXISTING LFG VERTICAL EXTRACTION WELL - PRESSURIZED LEACHATE RELEASE
  - ⊙ EXISTING CONDENSATE SUMP WITH PUMP
  - ▲ EXISTING DE-WATERING WELL WITH PUMP - CURRENTLY RUNNING
  - ▲ EXISTING DE-WATERING WELL WITH PUMP - INSTALLED

De-Watering Well Pumps that are Currently Running		
#	Well ID	Operational Startup Date
1	CV-2314	3/27/2024
2	CV-2007	4/19/2024
3	CV-2336	4/19/2024
4	CV-2337	4/22/2024
5	CV-2302	4/26/2024
6	CV-2328	4/26/2024
7	CV-24144	5/13/2024
8	CV-2414.PLR	5/23/2024
9	CV-24127	5/23/2024
10	CV-2486	5/30/2024
11	CV-2487	5/30/2024
12	CV-2408	5/31/2024
13	CV-24102	5/31/2024
14	CV-24109	7/3/2024
15	CV-24162	7/7/2024
16	CV-24101	7/8/2024
17	CV-24100	7/17/2024
18	CV-2315	7/18/2024
19	CV-2343.PLR	7/18/2024
20	CV-2406	7/18/2024
21	CV-2498	7/18/2024
22	CV-2348	7/22/2024
23	CV-2407	7/23/2024
24	CV-2347	7/24/2024
25	CV-2346	7/25/2024
26	CV-2345	7/27/2024
27	CV-2344	7/30/2024
28	CV-2418	8/14/2024
29	CV-2477	8/14/2024
30	CV-2341	8/15/2024
31	CV-2466	8/19/2024
32	CV-24121	8/19/2024
33	CV-2423	8/26/2024
34	CV-2430	8/26/2024
35	CV-2459	8/30/2024
36	CV-24125	8/30/2024
37	CV-24129	8/30/2024
38	CV-24131	8/30/2024
39	CV-2478	9/4/2024
40	CV-24108	9/4/2024
41	CV-24210	9/10/2024
42	CV-2420	9/10/2024
43	CV-2446	12/13/2024
44	CV-2442	12/21/2024
45	CV-2452	12/22/2024
46	CV-2471	12/24/2024
47	CV-24212	1/10/2025
48	CV-2469	1/17/2025
49	CV-2459	1/21/2025
50	CV-2334	1/22/2025
51	CV-2001	1/23/2025
52	CV-2483	1/29/2025
53	CV-24206	1/29/2025
54	CV-2470	2/4/2025
55	CV-2459	2/5/2025
56	CV-2338	2/8/2025
57	CV-2457	2/11/2025
58	CV-24202	2/20/2025
59	CV-1532A	2/28/2025
60	CV-24209	2/28/2025
61	CV-24197	3/11/2025
62	CV-2412	3/25/2025
63	CV-24135	4/11/2025
64	CV-24174	4/15/2025
65	CV-24173	4/15/2025
66	CV-24154	4/17/2025
67	CV-2208A	5/2/2025
68	CV-24136	5/2/2025
69	CV-24214	5/2/2025
70	CV-2493	5/6/2025
71	CV-24160	5/6/2025
72	CV-2354	5/6/2025
73	CV-2492	5/7/2025
74	CV-24161	5/8/2025
75	CV-24167	5/8/2025
76	CV-24170	5/8/2025
77	CV-2468	5/9/2025
78	CV-2469	5/9/2025
79	CV-24224	5/12/2025
80	CV-24117	5/13/2025
81	CV-24116	5/14/2025
82	CV-24119	5/14/2025
83	CV-24107	5/15/2025
84	CV-24211	5/15/2025
85	CV-24208	5/16/2025
86	CV-24205	5/20/2025
87	CV-2421	5/27/2025
88	CV-2456	5/29/2025
89	CV-2490	6/5/2025
90	CV-24203	6/5/2025
91	CV-24207	6/9/2025
92	CV-24225	6/9/2025
93	CV-24186	6/10/2025
94	CV-24222	6/10/2025
95	CV-24163	6/11/2025
96	CV-24143	6/12/2025
97	CV-24139	6/12/2025
98	CV-24140	6/14/2025
99	CV-2461	6/16/2025
100	CV-55R	6/23/2025
101	CV-24213	7/8/2025
102	CV-24185	7/14/2025
103	CV-24138	7/28/2025
104	CV-2485	8/7/2025
105	CV-24120	8/8/2025
106	CV-24178	8/8/2025
107	CV-24179	8/9/2025
108	CV-24180	8/15/2025
109	CV-2489	9/4/2025
110	CV-24148	9/5/2025
111	CV-2311	9/15/2025
112	CV-2440	9/15/2025
113	CV-2350	10/3/2025
114	CV-24128	10/13/2025
115	CV-2532	10/17/2025
116	CV-2529	10/18/2025
117	CV-2010A	11/24/2025
118	CV-2011A	11/24/2025
119	CV-24215	11/24/2025
120	CV-2484	11/25/2025
121	CV-2434	12/5/2025
122	CV-24164	12/11/2025
123	CV-24156	12/17/2025
124	CV-24157	12/18/2025
125	CV-24158	12/19/2025
126	CV-24152	12/22/2025
127	CV-2556	12/30/2025
128	CV-2557	1/5/2026
129	CV-2558	1/5/2026
130	CV-24153	1/5/2026
131	CV-2351	1/23/2026
132	CV-24141	1/23/2026
133	CV-2352	1/26/2026
134	CV-2302	1/29/2026
135	CV-2467	2/3/2026
136	CV-24155	2/4/2026
137	CV-2339	2/12/2026
138	CV-24126	2/12/2026

De-Watering Well Pumps That Are Currently Installed and Not in Operation	
#	Well ID
1	CV-114
2	CV-2205
3	CV-2301
4	CV-2303
5	CV-2306
6	CV-2319
7	CV-2321
8	CV-2326
9	CV-2333
10	CV-2349
11	CV-2411
12	CV-2413
13	CV-2416
14	CV-2417
15	CV-2419
16	CV-2425
17	CV-2426
18	CV-2427
19	CV-2428
20	CV-2431
21	CV-2432
22	CV-2433
23	CV-2436
24	CV-2437
25	CV-2438
26	CV-2439
27	CV-2443
28	CV-2444
29	CV-2445
30	CV-2451
31	CV-2453
32	CV-2455
33	CV-2458
34	CV-2462
35	CV-2463
36	CV-2465
37	CV-2472
38	CV-2473
39	CV-2474
40	CV-2475
41	CV-2479
42	CV-2481
43	CV-2487
44	CV-2491
45	CV-2499
46	CV-24110
47	CV-24111
48	CV-24124
49	CV-24134
50	CV-24150
51	CV-24165
52	CV-24168
53	CV-24172
54	CV-24175
55	CV-2533

Zone Description	De-Watering Pumps			
	Total	Operational	Non-Operational	Pending Installation
Within Condition 9A Boundary	148	101	47	22
Outside of Condition 9A Boundary	45	37	8	6
Combined (Both Areas)	193	138	55	28
Condensate Sump	52	48	4	14

DATE:	
REVISION:	
NO.	
SHEET TITLE:	EXISTING DE-WATERING WELL WITH PUMP MAP
PROJECT TITLE:	CHIQUITA CANYON LANDFILL CASTAIC, CALIFORNIA
CLIENT:	CHIQUITA CANYON LANDFILL CASTAIC, CALIFORNIA
ACAD FILE:	N:\CAD\ASBUILT-MASTERS
APP. BY:	
CHK. BY:	AEK
DATE:	02/13/2026
SCALE:	AS SHOWN
SHEET:	1

N:\CAD\ASBUILT - MASTERS\CHIQUITA\GCCS\2026 ACAD\2026 CCL Existing De-Watering Well with Pump Map\_2026-02-13.dwg Feb 13, 2026 - 2:32pm Bv.smedino