


Archived: Thursday, February 26, 2026 9:28:35 AM
From: [Han, Jessie](#)
Sent: Friday, February 20, 2026 2:47:31 PM
To: bchen@aqmd.gov
Cc: [Haley, William \(Bill\)](#)
Subject: RE: Case No. 6177-4 Stipulated Order for Abatement - Weekly Pump Installation and operation update
Importance: Normal
Sensitivity: None
Attachments: [2026 CCLF Existing De-Watering Well with Pump Map_2026-02-20.pdf](#) 

[EXTERNAL SENDER: Use caution with links/attachments]

All,

In accordance with Condition 65 of the Modified Stipulated Order, below is the summary of the installation and operation of dewatering pumps for the Chiquita Canyon Landfill. This information is subject to change based on further review and verification.

During 02/13/2026 to 02/19/2026, Chiquita completed the installation of, and began operating during the day, zero (0) pumps in a vertical LFG extraction well for a total of eleven (11) pumps operating in vertical LFG extraction wells. Additionally, one hundred twenty-seven (127) pumps were taken offline last week, and zero (0) new pumps became operational, leading to a net decrease of one hundred twenty-seven (127) pumps. Please refer to the attached, up-to-date map of LFG wells with operating pumps. The number of pumps taken offline was higher than usual due to the ongoing EVOH liner deployment and a communication issue affecting the Lorentz pump telemetry data.

During 02/20/2026 to 02/26/2026, given the number of dewatering pumps installed to date, and the maintenance associated with those pumps, Chiquita plans to install and begin operating an additional five (5) pumps in vertical LFG extraction wells in locations along the north and south slope of the reaction area. Pump installation will resume once the existing pumps are turned back on, subject to disposal outlet capacity. The pump installation locations for next week are also subject to change due to weather and/or safety conditions.


Jessie Han
SCS Engineers
3900 Kilroy Airport Way, Suite 300
Long Beach, CA 90806
Mobile: 562-508-2497
JHan@scsengineers.com

Driven by Client Success
www.scsengineers.com

GENERAL DRAWING NOTES:

- EXISTING TOPOGRAPHIC SURVEY INFORMATION SHOWN WAS PROVIDED BY PROPELLOR. AERIAL PHOTOGRAPHY DATED FEBRUARY 04, 2026.
- NORTH ARROW SHOWN HERE IS REFERENCE TO THE CALIFORNIA STATE PLANE ZONE V COORDINATE SYSTEM, NAD 83.
- THE LOCATION OF ANY EXISTING GCCS COMPONENTS AND OTHER FEATURES ARE APPROXIMATE AND SHOULD BE USED FOR INFORMATION PURPOSES ONLY.
- EXISTING GCCS AS-BUILT DATED FEBRUARY 06, 2026.


#	Well ID	Operational Startup Date
1	CV-24144	5/13/2024
2	CV-2496	5/30/2024
3	CV-2497	5/30/2024
4	CV-24101	7/8/2024
5	CV-24100	7/17/2024
6	CV-2498	7/18/2024
7	CV-2354	5/6/2025
8	CV-24140	6/14/2025
9	CV-2351	1/23/2026
10	CV-24141	1/23/2026
11	CV-2352	1/26/2026

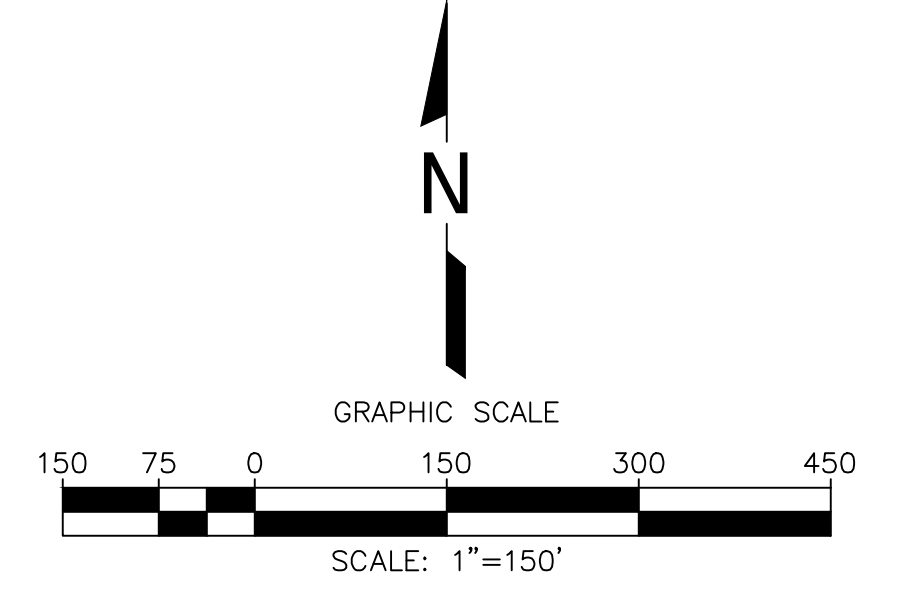

- LEGEND**
- 1150 TOPOGRAPHIC CONTOUR
 - EXISTING CELL LIMITS (APPROXIMATE)
 - REACTION AREA BOUNDARY - CONDITION 9A
 - REACTION AREA BOUNDARY - DATA ANALYSIS
 - ⊕ CV-XX EXISTING VERTICAL LFG EXTRACTION WELL
 - ⊕ CV-XX PLR EXISTING LFG VERTICAL EXTRACTION WELL - PRESSURIZED LEACHATE RELEASE
 - ⊙ EXISTING CONDENSATE SUMP WITH PUMP
 - ▲ EXISTING DE-WATERING WELL WITH PUMP - CURRENTLY RUNNING
 - ▲ EXISTING DE-WATERING WELL WITH PUMP - INSTALLED

De-Watering Well Pumps that are Currently Running

#	Well ID	Operational Startup Date
1	CV-24144	5/13/2024
2	CV-2496	5/30/2024
3	CV-2497	5/30/2024
4	CV-24101	7/8/2024
5	CV-24100	7/17/2024
6	CV-2498	7/18/2024
7	CV-2354	5/6/2025
8	CV-24140	6/14/2025
9	CV-2351	1/23/2026
10	CV-24141	1/23/2026
11	CV-2352	1/26/2026

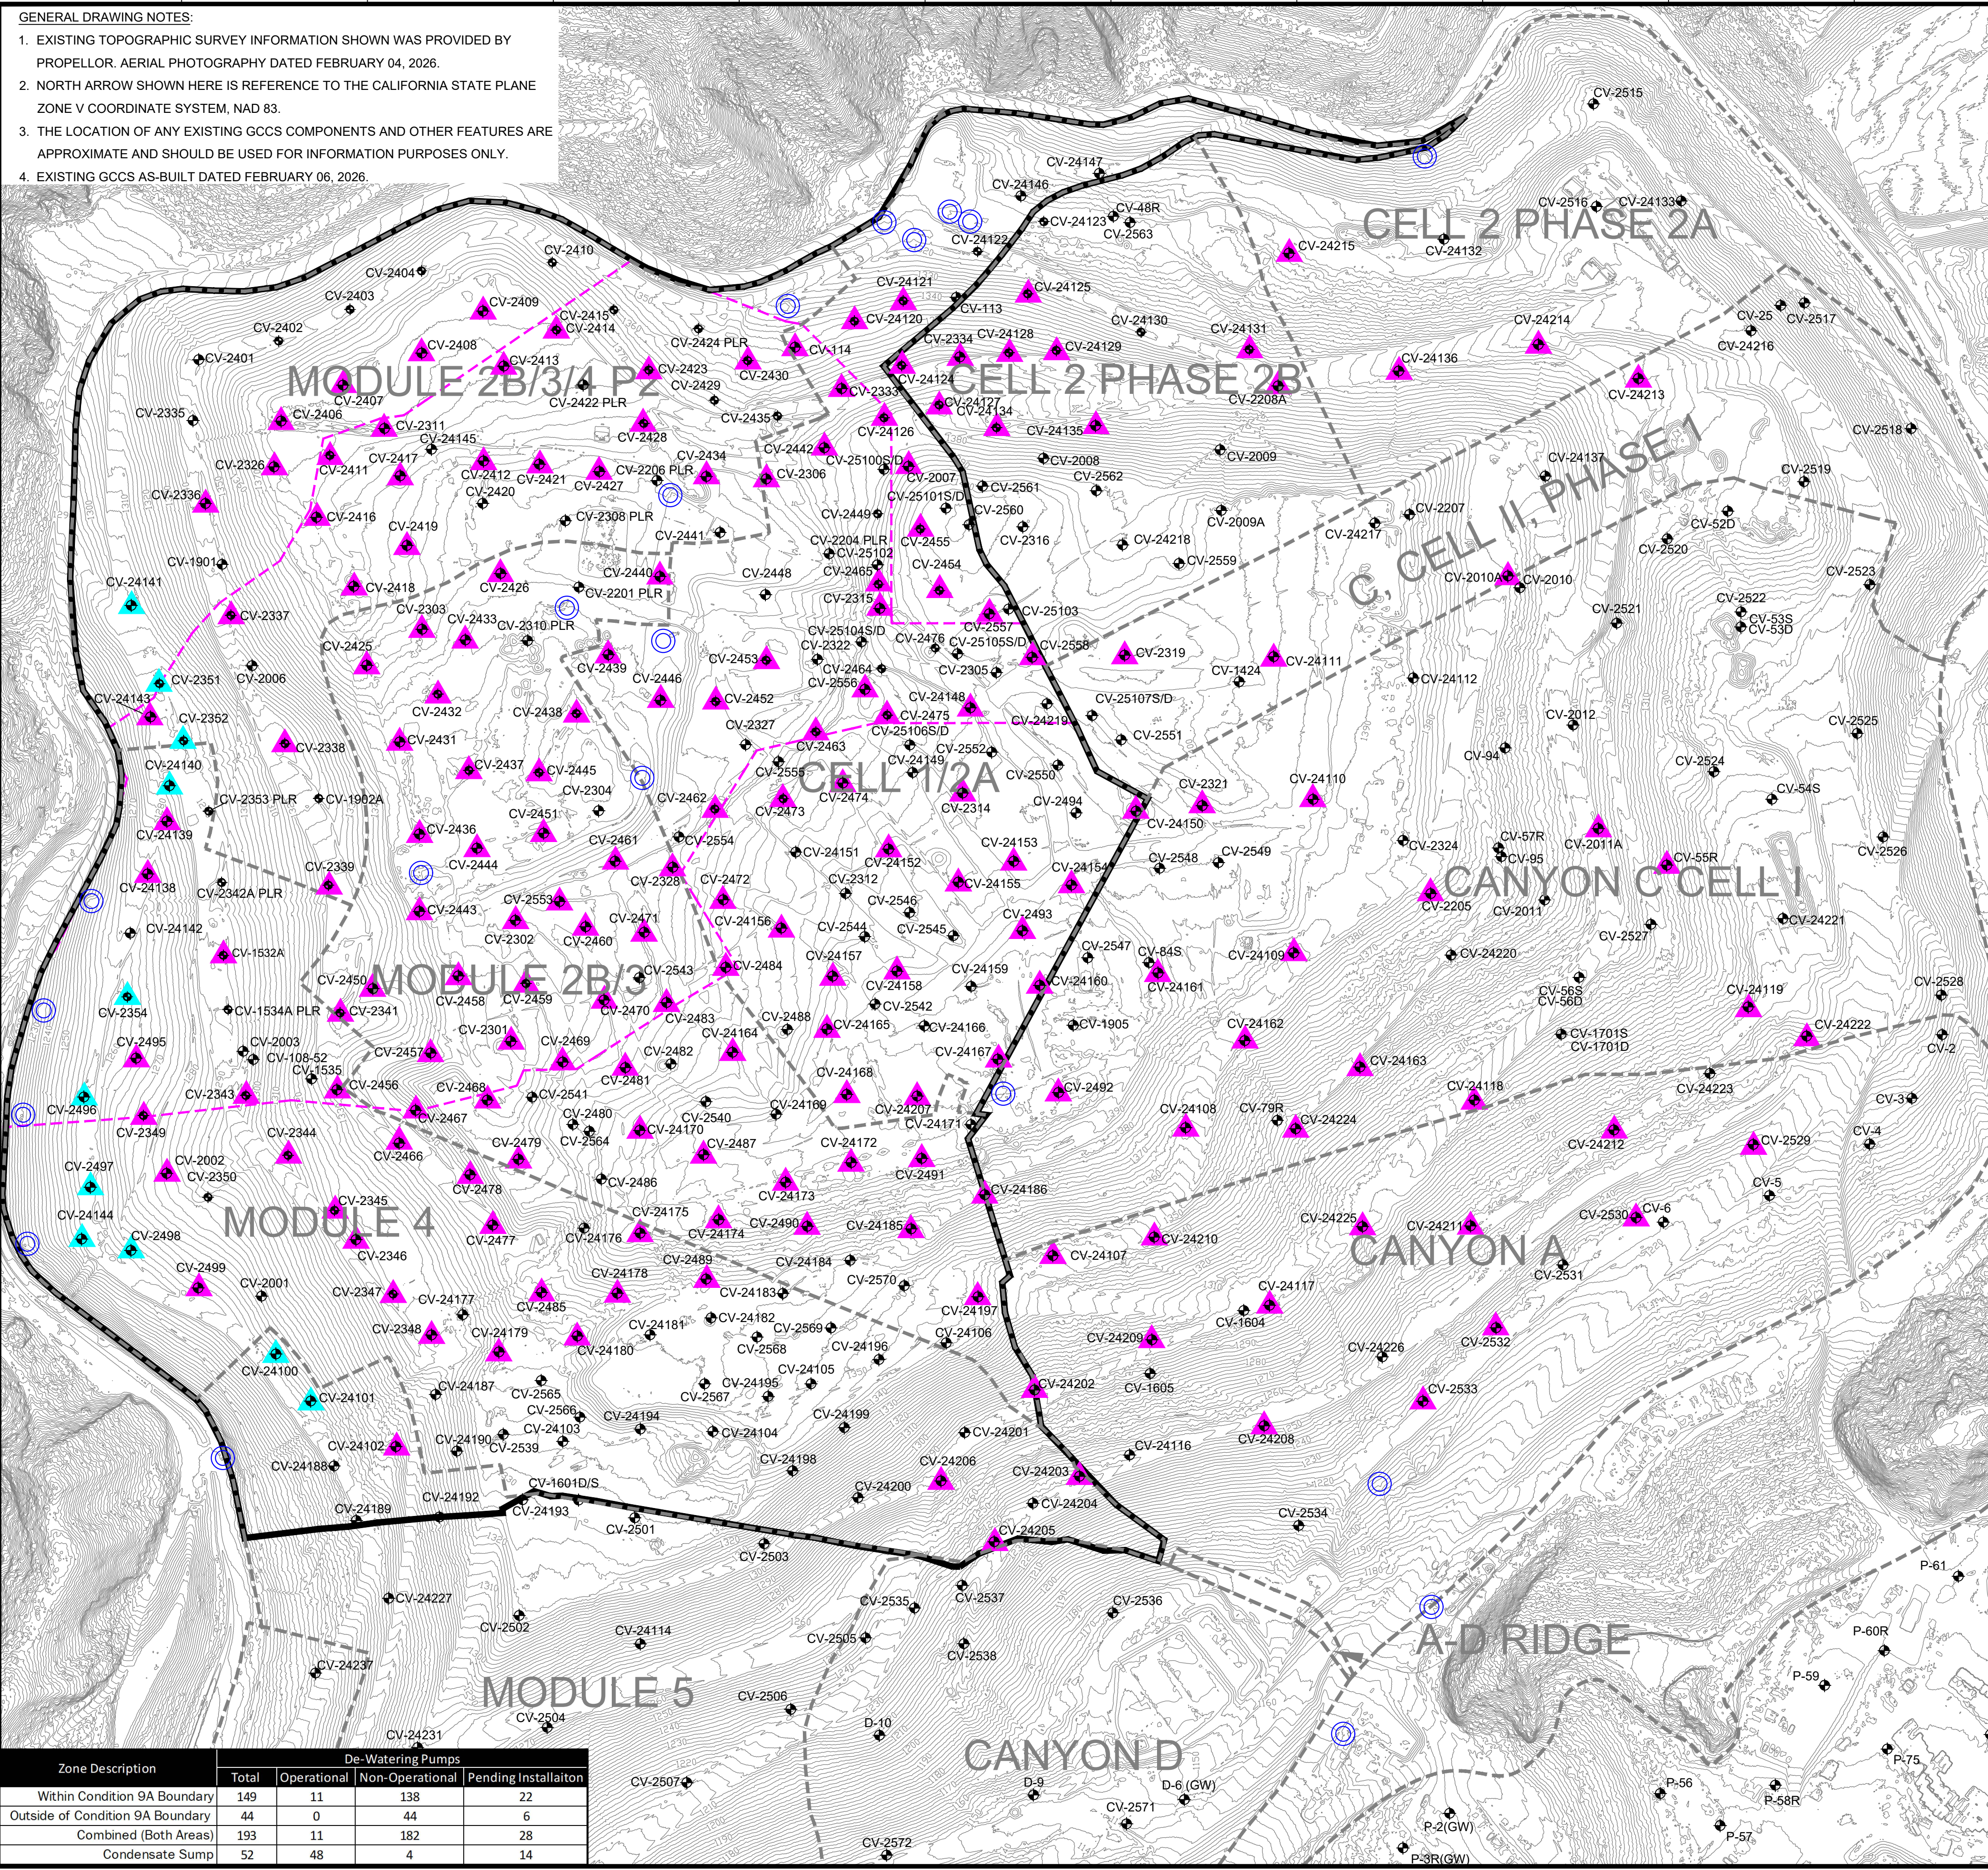

Zone Description	De-Watering Pumps			
	Total	Operational	Non-Operational	Pending Installation
Within Condition 9A Boundary	149	11	138	22
Outside of Condition 9A Boundary	44	0	44	6
Combined (Both Areas)	193	11	182	28
Condensate Sump	52	48	4	14

DATE:	
REVISION:	
NO.:	
SHEET TITLE:	EXISTING DE-WATERING WELL WITH PUMP MAP
PROJECT TITLE:	CHIQUITA CANYON LANDFILL CASTAIC, CALIFORNIA
CLIENT:	CHIQUITA CANYON LANDFILL CASTAIC, CALIFORNIA
ACAD FILE:	N:\CAD\ASBUILT-MASTERS
APP. BY:	
DATE:	02/20/2026
SCALE:	AS SHOWN
SHEET:	1

N:\CAD\ASBUILT - MASTERS\CHIQUITA\GCCS\2026 ACAD\2026 CCL Existing De-Watering Well with Pump Map_2026-02-20.dwg Feb 19, 2026 - 4:14pm By: srieding