

From: Medina, Steven <SMedina@scsengineers.com>
Sent: Friday, February 27, 2026 5:34 PM
To: BChen@aqmd.gov; Christina Ojeda; NDickel@aqmd.gov
Cc: Haley, William (Bill); Christopher.Fear@WasteConnections.com; Han, Jessie; Viswanathan, Srividhya; Mark.Adams; Dylan Smith; Sarah Phillips
Subject: Re: Case No. 6177-4 Stipulated Order for Abatement - Weekly Pump Installation and operation update
Attachments: 2026 CCLF Existing De-Watering Well with Pump Map_2026-02-27.pdf

[EXTERNAL SENDER: Use caution with links/attachments]

All,

In accordance with Condition 65 of the Modified Stipulated Order, below is the summary of the installation and operation of dewatering pumps for the Chiquita Canyon Landfill. This information is subject to change based on further review and verification.

During 02/20/2026 to 02/26/2026, Chiquita completed the installation of, and began operating during the day, four (4) pumps in a vertical LFG extraction well for a total of fourteen (14) pumps operating in vertical LFG extraction wells. Additionally, one (1) pump was taken offline last week, and four (4) new pumps became operational, leading to a net increase of three (3) pumps. Please refer to the attached, up-to-date map of LFG wells with operating pumps. The number of pumps offline is higher than usual due in large part to reduced off-site leachate disposal capacity and the ongoing EVOH/HDPE geomembrane cover deployment. Please note that Chiquita has additional pumps in operation in perimeter sumps that are not included in this count.

During 02/27/2026 to 03/05/2026, given the number of dewatering pumps installed to date, and the maintenance associated with those pumps, Chiquita plans to install and begin operating an additional five (5) pumps in vertical LFG extraction wells in locations along the north and south slope of the reaction area. Pump installation will resume once the existing pumps are turned back on, subject to disposal outlet capacity. The pump installation locations for next week are also subject to change due to weather and/or safety conditions.

Regards,

STEVEN Ruben Medina, **E.I.T.**
Staff Professional
SCS Engineers
3900 Kilroy Airport Way, Suite 300
Long Beach, CA 90806
858-204-4342 (c)
SMedina@scsengineers.com

Driven by Client Success
www.scsengineers.com


*2024 Conrad Quality Focus
Award Recipient*



GENERAL DRAWING NOTES:


- EXISTING TOPOGRAPHIC SURVEY INFORMATION SHOWN WAS PROVIDED BY PROPELLOR. AERIAL PHOTOGRAPHY DATED FEBRUARY 04, 2026.
- NORTH ARROW SHOWN HERE IS REFERENCE TO THE CALIFORNIA STATE PLANE ZONE V COORDINATE SYSTEM, NAD 83.
- THE LOCATION OF ANY EXISTING GCCS COMPONENTS AND OTHER FEATURES ARE APPROXIMATE AND SHOULD BE USED FOR INFORMATION PURPOSES ONLY.
- EXISTING GCCS AS-BUILT DATED FEBRUARY 06, 2026.

#	Well ID	Operational Startup Date
1	CV-24142	5/3/2024
2	CV-24144	5/13/2024
3	CV-2496	5/30/2024
4	CV-2497	5/30/2024
5	CV-24101	7/8/2024
6	CV-24100	7/17/2024
7	CV-2498	7/18/2024
8	CV-2354	5/6/2025
9	CV-24139	6/12/2025
10	CV-24140	6/14/2025
11	CV-2351	1/23/2026
12	CV-24138	1/23/2026
13	CV-2352	1/26/2026
14	CV-2499	1/27/2026

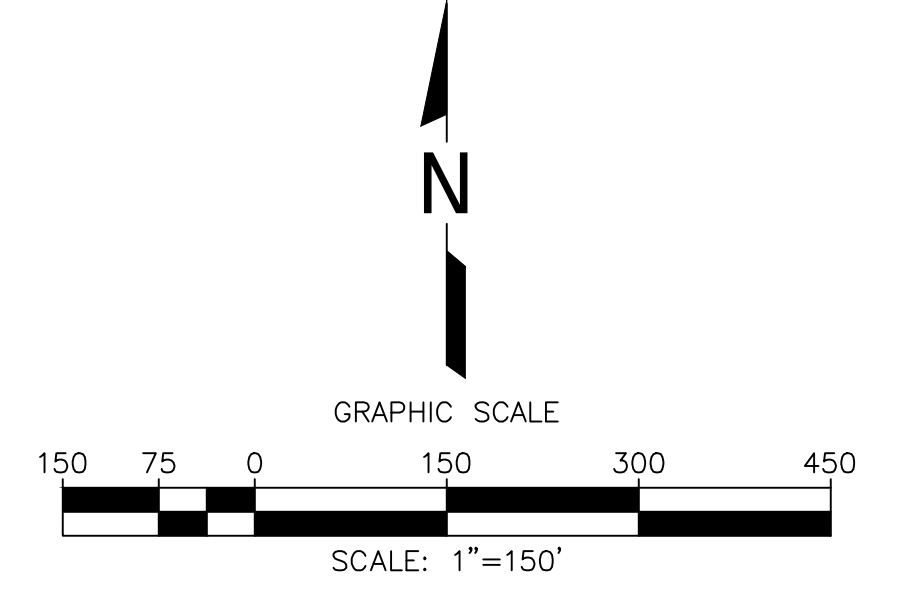

- LEGEND**
- 1150 TOPOGRAPHIC CONTOUR
 - EXISTING CELL LIMITS (APPROXIMATE)
 - REACTION AREA BOUNDARY - CONDITION 9A
 - REACTION AREA BOUNDARY - DATA ANALYSIS
 - ⊕ CV-XX EXISTING VERTICAL LFG EXTRACTION WELL
 - ⊕ CV-XX PLR EXISTING LFG VERTICAL EXTRACTION WELL - PRESSURIZED LEACHATE RELEASE
 - ⊙ EXISTING CONDENSATE SUMP WITH PUMP
 - ▲ EXISTING DE-WATERING WELL WITH PUMP - CURRENTLY RUNNING
 - ▲ EXISTING DE-WATERING WELL WITH PUMP - INSTALLED

#	Well ID	Operational Startup Date
1	CV-24142	5/3/2024
2	CV-24144	5/13/2024
3	CV-2496	5/30/2024
4	CV-2497	5/30/2024
5	CV-24101	7/8/2024
6	CV-24100	7/17/2024
7	CV-2498	7/18/2024
8	CV-2354	5/6/2025
9	CV-24139	6/12/2025
10	CV-24140	6/14/2025
11	CV-2351	1/23/2026
12	CV-24138	1/23/2026
13	CV-2352	1/26/2026
14	CV-2499	1/27/2026

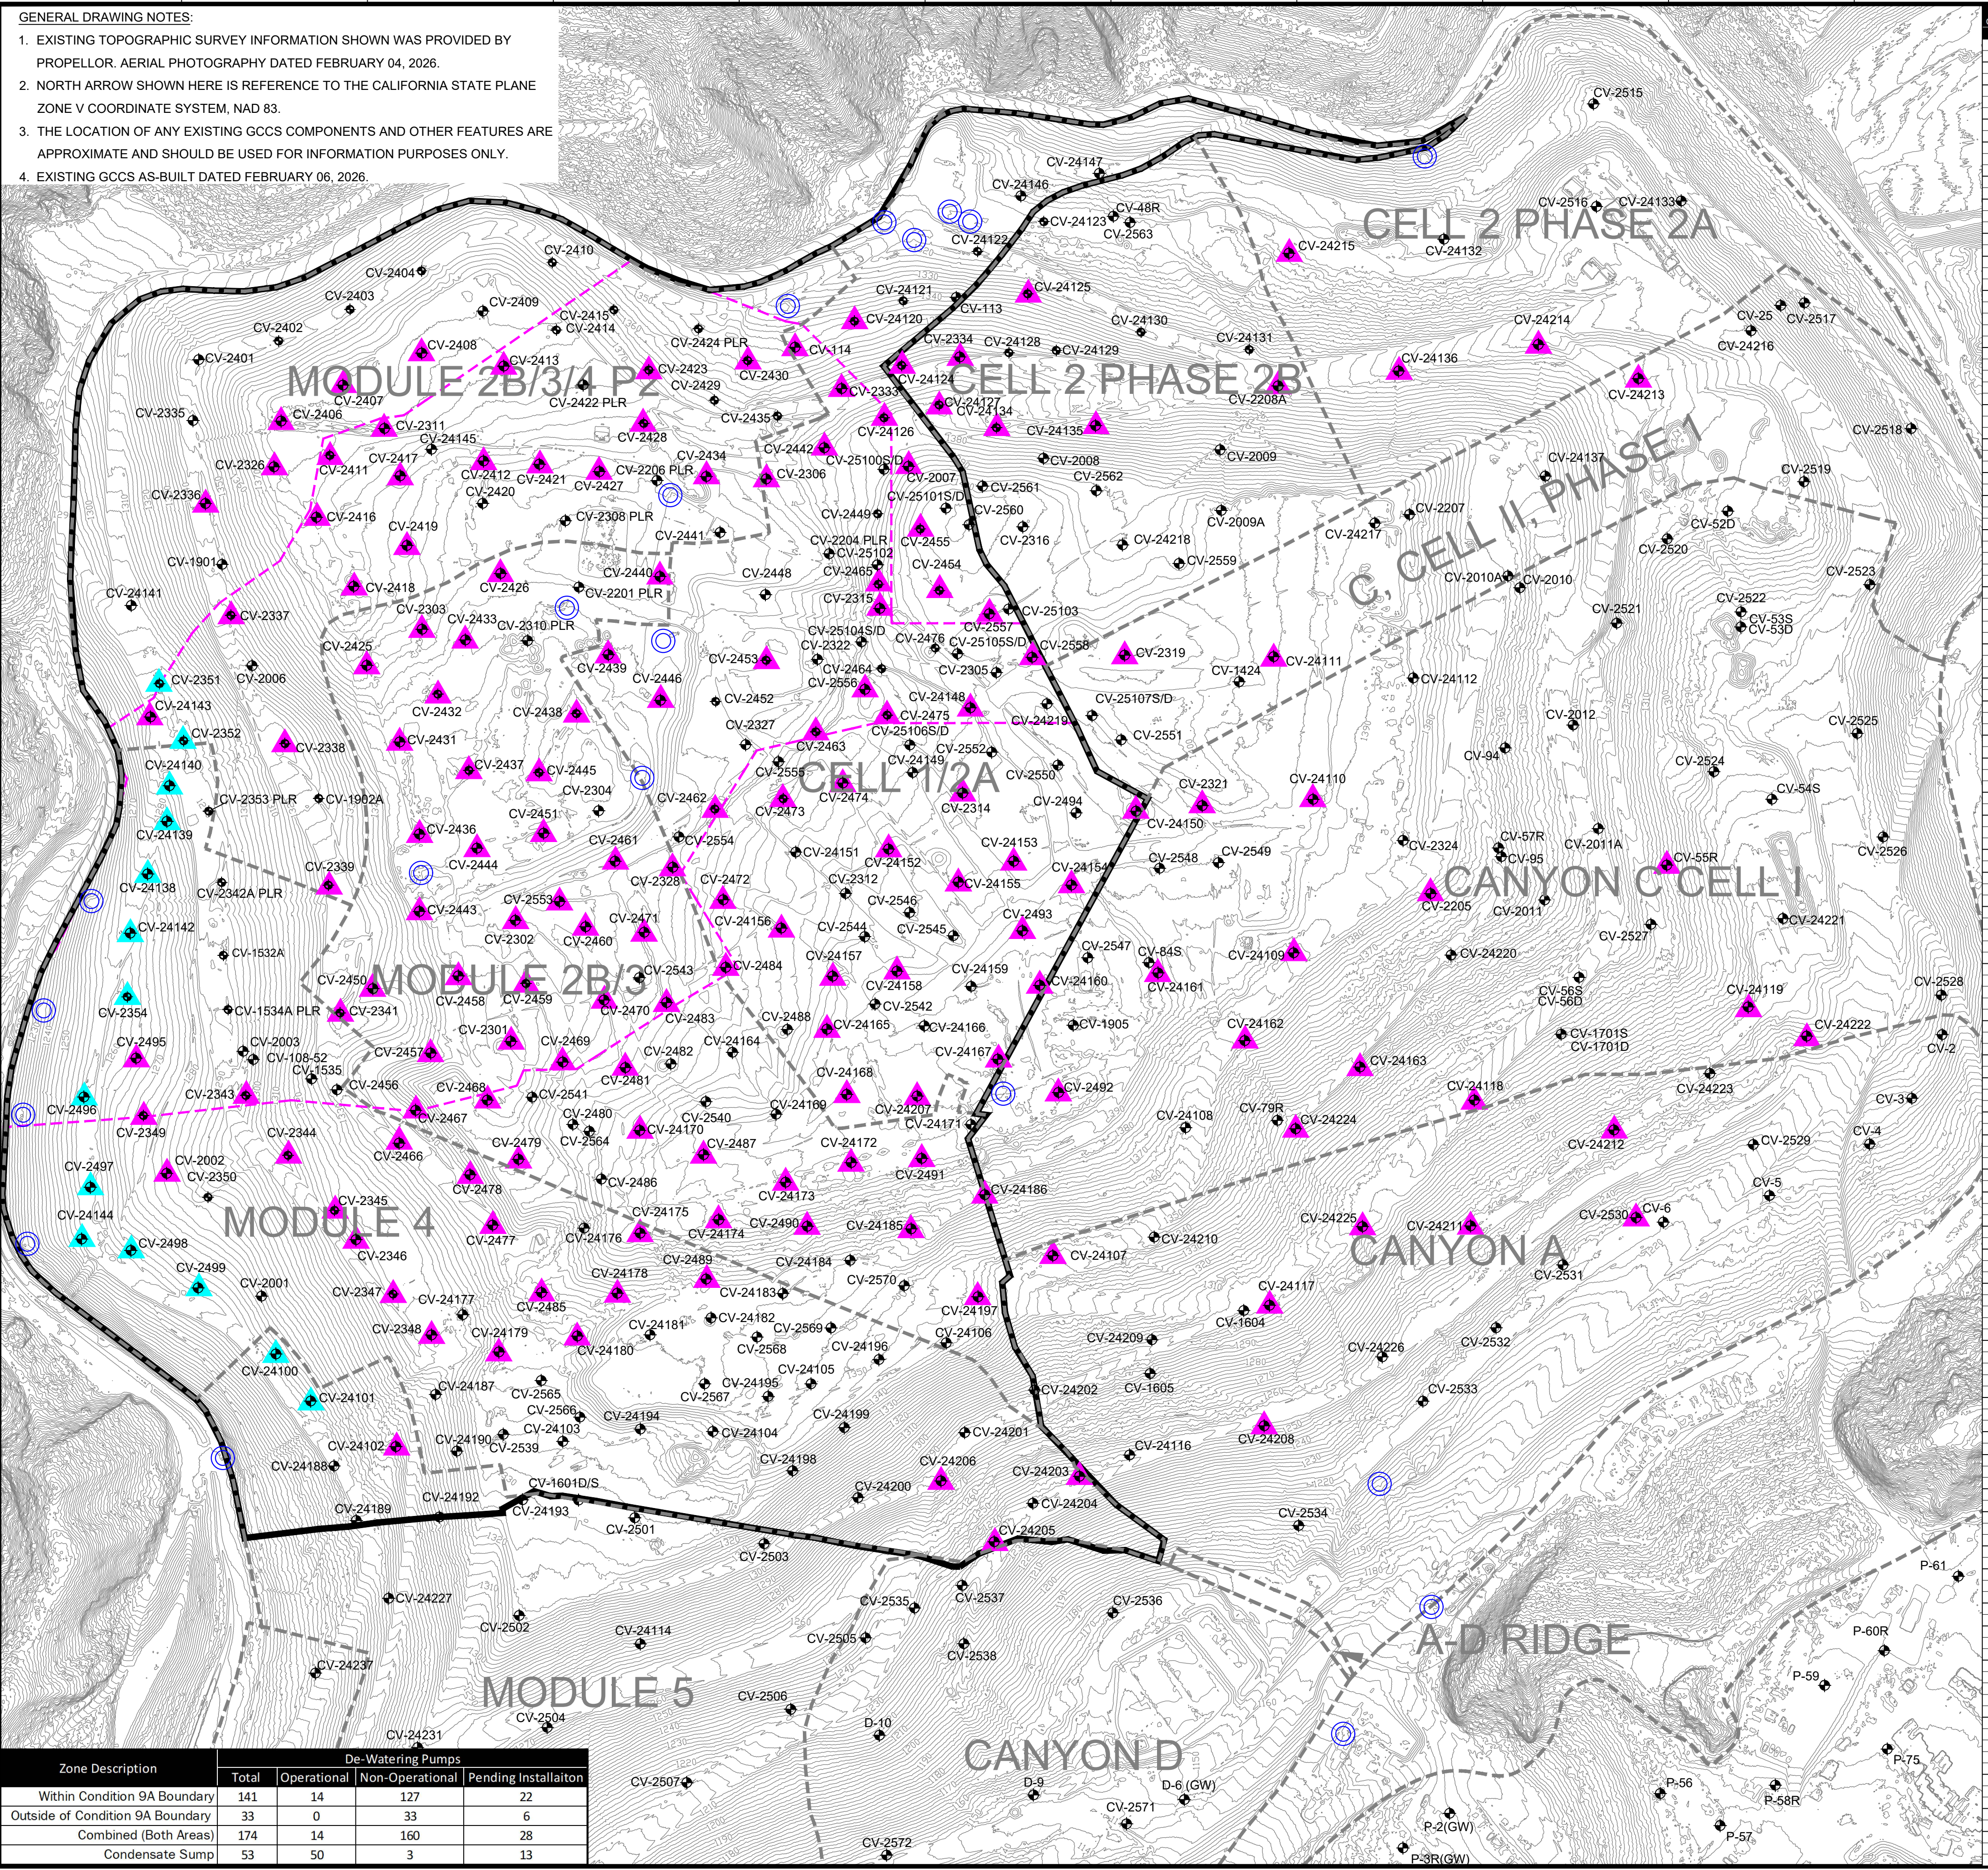

Zone Description	De-Watering Pumps			
	Total	Operational	Non-Operational	Pending Installation
Within Condition 9A Boundary	141	14	127	22
Outside of Condition 9A Boundary	33	0	33	6
Combined (Both Areas)	174	14	160	28
Condensate Sump	53	50	3	13

CLIENT: CHIQUITA CANYON LANDFILL, CASTAIC, CALIFORNIA

PROJECT TITLE: CHIQUITA CANYON LANDFILL, CASTAIC, CALIFORNIA

AGAP FILE: N:\CAD\ASBUILT-MASTERS

APP. BY: AEEKSRM

DATE: 02/27/2026

SCALE: AS SHOWN

SHEET: 1