

Archived: Tuesday, March 10, 2026 8:45:17 AM
From: [Medina, Steven](#)
Mail received time: Fri, 6 Mar 2026 22:55:36
Sent: Fri, 6 Mar 2026 22:53:22
To: bchen@aqmd.gov
Cc: [Haley, William \(Bill\)](#)
Subject: Re: Case No. 6177-4 Stipulated Order for Abatement - Weekly Pump Installation and operation update
Importance: Normal
Sensitivity: None
Attachments: Outlook-akfwehn.png Outlook-20uewoih.png 026 CCLF Existing De-Watering Well with Pump Map_2026-03-06.pdf

[EXTERNAL SENDER: Use caution with links/attachments]

Hello All,

In accordance with Condition 65 of the Modified Stipulated Order, below is the summary of the installation and operation of dewatering pumps for the Chiquita Canyon Landfill. This information is subject to change based on further review and verification.

During 02/27/2026 to 03/05/2026, Chiquita completed the installation of, and began operating during the day, twenty-four (24) pumps in a vertical LFG extraction well for a total of thirty-eight (38) pumps operating in vertical LFG extraction wells. No pumps were taken offline last week. Please refer to the attached, up-to-date map of LFG wells with operating pumps. The number of pumps offline is higher than usual due in large part to reduced off-site leachate disposal capacity and the ongoing EVOH/HDPE geomembrane cover deployment. Please note that Chiquita has additional pumps in operation in perimeter sumps that are not included in this count.

During 03/06/2026 to 03/12/2026, given the number of dewatering pumps installed to date, and the maintenance associated with those pumps, Chiquita plans to install and begin operating an additional (5) pumps in vertical LFG extraction wells in locations along the north and south slope of the reaction area. Pump installation will resume once the existing pumps are turned back on, subject to disposal outlet capacity. The pump installation locations for next week are also subject to change due to weather and/or safety conditions.

Regards,

STEVEN Ruben Medina, **E.I.T.**

Staff Professional

SCS Engineers

3900 Kilroy Airport Way, Suite 300

Long Beach, CA 90806

858-204-4342 (c)

SMedina@scsengineers.com

Driven by Client Success


www.scsengineers.com

GENERAL DRAWING NOTES:


- EXISTING TOPOGRAPHIC SURVEY INFORMATION SHOWN WAS PROVIDED BY PROPELLOR. AERIAL PHOTOGRAPHY DATED FEBRUARY 04, 2026.
- NORTH ARROW SHOWN HERE IS REFERENCE TO THE CALIFORNIA STATE PLANE ZONE V COORDINATE SYSTEM, NAD 83.
- THE LOCATION OF ANY EXISTING GCCS COMPONENTS AND OTHER FEATURES ARE APPROXIMATE AND SHOULD BE USED FOR INFORMATION PURPOSES ONLY.
- EXISTING GCCS AS-BUILT DATED FEBRUARY 06, 2026.

A
B
C
D
E
F
G
H
I
J

1 2 3 4 5 6 7 8 9 10 11 12 13 14 15

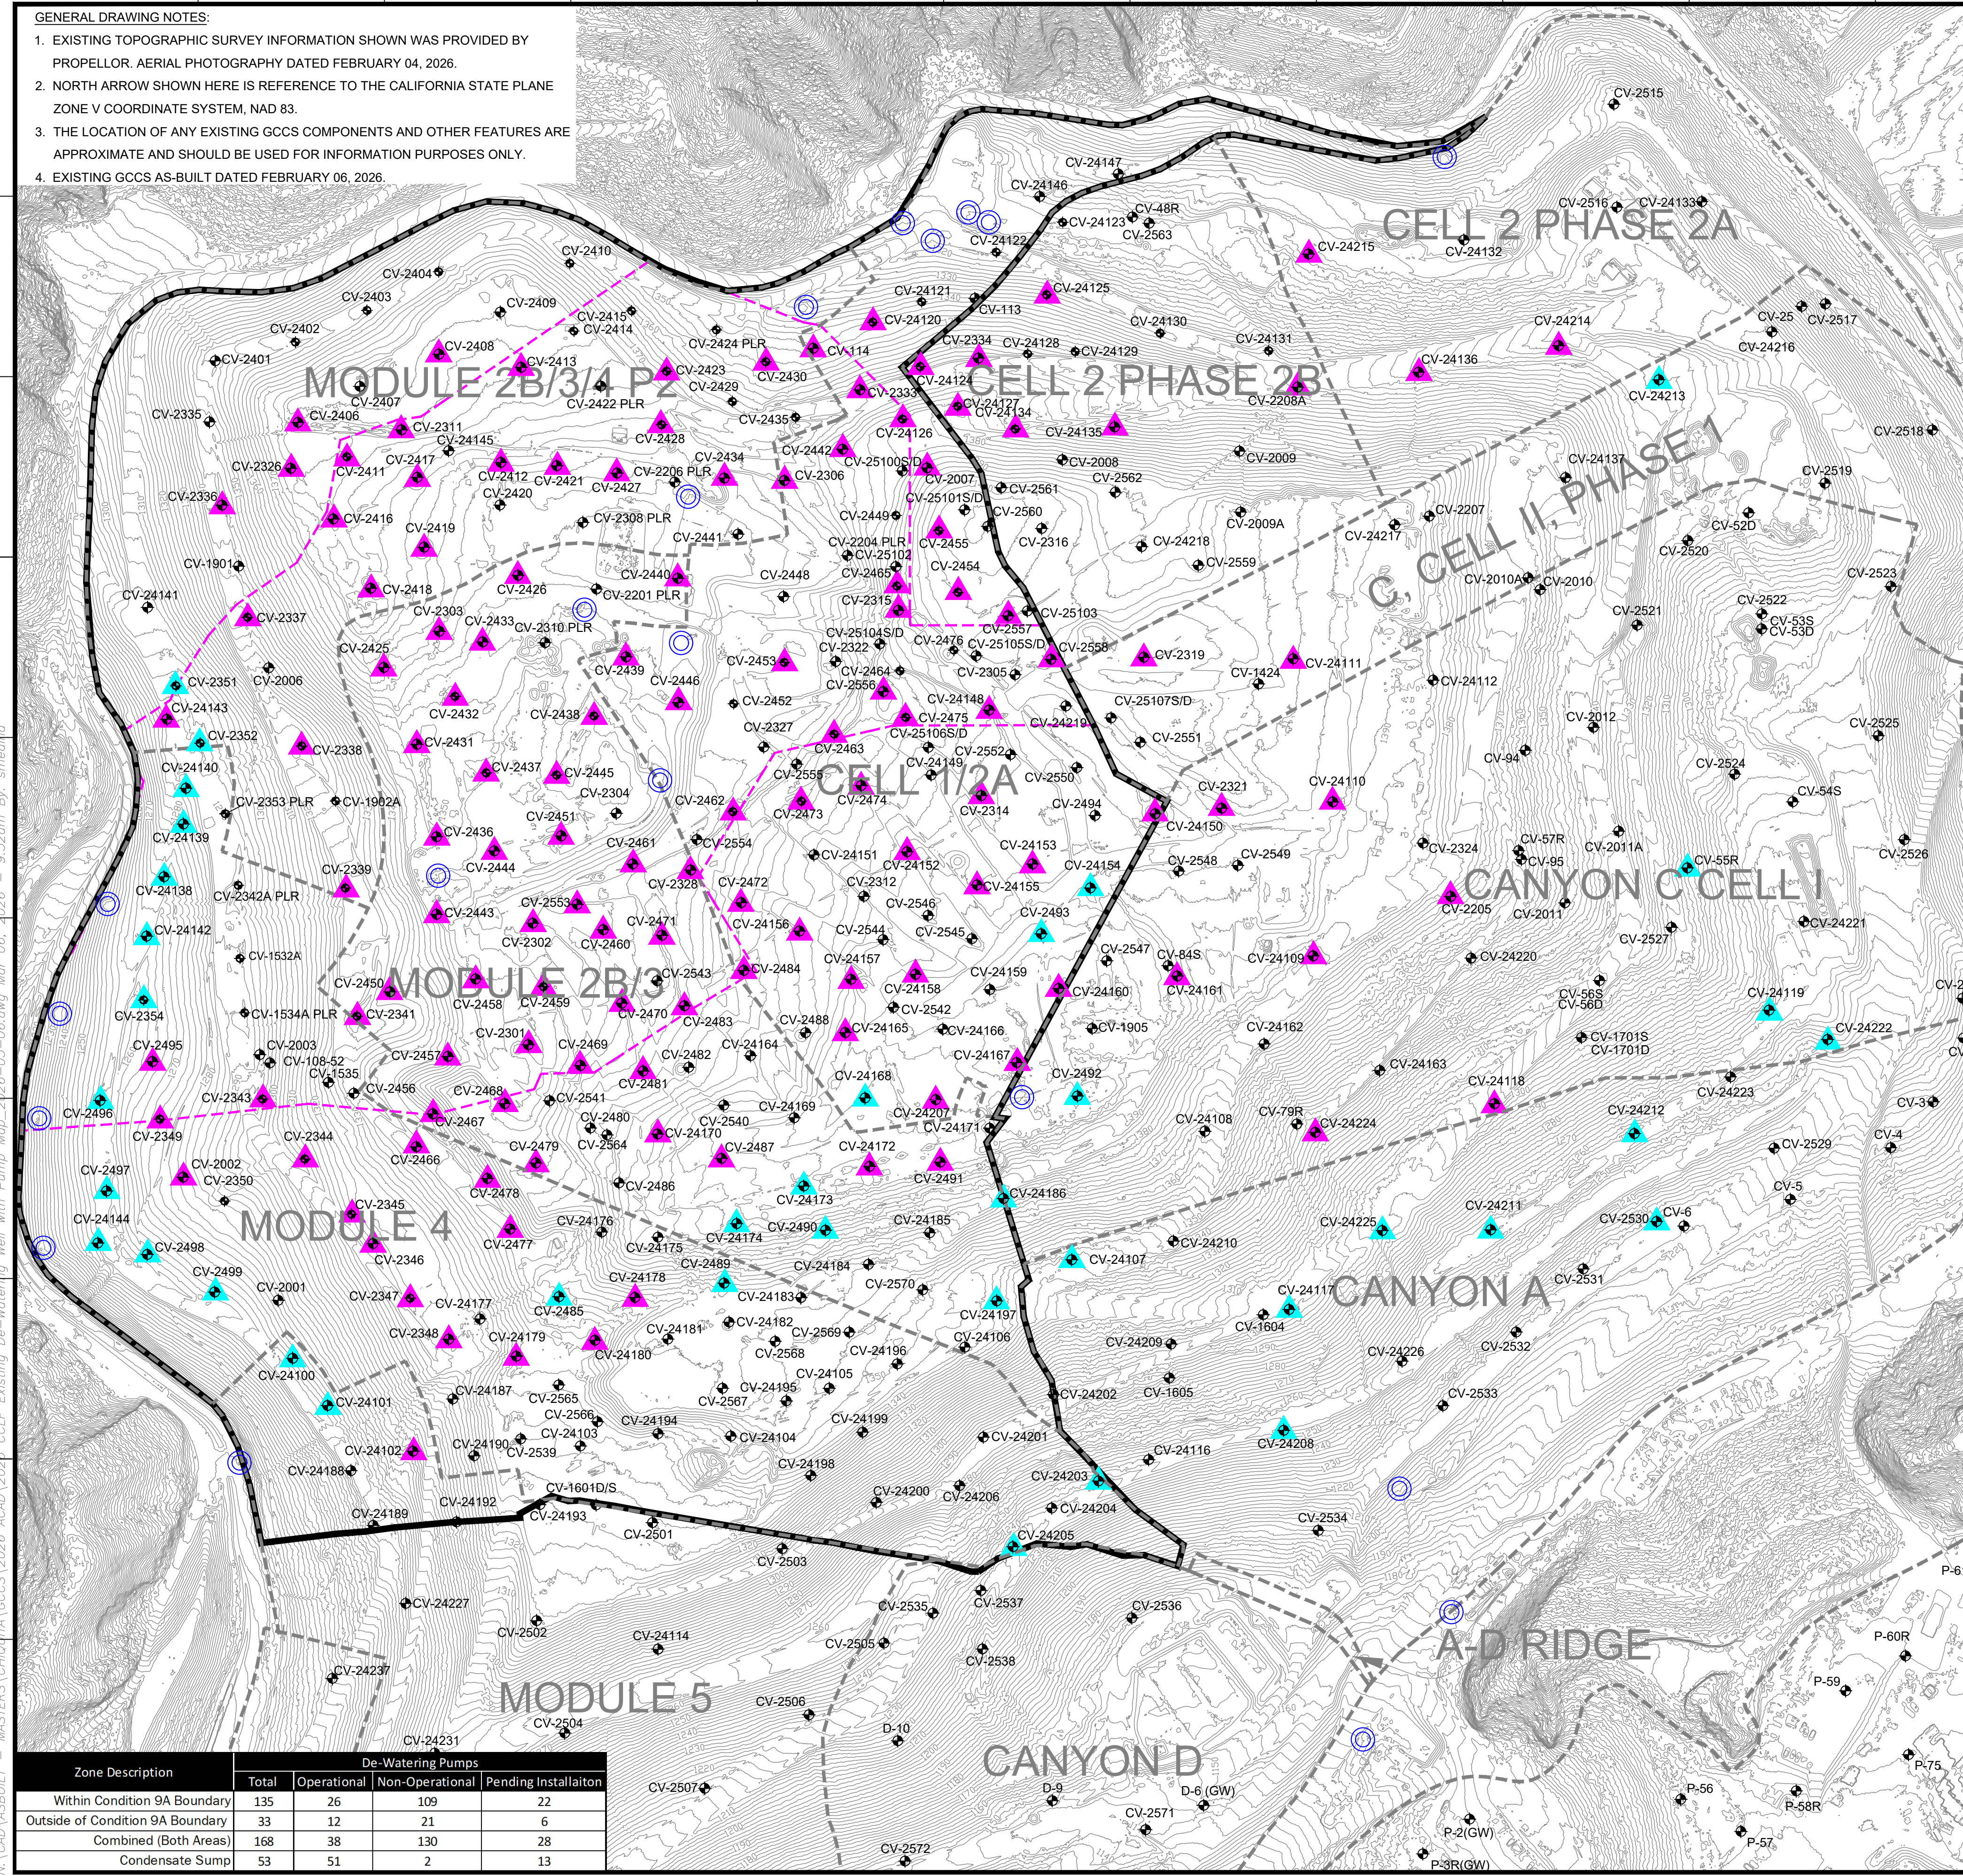

#	Well I.D.
1	CV-114
2	CV-2001
3	CV-2002
4	CV-2007
5	CV-2205
6	CV-2208A
7	CV-2301
8	CV-2302
9	CV-2303
10	CV-2306
11	CV-2311
12	CV-2314
13	CV-2315
14	CV-2319
15	CV-2321
16	CV-2326
17	CV-2328
18	CV-2333
19	CV-2334
20	CV-2336
21	CV-2337
22	CV-2338
23	CV-2339
24	CV-2341
25	CV-2343-PLR
26	CV-2344
27	CV-2345
28	CV-2346
29	CV-2347
30	CV-2348
31	CV-2349
32	CV-2349
33	CV-2408
34	CV-2411
35	CV-2412
36	CV-2413
37	CV-2416
38	CV-2417
39	CV-2418
40	CV-2421
41	CV-2423
42	CV-2425
43	CV-2426
44	CV-2427
45	CV-2428
46	CV-2430
47	CV-2431
48	CV-2432
49	CV-2433
50	CV-2434
51	CV-2436
52	CV-2437
53	CV-2438
54	CV-2439
55	CV-2440
56	CV-2442
57	CV-2443
58	CV-2444
59	CV-2445
60	CV-2446
61	CV-2450
62	CV-2451
63	CV-2453
64	CV-2455
65	CV-2457
66	CV-2458
67	CV-2459
68	CV-2460
69	CV-2461
70	CV-2462
71	CV-2463
72	CV-2465
73	CV-2466
74	CV-2467
75	CV-2468
76	CV-2469
77	CV-2470
78	CV-2471
79	CV-2472
80	CV-2473
81	CV-2474
82	CV-2475
83	CV-2477
84	CV-2478
85	CV-2479
86	CV-2481
87	CV-2483
88	CV-2484
89	CV-2487
90	CV-2491
91	CV-2495
92	CV-24102
93	CV-24109
94	CV-24110
95	CV-24111
96	CV-24118
97	CV-24120
98	CV-24124
99	CV-24125
100	CV-24126
101	CV-24127
102	CV-24134
103	CV-24135
104	CV-24136
105	CV-24143
106	CV-24148
107	CV-24150
108	CV-24152
109	CV-24153
110	CV-24155
111	CV-24156
112	CV-24157
113	CV-24158
114	CV-24160
115	CV-24161
116	CV-24165
117	CV-24167
118	CV-24170
119	CV-24172
120	CV-24178
121	CV-24179
122	CV-24180
123	CV-2419
124	CV-24207
125	CV-24214
126	CV-24215
127	CV-24224
128	CV-2556
129	CV-2557
130	CV-2558

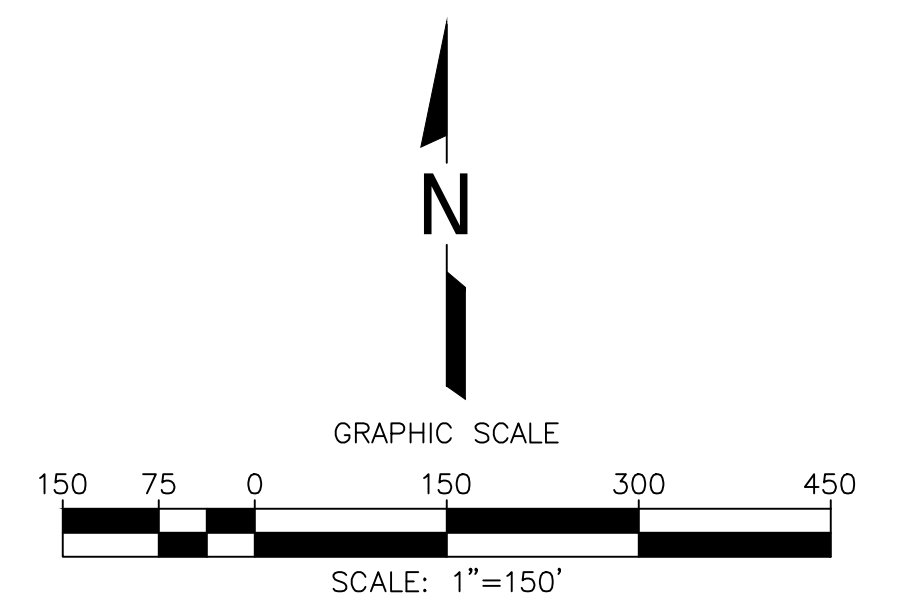

- LEGEND**
- 1150 TOPOGRAPHIC CONTOUR
 - EXISTING CELL LIMITS (APPROXIMATE)
 - REACTION AREA BOUNDARY - CONDITION 9A
 - REACTION AREA BOUNDARY - DATA ANALYSIS
 - ⊕ CV-XX EXISTING VERTICAL LFG EXTRACTION WELL
 - ⊕ CV-XX PLR EXISTING LFG VERTICAL EXTRACTION WELL - PRESSURIZED LEACHATE RELEASE
 - ⊙ EXISTING CONDENSATE SUMP WITH PUMP
 - ▲ EXISTING DE-WATERING WELL WITH PUMP - CURRENTLY RUNNING
 - ▲ EXISTING DE-WATERING WELL WITH PUMP - INSTALLED

De-Watering Well Pumps that are Currently Running

#	Well I.D.	Operational Startup Date
1	CV-24142	5/3/2024
2	CV-24144	5/13/2024
3	CV-2496	5/30/2024
4	CV-2497	5/30/2024
5	CV-24101	7/8/2024
6	CV-24100	7/17/2024
7	CV-2498	7/18/2024
8	CV-24212	1/10/2025
9	CV-24197	3/11/2025
10	CV-24168	4/7/2025
11	CV-24173	4/15/2025
12	CV-24174	4/15/2025
13	CV-24154	4/17/2025
14	CV-2354	5/6/2025
15	CV-2493	5/6/2025
16	CV-2492	5/7/2025
17	CV-24117	5/13/2025
18	CV-24119	5/14/2025
19	CV-24107	5/15/2025
20	CV-24211	5/15/2025
21	CV-24208	5/16/2025
22	CV-24205	5/20/2025
23	CV-2490	6/5/2025
24	CV-24203	6/5/2025
25	CV-24225	6/9/2025
26	CV-24186	6/10/2025
27	CV-24222	6/10/2025
28	CV-24139	6/12/2025
29	CV-24140	6/14/2025
30	CV-55R	6/23/2025
31	CV-24213	7/9/2025
32	CV-2485	8/7/2025
33	CV-2489	9/4/2025
34	CV-2530	10/3/2025
35	CV-2351	1/23/2026
36	CV-24138	1/23/2026
37	CV-2352	1/26/2026
38	CV-2499	1/27/2026

Zone Description	De-Watering Pumps			
	Total	Operational	Non-Operational	Pending Installation
Within Condition 9A Boundary	135	26	109	22
Outside of Condition 9A Boundary	33	12	21	6
Combined (Both Areas)	168	38	130	28
Condensate Sump	53	51	2	13

DATE: 03/06/2026

SCALE: AS SHOWN

SHEET: 1

CLIENT: CHIQUITA CANYON LANDFILL CASTAIC, CALIFORNIA

PROJECT TITLE: EXISTING DE-WATERING WELL WITH PUMP MAP

AGENCY: NUCAD/ASBUILT-MASTERS

DATE: 01/20/24 12:41

APP. BY: SRM

CHK. BY: SRM

SCS ENGINEERS ENVIRONMENTAL CONSULTANTS

3800 ALLEY, SUITE 300, LONG BEACH, CA 90806

PH: (562) 428-5544