

---

**From:** Medina, Steven <SMedina@scsengineers.com>  
**Sent:** Friday, March 27, 2026 5:03 PM  
**To:** Baitong Chen; Nathaniel Dickel; Christina Ojeda  
**Cc:** Haley, William (Bill); Chris Fear; Han, Jessie; Viswanathan, Srividhya; Mark.Adams; Dylan Smith; Sarah Phillips  
**Subject:** UPDATED: Case No. 6177-4 Stipulated Order for Abatement - Weekly Pump Installation and operation update  
**Attachments:** 2026 CCLF Existing De-Watering Well with Pump Map\_2026-03-13.pdf

[EXTERNAL SENDER: Use caution with links/attachments]

---

Hello All,

We are resubmitting this update to include a map of the LFG wells with operating pumps as of the date of the original submittal, March 13, 2026.

In accordance with Condition 65 of the Modified Stipulated Order, below is the summary of the installation and operation of dewatering pumps for the Chiquita Canyon Landfill. This information is subject to change based on further review and verification.

During 03/06/2026 to 03/12/2026, Chiquita completed the installation of, and began operating during the day, seven (7) pumps in a vertical LFG extraction well for a total of forty-five (45) pumps operating in vertical LFG extraction wells. No pumps were taken offline last week. The number of pumps offline is higher than usual due in large part to reduced off-site leachate disposal capacity and the ongoing EVOH/HDPE geomembrane cover deployment. Please note that Chiquita has additional pumps in operation in perimeter sumps that are not included in this count.

During 03/13/2026 to 03/19/2026, given the number of dewatering pumps installed to date, and the maintenance associated with those pumps, Chiquita plans to install and begin operating zero (0) additional pumps in vertical LFG extraction wells in locations along the north and south slope of the reaction area. Pump installation will resume once the existing pumps are turned back on, subject to disposal outlet capacity.

Regards,

**STEVEN** Ruben Medina, **E.I.T.**  
Staff Professional  
**SCS Engineers**  
3900 Kilroy Airport Way, Suite 300  
Long Beach, CA 90806  
858-204-4342 (c)  
[SMedina@scsengineers.com](mailto:SMedina@scsengineers.com)

**Driven by Client Success**

[www.scsengineers.com](http://www.scsengineers.com)

*2024 Conrad Quality Focus  
Award Recipient*



---

**From:** Medina, Steven <SMedina@scsengineers.com>

**Sent:** Friday, March 13, 2026 1:24 PM

**To:** Baitong Chen <bchen@aqmd.gov>; Christina Ojeda <cojeda@aqmd.gov>; Nathaniel Dickel <ndickel@aqmd.gov>

**Cc:** Haley, William (Bill) <WCHaley@scsengineers.com>; Chris Fear <christopher.fear@wasteconnections.com>; Han, Jessie <JHan@scsengineers.com>; Viswanathan, Srividhya <SViswanathan@scsengineers.com>; Mark.Adams <Mark.Adams@WasteConnections.com>; Dylan Smith <Dylan.Smith@WasteConnections.com>; Sarah Phillips <Sarah.Phillips@WasteConnections.com>

**Subject:** Case No. 6177-4 Stipulated Order for Abatement - Weekly Pump Installation and operation update

Hello All,

In accordance with Condition 65 of the Modified Stipulated Order, below is the summary of the installation and operation of dewatering pumps for the Chiquita Canyon Landfill. This information is subject to change based on further review and verification.

During 03/06/2026 to 03/12/2026, Chiquita completed the installation of, and began operating during the day, seven (7) pumps in a vertical LFG extraction well for a total of forty-five (45) pumps operating in vertical LFG extraction wells. No pumps were taken offline last week. Due to a system-wide shutdown, SCS is currently unable to access the up-to-date map of LFG wells with operating pumps. SCS will provide the map in a revised report once the system returns to normal operation. The number of pumps offline is higher than usual due in large part to reduced off-site leachate disposal capacity and the ongoing EVOH/HDPE geomembrane cover deployment. Please note that Chiquita has additional pumps in operation in perimeter sumps that are not included in this count.

During 03/13/2026 to 03/19/2026, given the number of dewatering pumps installed to date, and the maintenance associated with those pumps, Chiquita plans to install and begin operating zero (0) additional pumps in vertical LFG extraction wells in locations along the north and south slope of the reaction area. Pump installation will resume once the existing pumps are turned back on, subject to disposal outlet capacity.

Regards,

**STEVEN** Ruben Medina, **E.I.T.**

Staff Professional

**SCS Engineers**

3900 Kilroy Airport Way, Suite 300

Long Beach, CA 90806

858-204-4342 (c)  
[SMedina@scsengineers.com](mailto:SMedina@scsengineers.com)

**Driven by Client Success**  
[www.scsengineers.com](http://www.scsengineers.com)


*2024 Conrad Quality Focus  
Award Recipient*



**GENERAL DRAWING NOTES:**

- EXISTING TOPOGRAPHIC SURVEY INFORMATION SHOWN WAS PROVIDED BY PROPELLOR. AERIAL PHOTOGRAPHY DATED MARCH 18, 2026.
- NORTH ARROW SHOWN HERE IS REFERENCE TO THE CALIFORNIA STATE PLANE ZONE V COORDINATE SYSTEM, NAD 83.
- THE LOCATION OF ANY EXISTING GCCS COMPONENTS AND OTHER FEATURES ARE APPROXIMATE AND SHOULD BE USED FOR INFORMATION PURPOSES ONLY.

#	Well I.D.	Operational Startup Date
1	CV-114	
2	CV-2001	
3	CV-2002	
4	CV-2007	
5	CV-2205	
6	CV-2206-PLR	
7	CV-2208A	
8	CV-2301	
9	CV-2302	
10	CV-2303	
11	CV-2306	
12	CV-2311	
13	CV-2314	
14	CV-2315	
15	CV-2319	
16	CV-2321	
17	CV-2326	
18	CV-2328	
19	CV-2333	
20	CV-2334	
21	CV-2336	
22	CV-2337	
23	CV-2338	
24	CV-2339	
25	CV-2341	
26	CV-2343-PLR	
27	CV-2344	
28	CV-2345	
29	CV-2346	
30	CV-2347	
31	CV-2348	
32	CV-2349	
33	CV-2406	
34	CV-2408	
35	CV-2411	
36	CV-2412	
37	CV-2413	
38	CV-2416	
39	CV-2417	
40	CV-2419	
41	CV-2418	
42	CV-2421	
43	CV-2423	
44	CV-2425	
45	CV-2426	
46	CV-2427	
47	CV-2428	
48	CV-2430	
49	CV-2431	
50	CV-2432	
51	CV-2433	
52	CV-2434	
53	CV-2436	
54	CV-2437	
55	CV-2438	
56	CV-2439	
57	CV-2440	
58	CV-2442	
59	CV-2443	
60	CV-2444	
61	CV-2445	
62	CV-2446	
63	CV-2450	
64	CV-2451	
65	CV-2453	
66	CV-2455	
67	CV-2457	
68	CV-2458	
69	CV-2459	
70	CV-2460	
71	CV-2461	
72	CV-2462	
73	CV-2463	
74	CV-2465	
75	CV-2466	
76	CV-2467	
77	CV-2468	
78	CV-2469	
79	CV-2470	
80	CV-2471	
81	CV-2472	
82	CV-2473	
83	CV-2474	
84	CV-2475	
85	CV-2477	
86	CV-2478	
87	CV-2479	
88	CV-2481	
89	CV-2483	
90	CV-2484	
91	CV-2487	
92	CV-2487	
93	CV-2486	
94	CV-24102	
95	CV-24111	
96	CV-24118	
97	CV-24120	
98	CV-24124	
99	CV-24125	
100	CV-24126	
101	CV-24127	
102	CV-24134	
103	CV-24135	
104	CV-24136	
105	CV-24143	
106	CV-24148	
107	CV-24152	
108	CV-24153	
109	CV-24155	
110	CV-24156	
111	CV-24157	
112	CV-24158	
113	CV-24160	
114	CV-24161	
115	CV-24162	
116	CV-24163	
117	CV-24168	
118	CV-24172	
119	CV-24178	
120	CV-24179	
121	CV-24207	
122	CV-24214	
123	CV-24215	
124	CV-2556	
125	CV-2557	
126	CV-2558	

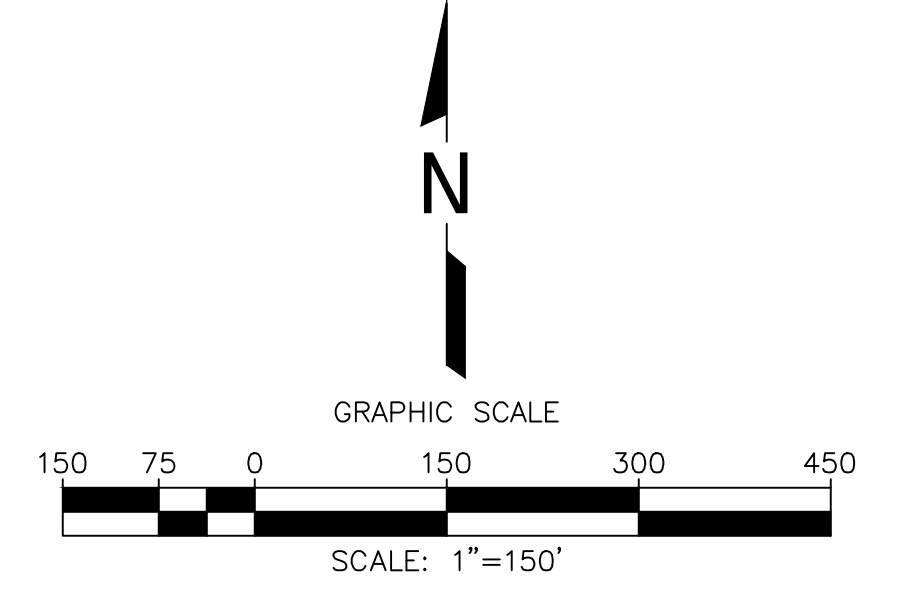

- LEGEND**
- 1150 TOPOGRAPHIC CONTOUR
  - EXISTING CELL LIMITS (APPROXIMATE)
  - REACTION AREA BOUNDARY - CONDITION 9A
  - REACTION AREA BOUNDARY - DATA ANALYSIS
  - CV-XX EXISTING VERTICAL LFG EXTRACTION WELL
  - CV-XX PLR EXISTING LFG VERTICAL EXTRACTION WELL - PRESSURIZED LEACHATE RELEASE
  - ⊙ EXISTING CONDENSATE SUMP WITH PUMP
  - ▲ EXISTING DE-WATERING WELL WITH PUMP - CURRENTLY RUNNING
  - ▲ EXISTING DE-WATERING WELL WITH PUMP - INSTALLED

**De-Watering Well Pumps that are Currently Running**

#	Well I.D.	Operational Startup Date
1	CV-24142	5/3/2024
2	CV-24144	5/13/2024
3	CV-2496	5/30/2024
4	CV-2497	5/30/2024
5	CV-24109	7/3/2024
6	CV-24101	7/8/2024
7	CV-24100	7/17/2024
8	CV-2498	7/18/2024
9	CV-24108	9/4/2024
10	CV-24210	9/10/2024
11	CV-24212	1/10/2025
12	CV-24197	3/11/2025
13	CV-24168	4/7/2025
14	CV-24173	4/15/2025
15	CV-24174	4/15/2025
16	CV-24154	4/17/2025
17	CV-2354	5/6/2025
18	CV-2493	5/6/2025
19	CV-2492	5/7/2025
20	CV-24224	5/12/2025
21	CV-24117	5/13/2025
22	CV-24119	5/14/2025
23	CV-24107	5/15/2025
24	CV-24211	5/15/2025
25	CV-24208	5/16/2025
26	CV-24205	5/20/2025
27	CV-2490	6/5/2025
28	CV-24203	6/5/2025
29	CV-24225	6/9/2025
30	CV-24186	6/10/2025
31	CV-24222	6/10/2025
32	CV-24139	6/12/2025
33	CV-24140	6/14/2025
34	CV-55R	6/23/2025
35	CV-24213	7/9/2025
36	CV-24150	7/9/2025
37	CV-24110	7/17/2025
38	CV-2485	8/7/2025
39	CV-24180	8/15/2025
40	CV-2489	9/4/2025
41	CV-2530	10/3/2025
42	CV-2351	1/23/2026
43	CV-24138	1/23/2026
44	CV-2352	1/26/2026
45	CV-2499	1/27/2026

Zone Description	De-Watering Pumps			
	Total	Operational	Non-Operational	Pending Installation
Within Condition 9A Boundary	141	31	110	22
Outside of Condition 9A Boundary	30	14	16	6
Combined (Both Areas)	171	45	126	28
Condensate Sump	53	51	2	13

DATE:	
REVISION:	
NO.	
SHEET TITLE:	EXISTING DE-WATERING WELL WITH PUMP MAP
PROJECT TITLE:	CHIQUITA CANYON LANDFILL CASTAIC, CALIFORNIA
CLIENT:	CHIQUITA CANYON LANDFILL CASTAIC, CALIFORNIA
ACAD FILE:	N:\CAD\ASBUILT-MASTERS
APP. BY:	
CHK. BY:	
DATE:	03/13/2026
SCALE:	AS SHOWN
SHEET:	1

N:\CAD\ASBUILT - MASTERS\CHIQUITA\GCCS\2026 ACAD\2026 CCL Existing De-Watering Well with Pump Map\_2026-03-13.dwg Mar 27, 2026 - 6:49am Bv.smedino