

From: Medina, Steven <SMedina@scsengineers.com>
Sent: Friday, April 10, 2026 1:55 PM
To: Baitong Chen; Christina Ojeda; Nathaniel Dickel
Cc: Haley, William (Bill); Chris Fear; Han, Jessie; Viswanathan, Srividhya; Mark.Adams; Dylan Smith; Sarah Phillips
Subject: Case No. 6177-4 Stipulated Order for Abatement - Weekly Pump Installation and Operation Update
Attachments: 2026 CCLF Existing De-Watering Well with Pump Map_2026-04-10.pdf

[EXTERNAL SENDER: Use caution with links/attachments]

Hello,

In accordance with Condition 65 of the Modified Stipulated Order, below is the summary of the installation and operation of dewatering pumps for the Chiquita Canyon Landfill. This information is subject to change based on further review and verification.

During 04/03/2026 to 04/09/2026, Chiquita completed the installation of, and began operating during the day, three (3) pumps in a vertical LFG extraction well for a total of seventy-seven (77) pumps operating in vertical LFG extraction wells. Additionally, one (1) pump was taken offline last week, and three (3) new pumps became operational, leading to a net increase of two (2) pumps.

Please refer to the attached, up-to-date map of LFG wells with operating pumps. The number of pumps offline is higher than usual due in large part to reduced off-site leachate disposal capacity and the ongoing EVOH/HDPE geomembrane cover deployment. Please note that Chiquita has additional pumps in operation in perimeter sumps that are not included in this count.

During 04/10/2026 to 04/16/2026, given the number of dewatering pumps installed to date, and the maintenance associated with those pumps, Chiquita plans to install and begin operating zero (0) additional pumps in vertical LFG extraction wells in locations along the north and south slope of the reaction area. Pump installation will resume once the existing pumps are turned back on, subject to disposal outlet capacity.

Regards,

STEVEN Ruben Medina, **E.I.T.**
Staff Professional
SCS Engineers
3900 Kilroy Airport Way, Suite 300
Long Beach, CA 90806
858-204-4342 (c)
SMedina@scsengineers.com


Driven by Client Success
www.scsengineers.com

*2024 Conrad Quality Focus
Award Recipient*




GENERAL DRAWING NOTES:
 1. EXISTING TOPOGRAPHIC SURVEY INFORMATION SHOWN WAS PROVIDED BY PROPELLOR. AERIAL PHOTOGRAPHY DATED APRIL 08, 2026.
 2. NORTH ARROW SHOWN HERE IS REFERENCE TO THE CALIFORNIA STATE PLANE ZONE V COORDINATE SYSTEM, NAD 83.
 3. THE LOCATION OF ANY EXISTING GCCS COMPONENTS AND OTHER FEATURES ARE APPROXIMATE AND SHOULD BE USED FOR INFORMATION PURPOSES ONLY.

A
B
C
D
E
F
G
H
I
J

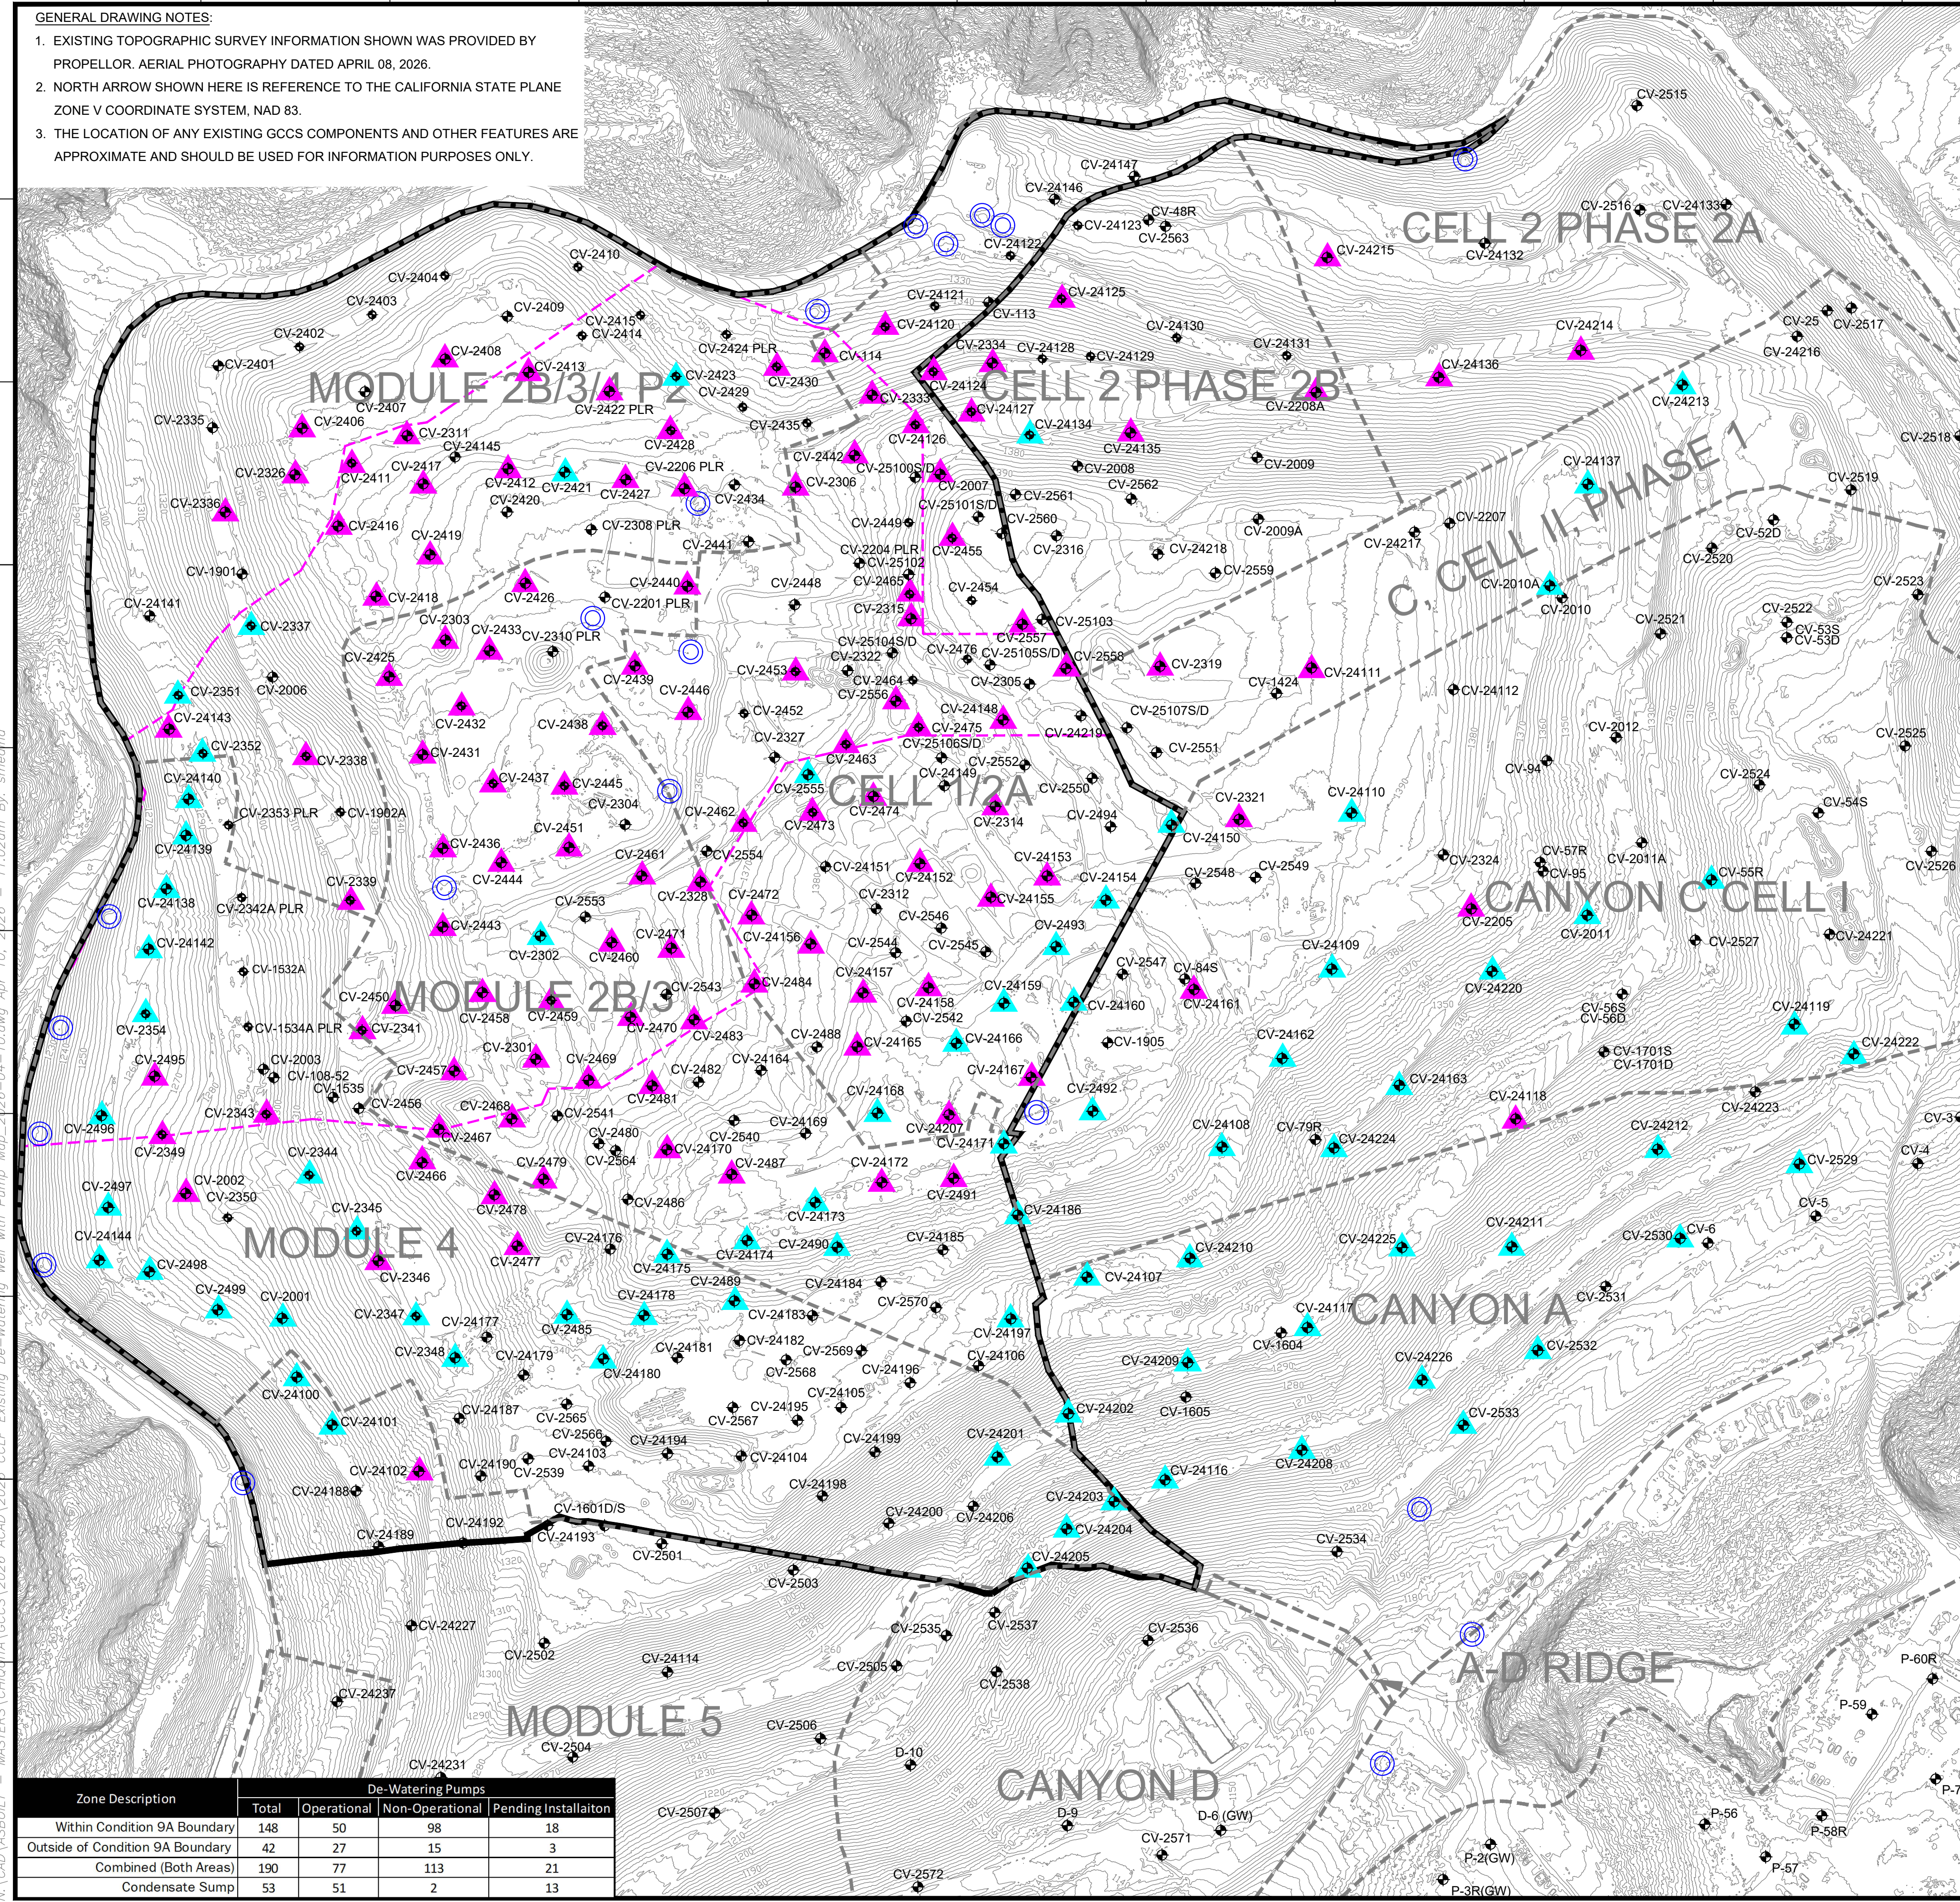

#	Well ID
1	CV-114
2	CV-2002
3	CV-2007
4	CV-2205
5	CV-2206-PLR
6	CV-2208A
7	CV-2301
8	CV-2303
9	CV-2306
10	CV-2311
11	CV-2314
12	CV-2315
13	CV-2319
14	CV-2321
15	CV-2326
16	CV-2328
17	CV-2333
18	CV-2334
19	CV-2336
20	CV-2338
21	CV-2339
22	CV-2341
23	CV-2343-PLR
24	CV-2346
25	CV-2349
26	CV-2406
27	CV-2408
28	CV-2411
29	CV-2412
30	CV-2413
31	CV-2416
32	CV-2417
33	CV-2419
34	CV-2418
35	CV-2422
36	CV-2425
37	CV-2426
38	CV-2427
39	CV-2428
40	CV-2430
41	CV-2431
42	CV-2432
43	CV-2433
44	CV-2436
45	CV-2437
46	CV-2438
47	CV-2439
48	CV-2440
49	CV-2442
50	CV-2443
51	CV-2444
52	CV-2445
53	CV-2446
54	CV-2450
55	CV-2451
56	CV-2453
57	CV-2455
58	CV-2457
59	CV-2458
60	CV-2459
61	CV-2460
62	CV-2461
63	CV-2462
64	CV-2463
65	CV-2465
66	CV-2466
67	CV-2467
68	CV-2468
69	CV-2469
70	CV-2470
71	CV-2471
72	CV-2472
73	CV-2473
74	CV-2474
75	CV-2475
76	CV-2477
77	CV-2478
78	CV-2479
79	CV-2481
80	CV-2483
81	CV-2484
82	CV-2487
83	CV-2491
84	CV-2495
85	CV-24102
86	CV-24205
87	CV-24118
88	CV-24203
89	CV-24124
90	CV-24125
91	CV-24126
92	CV-24127
93	CV-24135
94	CV-24136
95	CV-24143
96	CV-24148
97	CV-24152
98	CV-24153
99	CV-24156
100	CV-24159
101	CV-24157
102	CV-24158
103	CV-24165
104	CV-24167
105	CV-24171
106	CV-24170
107	CV-24172
108	CV-24207
109	CV-24214
110	CV-24215
111	CV-2556
112	CV-2557
113	CV-2558

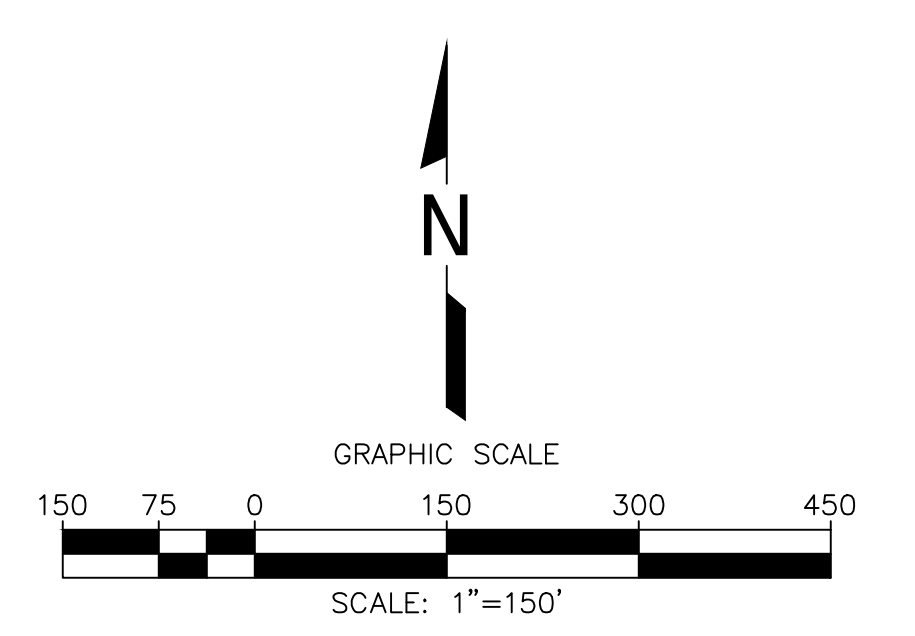

- LEGEND**
- 1150 TOPOGRAPHIC CONTOUR
 - EXISTING CELL LIMITS (APPROXIMATE)
 - REACTION AREA BOUNDARY - CONDITION 9A
 - REACTION AREA BOUNDARY - DATA ANALYSIS
 - CV-XX EXISTING VERTICAL LFG EXTRACTION WELL
 - CV-XX-PLR EXISTING LFG VERTICAL EXTRACTION WELL - PRESSURIZED LEACHATE RELEASE
 - ⊙ EXISTING CONDENSATE SUMP WITH PUMP
 - ▲ EXISTING DE-WATERING WELL WITH PUMP - CURRENTLY RUNNING
 - ▲ EXISTING DE-WATERING WELL WITH PUMP - INSTALLED

De-Watering Well Pumps that are Currently Running

#	Well ID	Operational Start Date
1	CV-2337	4/22/2024
2	CV-2302	4/26/2024
3	CV-24142	5/3/2024
4	CV-2444	5/3/2024
5	CV-2496	5/30/2024
6	CV-2497	5/30/2024
7	CV-24109	7/3/2024
8	CV-24162	7/7/2024
9	CV-24101	7/8/2024
10	CV-24100	7/17/2024
11	CV-2468	7/18/2024
12	CV-2348	7/23/2024
13	CV-2347	7/24/2024
14	CV-2345	7/27/2024
15	CV-2344	7/30/2024
16	CV-2423	8/26/2024
17	CV-24108	9/4/2024
18	CV-24210	9/10/2024
19	CV-24212	11/10/2025
20	CV-2001	1/23/2025
21	CV-24202	2/20/2025
22	CV-24209	2/28/2025
23	CV-24197	3/11/2025
24	CV-24166	4/7/2025
25	CV-24168	4/7/2025
26	CV-24171	4/7/2025
27	CV-24134	4/9/2025
28	CV-24173	4/15/2025
29	CV-24174	4/15/2025
30	CV-24175	4/15/2025
31	CV-24199	4/16/2025
32	CV-24154	4/17/2025
33	CV-2354	5/6/2025
34	CV-2493	5/6/2025
35	CV-24160	5/6/2025
36	CV-2492	5/7/2025
37	CV-24224	5/12/2025
38	CV-24117	5/13/2025
39	CV-24119	5/14/2025
40	CV-24107	5/15/2025
41	CV-24211	5/15/2025
42	CV-24137	5/15/2025
43	CV-24208	5/16/2025
44	CV-24116	5/20/2025
45	CV-24204	5/20/2025
46	CV-24205	5/20/2025
47	CV-2490	6/5/2025
48	CV-24203	6/5/2025
49	CV-24205	6/5/2025
50	CV-24186	6/10/2025
51	CV-24222	6/10/2025
52	CV-24163	6/11/2025
53	CV-24139	6/12/2025
54	CV-24140	6/14/2025
55	CV-24220	6/16/2025
56	CV-55R	6/23/2025
57	CV-24213	7/8/2025
58	CV-24150	7/9/2025
59	CV-24110	7/17/2025
60	CV-2485	8/7/2025
61	CV-24180	8/15/2025
62	CV-2489	9/4/2025
63	CV-2530	10/3/2025
64	CV-2533	10/3/2025
65	CV-2532	10/17/2025
66	CV-2529	10/18/2025
67	CV-2010A	11/24/2025
68	CV-2011A	11/24/2025
69	CV-2351	1/23/2026
70	CV-24138	1/23/2026
71	CV-2352	1/26/2026
72	CV-2499	1/27/2026
73	CV-2421	3/16/2026
74	CV-24201	3/26/2026
75	CV-24178	3/30/2026
76	CV-2555	4/1/2026
77	CV-24226	4/2/2026

Zone Description	De-Watering Pumps			
	Total	Operational	Non-Operational	Pending Installation
Within Condition 9A Boundary	148	50	98	18
Outside of Condition 9A Boundary	42	27	15	3
Combined (Both Areas)	190	77	113	21
Condensate Sump	53	51	2	13

DATE: 04/10/2026
 SCALE: AS SHOWN
 SHEET: 1

CLIENT: CHIQUITA CANYON LANDFILL
 CASTAIC, CALIFORNIA

PROJECT TITLE: CHIQUITA CANYON LANDFILL
 CASTAIC, CALIFORNIA

AGAP FILE: N:\CAD\ASBUILT-MASTERS
 DRAWN BY: SRM
 CHECKED BY: SRM