

**From:** Dylan Smith <Dylan.Smith@WasteConnections.com>  
**Sent:** Friday, April 10, 2026 6:54 PM  
**To:** Karen Gork  
**Cc:** Todd.Thalhamer@Calrecycle.ca.gov; LFrias@ph.lacounty.gov; NQuick@ph.lacounty.gov; RRagland@ph.lacounty.gov; BMcphillips@counsel.lacounty.gov; Wes.Mindermann@CalRecycle.ca.gov; mark.debie@calrecycle.ca.gov; mark.debie@calrecycle.ca.gov; emorofuji@ph.lacounty.gov; btway@ph.lacounty.gov; Relon.MarkAnthony@epa.gov; Holybee.Tyler@epa.gov; Friedli.Laura@epa.gov; John Perkey; Sarah Phillips; Gregory.Shaffer@dtsc.ca.gov; Natasha.DiPietro@dtsc.ca.gov; Gregory.Gentile@dtsc.ca.gov  
**Subject:** Chiquita Canyon Landfill – Geosynthetic Cover – Mitigation Measure 4.1  
**Attachments:** CCLF Reaction Area \_Reactive Wells\_2026-04-03.pdf; Milestone 2B Chiquita Canyon LF Isopach\_Mar.2026.pdf; RM22.1077-CCL-EVOH-FIG 1-(2026-04-10).pdf

**[EXTERNAL SENDER: Use caution with links/attachments]**

---



Below is Chiquita’s weekly update on the status of the installation of the 60-mil EVOH/HDPE geomembrane cover at the Chiquita Canyon Landfill, in accordance with Mitigation Measure 4.1 of the LEA’s Compliance Order issued May 1, 2025.

As of April 3, 2026, D&E, on behalf of Chiquita, has installed approximately 1,584,301 square feet of tan 60-mil EVOH/HDPE geomembrane cover. Of the 1,584,301 square feet deployed, approximately 212,001 square feet has been deployed on the west slope and in the area known as “the bowl,” as illustrated in the attached map. Wet weather conditions on April 1, 2026 prevented deployment of additional EVOH/HDPE geomembrane cover that day. Work conducted that week also included repairs and detailing of existing panels, including boot fabrication, patching, extrusion welding, and re-seaming, as needed. Work continued during the week of April 6, 2026.

The attached site map shows the approximate extent of geomembrane cover installed as of Wednesday, April 8, 2026, as well as the geomembrane coverage described in the revised draft workplan for extension of the geomembrane cover area submitted to the LEA, the US EPA, and DTSC on March 13, 2026. Also attached to this submission are the March 2026 monthly isopach map and a figure identifying wells showing signs of reaction as of April 3, 2026. Due to technical limitations, we are currently unable to create one figure including all of this data.

Thanks,

Dylan Smith

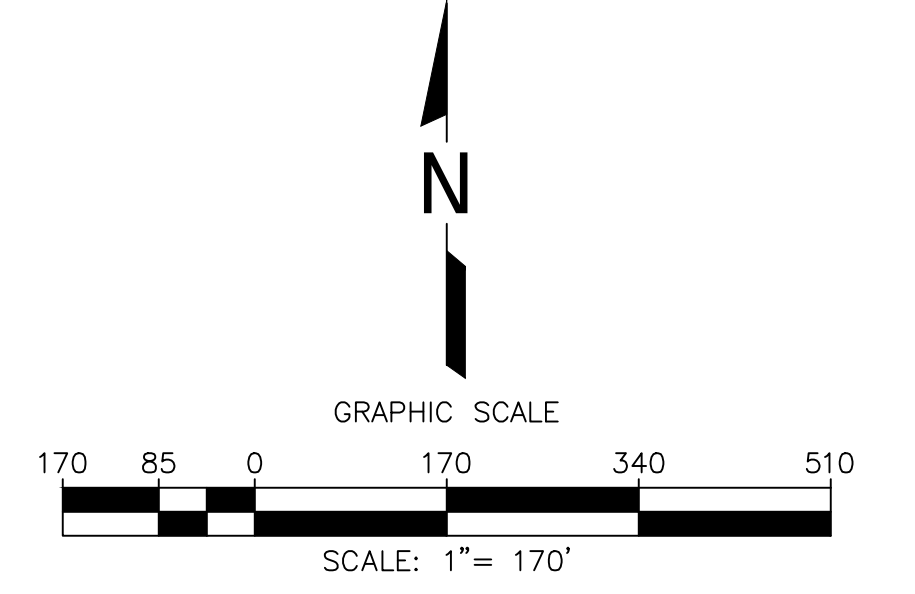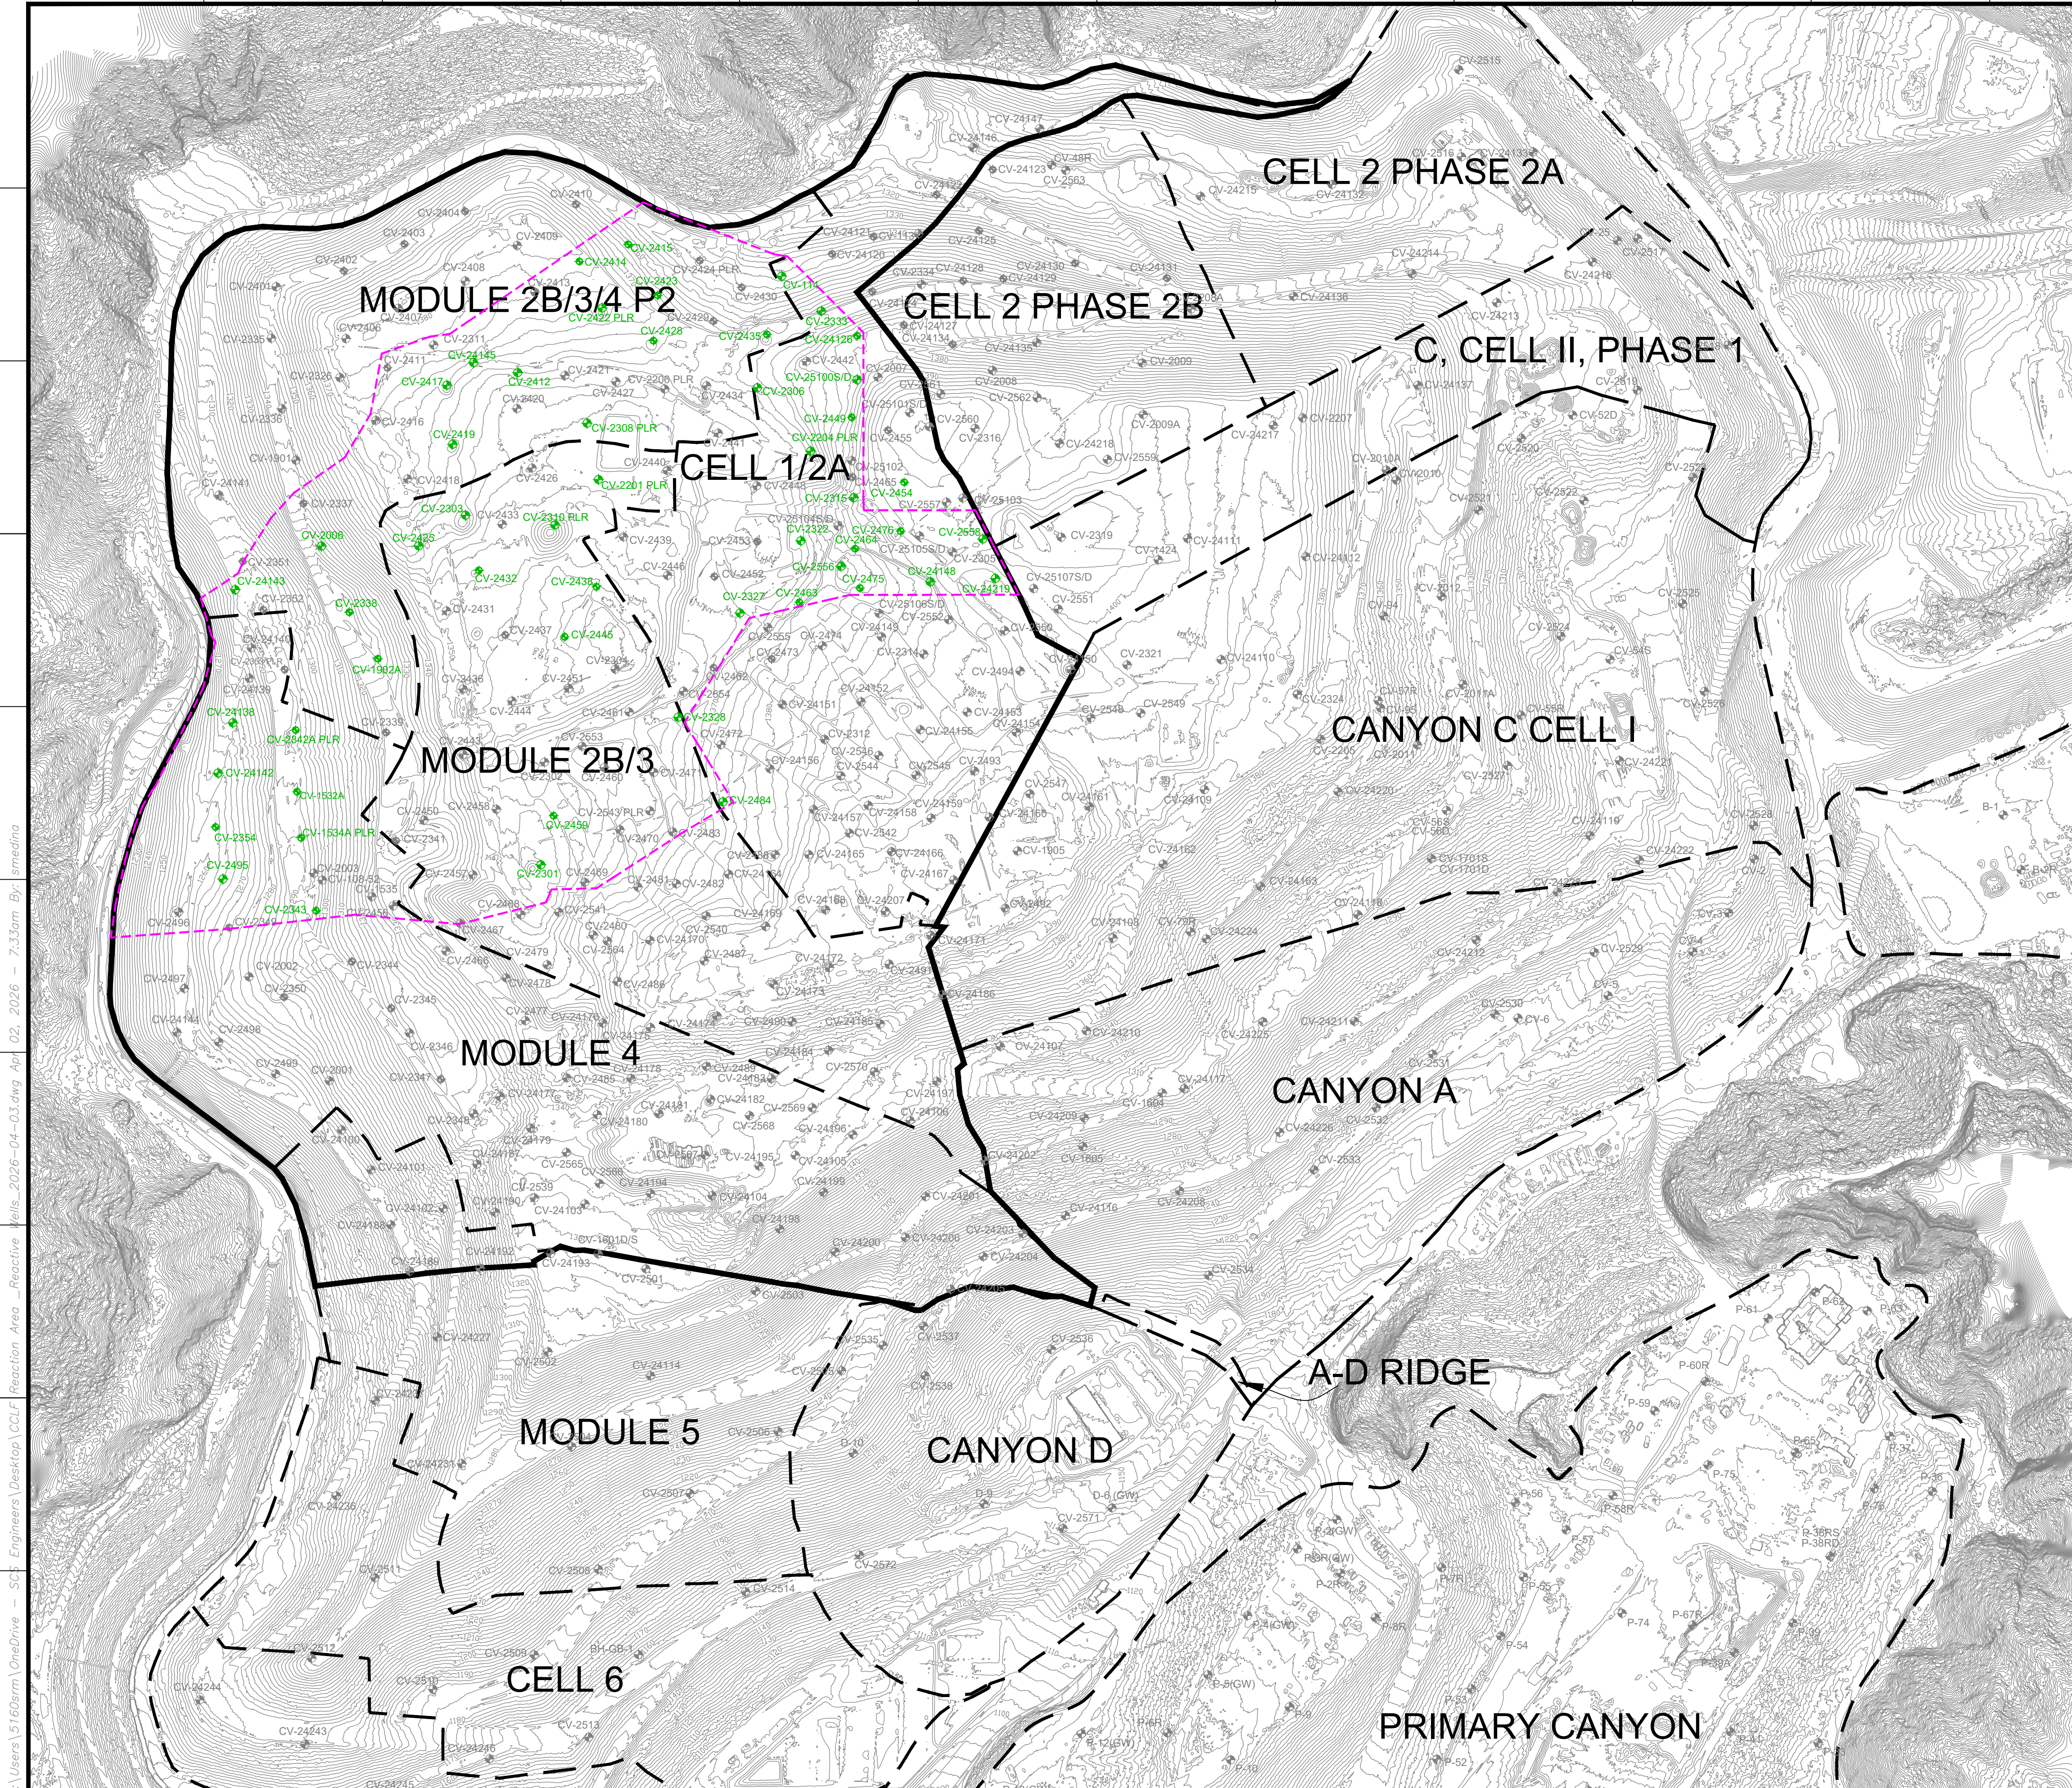

**LEGEND**

|  |   |
|--|---|
|  | EXISTING TOPOGRAPHIC CONTOUR                          |
|  | EXISTING CELL LIMITS (APPROXIMATE)                    |
|  | EXISTING VERTICAL WELLS                               |
|  | EXISTING VERTICAL WELL - PRESSURIZED LEACHATE RELEASE |
|  | EXISTING VERTICAL WELLS - REACTIVE                    |
|  | REACTION AREA BOUNDARY (APPROXIMATE)                  |
|  | REACTION AREA BOUNDARY - CONDITION 9A                 |


|                |   |
|----------------|---|
| DATE           |   |
| REVISION       |   |
| NO.            |   |
| SHEET TITLE:   | REACTION AREA MAP                               |
| PROJECT TITLE: | CHICUITA CANYON LANDFILL<br>CASTAIC, CALIFORNIA |
| CLIENT:        | CHICUITA CANYON LANDFILL<br>CASTAIC, CALIFORNIA |
| DATE:          | 04/03/2026                                      |
| SCALE:         | AS SHOWN  |
| SHEET:         | 1   |

**GENERAL DRAWING NOTES:**

- EXISTING TOPOGRAPHIC SURVEY INFORMATION SHOWN WAS PROVIDED BY PROPELLER. AERIAL PHOTOGRAPHY DATED MARCH 18, 2026.
- NORTH ARROW SHOWN HERE IS REFERENCE TO THE CALIFORNIA STATE PLANE ZONE V COORDINATE SYSTEM, NAD 83.


C:\Users\5160sr\OneDrive - SCS Engineers\Desktop\CCGF Reaction Area - Reactive Wells\_2026-04-03.dwg Apr 02, 2026 - 7:33am By: smedina

# Chiquita Canyon Landfill -Isopach

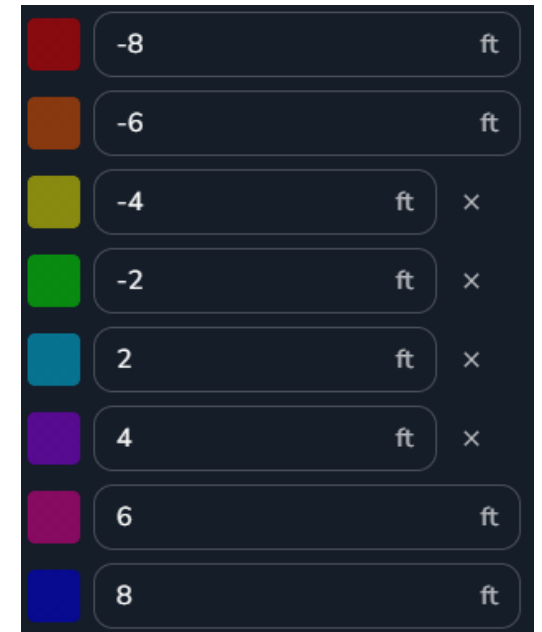

March 25, 2026 Survey Image. March 04, 2026 vs March 25, 2026

P:\SITES\CHIQUITA\_CYN\_LF\_MONITORING\_SUMMARY\FIGURES-WEEKLY\RM22.1077-CCL-EVOH-FIG 1-(2026-04-10).DWG April 10, 2026 - 10:07 AM BY: GLA-USER


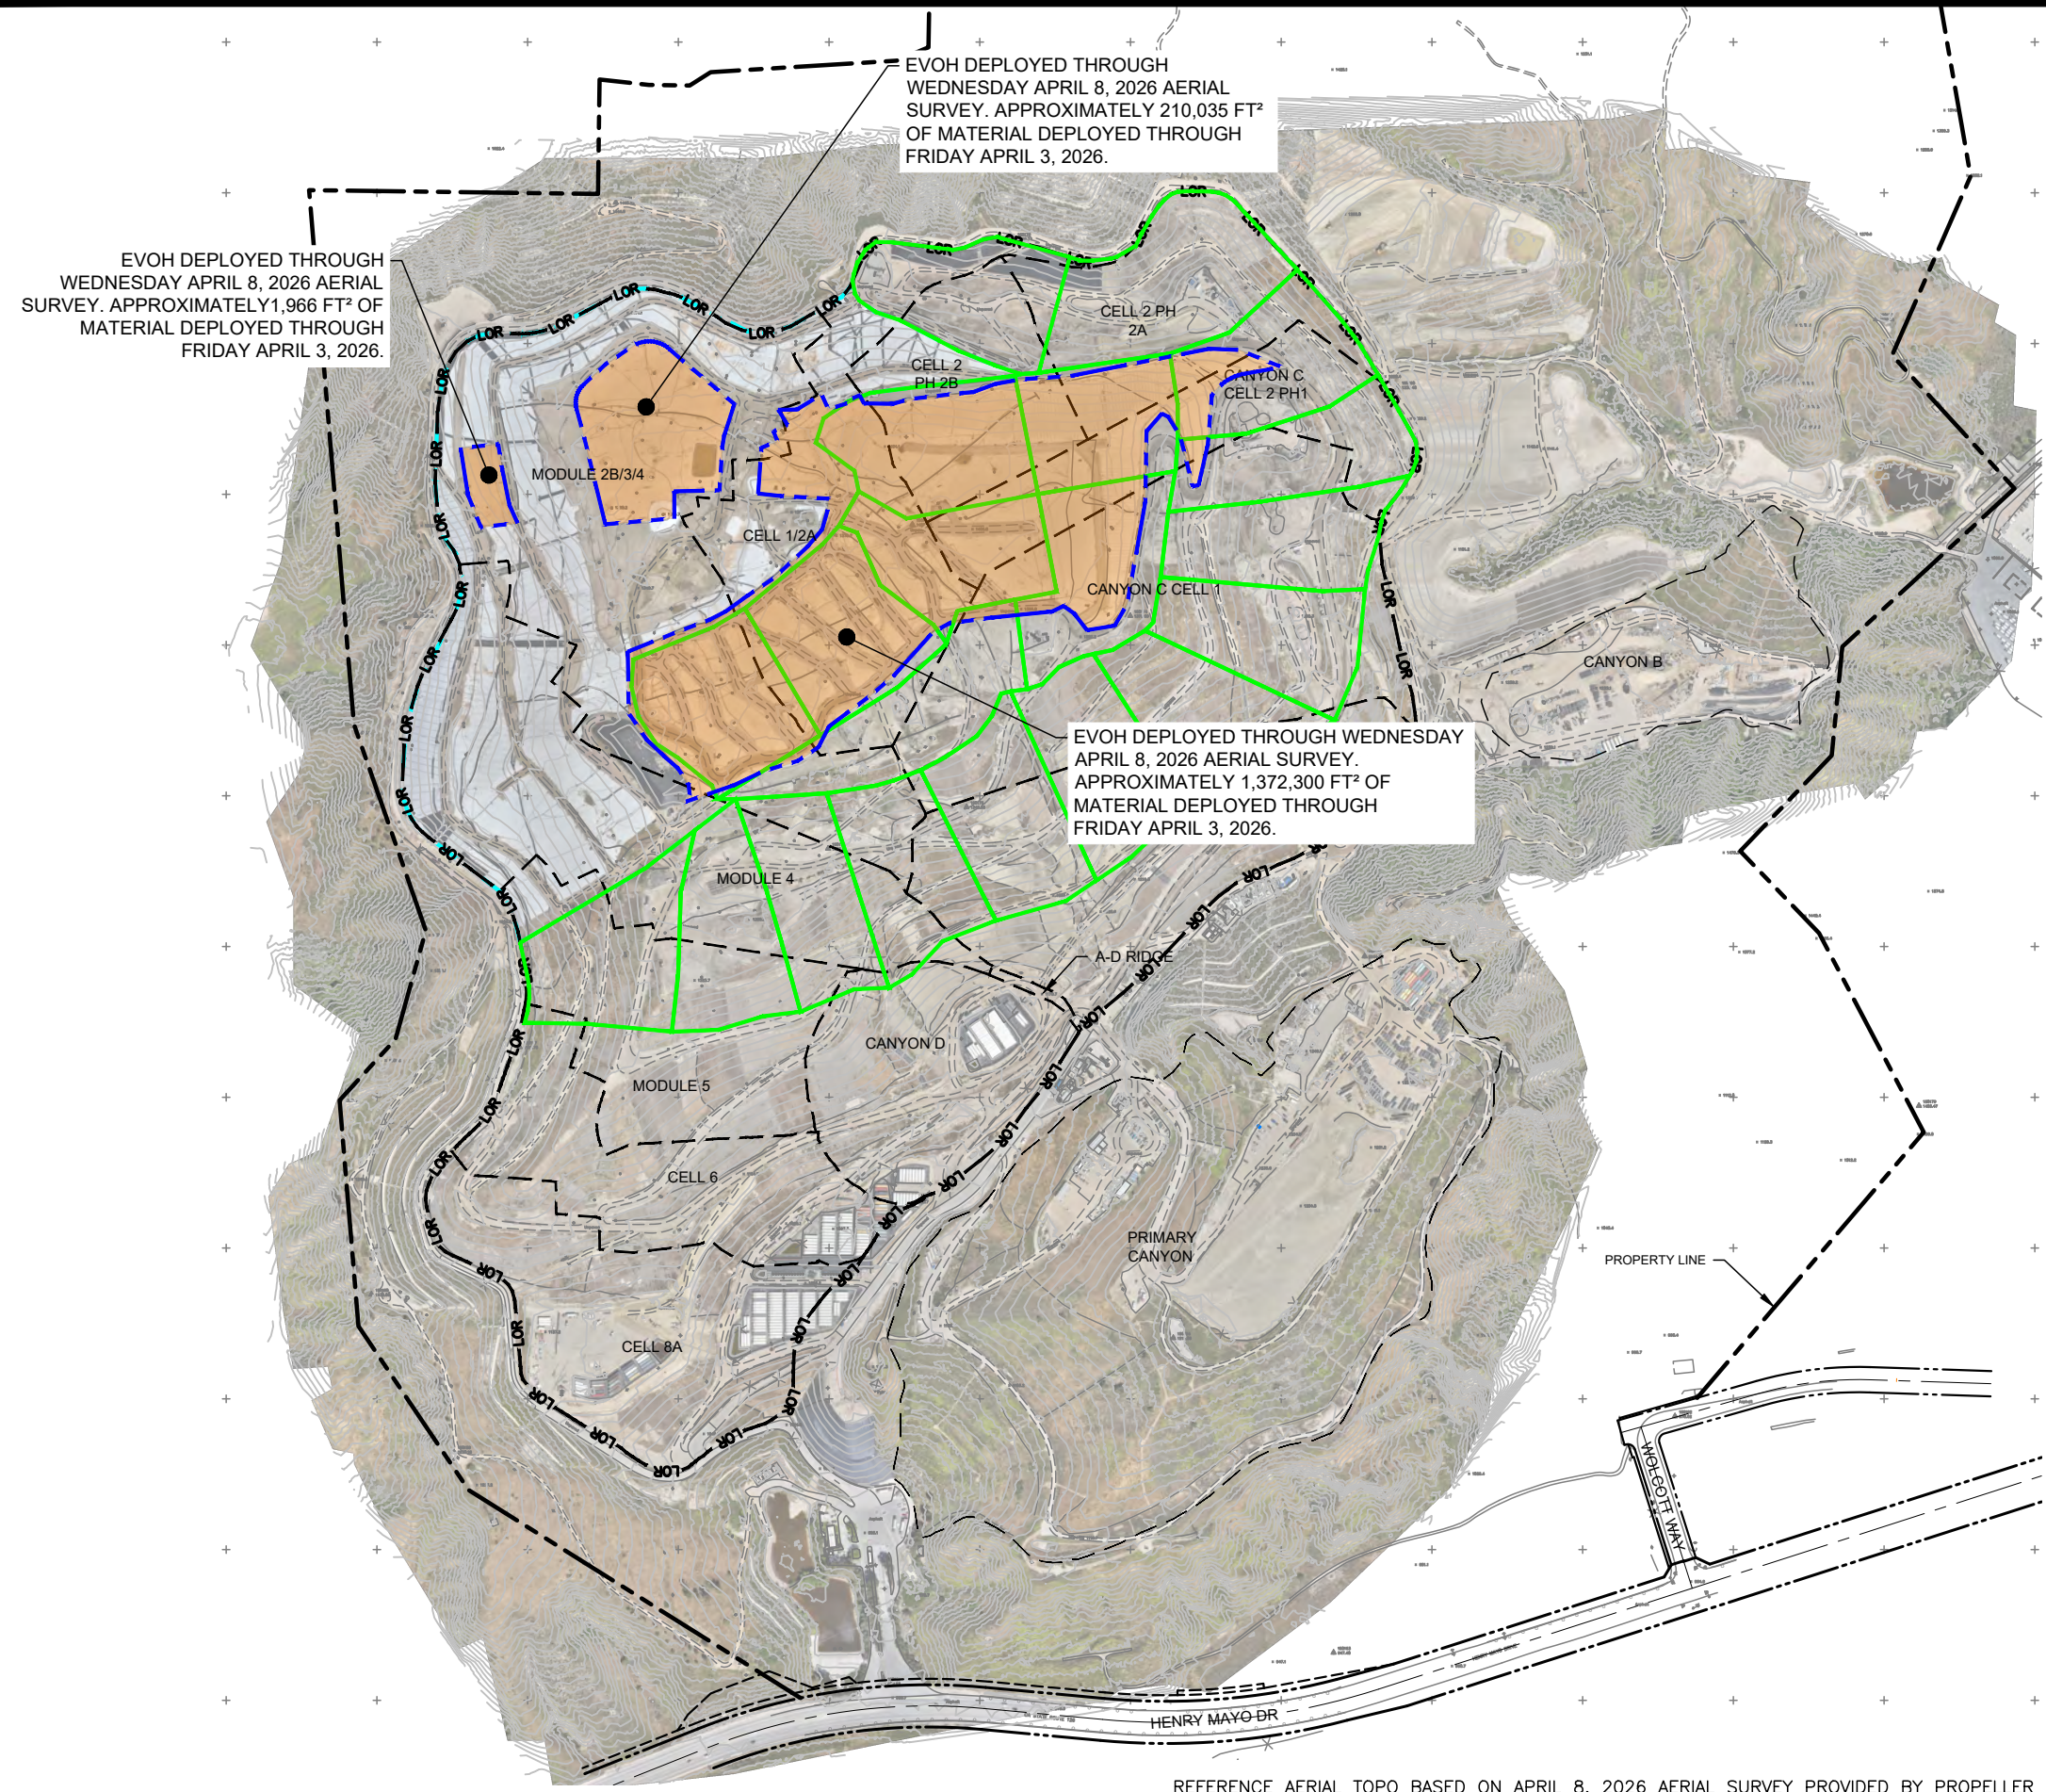


**LEGEND:**

- PROPERTY LINE
- APPROXIMATE LIMIT OF REFUSE
- CELL LIMIT
- EXISTING GEOMEMBRANE DEPLOYMENT AREA
- INITIAL SUPPLEMENTAL GEOMEMBRANE DEPLOYMENT AREA
- SUBSEQUENT SUPPLEMENTAL GEOMEMBRANE AREA

**NOTE:**

1. EXISTING GEOMEMBRANE DEPLOYMENT AREA IS APPROXIMATELY 48.3 ACRES.
2. EXISTING GEOMEMBRANE IS 30-MIL HDPE, EXCEPT FOR 1.3 ACRES OF 40-MIL HDPE.
3. EACH PROPOSED DEPLOYMENT AREA IS APPROXIMATELY 5 ACRES.
4. NEW GEOMEMBRANE WILL BE 60-MIL HDPE WITH AN INTERNAL CORE EVOH RESIN BARRIER.

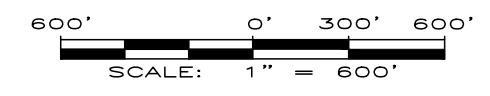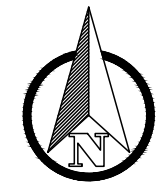

**FIGURE 1**  
**APPROXIMATE LIMITS OF**  
**EVOH GEOMEMBRANE**  
**CHIQUITA CANYON LANDFILL**  
**CASTAIC, CA**



DRAWN BY: LP/RM    DATE: APRIL 2026    JOB NO.: RM22.1077

REFERENCE AERIAL TOPO BASED ON APRIL 8, 2026 AERIAL SURVEY PROVIDED BY PROPELLER