

---

**From:** Han, Jessie <JHan@scsengineers.com>  
**Sent:** Friday, June 5, 2026 6:32 PM  
**To:** Baitong Chen; Christina Ojeda; Nathaniel Dickel  
**Cc:** Chris Fear; Viswanathan, Srividhya; Mark.Adams; Dylan Smith; Sarah Phillips; Huber, Rachele; Bill Haley; Medina, Steven  
**Subject:** Case No. 6177-4 Stipulated Order for Abatement - Weekly Pump Installation and Operation Update  
**Attachments:** 2026 CCLF Existing De-Watering Well with Pump Map\_2026-06-05.pdf

[EXTERNAL SENDER: Use caution with links/attachments]

---

Hi All,

In accordance with Condition 65 of the Modified Stipulated Order, below is the summary of the installation and operation of dewatering pumps for the Chiquita Canyon Landfill. This information is subject to change based on further review and verification.

During 05/29/2026 to 06/04/2026, Chiquita completed the installation of, and began operating during the day, twenty-one (21) new pumps in a vertical LFG extraction well for a total of one hundred twenty-seven (127) pumps operating in vertical LFG extraction wells. Additionally, five (5) pumps were taken offline last week, and twenty-one (21) new pumps became operational, leading to a net increase of sixteen (16) pumps. The number of pumps offline is higher than usual due in large part to reduced off-site leachate disposal capacity and the ongoing EVOH/HDPE geomembrane cover deployment. Please note that Chiquita has additional pumps in operation in perimeter sumps that are not included in this count.

During 06/05/2026 to 06/11/2026, given the number of dewatering pumps installed to date, and the maintenance associated with those pumps, Chiquita plans to install and begin operating zero (0) additional pumps in vertical LFG extraction wells in locations along the north and south slope of the reaction area. Pump installation will resume once the existing pumps are turned back on, subject to disposal outlet capacity.


Jessie Han  
Project Manager  
**SCS Engineers**  
3900 Kilroy Airport Way, Suite 300  
Long Beach, CA 90806  
Mobile: 562-508-2497  
[JHan@scsengineers.com](mailto:JHan@scsengineers.com)

**Driven by Client Success**  
[www.scsengineers.com](http://www.scsengineers.com)


**GENERAL DRAWING NOTES:**

- EXISTING TOPOGRAPHIC SURVEY INFORMATION SHOWN WAS PROVIDED BY PROPELLOR. AERIAL PHOTOGRAPHY DATED MAY 06, 2026.
- NORTH ARROW SHOWN HERE IS REFERENCE TO THE CALIFORNIA STATE PLANE ZONE V COORDINATE SYSTEM, NAD 83.
- THE LOCATION OF ANY EXISTING GCCS COMPONENTS AND OTHER FEATURES ARE APPROXIMATE AND SHOULD BE USED FOR INFORMATION PURPOSES ONLY.

A  
B  
C  
D  
E  
F  
G  
H  
J

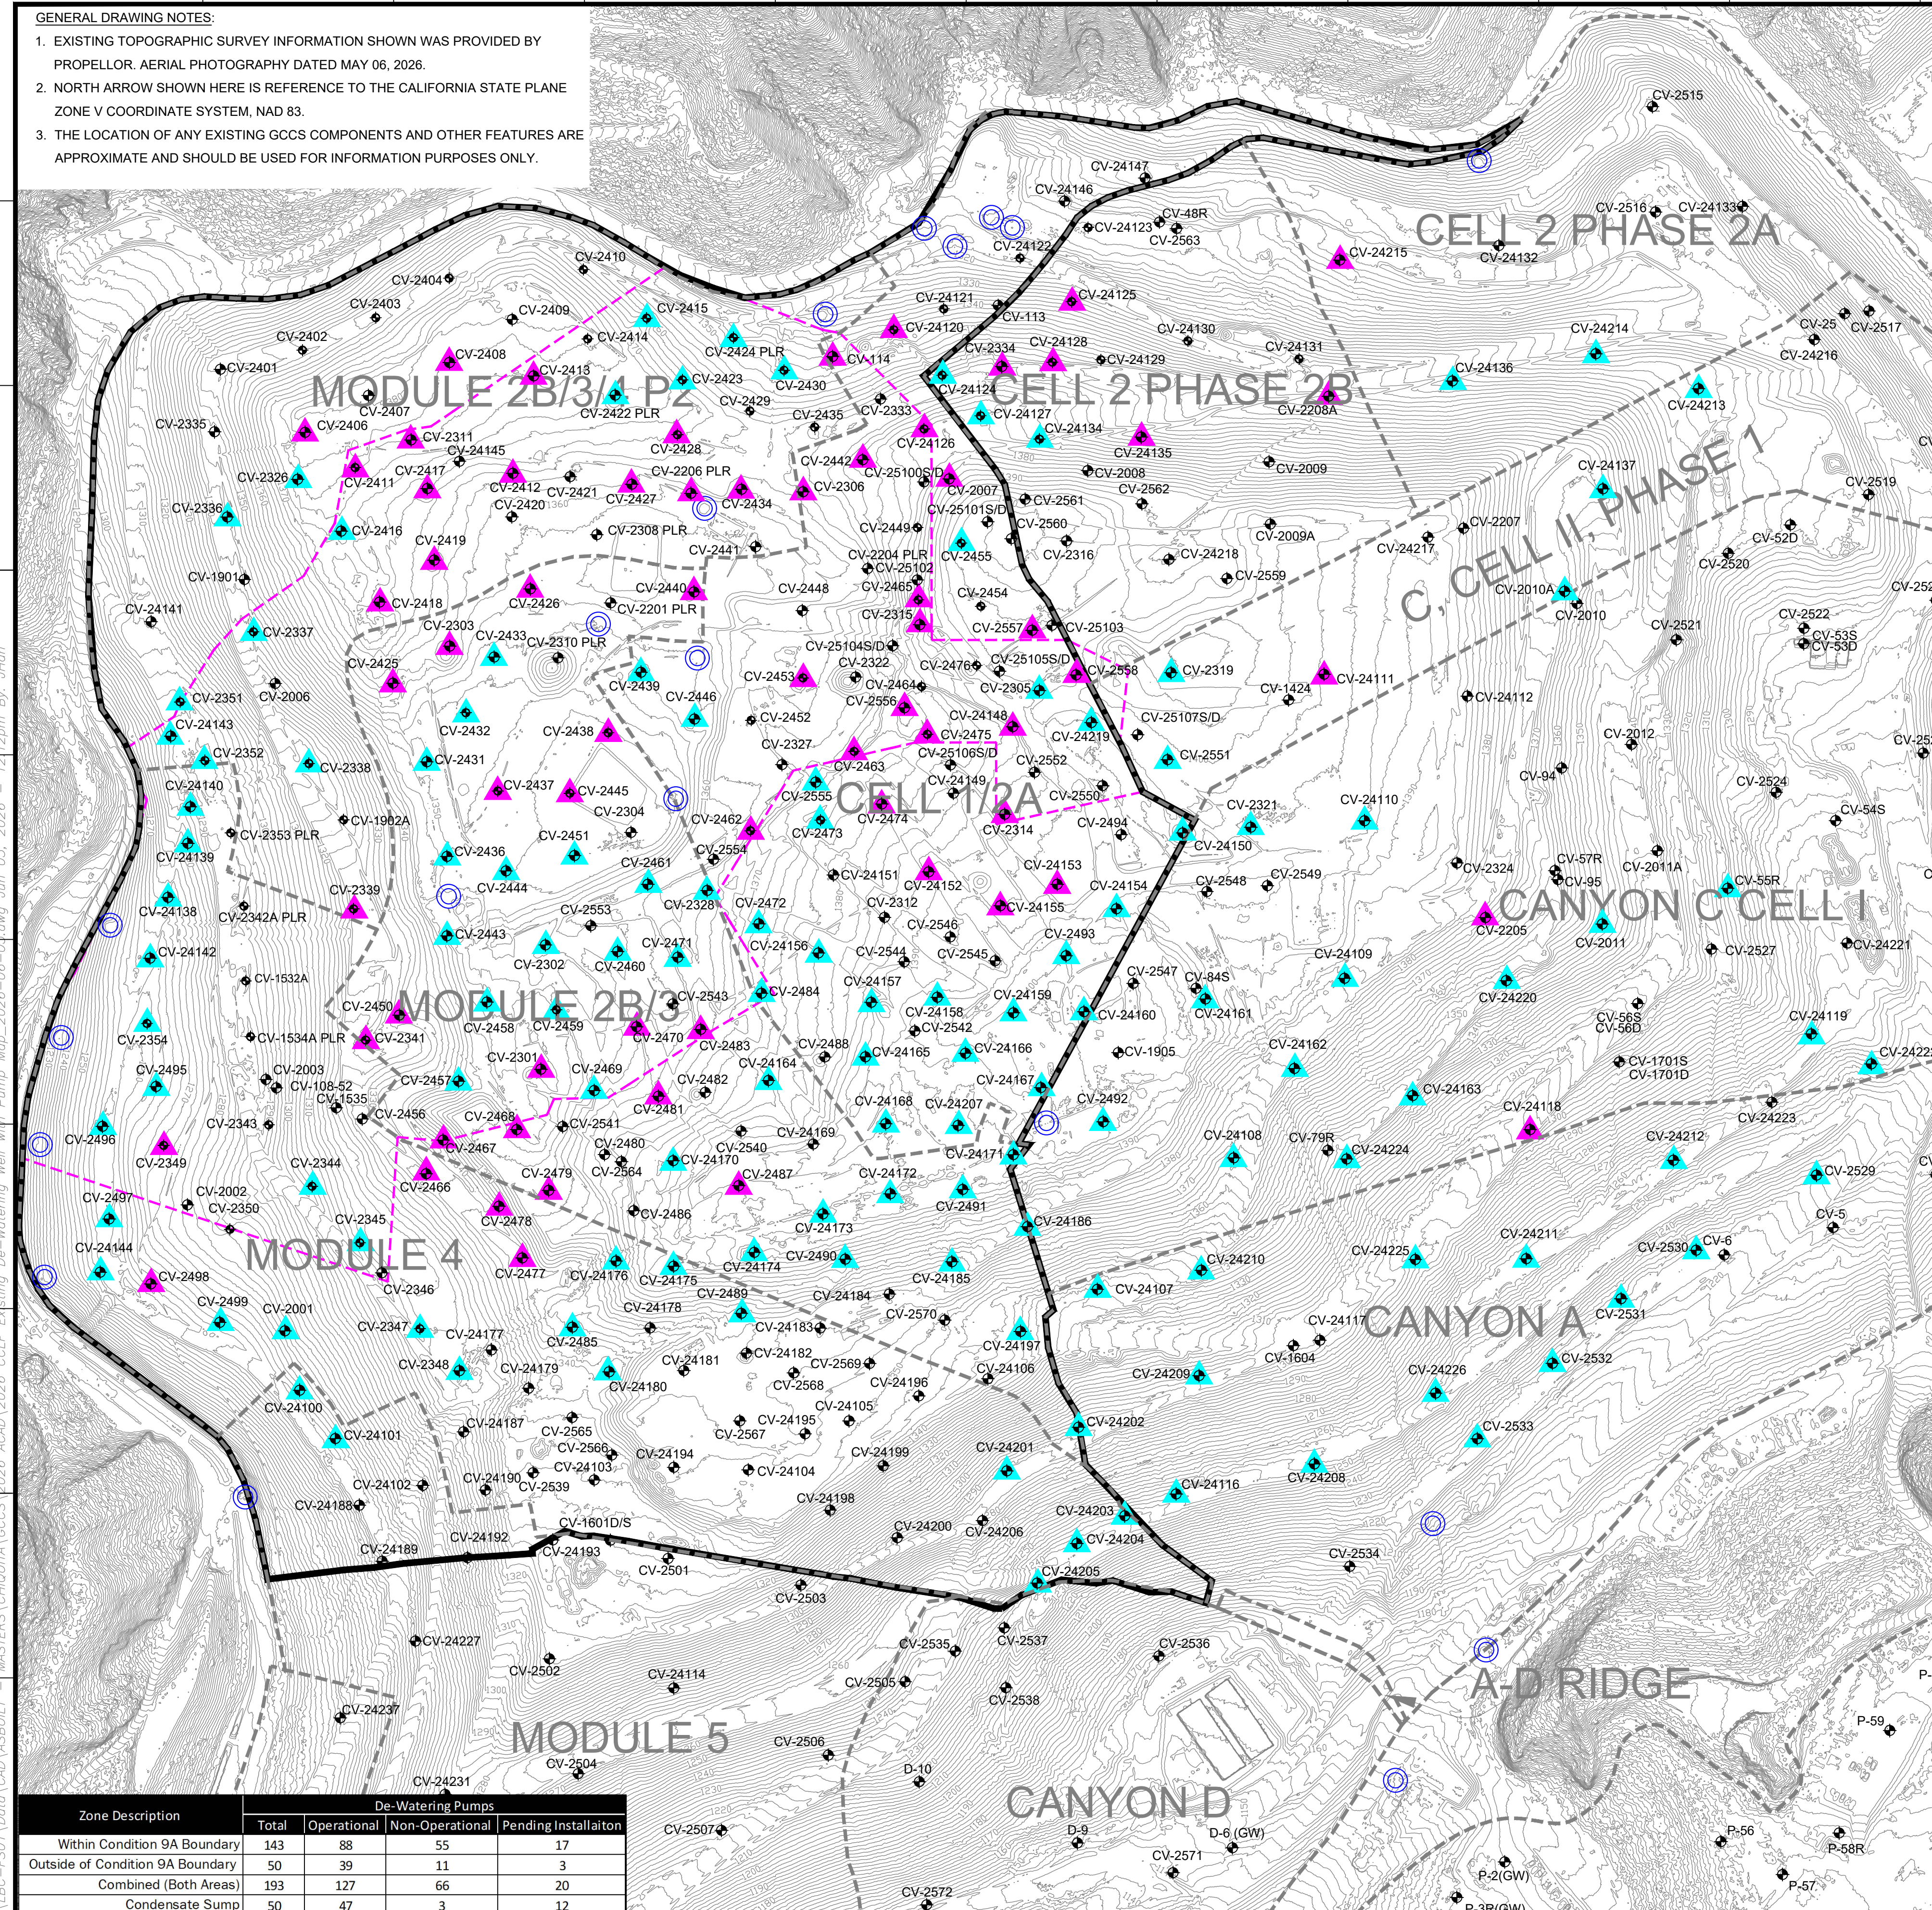

#	Well I.D.	Operational Start/Up Date
1	CV-2337	4/22/2024
2	CV-2302	4/26/2024
3	CV-2328	4/26/2024
4	CV-2336	4/30/2024
5	CV-24142	5/3/2024
6	CV-24144	5/13/2024
7	CV-2496	5/30/2024
8	CV-2497	5/30/2024
9	CV-2416	6/24/2024
10	CV-24109	7/3/2024
11	CV-24162	7/7/2024
12	CV-24101	7/8/2024
13	CV-24100	7/17/2024
14	CV-2348	7/22/2024
15	CV-2347	7/24/2024
16	CV-2345	7/27/2024
17	CV-2344	7/30/2024
18	CV-24124	8/24/2024
19	CV-2423	8/26/2024
20	CV-24108	9/4/2024
21	CV-24210	9/10/2024
22	CV-2451	12/23/2024
23	CV-2432	1/7/2025
24	CV-24212	1/10/2025
25	CV-2001	1/23/2025
26	CV-2338	2/8/2025
27	CV-24202	2/20/2025
28	CV-24209	2/28/2025
29	CV-24197	3/11/2025
30	CV-24166	4/7/2025
31	CV-24168	4/7/2025
32	CV-24171	4/7/2025
33	CV-24165	4/7/2025
34	CV-24134	4/9/2025
35	CV-24173	4/15/2025
36	CV-24174	4/15/2025
37	CV-24175	4/15/2025
38	CV-24159	4/16/2025
39	CV-24154	4/17/2025
40	CV-24214	5/2/2025
41	CV-2354	5/6/2025
42	CV-2493	5/6/2025
43	CV-24160	5/6/2025
44	CV-2402	5/7/2025
45	CV-24161	5/8/2025
46	CV-24224	5/12/2025
47	CV-24119	5/14/2025
48	CV-24107	5/15/2025
49	CV-24211	5/15/2025
50	CV-24137	5/15/2025
51	CV-24208	5/16/2025
52	CV-24116	5/20/2025
53	CV-24204	5/20/2025
54	CV-24205	5/20/2025
55	CV-2490	6/5/2025
56	CV-24203	6/8/2025
57	CV-24225	6/9/2025
58	CV-24207	6/9/2025
59	CV-24186	6/10/2025
60	CV-24222	6/10/2025
61	CV-24163	6/11/2025
62	CV-2439	6/12/2025
63	CV-24143	6/12/2025
64	CV-24139	6/12/2025
65	CV-24140	6/14/2025
66	CV-24220	6/16/2025
67	CV-2436	6/23/2025
68	CV-2444	6/23/2025
69	CV-55R	6/23/2025
70	CV-24213	7/9/2025
71	CV-24150	7/9/2025
72	CV-2319	7/9/2025
73	CV-24219	7/9/2025
74	CV-24110	7/17/2025
75	CV-2485	8/7/2025
76	CV-2489	9/4/2025
77	CV-2431	9/18/2025
78	CV-2530	10/3/2025
79	CV-2533	10/3/2025
80	CV-2532	10/17/2025
81	CV-2529	10/18/2025
82	CV-2010A	11/24/2025
83	CV-2011A	11/24/2025
84	CV-2551	12/30/2025
85	CV-2351	1/23/2026
86	CV-24138	1/23/2026
87	CV-2352	1/26/2026
88	CV-2499	1/27/2026
89	CV-2455	2/28/2026
90	CV-2495	2/28/2026
91	CV-24167	3/4/2026
92	CV-24165	3/19/2026
93	CV-24201	3/26/2026
94	CV-2430	3/31/2026
95	CV-2555	4/1/2026
96	CV-24226	4/2/2026
97	CV-24176	4/3/2026
98	CV-2422	4/6/2026
99	CV-2321	4/10/2026
100	CV-2433	4/11/2026
101	CV-2446	4/11/2026
102	CV-2457	4/11/2026
103	CV-2459	4/11/2026
104	CV-2424	4/13/2026
105	CV-2305	4/15/2026
106	CV-24172	4/16/2026
107	CV-2415	4/22/2026
108	CV-2531	4/29/2026
109	CV-24127	5/21/2026
110	CV-24180	5/29/2026
111	CV-2443	6/1/2026
112	CV-2472	6/1/2026
113	CV-24156	6/1/2026
114	CV-24157	6/1/2026
115	CV-24170	6/2/2026
116	CV-2459	6/2/2026
117	CV-2480	6/2/2026
118	CV-2461	6/2/2026
119	CV-2469	6/2/2026
120	CV-2471	6/3/2026
121	CV-2326	6/3/2026
122	CV-2473	6/3/2026
123	CV-2484	6/3/2026
124	CV-2491	6/3/2026
125	CV-24136	6/3/2026
126	CV-24158	6/3/2026
127	CV-24164	6/3/2026

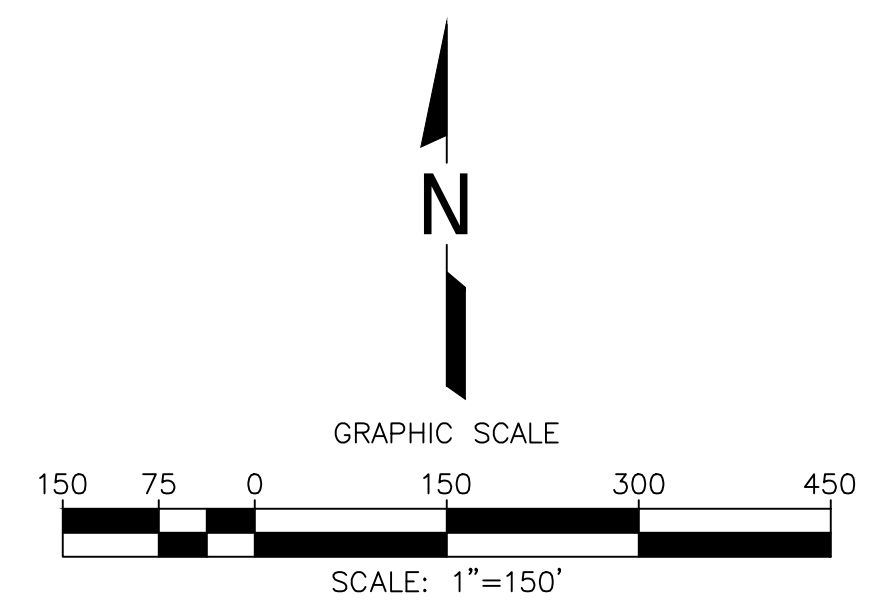

- LEGEND**
- 1150 TOPOGRAPHIC CONTOUR
  - EXISTING CELL LIMITS (APPROXIMATE)
  - REACTION AREA BOUNDARY - CONDITION 9A
  - REACTION AREA BOUNDARY - DATA ANALYSIS
  - ⊕ CV-XX EXISTING VERTICAL LFG EXTRACTION WELL
  - ⊕ CV-XX PLR EXISTING LFG VERTICAL EXTRACTION WELL - PRESSURIZED LEACHATE RELEASE
  - ⊙ EXISTING CONDENSATE SUMP WITH PUMP
  - ▲ EXISTING DE-WATERING WELL WITH PUMP - CURRENTLY RUNNING
  - ▲ EXISTING DE-WATERING WELL WITH PUMP - INSTALLED

De-Watering Well Pumps That Are Currently Installed and Not in Operation

#	Well I.D.
1	CV-114
2	CV-2007
3	CV-2206-PLR
4	CV-2208A
5	CV-2301
6	CV-2303
7	CV-2306
8	CV-2311
9	CV-2314
10	CV-2315
11	CV-2334
12	CV-2339
13	CV-2341
14	CV-2349
15	CV-2406
16	CV-2408
17	CV-2411
18	CV-2412
19	CV-2413
20	CV-2417
21	CV-2419
22	CV-2418
23	CV-2425
24	CV-2426
25	CV-2427
26	CV-2428
27	CV-2434
28	CV-2437
29	CV-2438
30	CV-2440
31	CV-2442
32	CV-2450
33	CV-2453
34	CV-2462
35	CV-2463
36	CV-2465
37	CV-2466
38	CV-2467
39	CV-2468
40	CV-2470
41	CV-2474
42	CV-2475
43	CV-2477
44	CV-2478
45	CV-2479
46	CV-2481
47	CV-2483
48	CV-2487
49	CV-2498
50	CV-24111
51	CV-24118
52	CV-24120
53	CV-24125
54	CV-24126
55	CV-24128
56	CV-24135
57	CV-24148
58	CV-24152
59	CV-24153
60	CV-24155
61	CV-24159
62	CV-24163
63	CV-24165
64	CV-24166
65	CV-24168
66	CV-24173
67	CV-24175
68	CV-24176
69	CV-24177
166	CV-24274

DATE:	
REVISION:	
NO.	
SHEET TITLE:	EXISTING DE-WATERING WELL WITH PUMP MAP
PROJECT TITLE:	CHIQUITA CANYON LANDFILL CASTAIC, CALIFORNIA
CLIENT:	CHIQUITA CANYON LANDFILL CASTAIC, CALIFORNIA
ACAD FILE:	N:\CAD\ASBUILT-MASTERS
APP. BY:	
CHK. BY:	
DATE:	06/05/2026
SCALE:	AS SHOWN
SHEET:	1

Zone Description	De-Watering Pumps			
	Total	Operational	Non-Operational	Pending Installation
Within Condition 9A Boundary	143	88	55	17
Outside of Condition 9A Boundary	50	39	11	3
Combined (Both Areas)	193	127	66	20
Condensate Sump	50	47	3	12