

---

**From:** Medina, Steven <SMedina@scsengineers.com>  
**Sent:** Friday, June 5, 2026 7:30 AM  
**To:** Nathaniel Dickel; Christina Ojeda; Baitong Chen  
**Cc:** Han, Jessie; Huber, Rachelle; Bill Haley; Viswanathan, Srividhya; Jones, Art; Mark.Adams; Dylan Smith; Matt Breuer; Sarah Phillips  
**Subject:** Case No. 6177-4 Stipulated Order for Abatement – Well Drilling Update  
**Attachments:** 2025 CCLF GCCS Expan Master Plan\_Proposed LFG Extraction Well and Temp Probe Map\_2026-06-05.pdf

[EXTERNAL SENDER: Use caution with links/attachments]

---

All,

Chiquita submits this update pursuant to Condition 15(c) of the Stipulated Order. From December 6, 2023 (the start date of the GCCS Master Expansion) through today, Chiquita has installed a total of three hundred fifteen (315) vertical LFG extraction wells.

No vertical extraction wells were installed last week, and none are currently scheduled for drilling next week. Chiquita is continuing to evaluate site needs and will schedule additional drilling as appropriate.



For reference, the attached figure depicts the wells installed to date.

Regards,

**STEVEN** Ruben Medina, **E.I.T.**  
Project Professional  
**SCS Engineers**  
3900 Kilroy Airport Way, Suite 300  
Long Beach, CA 90806  
858-204-4342 (c)  
[SMedina@scsengineers.com](mailto:SMedina@scsengineers.com)

**Driven by Client Success**  
[www.scsengineers.com](http://www.scsengineers.com)



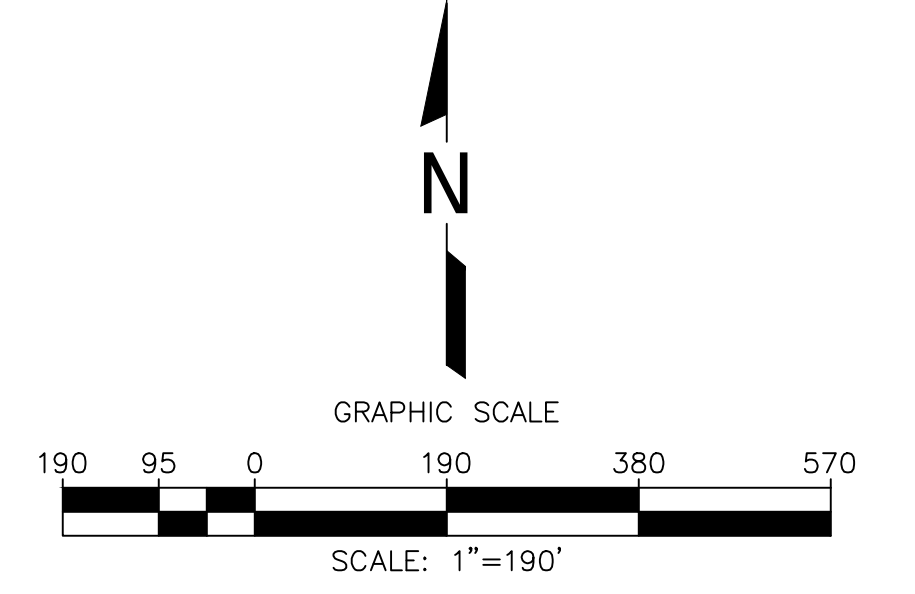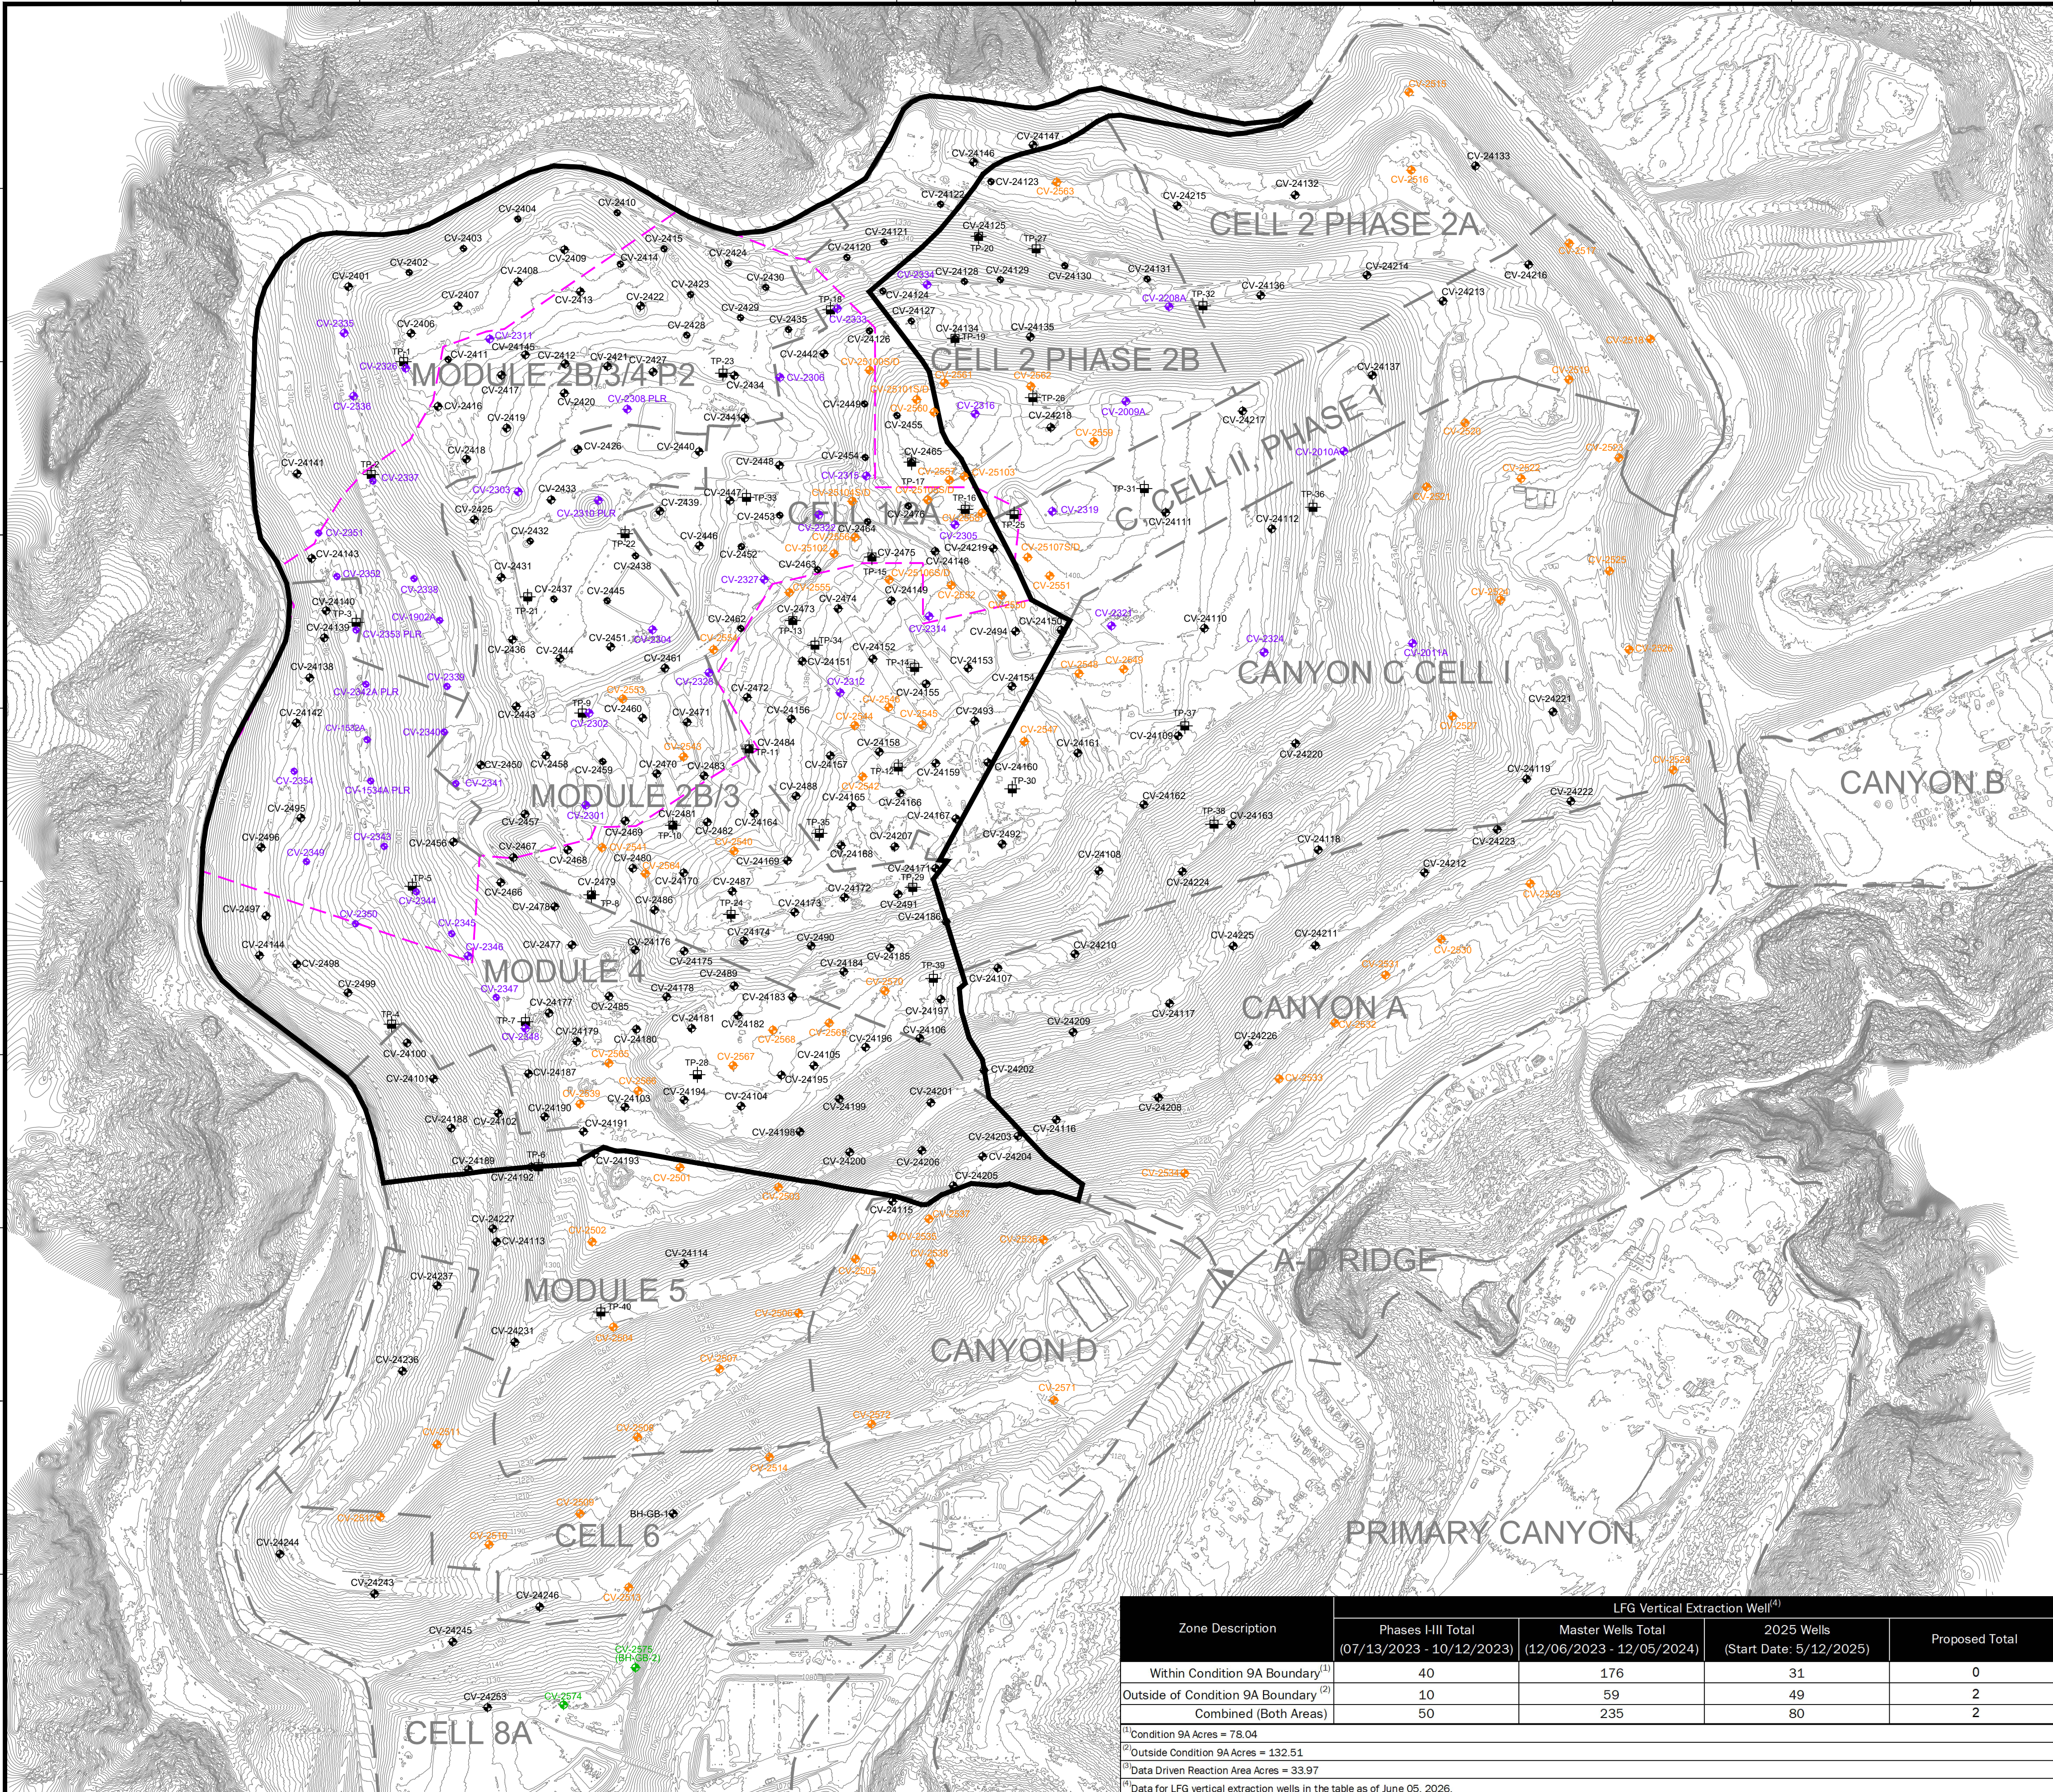

- LEGEND**
- EXISTING TOPOGRAPHIC CONTOUR
  - EXISTING CELL LIMITS (APPROXIMATE)
  - REACTION AREA BOUNDARY (APPROXIMATE) - BASED ON DATA REVIEW
  - REACTION AREA BOUNDARY - CONDITION 9A
  - EXISTING PHASES I-III LFG EXTRACTION WELL - INSTALLED
  - EXISTING MASTER LFG EXTRACTION WELL - INSTALLED
  - EXISTING 2025 LFG EXTRACTION WELL - INSTALLED
  - PROPOSED LFG EXTRACTION WELL
  - EXISTING TEMPERATURE PROBE - INSTALLED

NO.	REVISION	DATE

SHEET TITLE: WELL/TEMPERATURE PROBE INSTALLATION MAP  
 PROJECT TITLE: 2025 GCCS EXPANSION WELL & TEMPERATURE PROBE MASTER PLAN  
 CHIQUITA CANYON LANDFILL  
 CASTAIC, CALIFORNIA



DATE: 06/05/2026  
 SCALE: AS SHOWN  
 SHEET: 1

Zone Description	LFG Vertical Extraction Well <sup>(4)</sup>			
	Phases I-III Total (07/13/2023 - 10/12/2023)	Master Wells Total (12/06/2023 - 12/05/2024)	2025 Wells (Start Date: 5/12/2025)	Proposed Total
Within Condition 9A Boundary <sup>(1)</sup>	40	176	31	0
Outside of Condition 9A Boundary <sup>(2)</sup>	10	59	49	2
Combined (Both Areas)	50	235	80	2

<sup>(1)</sup> Condition 9A Acres = 78.04  
<sup>(2)</sup> Outside Condition 9A Acres = 132.51  
<sup>(3)</sup> Data Driven Reaction Area Acres = 33.97  
<sup>(4)</sup> Data for LFG vertical extraction wells in the table as of June 05, 2026.

**GENERAL DRAWING NOTES:**  
 1. EXISTING TOPOGRAPHIC SURVEY INFORMATION SHOWN WAS PROVIDED BY PROPELLER. AERIAL PHOTOGRAPHY DATED MAY 06, 2026.  
 2. NORTH ARROW SHOWN HERE IS REFERENCE TO THE CALIFORNIA STATE PLANE ZONE V COORDINATE SYSTEM, NAD 83.