

Revised Final Construction Report

2024 – 2025 Temperature Monitoring Probe Installation at the Chiquita Canyon Landfill Castaic, California

Mr. William Haley
Chiquita Canyon, LLC
29201 Henry Mayo Drive
Castaic, CA 91384

SCS ENGINEERS

01204123.45 | June 6, 2026

3900 Kilroy Airport Way, Suite 300
Long Beach, California 90806
562-426-9544

Table of Contents

| Section..... | Page |
|--|------|
| 1 INTRODUCTION..... | 3 |
| 2 CONSTRUCTION SUMMARY | 3 |
| 3 MODIFICATIONS OF THE WELL BORING DEPTHS..... | 6 |
| 4 TEMPERATURE PROBE DATA..... | 7 |

Tables

| | | |
|----------|---|---|
| Table 1. | Probe Boring Depth | 1 |
| Table 2. | Probe As-built Thermocouple Depths..... | 5 |

Appendices

| | |
|------------|--|
| Appendix A | Boring and As-Built Temperature Monitoring Probe Completion Logs |
| Appendix B | Solid Waste Borehole Temperature Profiles |
| Appendix C | Temperature Monitoring Probe Site Map |

1 INTRODUCTION

SCS Engineers (SCS) was retained by Chiquita Canyon, LLC to design, construct and install temperature monitoring probes (TMP/probe) at the Chiquita Canyon Landfill (Chiquita/Site), located in Castaic, California. The installation process involved the placement of a total of twenty (20) TMPs.

The following supporting documents are included as attachments to this report:

- Boring and as-built temperature monitoring probe completion logs, prepared by SCS or Tetra Tech, are included in *Appendix A*.
- Solid Waste Borehole Temperature Profiles in *Appendix B*.
- Temperature Monitoring Probe Site Map in *Appendix C*.

2 CONSTRUCTION SUMMARY

The 2024–2025 TMP project included the design, construction, and installation of twenty (20) new probes, which were drilled between November 15, 2024, and December 11, 2025. A comprehensive Construction Quality Assurance (CQA) program was implemented throughout the drilling and installation activities to verify compliance with the approved design criteria and Local Enforcement Agency (LEA) requirements.

The probe borings were drilled by the subcontractors Cascade Remediation Services, LLC (Cascade) and Boart Longyear using the following drilling equipment:

- A GEFCO 50K truck-mounted mud rotary drilling rig equipped with an 8.6-inch-diameter hollow-stem auger.
- A ProSonic 600T truck-mounted sonic drilling rig utilizing 4-inch- to 6-inch-diameter sonic tooling and high-frequency resonant energy for advancement.
- A Boart Longyear LS 450 truck-mounted sonic drilling rig utilizing 6-inch- to 8-inch-diameter sonic tooling and high-frequency resonant energy for advancement.

All twenty (20) probes were constructed as single-completion installations, with boring depths ranging from approximately 50 feet to 320 feet below ground surface. A summary of the probe boring depths is provided in **Table 1**. Probe locations are presented in **Appendix C** for reference.

Table 1. Temperature Monitoring Probe Boring Depths

| Probe ID | Date Installed | Total Bore Depth (feet) | Total Probe Depth (feet) |
|----------|----------------|-------------------------|--------------------------|
| TP-21 | 2/6/2025 | 110 | 110 |
| TP-22 | 11/12/2025 | 147 | 30 |
| TP-23 | 10/22/2025 | 107 | 80 |
| TP-24 | 1/24/2025 | 320 | 320 |
| TP-25 | 12/10/2024 | 138 | 138 |
| TP-26 | 12/17/2024 | 159 | 159 |
| TP-27 | 12/5/2024 | 154 | 154 |
| TP-28 | 12/23/2024 | 173 | 173 |

| Probe ID | Date Installed | Total Bore Depth (feet) | Total Probe Depth (feet) |
|----------|----------------|-------------------------|--------------------------|
| TP-29 | 11/27/2024 | 245 | 245 |
| TP-30 | 11/22/2024 | 200 | 200 |
| TP-31 | 11/15/2024 | 290 | 290 |
| TP-32 | 12/12/2024 | 196 | 196 |
| TP-33 | 12/11/2025 | 50 | 48 |
| TP-34 | 12/3/2024 | 124 | 124 |
| TP-35 | 12/19/2024 | 142 | 142 |
| TP-36 | 6/25/2025 | 250 | 250 |
| TP-37 | 8/25/2025 | 180 | 180 |
| TP-38 | 9/4/2025 | 250 | 250 |
| TP-39 | 9/18/2025 | 190 | 190 |
| TP-40 | 9/24/2025 | 220 | 220 |
| | Total | 3645 | 3499 |

Probe construction consisted of drilling to achievable depths, based on field conditions, and installing a solid, 2-inch-diameter stainless steel casing. The original design called for soil backfill to be placed to within 5 feet of the ground surface, followed by a 2-foot bentonite seal, with the remaining annular space backfilled with soil to finish grade. However, based on field observations and site conditions encountered during drilling operations, the final backfill completion varied across probe locations.

The as-built borehole backfill configurations are summarized below:

- Probes TP-25, TP-26, TP-27, TP-28, TP-32, TP-34, TP-35, and TP-36 were completed with soil backfill, a 1-foot-thick upper bentonite plug, and soil backfill to ground surface.
- Probe TP-33 was completed with soil backfill and a 1-foot-thick upper bentonite seal to ground surface.
- Probes TP-29, TP-30, TP-31, TP-37, TP-38, TP-39, and TP-40 were completed with soil backfill, a 2-foot-thick upper bentonite plug, and soil backfill to ground surface.
- Probe TP-24 was completed with soil backfill and a 5-foot-thick upper bentonite plug to ground surface.
- Probe TP-23 was completed with soil backfill and a 15-foot-thick upper bentonite plug extending to ground surface.
- Probe TP-21 was completed with soil backfill and both upper and lower 2-foot-thick bentonite plugs separated by soil backfill.
- Probe TP-22 included the placement of approximately 65 feet of bentonite grout due to elevated subsurface pressures encountered during drilling and to provide additional borehole stabilization.

The thickness and configuration of bentonite plugs were selected based on field conditions, including elevated subsurface temperatures and pressure conditions. Detailed borehole backfill configurations and casing lengths are provided in the probe drilling logs included in **Appendix A**.

Upon completion of each probe, the stainless-steel casings were capped with a 2-inch flanged sensor assembly to prevent the emission of landfill gas prior to the thermocouple system installation. Each probe casing was also fitted with Cleveland Electric Model MGO-K-3-4-U thermocouples at the designated depth intervals listed in **Table 2** below. Thermocouple depth intervals were evaluated following probe casing installation and subsequently established at designated depths based on further site evaluation.

Table 2. Probe As-Built Thermocouple Depths

| Probe ID | Thermocouple Depth (ft.) | | | | | | | |
|----------|--------------------------|----|----|-----|-----|-----|------|-----|
| | 15 | 30 | 45 | 60 | 70 | 85 | 95 | 110 |
| TP-21 | 15 | 30 | 45 | 60 | 70 | 85 | 95 | 110 |
| TP-22 | 15 | - | - | - | - | - | - | - |
| TP-23 | 15 | 30 | 45 | 75 | - | - | - | - |
| TP-24 | 15 | 30 | 45 | 100 | 155 | 210 | 265 | 320 |
| TP-25 | 15 | 30 | 45 | 60 | 75 | 90 | 110 | 130 |
| TP-26 | 15 | 30 | 45 | 60 | 80 | 100 | 125 | 150 |
| TP-27 | 15 | 30 | 45 | 60 | 80 | 100 | 1250 | 150 |
| TP-28 | 15 | 30 | 45 | 70 | 95 | 120 | 145 | 170 |
| TP-29 | 15 | 30 | 45 | 80 | 120 | 160 | 200 | 240 |
| TP-30 | 15 | 30 | 45 | 70 | 100 | 130 | 160 | 190 |
| TP-31 | 15 | 30 | 45 | 80 | 130 | 180 | 230 | 280 |
| TP-32 | 15 | 30 | 45 | 70 | 100 | 130 | 160 | 190 |
| TP-33 | 15 | 30 | 45 | - | - | - | - | - |
| TP-34 | 15 | 30 | 45 | 60 | 75 | 90 | 110 | 120 |
| TP-35 | 15 | 30 | 45 | 65 | 85 | 105 | 125 | 140 |
| TP-36 | 15 | 30 | 45 | 75 | 120 | 165 | 210 | 250 |
| TP-37 | 15 | 30 | 45 | 75 | 100 | 130 | 155 | 180 |
| TP-38 | 15 | 30 | 45 | 75 | 120 | 165 | 210 | 250 |
| TP-39 | 15 | 30 | 45 | 75 | 105 | 135 | 160 | - |
| TP-40 | 15 | 30 | 45 | 75 | 110 | 155 | 185 | 220 |

SCS field CQA personnel were onsite during the drilling and installation of probe casings TP-22, TP-23, and TP-33 observing construction activities. The remainder of the construction oversight during the drilling and installation of the remaining seventeen (17) probe casings was provided by Tetra Tech personnel. All probe construction activities were documented in the drilling logs included in **Appendix A**. Contractor activities were inspected daily to verify compliance with project specifications.

A link to download refuse photographs collected during drilling operations between November 15, 2024, and December 11, 2025, is provided here:

[2024 - 2025 TMP \(TP-21 - TP-40\) Photos](#)

3 MODIFICATIONS OF THE WELL BORING DEPTHS

In accordance with the May 1, 2025, LEA Compliance Order (Mitigation Measure 4.4), SCS established target boring depths prior to construction to meet the required TMP installation intervals (15, 30, 45, and 75 feet below ground surface, and calculated depths beyond 75 feet where applicable). Probes were generally constructed in accordance with the design documents with the exception of modifications discussed with the design engineer, and submitted to the LEA in the weekly TMP update.

During drilling operations, field conditions; including, but not limited to, the presence of free liquids, elevated subsurface gas pressures, and borehole instability, prevented several borings from reaching their planned total depths. As a result, probes TP-21, TP-22, TP-23, TP-24, TP-25, TP-26, TP-28, TP-29, TP-30, TP-33, TP-34, TP-35, TP-37, TP-39, and TP-40 were completed at depths shallower than originally designed. Probes TP-27, TP-31, TP-32, TP-36, and TP-38 were not affected by these conditions and successfully reached design borehole depths.

Borings were advanced to the maximum safe and practicable depth at the time of installation. As a result, reductions to the total bore depths were necessary during construction.

Thermocouple intervals were then set in accordance with required Mitigation Measure 4.4 intervals based upon depths achieved during drilling. Note that only one thermocouple was installed at TP-22 because the borehole collapsed at 30 feet, preventing casing installation beyond 30 feet and allowing a single thermocouple to be installed at 15 feet in accordance with Mitigation Measure 4.4.

Probes TP-25, TP-26, TP-27, and TP-34 have thermocouples installed at depths of 15, 30, 45, and 60 feet. Probes TP-30 and TP-32 have thermocouples installed at depths of 15, 30, 45, and 70 feet. Probes TP-29, and TP-31 have thermocouples installed at depths of 15, 30, 45, and 80 feet. The 60-foot, 70-foot and 80-foot thermocouples were installed in lieu of the 75-foot interval.

TMPs TP-25, TP-26, TP-27, TP-29, TP-30, TP-31, TP-32, and TP-34 were installed at the intended depths; however, incorrect thermocouple lengths were programmed in the remote monitoring control system. Each TMP was equipped with thermocouples at 15-, 30-, 45-, and 60-foot intervals (per LEA email request), but data were initially reported at incorrect depths. The reported depths were corrected in May 2025, as documented in the weekly TMP updates submitted to the LEA during that period. As is outlined in the Modifications of the Well Boring Depths section of the revised Final Report:

In February 2025, thermocouples in TMPs TP-25, TP-26, TP-27, TP-29, TP-30, TP-31, TP-32, and TP-34 were displaying incorrect depths of 25, 40, 50, and 70 feet, rather than the required depths of 15, 30, 45, and 60 feet. Since that time, the final installation depths for these thermocouples has been verified and corrected in the monitoring system, as summarized below.

- TMPs TP-25, TP-26, TP-27, and TP-34 have thermocouples installed at depths of 15, 30, 45, and 60 feet. TMPs TP-30 and TP-32 have thermocouples installed at depths of 15, 30, 45, and 70 feet.
- TMPs TP-29, and TP-31 have thermocouples installed at depths of 15, 30, 45, and 80 feet. The 60-foot, 70-foot and 80-foot thermocouples were installed in lieu of the 75-foot interval.

At the request of the LEA, the Excel spreadsheet is submitted as part of the weekly TMP updates is made up of raw data and thus does not include explanatory language. As-builts for all TMPs are included attached as stipulated in the LEA's letter dated May 8, 2024, Items 2 and 3, and in the LEA's June 6, 2024, Compliance Order. The actual depths are included in the weekly raw data spreadsheets and submitted to the LEA as part of the TMP updates.

Refer to **Table 2** and **Appendix C** for thermocouple depth as-built information.

4 TEMPERATURE PROBE DATA

The temperature data collected at each TMP was obtained from thermocouples installed at depths, requested by the LEA in Mitigation Measure 4.4, at the time of each TMP installation. Accordingly, the temperature monitoring network was designed and implemented to be consistent with the milestone plan and subsequent communications with the LEA.

To validate the temperature data, a quality assurance/quality control (QA/QC) approach was implemented, focusing on confirming that the data was collected from the appropriate TMP locations and thermocouple depths, that the data was recorded on a regular basis, and that the data was reviewed for completeness, consistency, and reasonableness. This QA/QC process includes verification that each TMP casing contains the necessary thermocouple depths, confirmation that the monitoring points correspond to the locations and depths identified in the plan, and review of the resulting temperature readings to identify potential anomalies, data gaps, equipment issues, or readings inconsistent with observed temperature trends.

As part of compliance with Mitigation Measure #1B of the June 6, 2024, LEA Compliance Order, Chiquita installed a Telemetry System to monitor of the each thermocouple depths located within each probe casing. The system uses Industrial Internet of Things Devices mounted on each probe riser to transmit data to the SCS RMC GeoScience (RMC) cloud-based platform for remote monitoring, review, and analysis. The Telemetry System supports the QA/QC process by providing continuous data collection at each thermocouple depth, automated reporting, alarm notifications by text and email, and secure cloud storage of monitoring data. Temperature data is recorded and uploaded to the cloud at 1–2 hour intervals, enabling near real-time visibility of temperature trends and system performance.

QA/QC review of temperature data includes confirming data receipt from each active TMP and thermocouple depth, verifying uploads occur at the expected frequency, assessing data completeness and continuity, and evaluating temperature trends for abrupt changes, outliers, or potential sensor or communication issues. Where data gaps, anomalous readings, or equipment-related issues are identified, the affected data are reviewed, the potential cause is evaluated, and, as appropriate, field checks, equipment maintenance, sensor verification, and/or data qualification are performed.

Through this process, Chiquita and SCS validate that the temperature data was collected from the planned TMP locations and depths, recorded and transmitted at the planned frequency, and reviewed for quality and consistency. QA/QC review of the temperature data includes confirming that data are being received from each.

All TMPs are fully operational and actively providing temperature data to the Telemetry System. Example temperature data logs from January 01 to February 11, 2026, are submitted to the LEA on a weekly basis, and are provided in **Appendix B**.


STATEMENT OF COMPLIANCE

A Construction Quality Assurance (CQA) program was implemented by SCS and Tetra Tech personnel during the 2024-2025 installation of new temperature monitoring probes at Chiquita Canyon Landfill, Castaic, California. The program verifies that work was completed in accordance with the design intent shown on the project drawings. If you have any questions, please do not hesitate to contact the undersigned, Rachelle Huber (925) 789-5710 or Srividhya Viswanathan, PE, at (858) 524-9525.

Sincerely,



Rachelle Huber
Project Manager
SCS ENGINEERS

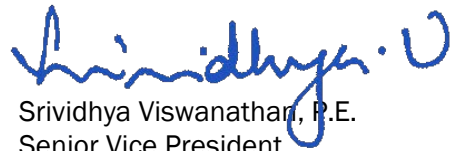

Srividhya Viswanathan, P.E.
Senior Vice President
SCS ENGINEERS

Appendix A

Boring and As-Built Temperature Monitoring Probe Completion Logs

DRILLING LOG

Record Prepared By: Tom Gordon
 Site: Chiquita Canyon Landfill
 Date: 10/28/2025 & 10/30/2025 - 10/31/2025
 Northing: 1981376.636
 Easting: 6366017.682
 Surface Elevation: 1352
 Liner Elevation: 1071
 Temperature Probe Pipe Size: (In.) 2
 Temperature Probe Material: Stainless Steel
 Solid Pipe: (Ft.) 30 (reference from top of ground surface)
 Boring depth: (Ft.) 147

Temperature Probe ID: TP-22
 Driller Name: Boart Longyear
 Bench (Y/N) N
 Weather: -
 Start Drill Time: 9:50:00 AM (10/28) / 9:00:00 AM (10/30) / 7:30:00 AM (10/31)
 End Drill Time: 4:30:00 PM (10/28) / 4:30:00 PM (10/30) / 11:00:00 AM (10/31)
 Seal Type: Bentonite Plug
 Latitude: 34.4351601
 Longitude: -118.6488676

| Starting Depth | Ending Depth | Composition | Temp (F) | Degree of Decomposition | Amount of Moisture | Comments |
|----------------|--------------|------------------------------------|----------|-------------------------|--------------------|-------------|
| 0 | 10 | soil | 99.5 | moderate | moist | |
| 10 | 20 | soil, metal, rocks, plastic, paper | 124.5 | moderate | moist | |
| 20 | 30 | metal, plastic, paper | 124.5 | moderate | moist | |
| 30 | 40 | metal, plastic, paper | 178.5 | moderate | moist | |
| 40 | 50 | - | - | - | - | No recovery |
| 50 | 60 | metal, plastic, paper | 180.5 | moderate | moist | |
| 60 | 70 | metal, plastic, paper | 164.5 | moderate | moist | |
| 70 | 80 | - | - | - | - | No recovery |
| 80 | 90 | - | - | - | - | No recovery |
| 90 | 100 | - | - | - | - | No recovery |
| 100 | 110 | - | - | - | - | No recovery |
| 110 | 120 | metal, plastic, paper | 180.0 | well | moist | |
| 120 | 130 | metal, plastic, paper | 185.0 | well | moist | |
| 130 | 147 | metal, plastic, paper | 183.5 | well | moist | |

Comments:
 Drilling was halted at 147' due to high pressure within the borehole, which prevented removal of the drilling rods. A grout mixture was placed to stabilize the borehole. The drilling crew returned on 11/12, and the borehole was deemed stable and safe for installation of the temperature probe casing. Due to the high pressure, the drilling rods could only advance to 65', and the temperature probe casing could not be installed beyond 30'. Therefore, the temperature probe casing was installed at 30'.

ETOOLS ID

-

Alias

TP-22

Site Name:

CHIQUITA CANYON LANDFILL

Date Installed:

11/12/2025

City:

CASTAIC

State:

CA

Installation Contractor:


Boart Longyear

General Comments:

Coordinates :
 Northing: 1981376.636
 Easting: 6366017.682
 Ground Elevation (MSL): 1352
 Notes: Drilling was halted at 147' due to high pressure within the borehole, which prevented removal of the drilling rods. A grout mixture was placed to stabilize the borehole. The drilling crew returned on 11/12, and the borehole was deemed stable and safe for installation of the temperature probe casing. Due to the high pressure, the drilling rods could only advance to 65', and the temperature probe casing could not be installed beyond 30'. Therefore, the temperature probe casing was installed at 30'.

Pipe Material:

Stainless Steel

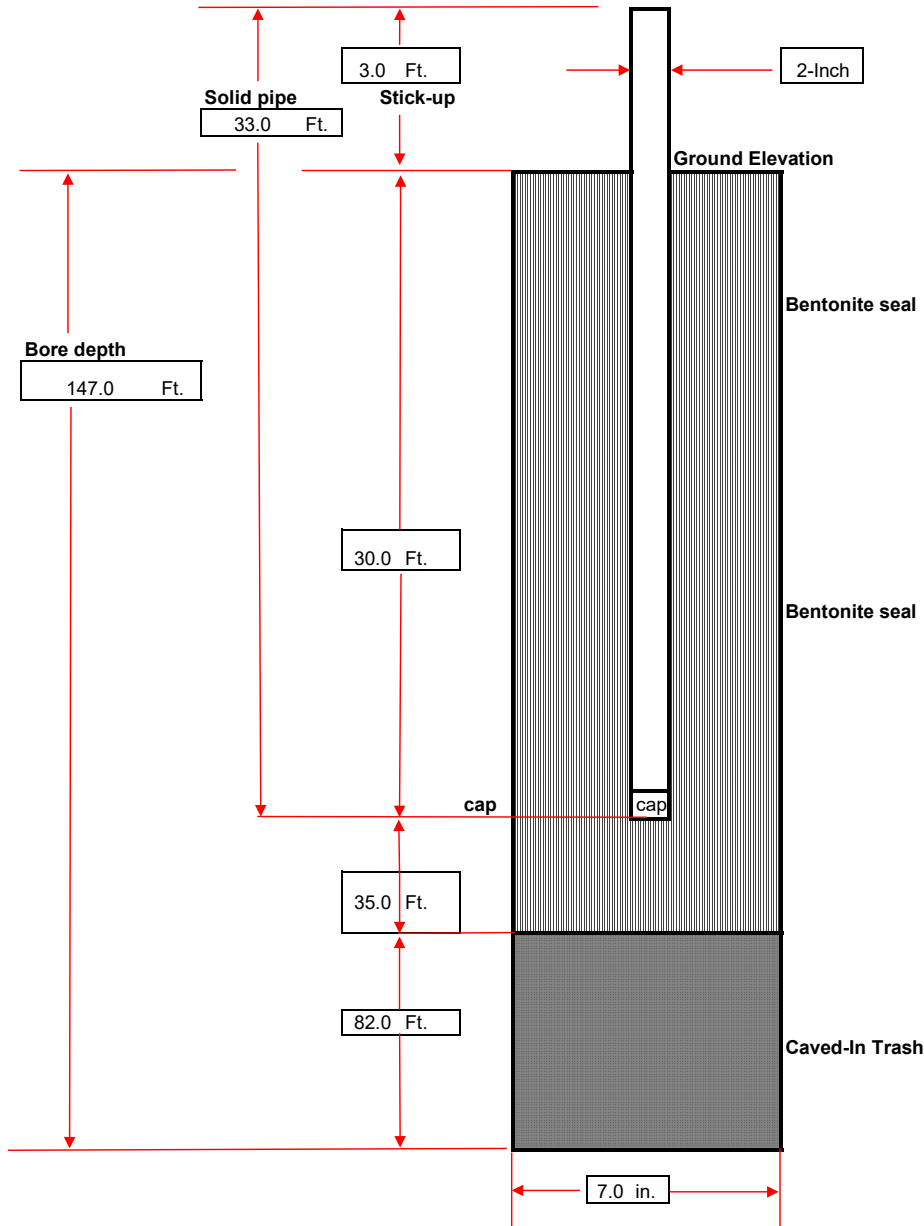

DRILLING LOG

Record Prepared By: Eli Ortenberg
 Site: Chiquita Canyon Landfill
 Date: 10/17/2025 & 10/20/2025
 Northing: 1981728.756
 Easting: 6366232.457
 Surface Elevation: 1367
 Liner Elevation: 1203
 Temperature Probe Pipe Size: (In.) 2
 Temperature Probe Material: Stainless Steel
 Solid Pipe: (Ft.) 80 (reference from top of ground surface)
 Boring depth: (Ft.) 107

Temperature Probe ID: TP-23
 Driller Name: Boart Longyear
 Bench (Y/N) N
 Weather: -
 Start Drill Time: 11:00:00 AM (10/17) / 7:30:00 AM (10/20)
 End Drill Time: 4:30:00 PM (10/17) / 5:30:00 PM (10/20)
 Well Seal Type: Bentonite Plug
 Latitude: 34.4361314
 Longitude: -118.6481628

| Starting Depth | Ending Depth | Composition | Temp (F) | Degree of Decomposition | Amount of Moisture | Comments |
|----------------|--------------|-----------------------------------|----------|-------------------------|--------------------|-------------|
| 0 | 7 | soil | 115.0 | none to little | dry | |
| 7 | 17 | black soil, metal | 142.0 | none to little | dry | |
| 17 | 27 | plastic, paper, glass | 122.0 | moderate | dry | |
| 27 | 37 | plastic, paper | 152.0 | moderate | dry | |
| 37 | 47 | plastic, cardboard, paper | 125.0 | moderate | dry | |
| 47 | 57 | soil, metal, plastic | 158.0 | moderate | moist | |
| 57 | 67 | metal, plastic, soil, wood | 130.0 | moderate | moist | |
| 67 | 77 | soil, wood, paper, plastic, glass | 176.0 | well | moist | |
| 77 | 87 | soil, plastic, wood | 192.0 | well | moist | |
| 87 | 97 | - | - | - | - | No recovery |
| 97 | 107 | - | - | - | - | No recovery |

Comments:
 During preparation for temperature probe casing installation, the borehole experienced a collapse from 107' to 86'. Elevated borehole pressure prevented re-drilling to the original depth of 107'. Due to the availability of temperature probe casing in 20-foot sections, the probe was ultimately installed at a depth of 80'.

ETOOLS ID

-

Alias

TP-23

Site Name:

CHIQUITA CANYON LANDFILL

Date Installed:

10/22/2025

City:

CASTAIC

State:

CA

Installation Contractor:


Boart Longyear

Pipe Material:

Stainless Steel

General Comments:

Coordinates :
 Northing: 1981728.756
 Easting: 6366232.457
 Ground Elevation (MSL): 1367
 Notes: During preparation for temperature probe casing installation, the borehole experienced a collapse from 107' to 86'. Elevated borehole pressure prevented re-drilling to the original depth of 107'. Due to the availability of temperature probe casing in 20-foot sections, the probe was ultimately installed at a depth of 80'.

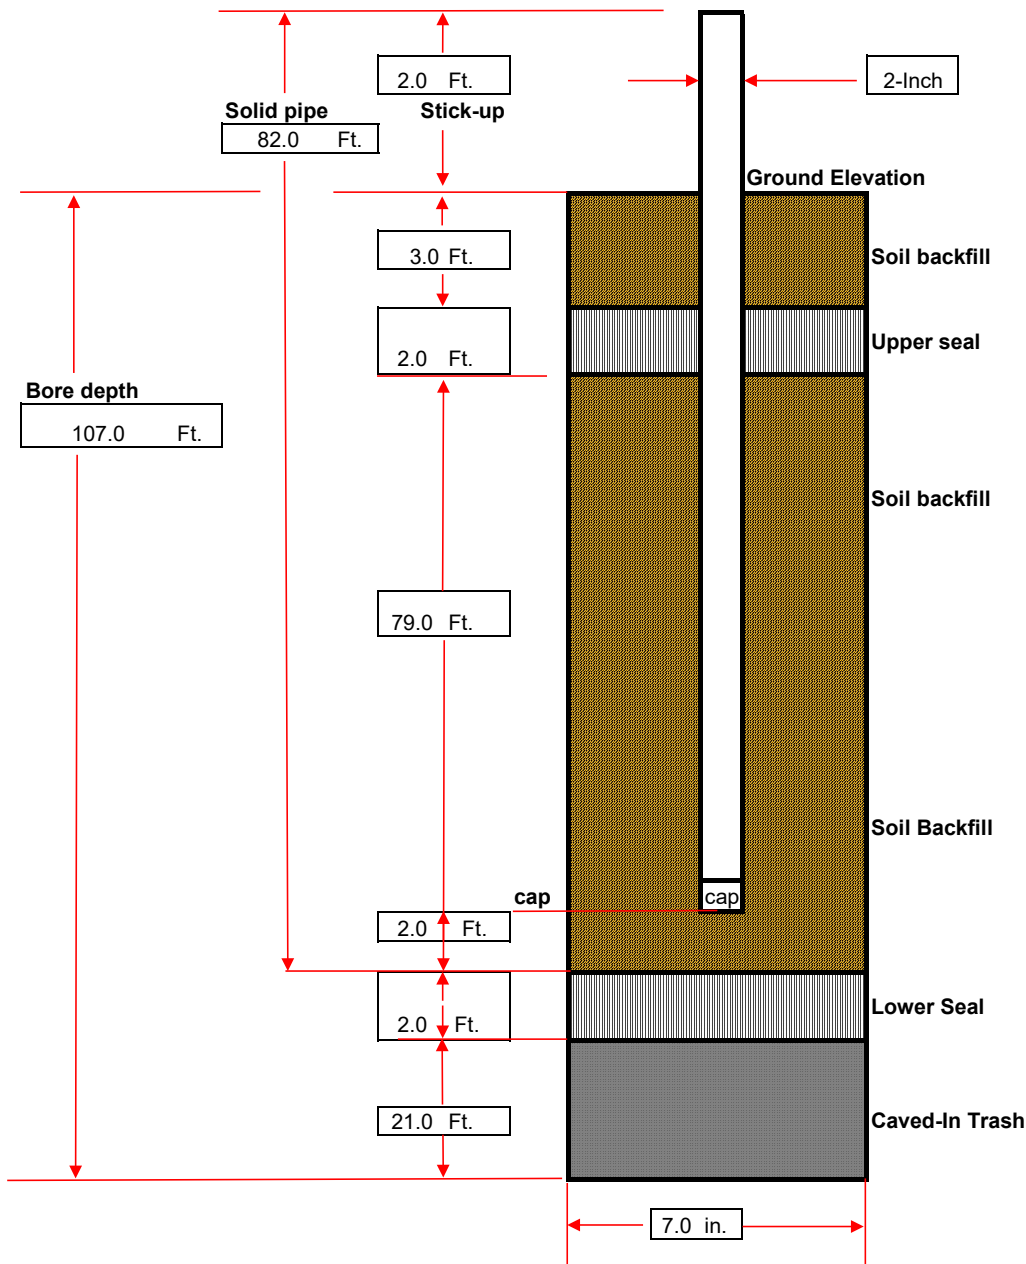

| Tetra Tech, BAS Inc. | | | | TEMPERATURE PROBE ID: | TP-24 | | |
|-----------------------------|--|--|--|--------------------------|----------------------------|------------|---------------------------|
| SITE NAME: | CHIQUITA CANYON LANDFILL | | | COORDINATES: | N: 1,980,531, E: 6,366,233 | | |
| START DATE: | 1/15/2025 | | | SURFACE ELEVATION: | 1,391 | | |
| COMPLETION DATE: | 1/24/2025 | | | TOP OF CASING ELEVATION: | 1,396 | | |
| CQA MONITOR: | Ana Levosada | | | WELL CASING MATERIAL: | 2-INCH STAINLESS STEEL | | |
| CONTRACTOR: | Cascade Remediation Services, LLC | | | END CAP MATERIAL: | 2-INCH STAINLESS STEEL | | |
| DRILLER: | Cascade Remediation Services, LLC | | | TARGET DEPTH: | 325 FT | | |
| DRILL RIG: | GEFCO 50K | | | COMPLETION DEPTH: | 320 FT | | |
| EXISTING LITHOGRAPHY | | | | COMPLETION LOG | | FT. | FT. BGS TO FT. BGS |
| FT. BGS TO FT. BGS | DESCRIPTION (TYPE, DECOMPOSITION, MOISTURE) | | | PIPE: | | | |
| 0 TO 10 | PLASTIC/SOIL, MILD, DRY | | | RISER STICK UP | | 5 | |
| 10 TO 20 | PLASTIC/SOIL, MILD, DRY | | | SOLID PIPE | | 320 | 0 TO 320 |
| 20 TO 30 | PLASTIC/PAPER, MILD, WET | | | GROUND SURFACE | | | |
| 30 TO 40 | PLASTIC/PAPER/WOOD, MILD, WET | | | BENTONITE SEAL | | | |
| 40 TO 50 | PLASTIC/WOOD, MILD, MOIST | | | BACKFILL: | | | |
| 50 TO 60 | PLASTIC/PAPER/WOOD, MILD, MOIST | | | UPPER BENTONITE SEAL | | 5 | 0 TO 5 |
| 60 TO 70 | PLASTIC/WOOD, MODERATE, WET | | | LOWER SOIL PLUG | | 315 | 5 TO 320 |
| 70 TO 80 | PLASTIC/PAPER/WOOD, MILD, MOIST | | | | | | |
| 80 TO 90 | PLASTIC/PAPER/WOOD, MODERATE, MOIST | | | BORING DIAMETER: | | | |
| 90 TO 100 | PLASTIC/WOOD, MODERATE, WET | | | 8.5 INCHES | | 320 | 0 TO 320 |
| 100 TO 110 | PLASTIC/WOOD, MODERATE, WET | | | | | | |
| 110 TO 120 | PLASTIC/WOOD, MODERATE, MOIST | | | | | | |
| 120 TO 130 | PLASTIC, SEVERE, WET | | | | | | |
| 130 TO 140 | PLASTIC, MODERATE, MOIST | | | | | | |
| 140 TO 150 | PLASTIC, MODERATE, MOIST | | | | | | |
| 150 TO 160 | PLASTIC, SEVERE, WET | | | | | | |
| 160 TO 170 | PLASTIC, MODERATE, WET | | | | | | |
| 170 TO 180 | PLASTIC/WOOD, SEVERE, WET | | | | | | |
| 180 TO 190 | PLASTIC, SEVERE, WET | | | | | | |
| 190 TO 200 | PLASTIC, SEVERE, MOIST | | | | | | |
| 200 TO 210 | PLASTIC, SEVERE, WET | | | | | | |
| 210 TO 220 | PLASTIC, SEVERE, MOIST | | | | | | |
| 220 TO 230 | PLASTIC, MODERATE, MOIST | | | | | | |
| 230 TO 240 | PLASTIC, MODERATE, MOIST | | | | | | |
| 240 TO 250 | PLASTIC, MODERATE, MOIST | | | | | | |
| 250 TO 260 | PLASTIC, MODERATE, MOIST | | | | | | |
| 260 TO 270 | PLASTIC, MODERATE, MOIST | | | | | | |
| 270 TO 280 | PLASTIC, SEVERE, MOIST | | | | | | |
| 280 TO 290 | PLASTIC, SEVERE, WET | | | | | | |
| 290 TO 300 | PLASTIC, SEVERE, WET | | | | | | |
| DEPTH (FT. BGS) | TEMPERATURE (°F) | | | | | | |
| 0 TO 10 | 84 | | | | | | |
| 10 TO 20 | 94 | | | | | | |
| 20 TO 30 | 84M, 80W | | | | | | |
| 30 TO 40 | 90M, 84W | | | | | | |
| 40 TO 50 | 84M, 84W | | | | | | |
| 50 TO 60 | 84M, 82W | | | | | | |
| 60 TO 70 | 80M, 76W | | | | | | |
| 70 TO 80 | 78M, 76W | | | | | | |
| 80 TO 90 | 82M, 76W | | | | | | |
| 90 TO 100 | 82M, 78W | | | | | | |
| 100 TO 110 | 84M, 82W | | | | | | |
| 110 TO 120 | 86M, 82W | | | | | | |
| 120 TO 130 | 88M, 88W | | | | | | |
| 130 TO 140 | 76M, 68W | | | | | | |
| 140 TO 150 | 80M, 78W | | | | | | |
| 150 TO 160 | 82M, 80W | | | | | | |
| 160 TO 170 | 82M, 78W | | | | | | |
| 170 TO 180 | 84M, 82W | | | | | | |
| 180 TO 190 | 86M, 82W | | | | | | |
| 190 TO 200 | 88M, 82W | | | | | | |
| 200 TO 210 | 88M, 84W | | | | | | |
| 210 TO 220 | 88M, 82W | | | | | | |
| 220 TO 230 | 88M, 82W | | | | | | |
| 230 TO 240 | 76M | | | | | | |
| 240 TO 250 | 80M, 70W | | | | | | |
| 250 TO 260 | 82M, 78W | | | | | | |
| 260 TO 270 | 86M, 76W | | | | | | |
| 270 TO 280 | 84M, 78W | | | | | | |
| 280 TO 290 | 86M, 82W | | | | | | |
| 290 TO 300 | 88M, 80W | | | | | | |

RISER PIPE

5'X5' REBAR SAFETY GRATE

SOLID PIPE

LOWER SOIL PLUG

| Tetra Tech, BAS Inc. | | | | TEMPERATURE PROBE ID: | TP-29 | | |
|-----------------------------|--|--|--|--------------------------|----------------------------|------------|---------------------------|
| SITE NAME: | CHIQUITA CANYON LANDFILL | | | COORDINATES: | N: 1,980,633, E: 6,366,655 | | |
| START DATE: | 11/25/2024 | | | SURFACE ELEVATION: | 1,399 | | |
| COMPLETION DATE: | 11/27/2024 | | | TOP OF CASING ELEVATION: | 1,402 | | |
| CQA MONITOR: | Ana Levosada | | | WELL CASING MATERIAL: | 2-INCH STAINLESS STEEL | | |
| CONTRACTOR: | Cascade Remediation Services, LLC | | | END CAP MATERIAL: | 2-INCH STAINLESS STEEL | | |
| DRILLER: | Cascade Remediation Services, LLC | | | TARGET DEPTH: | 325 FT | | |
| DRILL RIG: | ProSonic 600T | | | COMPLETION DEPTH: | 245 FT | | |
| EXISTING LITHOGRAPHY | | | | COMPLETION LOG | | | |
| FT. BGS TO FT. BGS | DESCRIPTION (TYPE, DECOMPOSITION, MOISTURE) | | | PIPE: | | FT. | FT. BGS TO FT. BGS |
| 0 TO 10 | NOT MONITORED | | | RISER STICK UP | 3 | | |
| 10 TO 20 | PAPER/PLASTIC, SOME, DRY | | | SOLID PIPE | 245 | 0 TO 245 | |
| 20 TO 30 | NOT MONITORED | | | | | | |
| 30 TO 40 | PAPER/PLASTIC/TEXTILE, MODERATE, DRY | | | | | | |
| 40 TO 50 | PAPER/PLASTIC, MODERATE, MOIST | | | | | | |
| 50 TO 60 | PAPER/PLASTIC, MODERATE, MOIST | | | | | | |
| 60 TO 70 | WOOD/PLASTIC, MODERATE, MOIST | | | | | | |
| 70 TO 80 | ROCKS, MODERATE, DRY | | | | | | |
| 80 TO 90 | PAPER/WOOD/PLASTIC, MODERATE, DRY | | | | | | |
| 90 TO 100 | NOT MONITORED | | | | | | |
| 100 TO 110 | PAPER/WOOD/PLASTIC, MODERATE, MOIST | | | | | | |
| 110 TO 120 | NOT MONITORED | | | | | | |
| 120 TO 130 | NOT MONITORED | | | | | | |
| 130 TO 140 | PAPER/PLASTIC/TEXTILE, MODERATE, MOIST | | | | | | |
| 140 TO 150 | NOT MONITORED | | | | | | |
| 150 TO 160 | NOT MONITORED | | | | | | |
| 160 TO 170 | PAPER/WOOD/PLASTIC/TEXTILE, MODERATE, MOIST | | | | | | |
| 170 TO 180 | NOT MONITORED | | | | | | |
| 180 TO 190 | NOT MONITORED | | | | | | |
| 190 TO 200 | PAPER/PLASTIC, SEVERE, MOIST | | | | | | |
| 200 TO 210 | NOT MONITORED | | | | | | |
| 210 TO 220 | NOT MONITORED | | | | | | |
| 220 TO 230 | PAPER/PLASTIC/WOOD, MODERATE, MOIST | | | | | | |
| 230 TO 245 | NOT MONITORED | | | | | | |
| BACKFILL: | | | | | | | |
| UPPER SOIL PLUG | | | | 3 | | 0 TO 3 | |
| BENTONITE SEAL | | | | 2 | | 3 TO 5 | |
| LOWER SOIL PLUG | | | | 240 | | 5 TO 245 | |
| BORING DIAMETER: | | | | | | | |
| 6 INCHES | | | | 105 | | 0 TO 105 | |
| 4 INCHES | | | | 140 | | 105 TO 245 | |
| DEPTH (FT. BGS) | TEMPERATURE (°F) | | | | | | |
| 0 TO 10 | NOT MONITORED | | | | | | |
| 10 TO 20 | 112 | | | | | | |
| 20 TO 30 | NOT MONITORED | | | | | | |
| 30 TO 40 | 114 | | | | | | |
| 40 TO 50 | 130 | | | | | | |
| 50 TO 60 | 134 | | | | | | |
| 60 TO 70 | 176 | | | | | | |
| 70 TO 80 | 166 | | | | | | |
| 80 TO 90 | 156 | | | | | | |
| 90 TO 100 | NOT MONITORED | | | | | | |
| 100 TO 110 | 160 | | | | | | |
| 110 TO 120 | NOT MONITORED | | | | | | |
| 120 TO 130 | NOT MONITORED | | | | | | |
| 130 TO 140 | 154 | | | | | | |
| 140 TO 150 | NOT MONITORED | | | | | | |
| 150 TO 160 | NOT MONITORED | | | | | | |
| 160 TO 170 | 150 | | | | | | |
| 170 TO 180 | NOT MONITORED | | | | | | |
| 180 TO 190 | NOT MONITORED | | | | | | |
| 190 TO 200 | 146 | | | | | | |
| 200 TO 210 | NOT MONITORED | | | | | | |
| 210 TO 220 | NOT MONITORED | | | | | | |
| 220 TO 230 | 154 | | | | | | |
| 230 TO 245 | NOT MONITORED | | | | | | |

| Tetra Tech, BAS Inc. | | | | TEMPERATURE PROBE ID: | TP-31 | | |
|-----------------------------|--|--|--|--------------------------|----------------------------|------------|---------------------------|
| SITE NAME: | CHIQUITA CANYON LANDFILL | | | COORDINATES: | N: 1,981,476, E: 6,367,157 | | |
| START DATE: | 11/12/2024 | | | SURFACE ELEVATION: | 1,402 | | |
| COMPLETION DATE: | 11/15/2024 | | | TOP OF CASING ELEVATION: | 1,405 | | |
| CQA MONITOR: | Julian Obusan, E.I.T. | | | WELL CASING MATERIAL: | 2-INCH STAINLESS STEEL | | |
| CONTRACTOR: | Cascade Remediation Services, LLC | | | END CAP MATERIAL: | 2-INCH STAINLESS STEEL | | |
| DRILLER: | Cascade Remediation Services, LLC | | | TARGET DEPTH: | 290 FT | | |
| DRILL RIG: | ProSonic 600T | | | COMPLETION DEPTH: | 290 FT | | |
| EXISTING LITHOGRAPHY | | | | COMPLETION LOG | | | |
| FT. BGS TO FT. BGS | DESCRIPTION (TYPE, DECOMPOSITION, MOISTURE) | | | PIPE: | | FT. | FT. BGS TO FT. BGS |
| 0 TO 10 | NOT MONITORED | | | RISER STICK UP | 3 | | |
| 10 TO 20 | PAPER/PLASTIC/TEXTILE, MODERATE, MOIST | | | SOLID PIPE | 290 | 0 TO 290 | |
| 20 TO 30 | NOT MONITORED | | | | | | |
| 30 TO 40 | PAPER/PLASTIC/TEXTILE, MODERATE, MOIST | | | | | | |
| 40 TO 50 | NOT MONITORED | | | | | | |
| 50 TO 60 | PAPER/WOOD, MODERATE, MOIST | | | | | | |
| 60 TO 70 | NOT MONITORED | | | | | | |
| 70 TO 80 | PAPER/WOOD, SEVERE, WET | | | | | | |
| 80 TO 90 | NOT MONITORED | | | | | | |
| 90 TO 100 | PAPER/PLASTIC/TEXTILE, SEVERE, WET | | | | | | |
| 100 TO 110 | NOT MONITORED | | | | | | |
| 110 TO 120 | NOT MONITORED | | | | | | |
| 120 TO 130 | NOT MONITORED | | | | | | |
| 130 TO 140 | NOT MONITORED | | | | | | |
| 140 TO 150 | PLASTIC, SEVERE, WET | | | | | | |
| 150 TO 160 | NOT MONITORED | | | | | | |
| 160 TO 170 | PAPER/PLASTIC, SEVERE, WET | | | | | | |
| 170 TO 180 | NOT MONITORED | | | | | | |
| 180 TO 190 | PAPER/PLASTIC, SEVERE, WET | | | | | | |
| 190 TO 200 | NOT MONITORED | | | | | | |
| 200 TO 210 | PAPER/PLASTIC, SEVERE, WET | | | | | | |
| 210 TO 220 | NOT MONITORED | | | | | | |
| 220 TO 230 | PAPER/PLASTIC, SEVERE, WET | | | | | | |
| 230 TO 240 | NOT MONITORED | | | | | | |
| 240 TO 250 | PAPER/PLASTIC, SEVERE, WET | | | | | | |
| 250 TO 260 | NOT MONITORED | | | | | | |
| 260 TO 270 | NOT MONITORED | | | | | | |
| 270 TO 280 | PAPER/PLASTIC, SEVERE, WET | | | | | | |
| 280 TO 290 | PAPER/PLASTIC, SEVERE, WET | | | | | | |
| DEPTH (FT. BGS) | | | | TEMPERATURE (°F) | | | |
| 0 TO 10 | NOT MONITORED | | | | | | |
| 10 TO 20 | 120 | | | | | | |
| 20 TO 30 | NOT MONITORED | | | | | | |
| 30 TO 40 | 134 | | | | | | |
| 40 TO 50 | NOT MONITORED | | | | | | |
| 50 TO 60 | 136 | | | | | | |
| 60 TO 70 | NOT MONITORED | | | | | | |
| 70 TO 80 | 144 | | | | | | |
| 80 TO 90 | NOT MONITORED | | | | | | |
| 90 TO 100 | 150 | | | | | | |
| 100 TO 110 | NOT MONITORED | | | | | | |
| 110 TO 120 | NOT MONITORED | | | | | | |
| 120 TO 130 | NOT MONITORED | | | | | | |
| 130 TO 140 | NOT MONITORED | | | | | | |
| 140 TO 150 | NOT MONITORED | | | | | | |
| 150 TO 160 | NOT MONITORED | | | | | | |
| 160 TO 170 | 135 | | | | | | |
| 170 TO 180 | NOT MONITORED | | | | | | |
| 180 TO 190 | 160 | | | | | | |
| 190 TO 200 | NOT MONITORED | | | | | | |
| 200 TO 210 | 178 | | | | | | |
| 210 TO 220 | NOT MONITORED | | | | | | |
| 220 TO 230 | 145 | | | | | | |
| 230 TO 240 | NOT MONITORED | | | | | | |
| 240 TO 250 | 150 | | | | | | |
| 250 TO 260 | NOT MONITORED | | | | | | |
| 260 TO 270 | NOT MONITORED | | | | | | |
| 270 TO 280 | 152 | | | | | | |
| 280 TO 290 | 150 | | | | | | |

RISER PIPE

5'X5' REBAR SAFETY GRATE

SOLID PIPE

LOWER SOIL PLUG

DRILLING LOG

Record Prepared By: Eli Ortenberg
 Site: Chiquita Canyon Landfill
 Date: 12/11/2025
 Northing: 1981455.963
 Easting: 6366283.972
 Surface Elevation: 1366
 Liner Elevation: -
 Temperature Probe Pipe Size: (In.) 2
 Temperature Probe Material: Stainless Steel
 Solid Pipe: (Ft.) 48 (reference from top of ground surface)
 Boring depth: (Ft.) 50

Temperature Probe ID: TP-33
 Driller Name: Boart Longyear
 Bench (Y/N) N
 Weather: -
 Start Drill Time: 10:30:00 AM
 End Drill Time: 1:20:00 PM
 Seal Type: Bentonite Plug
 Latitude: 34.4353828
 Longitude: -118.6479862

| Starting Depth | Ending Depth | Composition | Temp (F) | Degree of Decomposition | Amount of Moisture | Comments |
|----------------|--------------|---------------------------|----------|-------------------------|--------------------|----------|
| 0 | 7 | soil, gravel | 75.0 | none to little | dry | |
| 7 | 17 | paper, plastic | 90.0 | moderate | moist | |
| 17 | 27 | wood, cardboard | 100.0 | moderate | moist | |
| 27 | 37 | paper, plastic, cardboard | 100.0 | moderate | moist | |
| 37 | 47 | wood, paper, plastic | 108.0 | well | moist | |
| 47 | 50 | wood, paper, plastic | 110.0 | well | moist | |

Comments:
 Stopped drilling at 50' before encountering high pressure.

ETOOLS ID

-

Alias

TP-33

Site Name:

CHIQUITA CANYON LANDFILL

Date Installed:

12/11/2025

City:

CASTAIC

State:

CA

Installation Contractor:


Boart Longyear

General Comments:

Coordinates :
Northing: 1981455.963
Easting: 6366283.972
Ground Elevation (MSL): 1366
Notes: Stopped drilling at 50' before encountering high pressure.


Pipe Material:

Stainless Steel

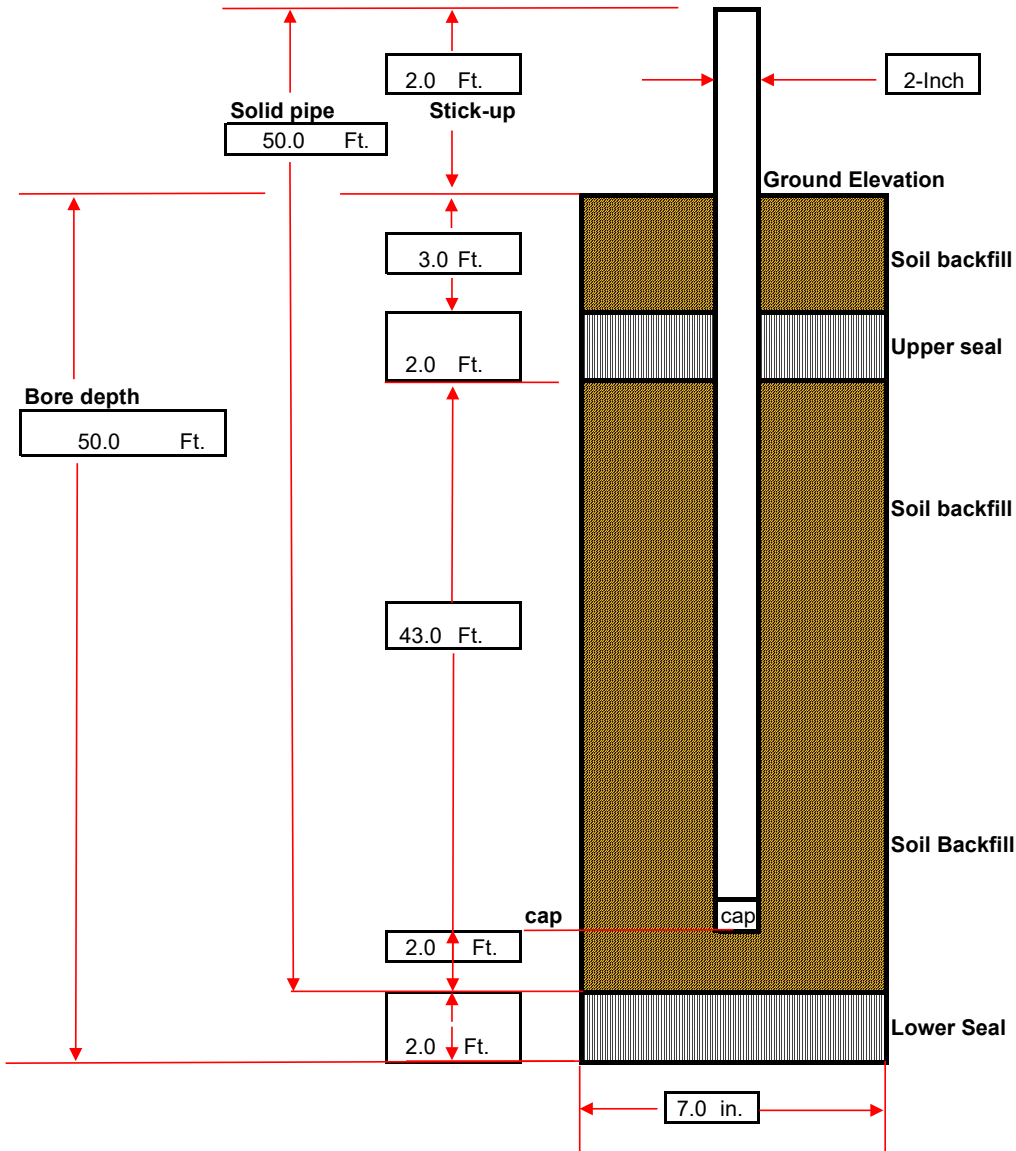

| Tetra Tech, BAS Inc. | | | | TEMPERATURE PROBE ID: | TP-37 | | |
|----------------------|---|--|--|--------------------------|----------------------------|-----|--------------------|
| SITE NAME: | CHIQUITA CANYON LANDFILL | | | COORDINATES: | N: 1,980,945, E: 6,367,236 | | |
| START DATE: | 8/18/2025 | | | SURFACE ELEVATION: | 1,385 | | |
| COMPLETION DATE: | 8/25/2025 | | | TOP OF CASING ELEVATION: | 1,387 | | |
| CQA MONITOR: | Keith Hussain | | | WELL CASING MATERIAL: | 2-INCH STAINLESS STEEL | | |
| CONTRACTOR: | Boart Longyear | | | END CAP MATERIAL: | 2-INCH STAINLESS STEEL | | |
| DRILLER: | Boart Longyear | | | TARGET DEPTH: | 288 FT | | |
| DRILL RIG: | LS 450 | | | COMPLETION DEPTH: | 180 FT | | |
| EXISTING LITHOGRAPHY | | | | COMPLETION LOG | | FT. | FT. BGS TO FT. BGS |
| FT. BGS TO FT. BGS | DESCRIPTION (TYPE, DECOMPOSITION, MOISTURE) | | | PIPE: | | | |
| 0 TO 10 | PAPER/PLASTIC/WOOD, SEVERE, MOIST | | | RISER STICK UP | | 2 | |
| 10 TO 20 | PAPER/PLASTIC/WOOD, SEVERE, MOIST | | | SOLID PIPE | | 180 | 0 TO 180 |
| 20 TO 30 | PAPER/PLASTIC/WOOD, SOME, MOIST | | | GROUND SURFACE | | | |
| 30 TO 40 | PAPER/PLASTIC/WOOD, SOME, MOIST | | | UPPER SOIL PLUG | | | |
| 40 TO 50 | PAPER/PLASTIC/WOOD, MODERATE, MOIST | | | BENTONITE SEAL | | | |
| 50 TO 60 | PAPER/PLASTIC/WOOD, MODERATE, MOIST | | | BACKFILL: | | | |
| 60 TO 70 | PAPER/PLASTIC/WOOD, MODERATE, MOIST | | | UPPER SOIL PLUG | | 3 | 0 TO 3 |
| 70 TO 80 | PAPER/PLASTIC/WOOD, MODERATE, MOIST | | | UPPER BENTONITE SEAL | | 2 | 3 TO 5 |
| 80 TO 90 | PAPER/PLASTIC/WOOD, MODERATE, MOIST | | | LOWER SOIL PLUG | | 175 | 5 TO 180 |
| 90 TO 100 | PAPER/PLASTIC/WOOD, MODERATE, MOIST | | | BORING DIAMETER: | | | |
| 100 TO 110 | PAPER/PLASTIC/WOOD, MODERATE, MOIST | | | 8 INCHES | | 50 | 0 TO 50 |
| 110 TO 120 | PAPER/PLASTIC/WOOD, MODERATE, MOIST | | | 7 INCHES | | 130 | 50 TO 180 |
| 120 TO 130 | PAPER/PLASTIC/WOOD, MODERATE, MOIST | | | | | | |
| 130 TO 140 | PAPER/PLASTIC/WOOD, MODERATE, MOIST | | | | | | |
| 140 TO 150 | PAPER/PLASTIC/WOOD, MODERATE, MOIST | | | | | | |
| 150 TO 160 | PAPER/PLASTIC/WOOD, MODERATE, MOIST | | | | | | |
| 160 TO 170 | PAPER/PLASTIC/WOOD, MODERATE, MOIST | | | | | | |
| 170 TO 180 | PAPER/PLASTIC/WOOD, MODERATE, DRY | | | | | | |
| DEPTH (FT. BGS) | TEMPERATURE (°F) | | | | | | |
| 0 TO 10 | 100 | | | | | | |
| 10 TO 20 | 128 | | | | | | |
| 20 TO 30 | 150 | | | | | | |
| 30 TO 40 | 164 | | | | | | |
| 40 TO 50 | 135 | | | | | | |
| 50 TO 60 | 190 | | | | | | |
| 60 TO 70 | 170 | | | | | | |
| 70 TO 80 | 178 | | | | | | |
| 80 TO 90 | 206 | | | | | | |
| 90 TO 100 | 170 | | | | | | |
| 100 TO 110 | 170 | | | | | | |
| 110 TO 120 | 164 | | | | | | |
| 120 TO 130 | 190 | | | | | | |
| 130 TO 140 | 186 | | | | | | |
| 140 TO 150 | 180 | | | | | | |
| 150 TO 160 | 168 | | | | | | |
| 160 TO 170 | 152 | | | | | | |
| 170 TO 180 | 162 | | | | | | |


| Tetra Tech, BAS Inc. | | | | TEMPERATURE PROBE ID: | TP-40 | | |
|----------------------|---|--|--|--------------------------|----------------------------|-----------|--------------------|
| SITE NAME: | CHIQUITA CANYON LANDFILL | | | COORDINATES: | N: 1,979,663, E: 6,365,958 | | |
| START DATE: | 9/20/2025 | | | SURFACE ELEVATION: | 1,277 | | |
| COMPLETION DATE: | 9/24/2025 | | | TOP OF CASING ELEVATION: | Zxas | | |
| CQA MONITOR: | Ana Levisada and Keith Hussain | | | WELL CASING MATERIAL: | 2-INCH STAINLESS STEEL | | |
| CONTRACTOR: | Boart Longyear | | | END CAP MATERIAL: | 2-INCH STAINLESS STEEL | | |
| DRILLER: | Boart Longyear | | | TARGET DEPTH: | 221 FT | | |
| DRILL RIG: | LS 450 | | | COMPLETION DEPTH: | 220 FT | | |
| EXISTING LITHOGRAPHY | | | | COMPLETION LOG | | FT. | FT. BGS TO FT. BGS |
| FT. BGS TO FT. BGS | DESCRIPTION (TYPE, DECOMPOSITION, MOISTURE) | | | PIPE: | | | |
| 0 TO 10 | METAL/PLASTIC/WOOD, MODERATE, MOIST | | | RISER STICK UP | 2 | | |
| 10 TO 20 | METAL/PLASTIC/WOOD, MODERATE, DRY | | | SOLID PIPE | 220 | 0 TO 220 | |
| 20 TO 30 | METAL/PLASTIC/TEXTILE/WOOD, SOME, DRY | | | | | | |
| 30 TO 40 | PLASTIC/WOOD, SOME, DRY | | | GROUND SURFACE | | | |
| 40 TO 50 | PLASTIC/WOOD, SOME, DRY | | | UPPER SOIL PLUG | | | |
| 50 TO 60 | PLASTIC, MODERATE, MOIST | | | BENTONITE SEAL | | | |
| 60 TO 70 | PLASTIC/WOOD, MODERATE, DRY | | | BACKFILL: | | | |
| 70 TO 80 | PLASTIC/WOOD, MODERATE, DRY | | | UPPER SOIL PLUG | 3 | 0 TO 3 | |
| 80 TO 90 | PLASTIC, MODERATE, MOIST | | | UPPER BENTONITE SEAL | 2 | 3 TO 5 | |
| 90 TO 100 | PLASTIC/WOOD, MODERATE, DRY | | | LOWER SOIL PLUG | 215 | 5 TO 220 | |
| 100 TO 110 | PLASTIC, MODERATE, MOIST | | | | | | |
| 110 TO 120 | PLASTIC/WOOD, MODERATE, DRY | | | BORING DIAMETER: | | | |
| 120 TO 130 | PLASTIC, MODERATE, DRY | | | 7 INCHES | 60 | 0 TO 60 | |
| 130 TO 140 | PLASTIC/WOOD, MODERATE, DRY | | | 6 INCHES | 160 | 60 TO 220 | |
| 140 TO 150 | SOIL/WOOD/PLASTIC, MODERATE, DRY | | | | | | |
| 150 TO 160 | SAND/PLASTIC/WOOD, MODERATE, DRY | | | | | | |
| 160 TO 170 | PLASTIC/WOOD, MODERATE, DRY | | | | | | |
| 170 TO 180 | PLASTIC/WOOD, MODERATE, DRY | | | | | | |
| 180 TO 190 | PLASTIC/WOOD, MODERATE, DRY | | | | | | |
| 190 TO 200 | PLASTIC/WOOD, MODERATE, MOIST | | | | | | |
| 200 TO 210 | PLASTIC, MODERATE, DRY | | | | | | |
| 210 TO 220 | PLASTIC, SEVERE, DRY | | | | | | |
| DEPTH (FT. BGS) | TEMPERATURE (°F) | | | | | | |
| 0 TO 10 | 130 | | | | | | |
| 10 TO 20 | 152 | | | | | | |
| 20 TO 30 | 116 | | | | | | |
| 30 TO 40 | 162 | | | | | | |
| 40 TO 50 | 170 | | | | | | |
| 50 TO 60 | 90 | | | | | | |
| 60 TO 70 | 110 | | | | | | |
| 70 TO 80 | 110 | | | | | | |
| 80 TO 90 | 104 | | | | | | |
| 90 TO 100 | 118 | | | | | | |
| 100 TO 110 | 110 | | | | | | |
| 110 TO 120 | 102 | | | | | | |
| 120 TO 130 | 112 | | | | | | |
| 130 TO 140 | 132 | | | | | | |
| 140 TO 150 | 156 | | | | | | |
| 150 TO 160 | 154 | | | | | | |
| 160 TO 170 | 154 | | | | | | |
| 170 TO 180 | 144 | | | | | | |
| 180 TO 190 | 142 | | | | | | |
| 190 TO 200 | 180 | | | | | | |
| 200 TO 210 | 148 | | | | | | |
| 210 TO 220 | 148 | | | | | | |



Appendix B
Solid Waste Borehole Temperature Profiles


Vertical Temperature Profiles from Temperature Probes at Chiquita Landfill for TP-21

Maximum data for 1/1/2026 to 2/11/2026

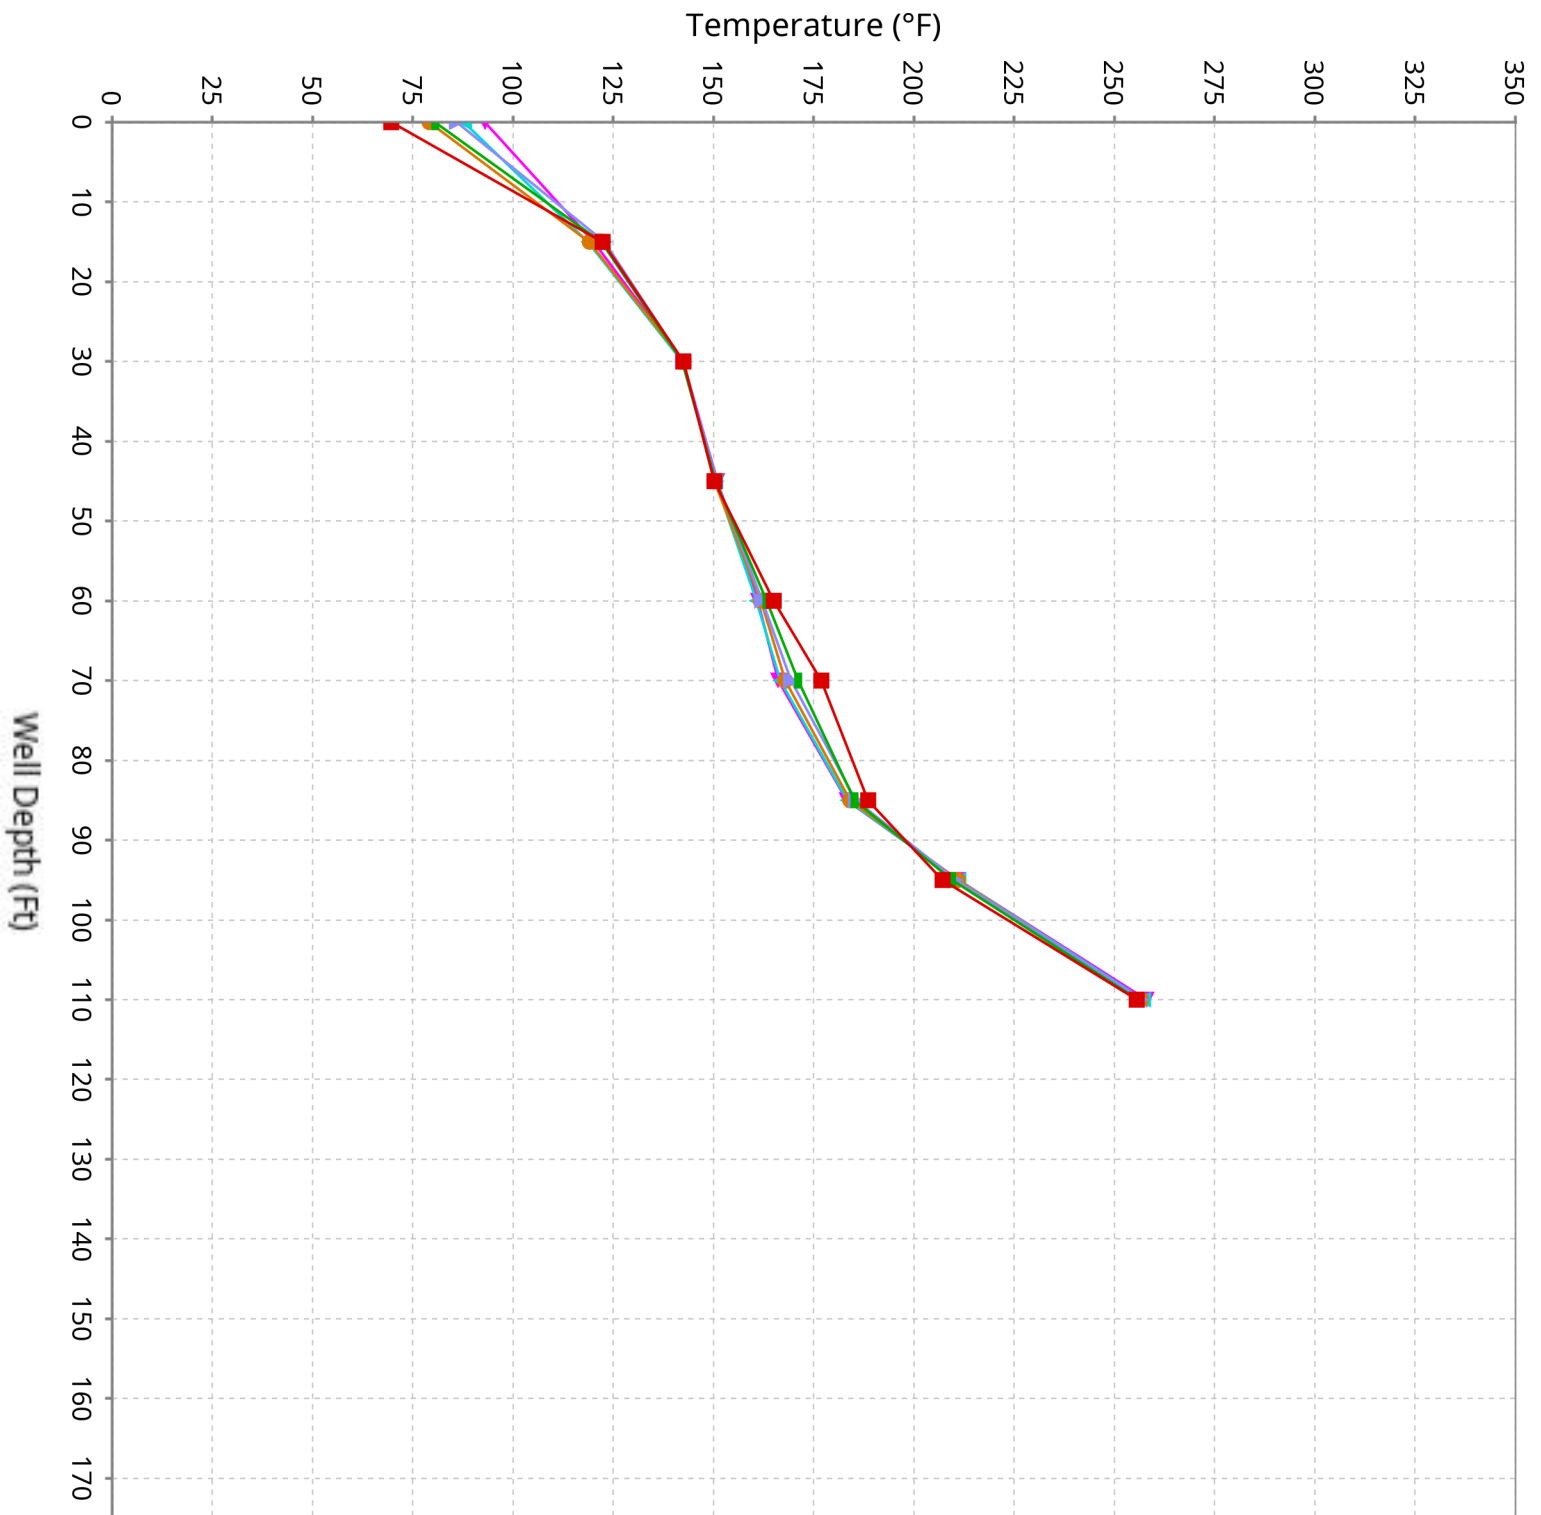


Vertical Temperature Profiles from Temperature Probes at Chiquita Landfill for TP-22

Maximum data for 1/1/2026 to 2/11/2026

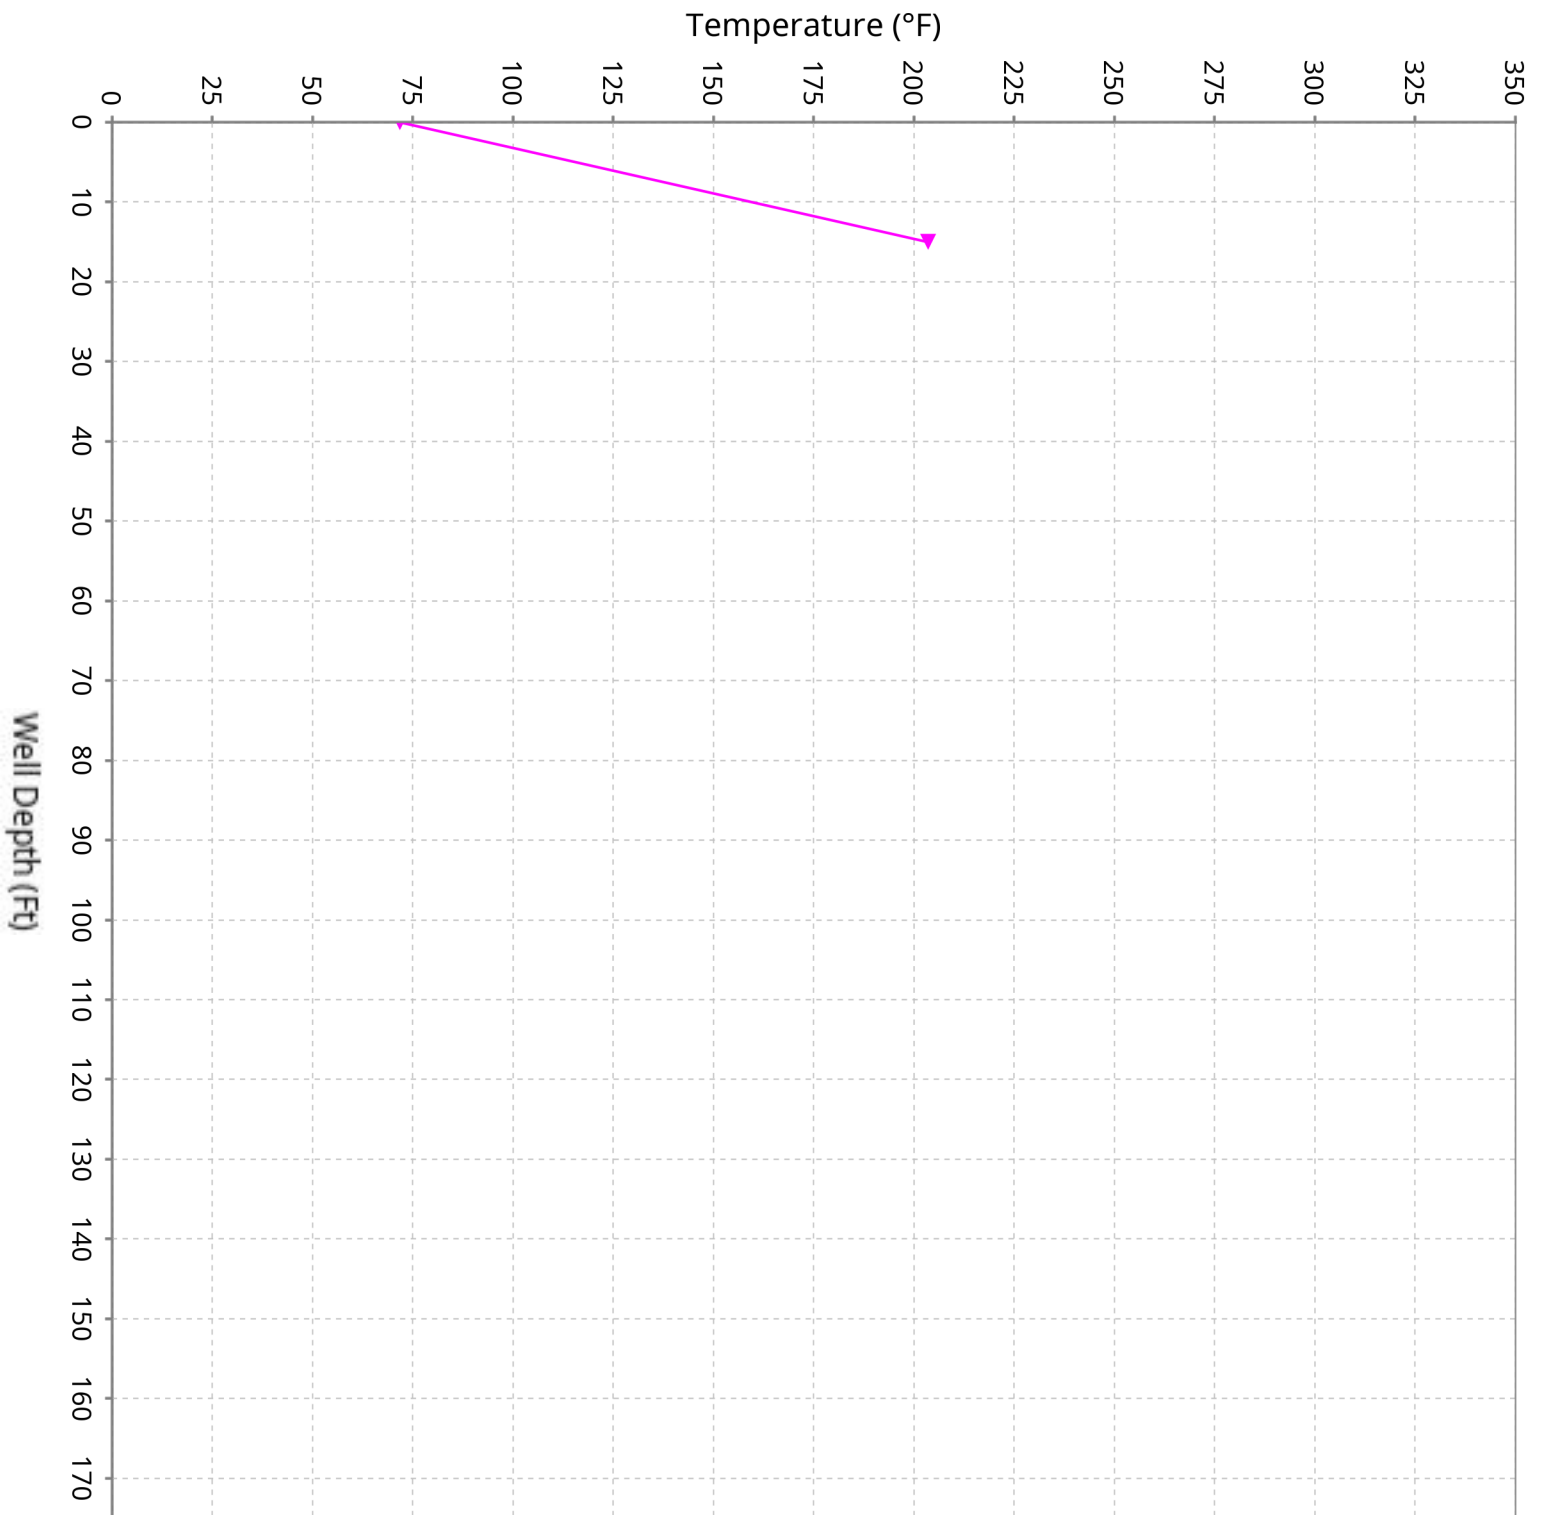


Vertical Temperature Profiles from Temperature Probes at Chiquita Landfill for TP-23

Maximum data for 1/1/2026 to 2/11/2026

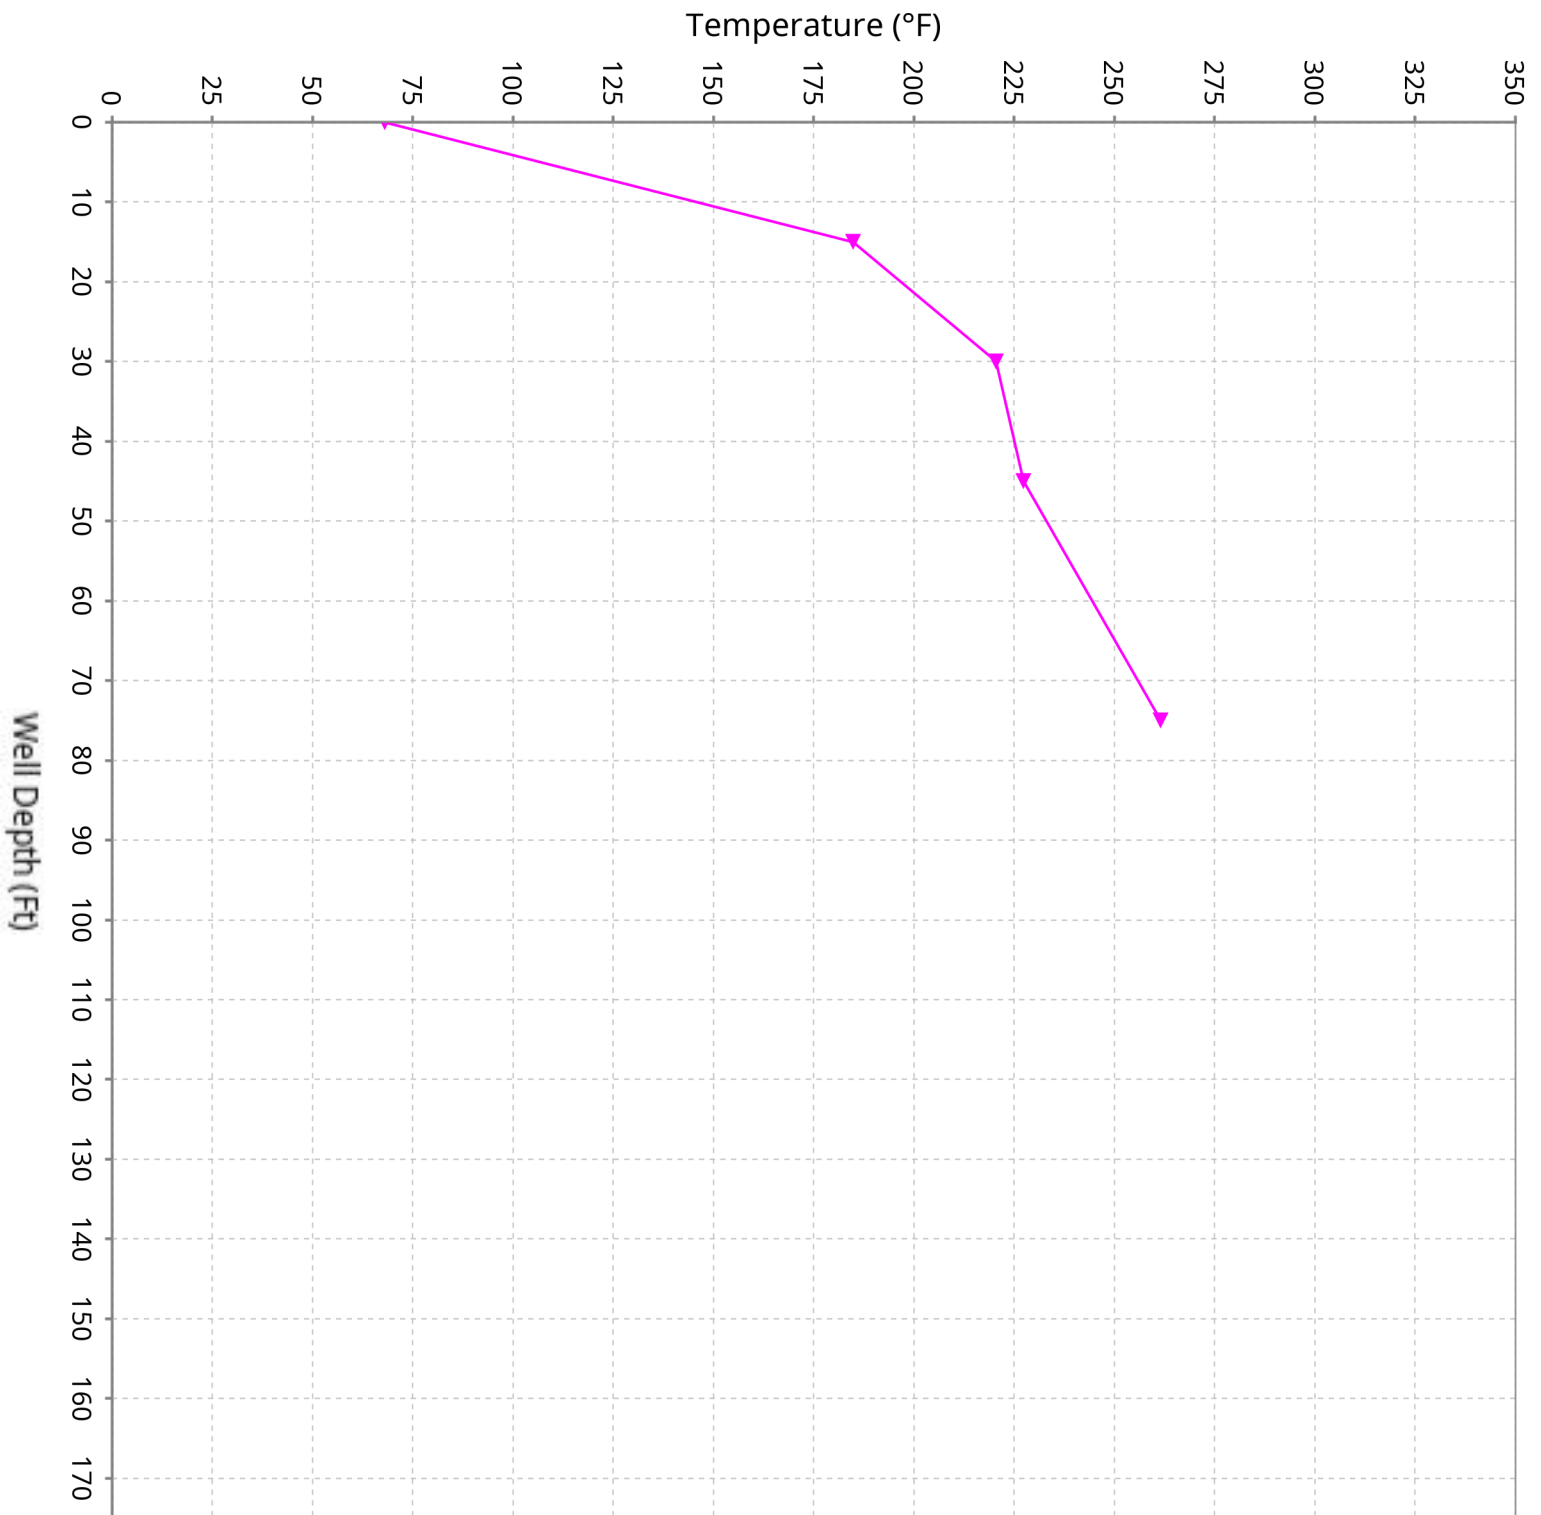


Vertical Temperature Profiles from Temperature Probes at Chiquita Landfill for TP-24

Maximum data for 1/1/2026 to 2/11/2026

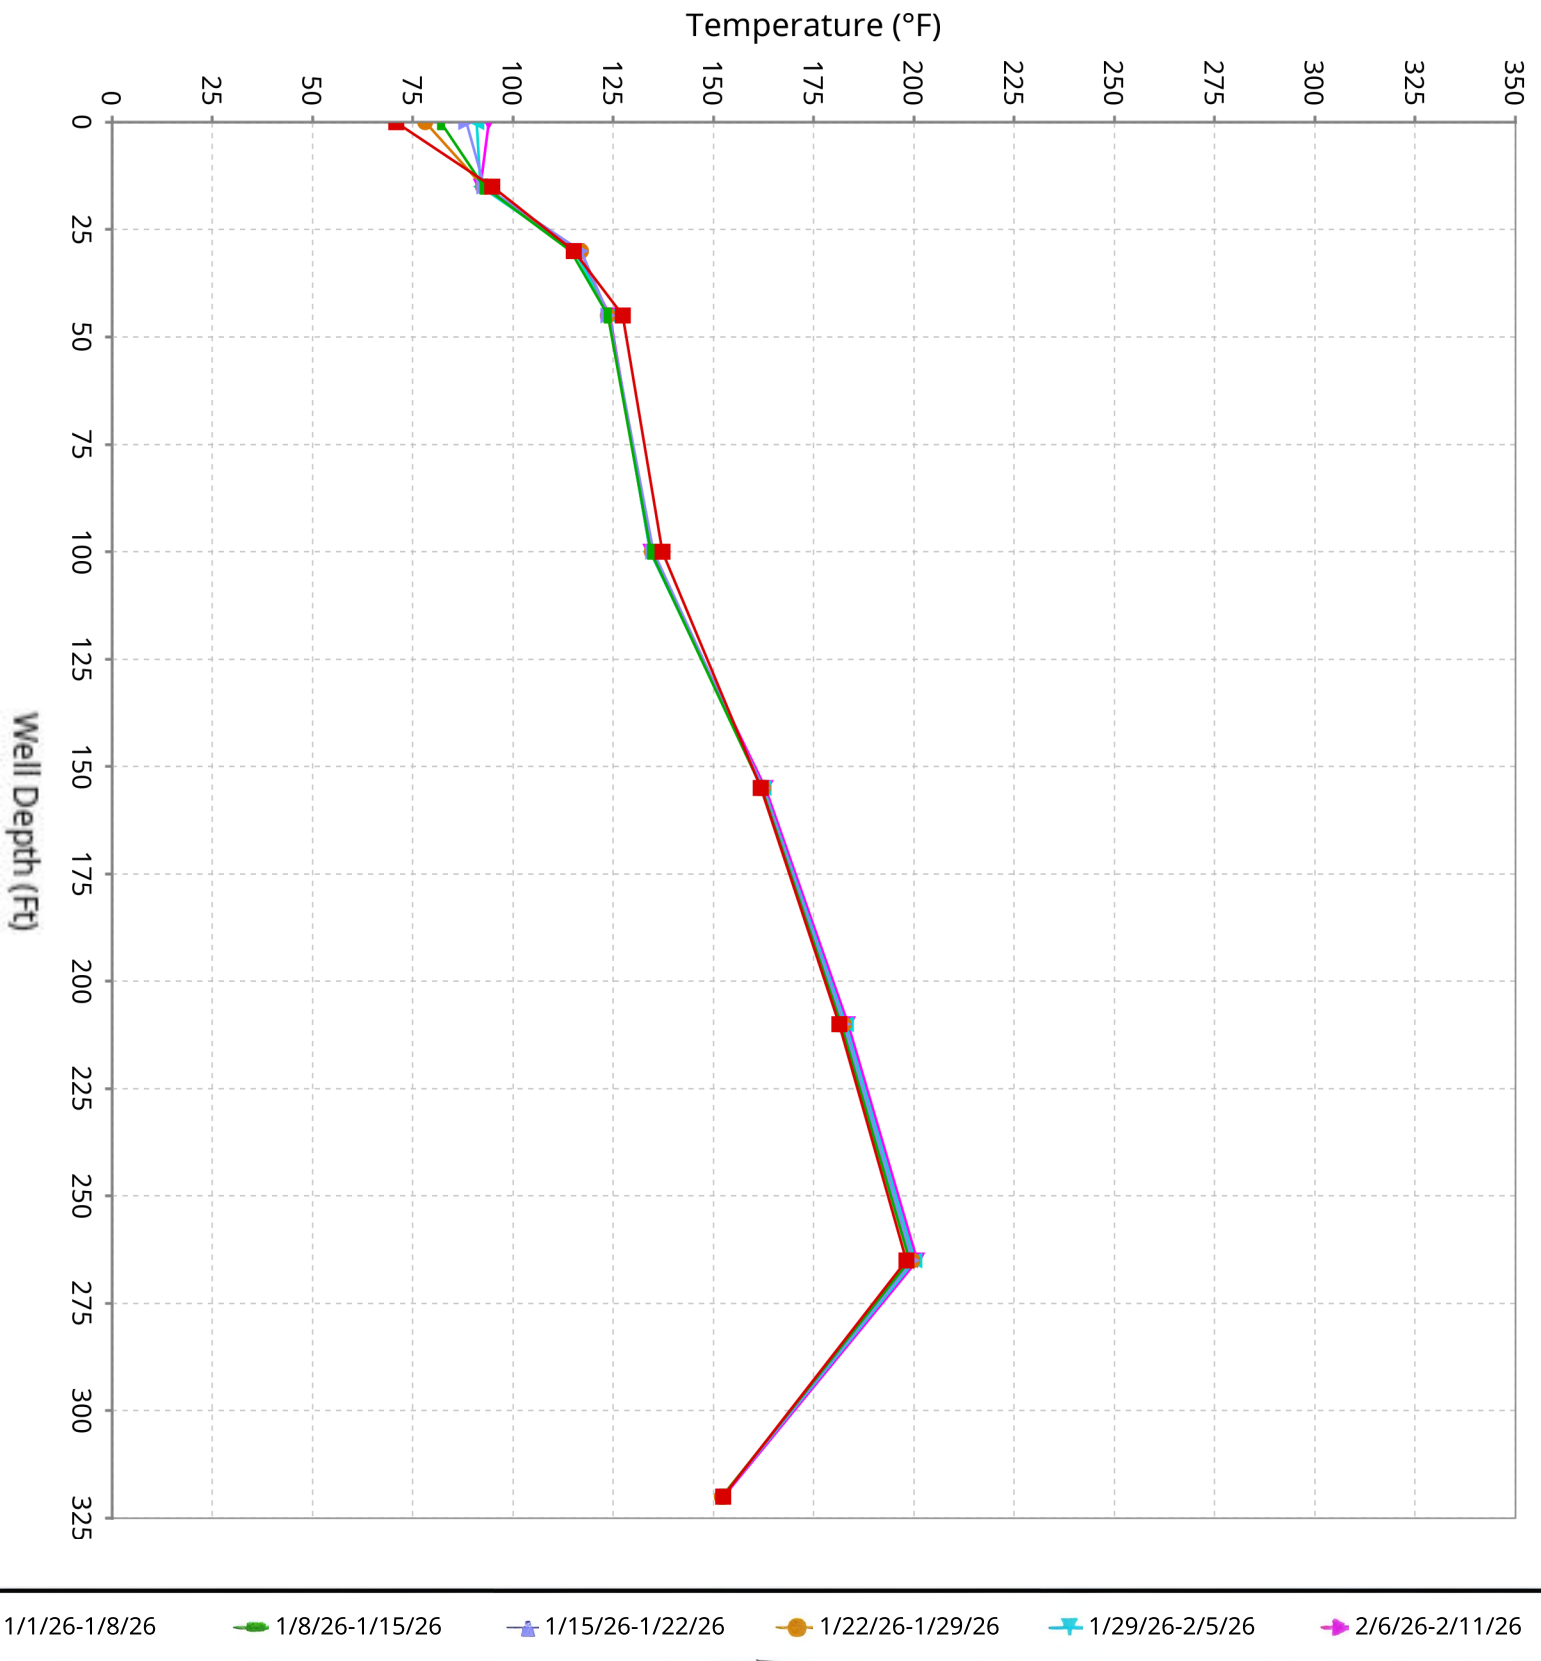


Vertical Temperature Profiles from Temperature Probes at Chiquita Landfill for TP-25

Maximum data for 1/1/2026 to 2/11/2026

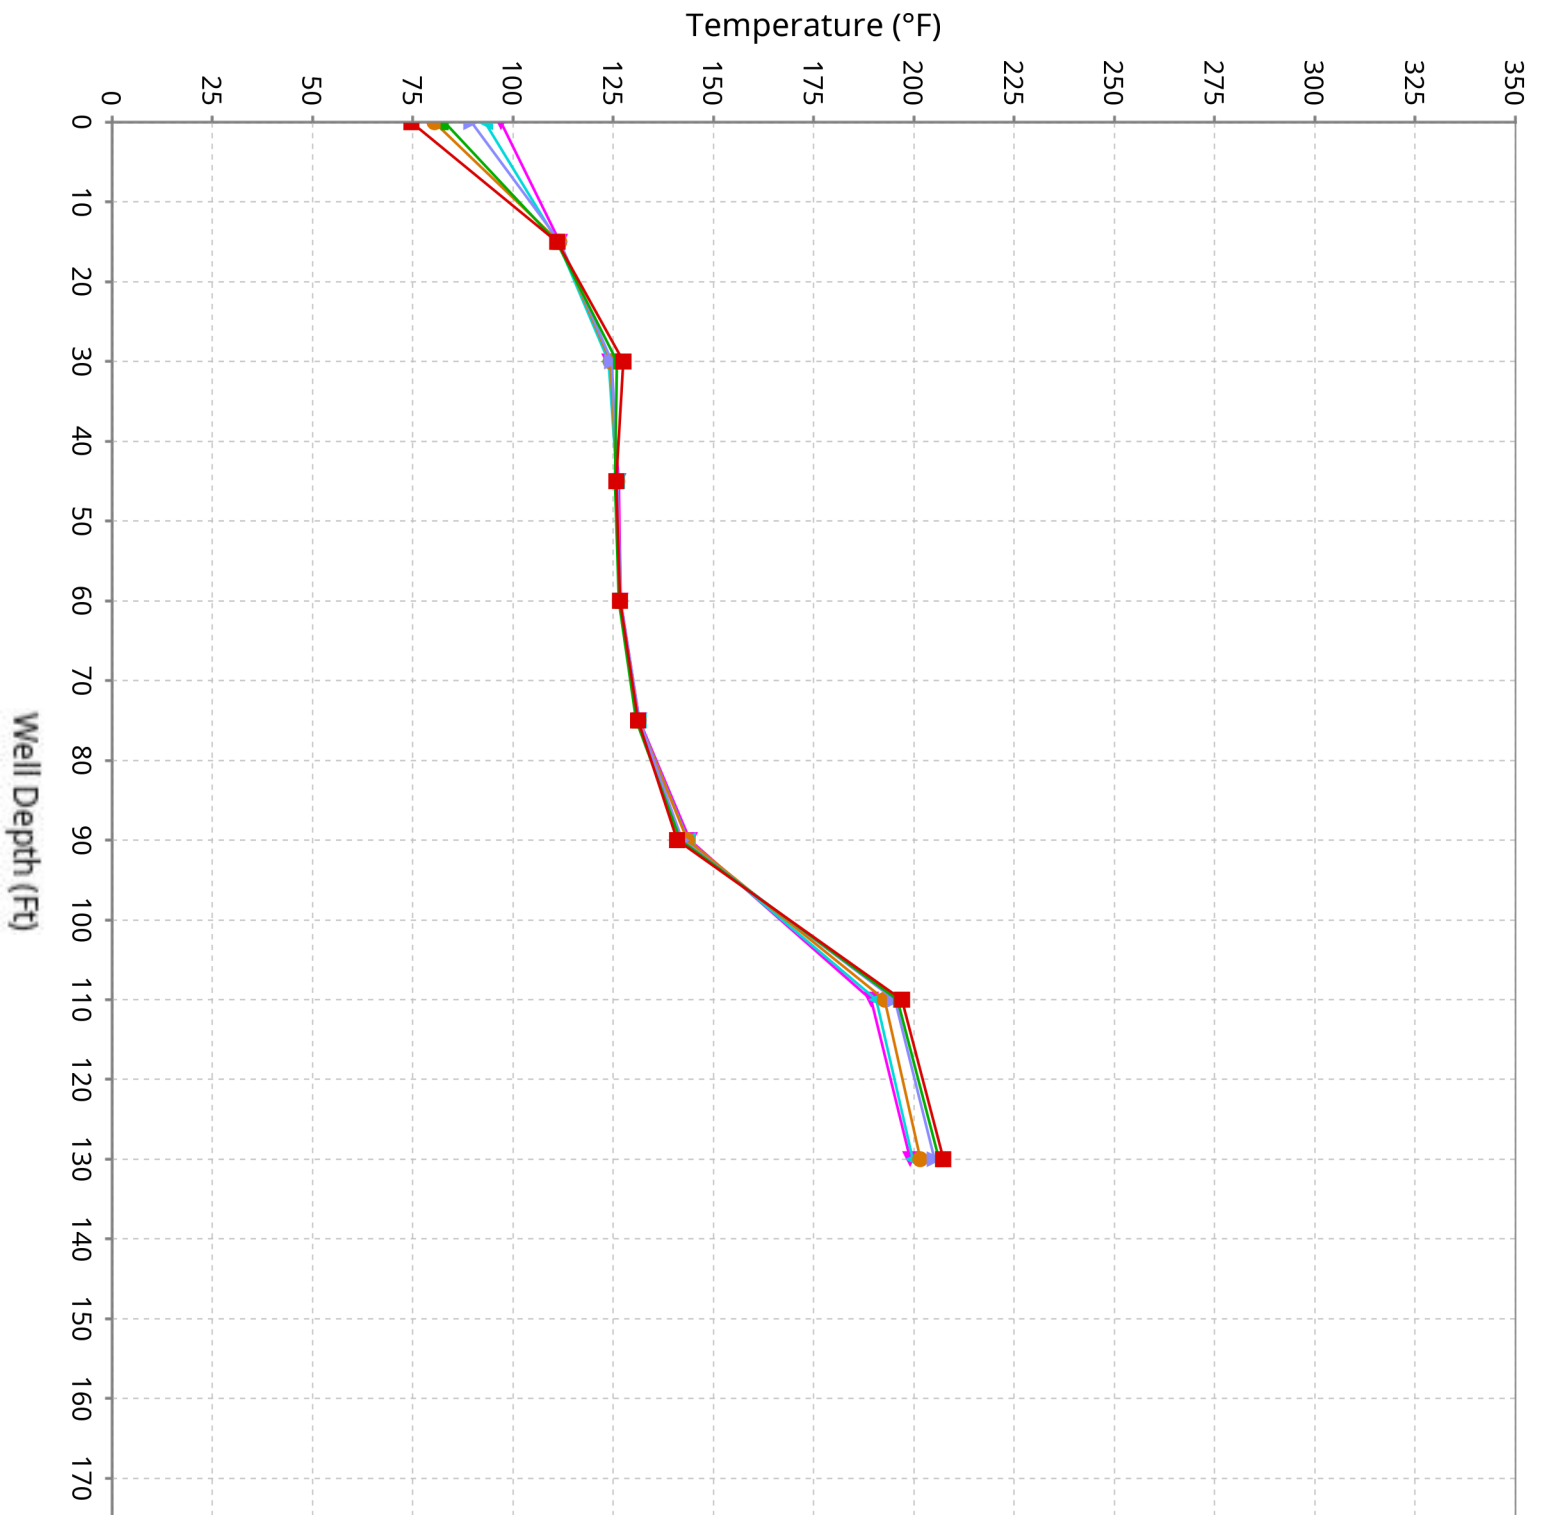


Vertical Temperature Profiles from Temperature Probes at Chiquita Landfill for TP-26

Maximum data for 1/1/2026 to 2/11/2026

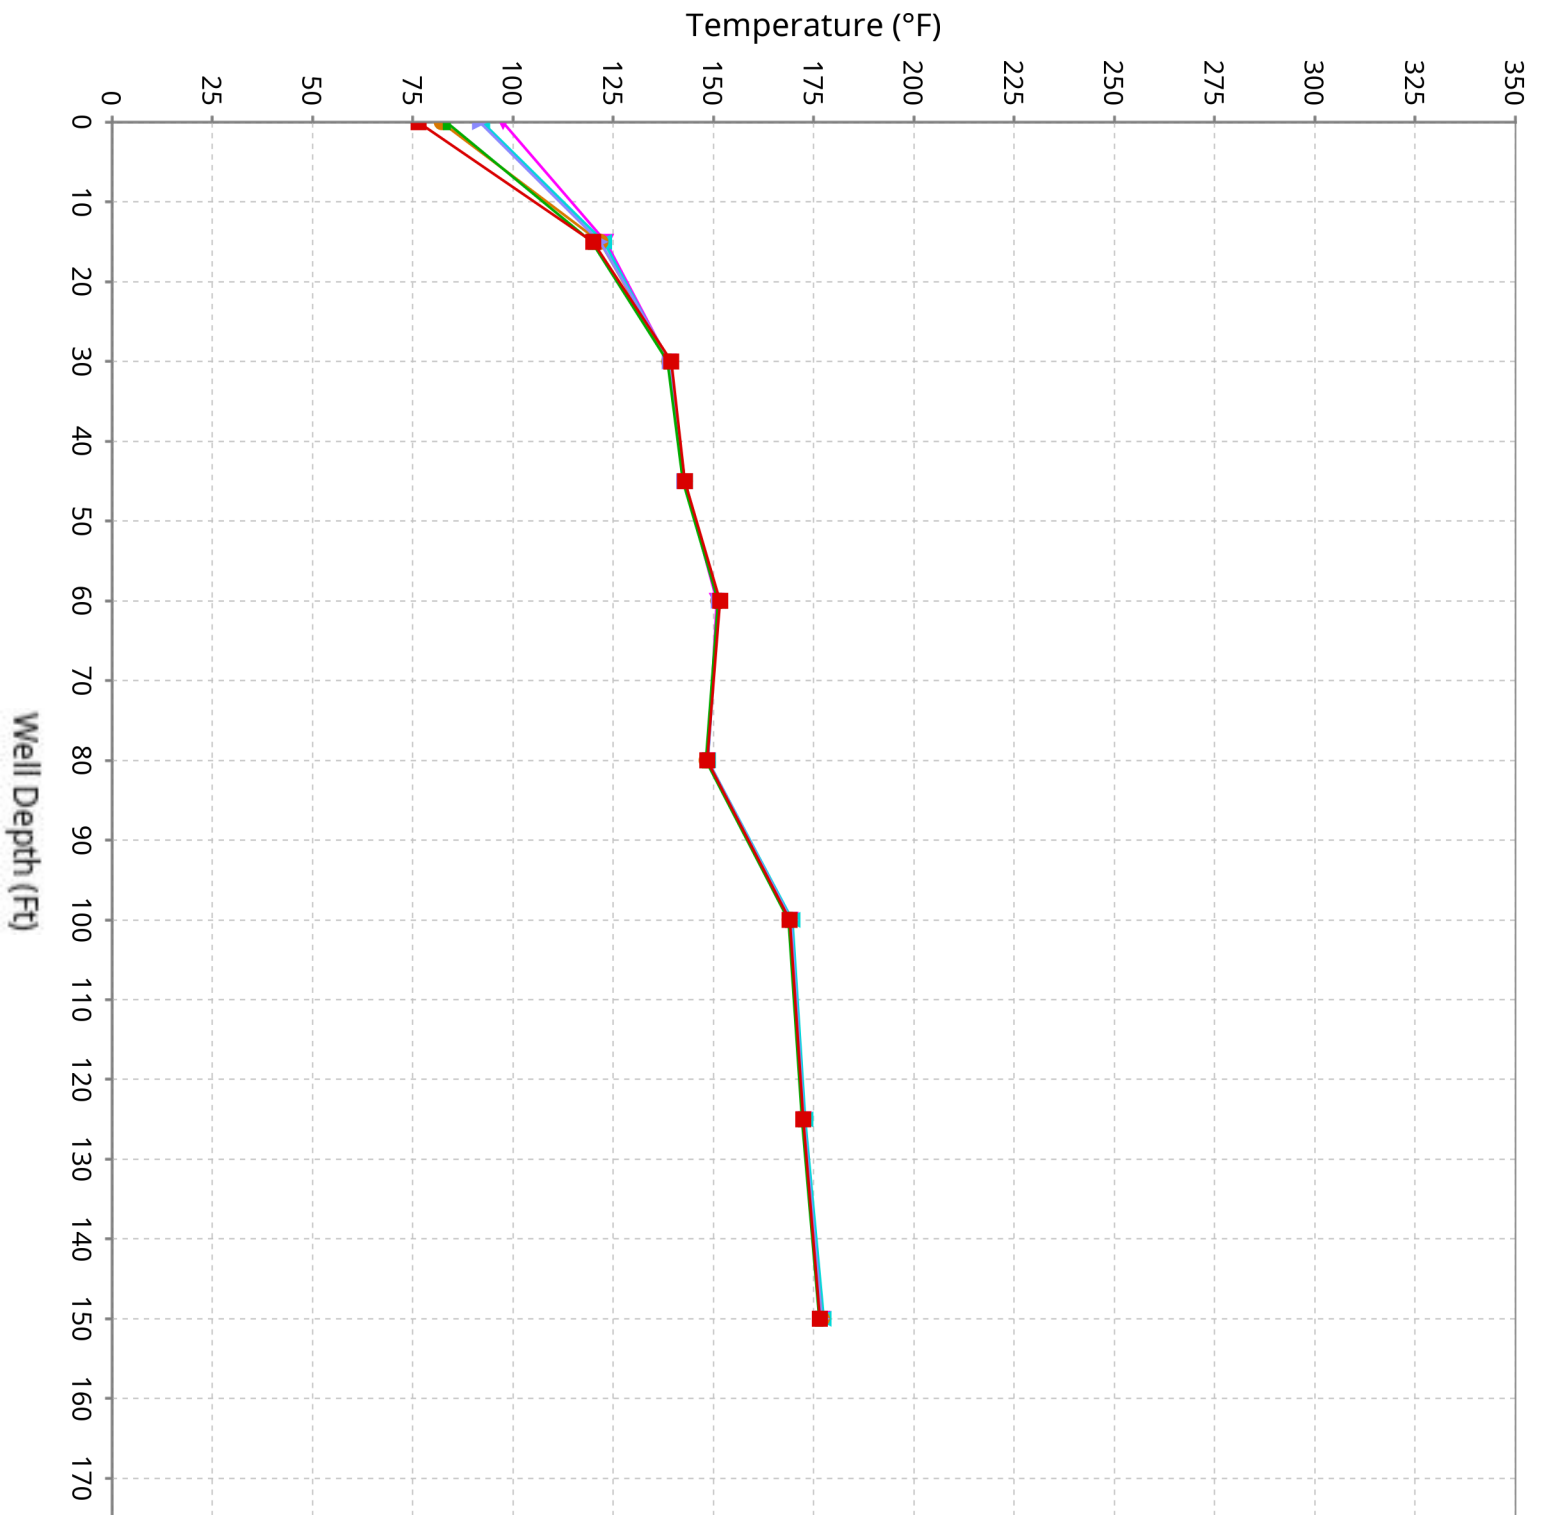


Vertical Temperature Profiles from Temperature Probes at Chiquita Landfill for TP-27

Maximum data for 1/1/2026 to 2/11/2026

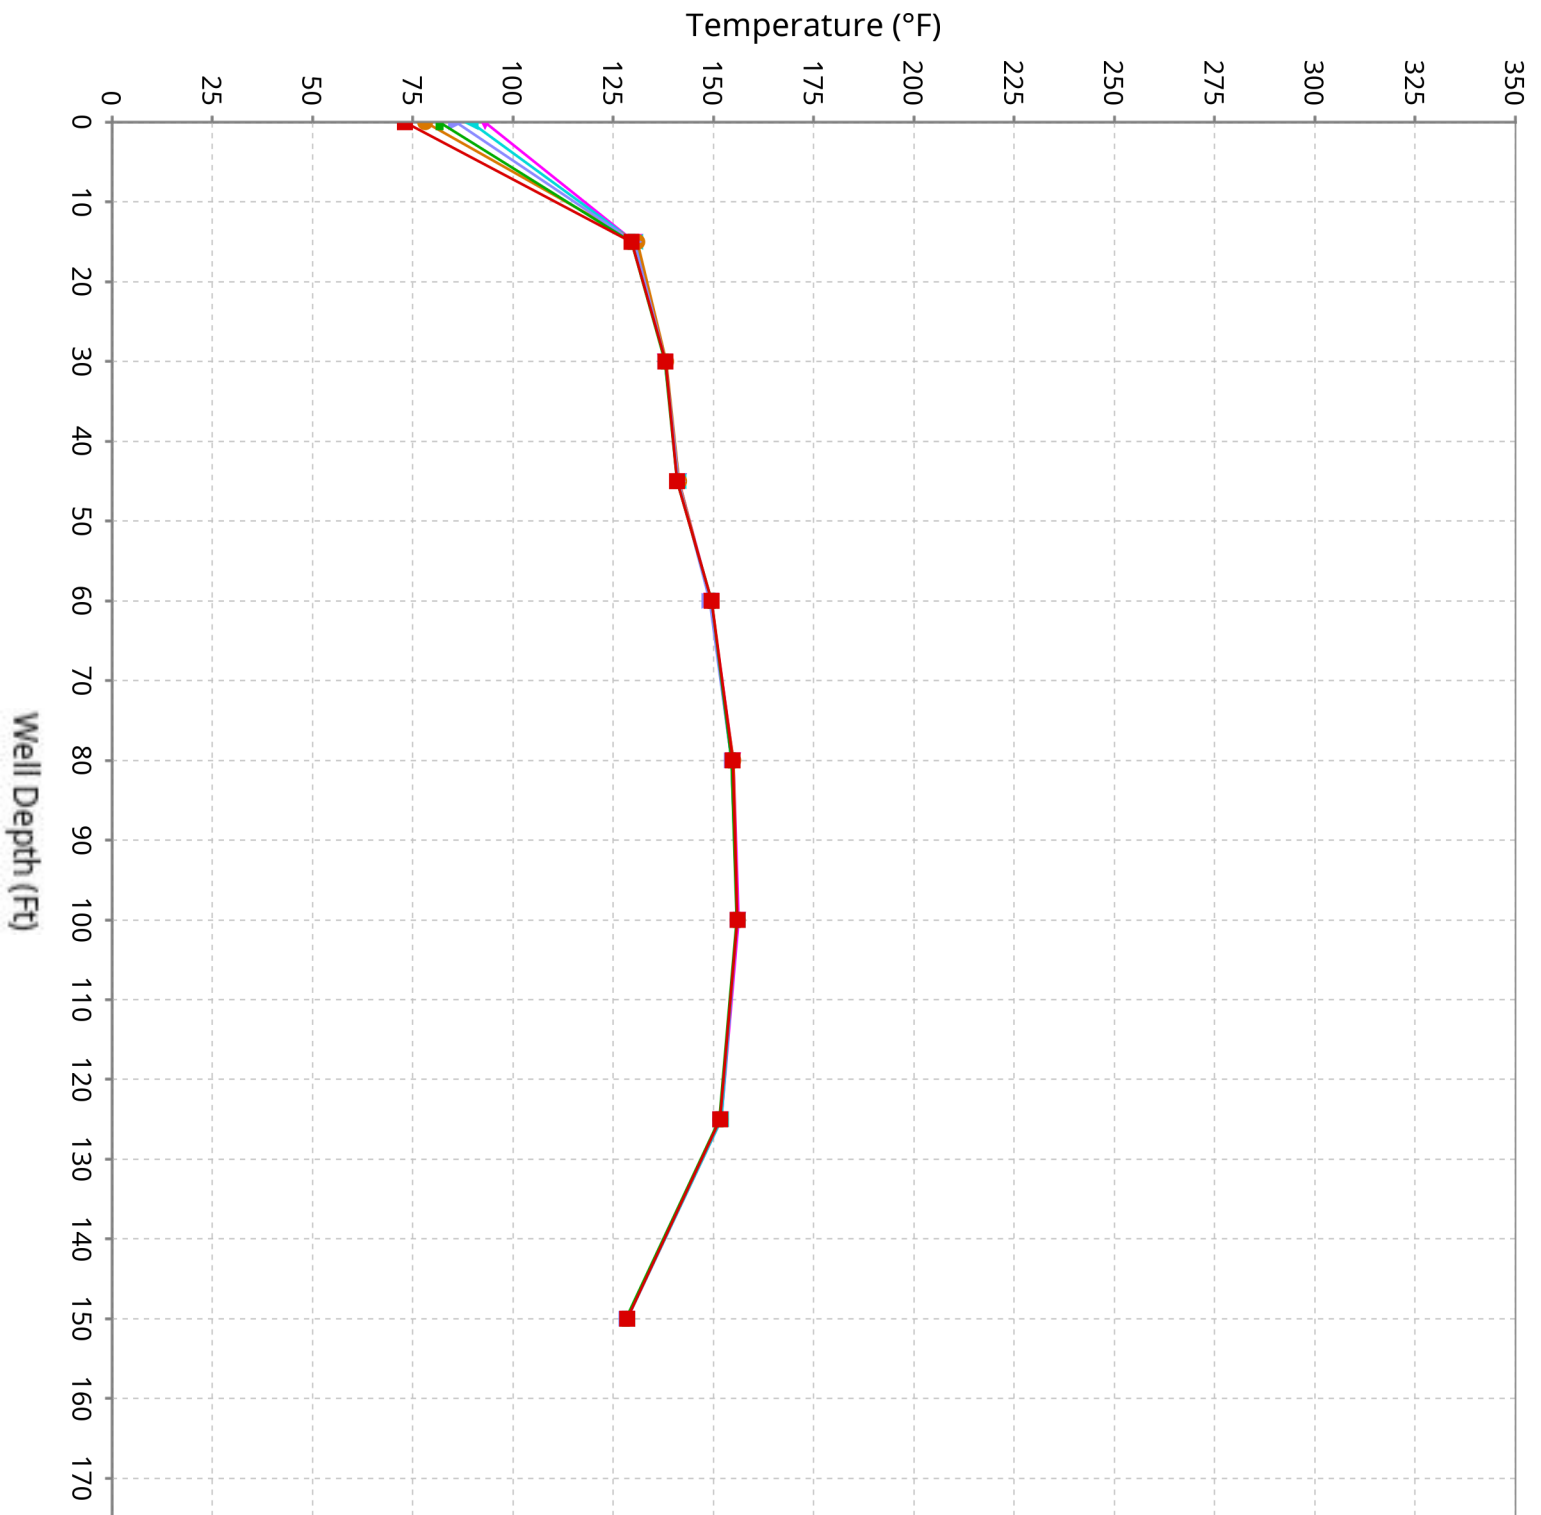


Vertical Temperature Profiles from Temperature Probes at Chiquita Landfill for TP-28

Maximum data for 1/1/2026 to 2/11/2026

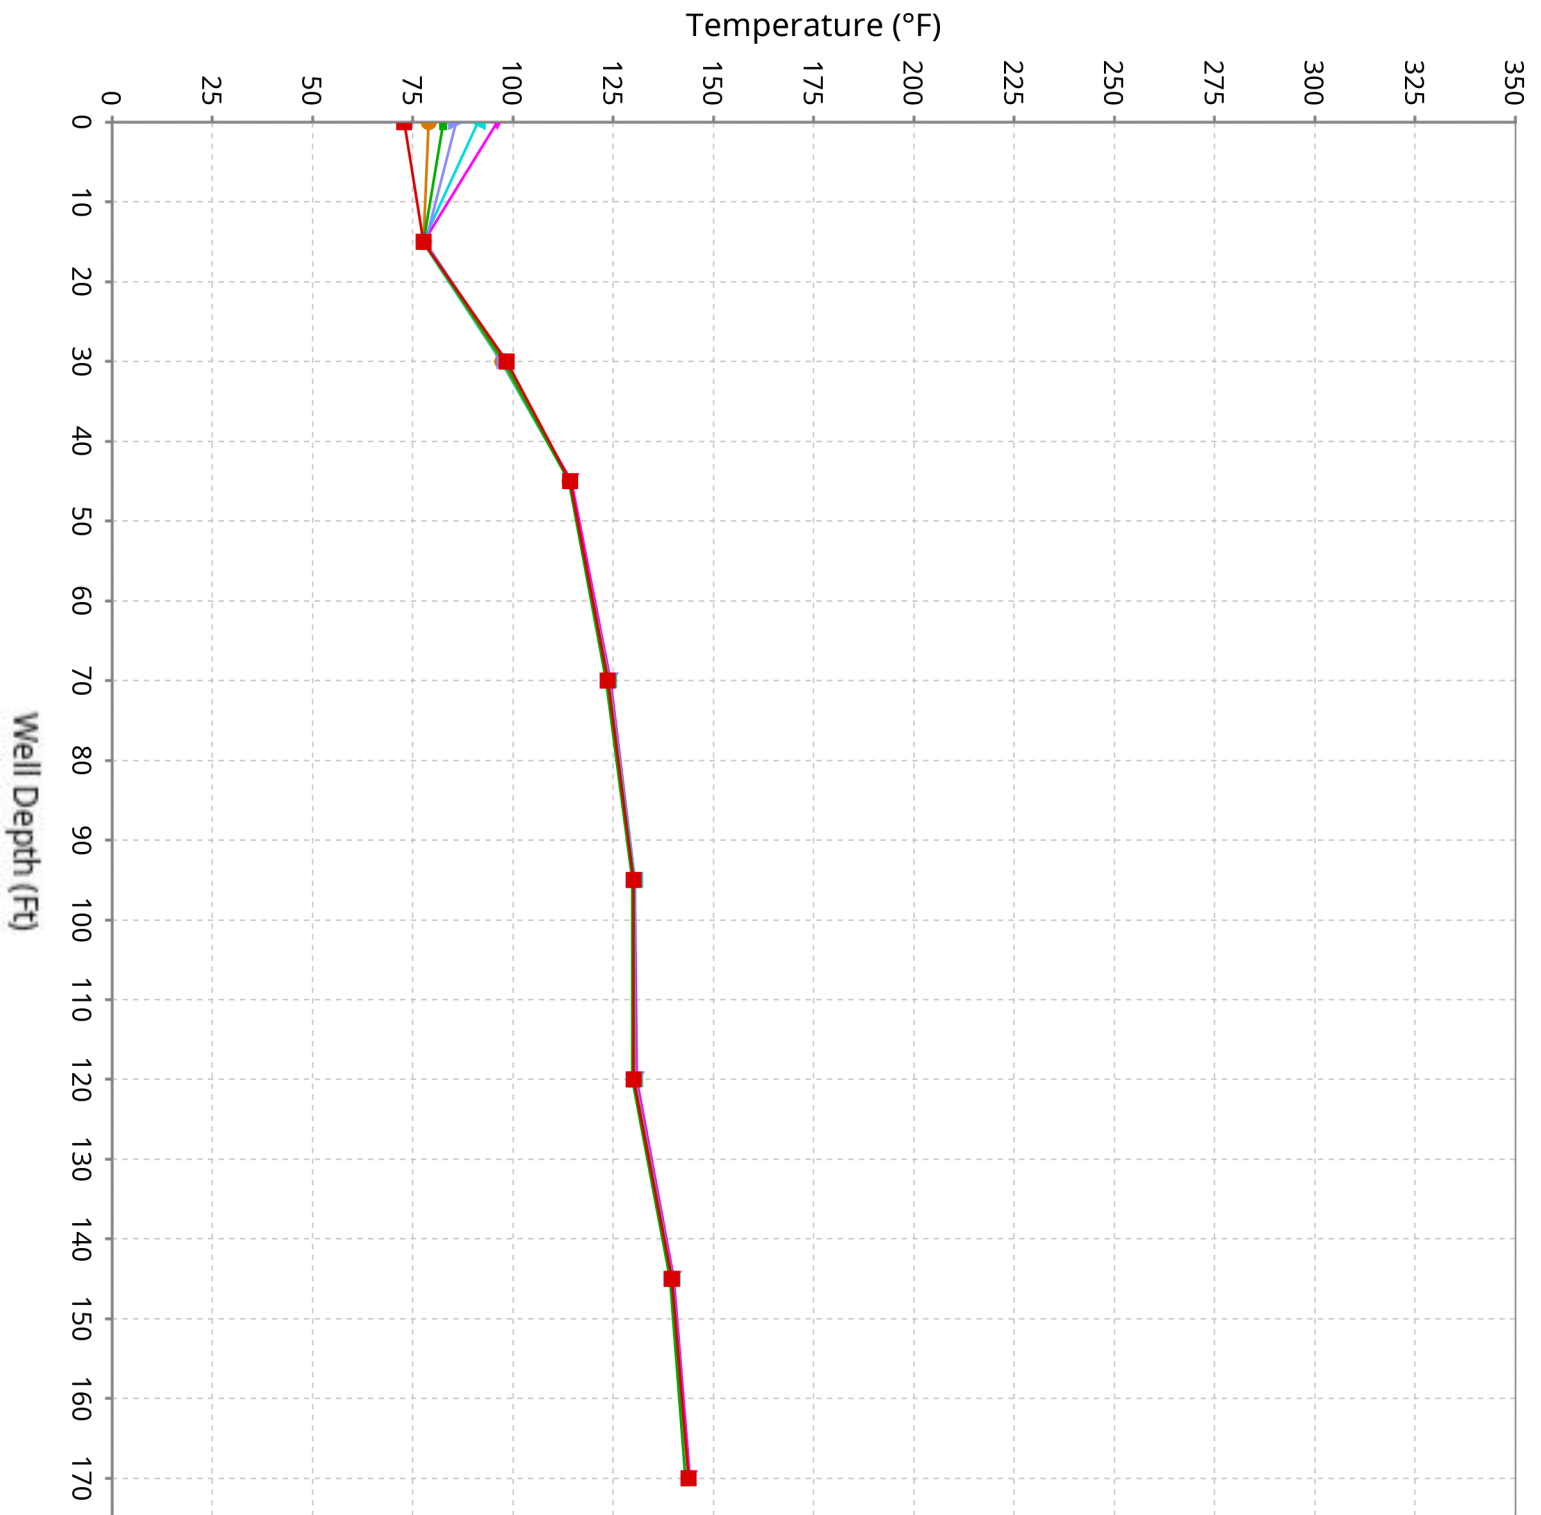


Vertical Temperature Profiles from Temperature Probes at Chiquita Landfill for TP-29

Maximum data for 1/1/2026 to 2/11/2026

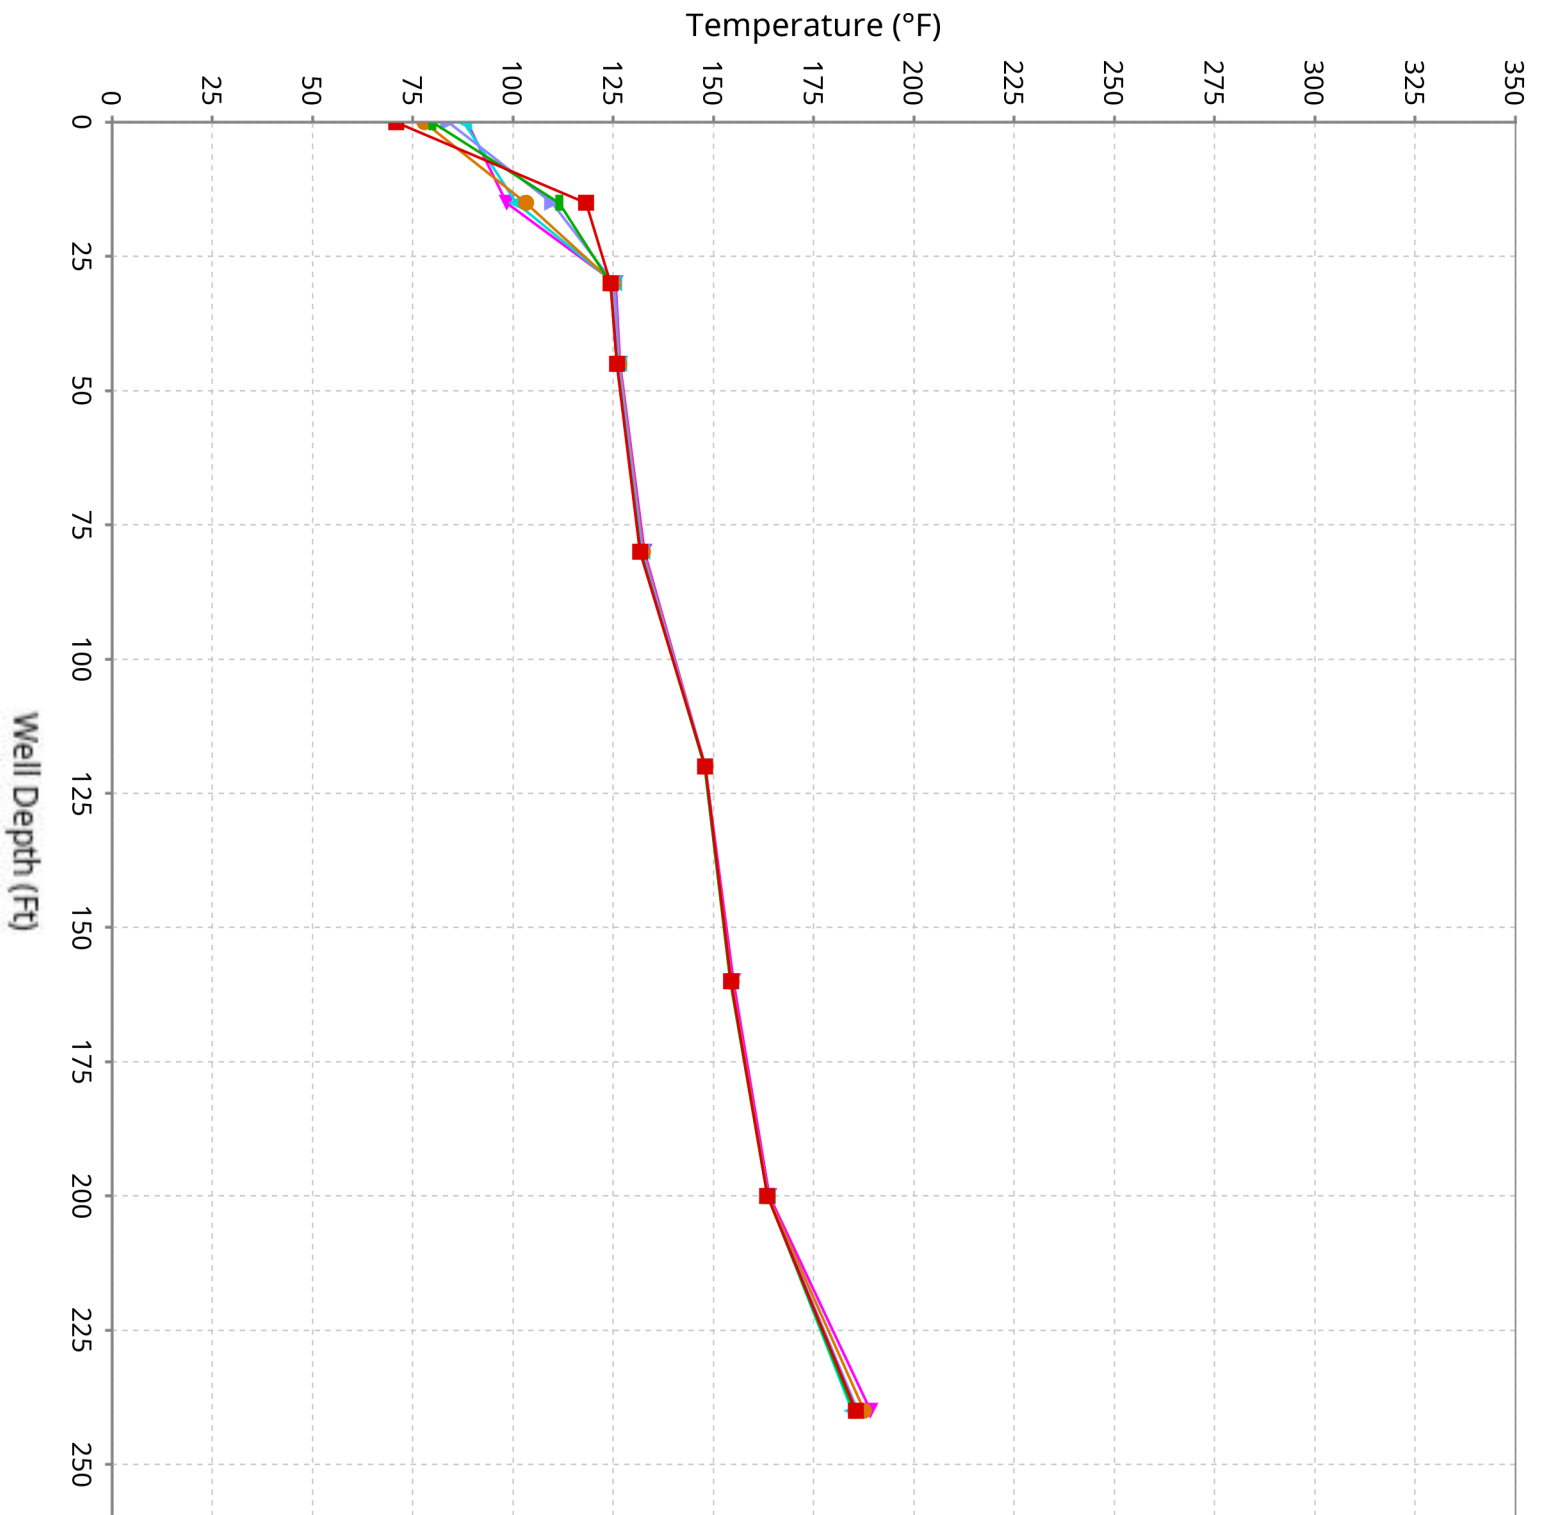


Vertical Temperature Profiles from Temperature Probes at Chiquita Landfill for TP-30

Maximum data for 1/1/2026 to 2/11/2026

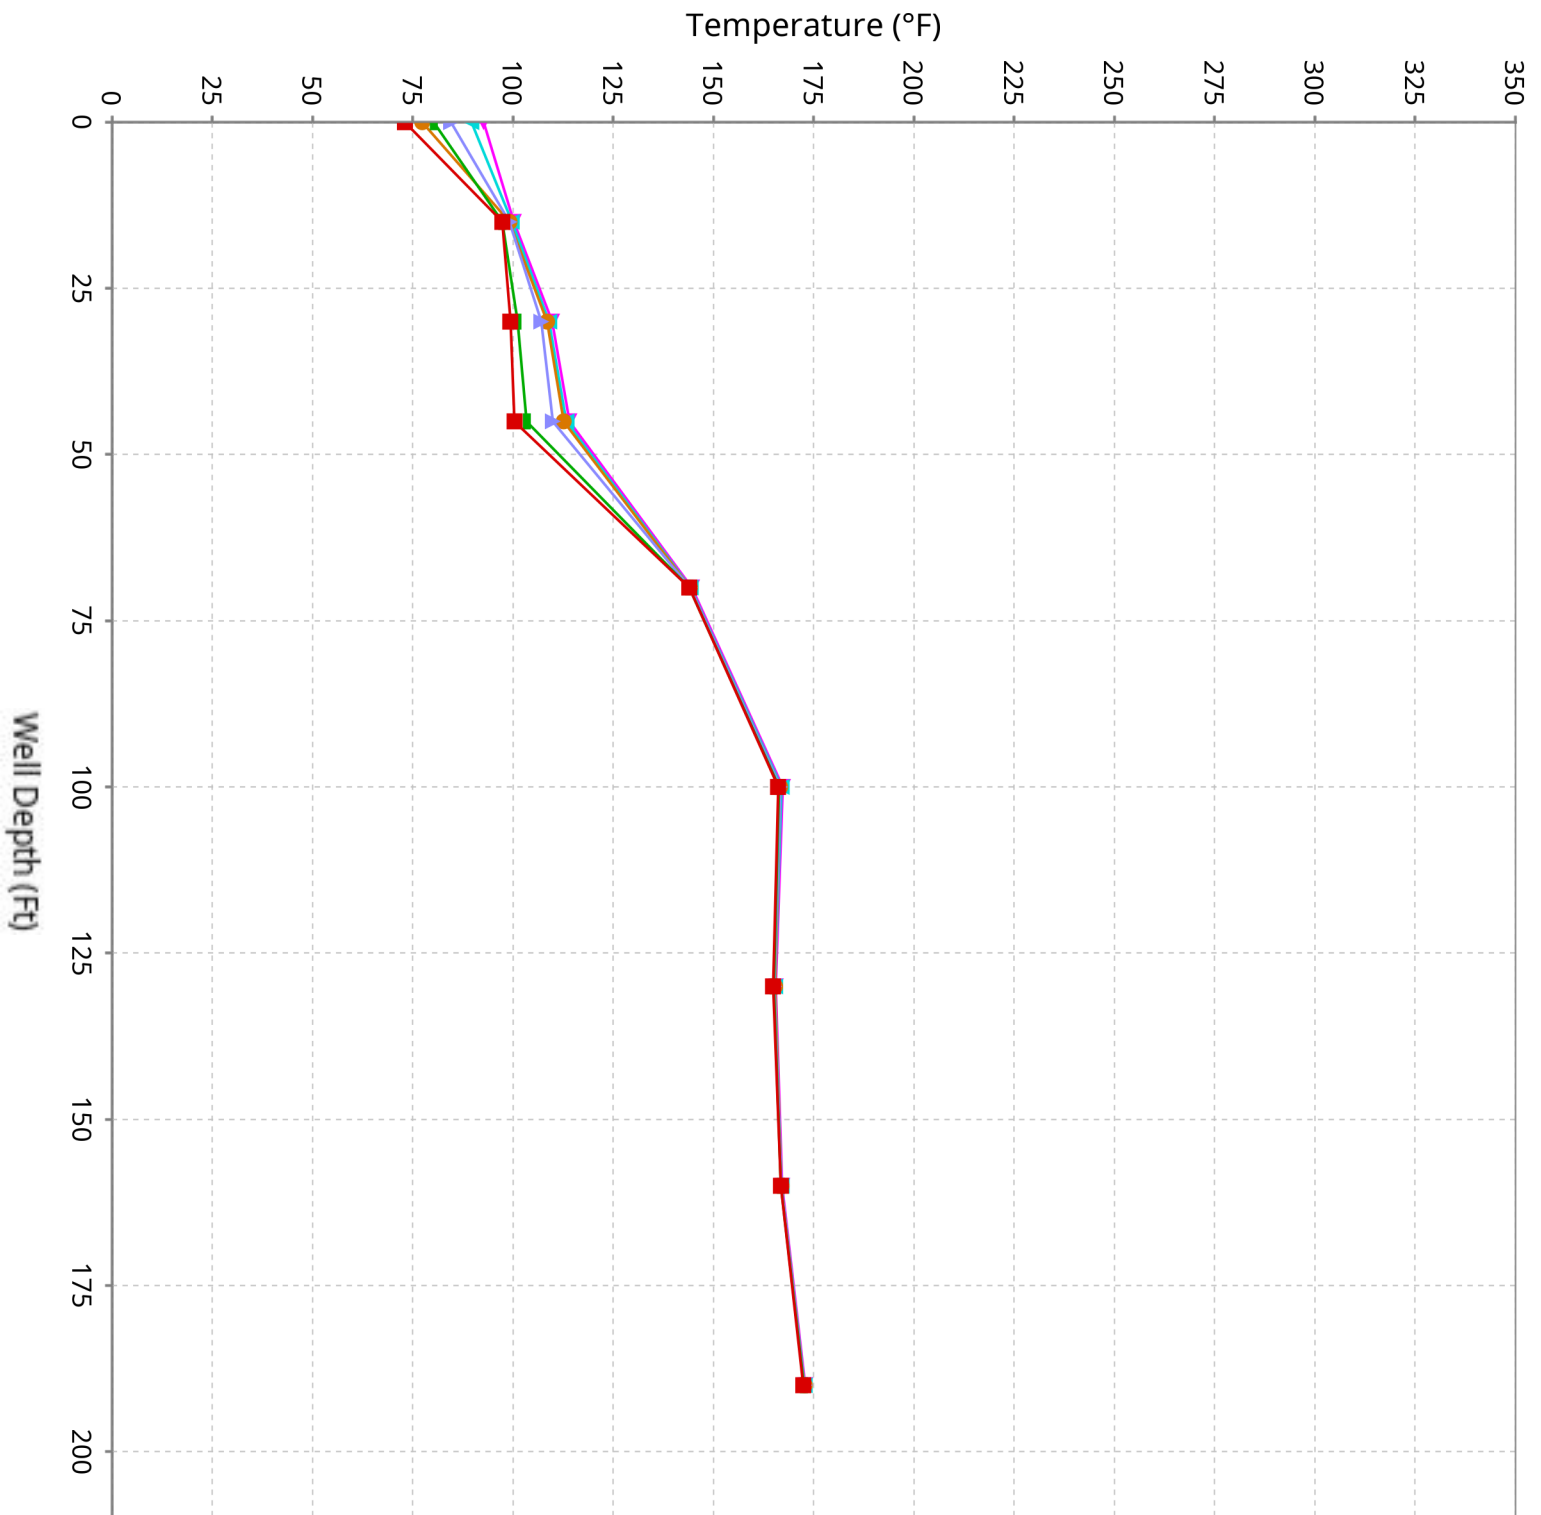


Vertical Temperature Profiles from Temperature Probes at Chiquita Landfill for TP-31

Maximum data for 1/1/2026 to 2/11/2026

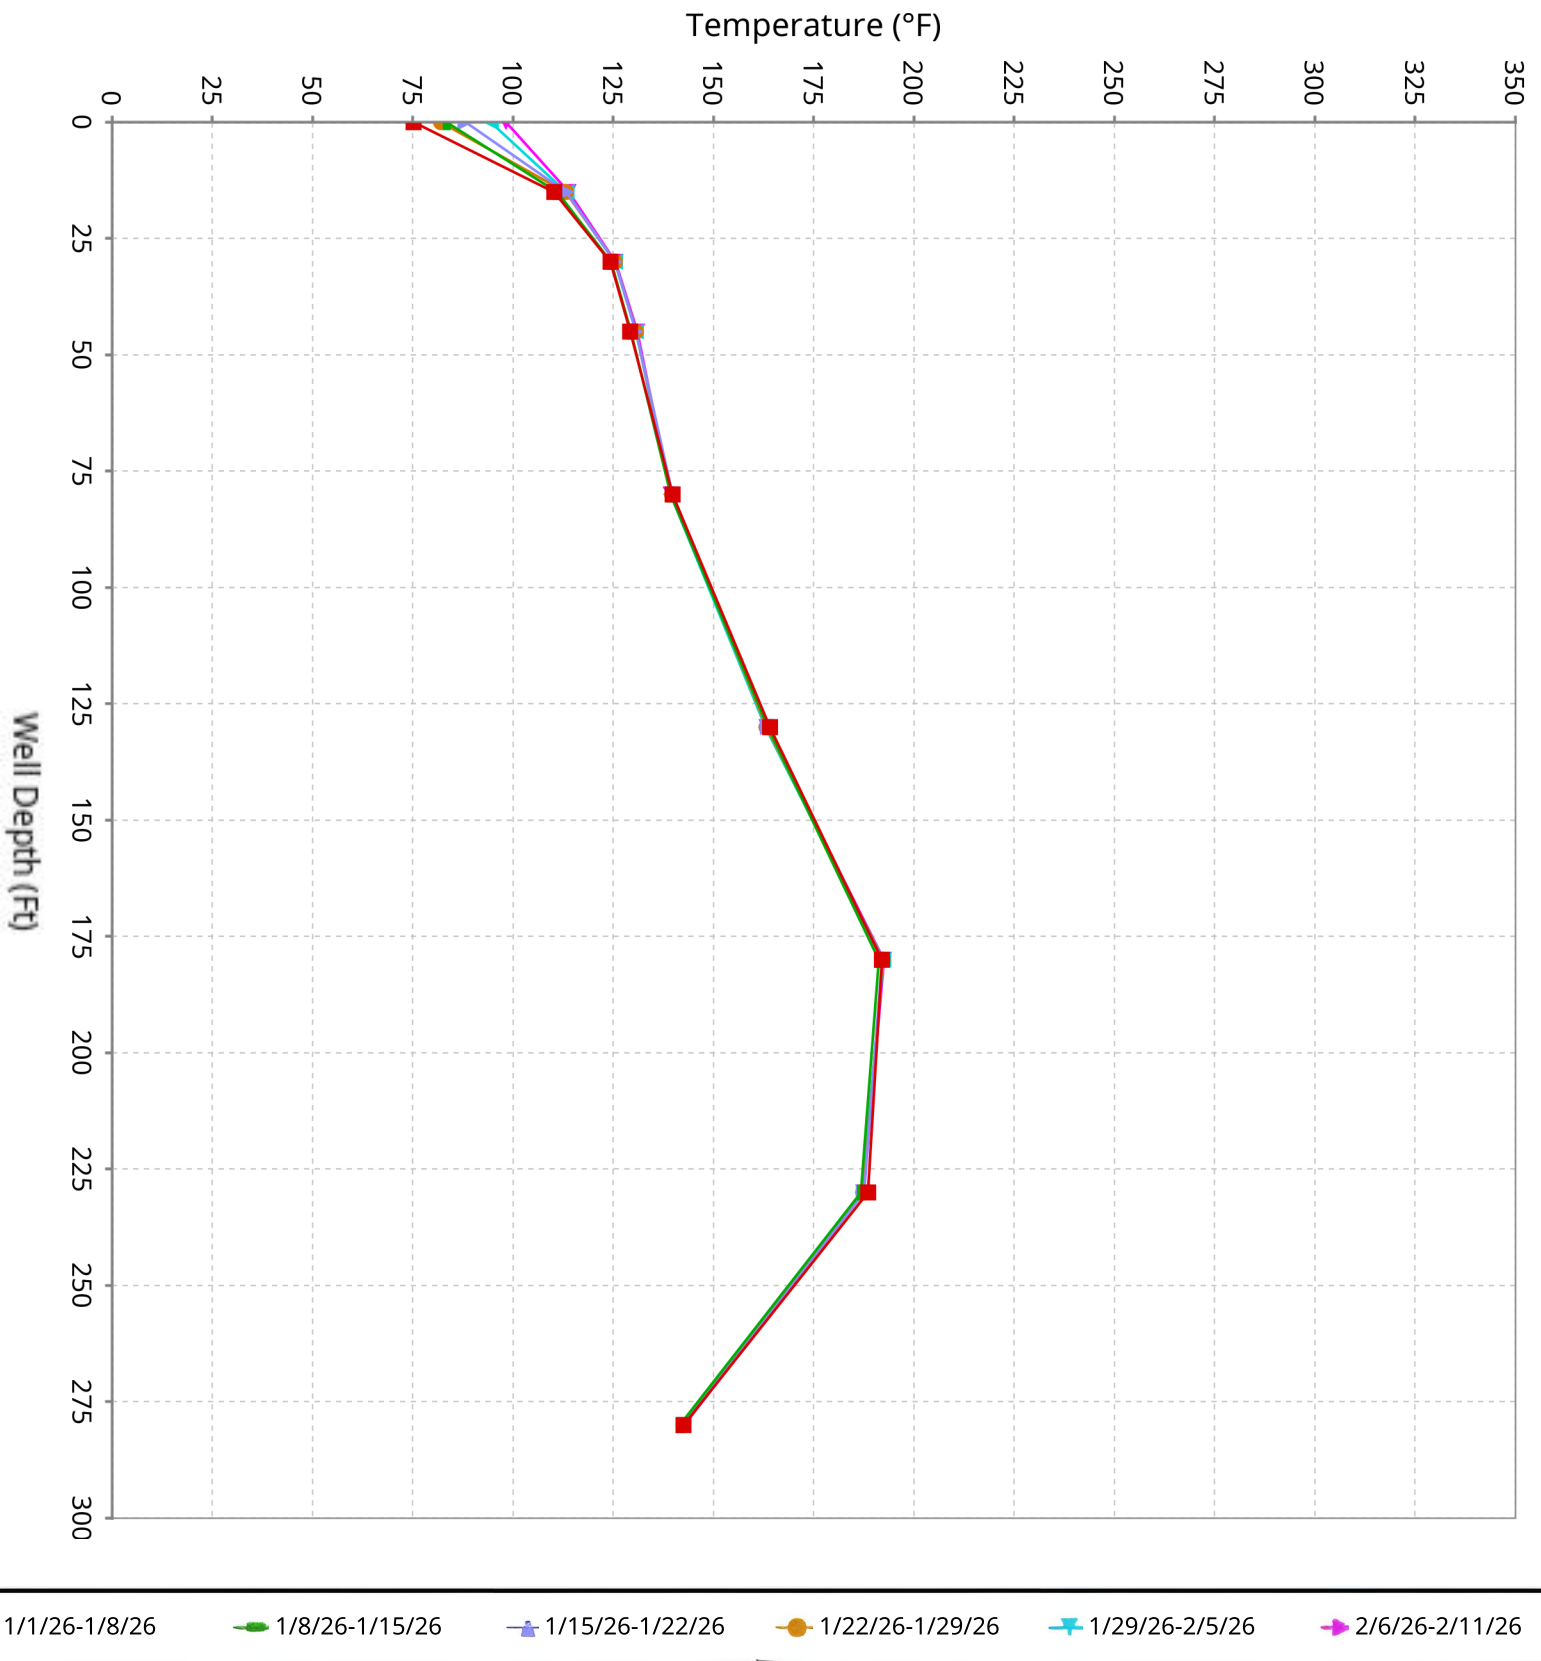


Vertical Temperature Profiles from Temperature Probes at Chiquita Landfill for TP-32

Maximum data for 1/1/2026 to 2/11/2026

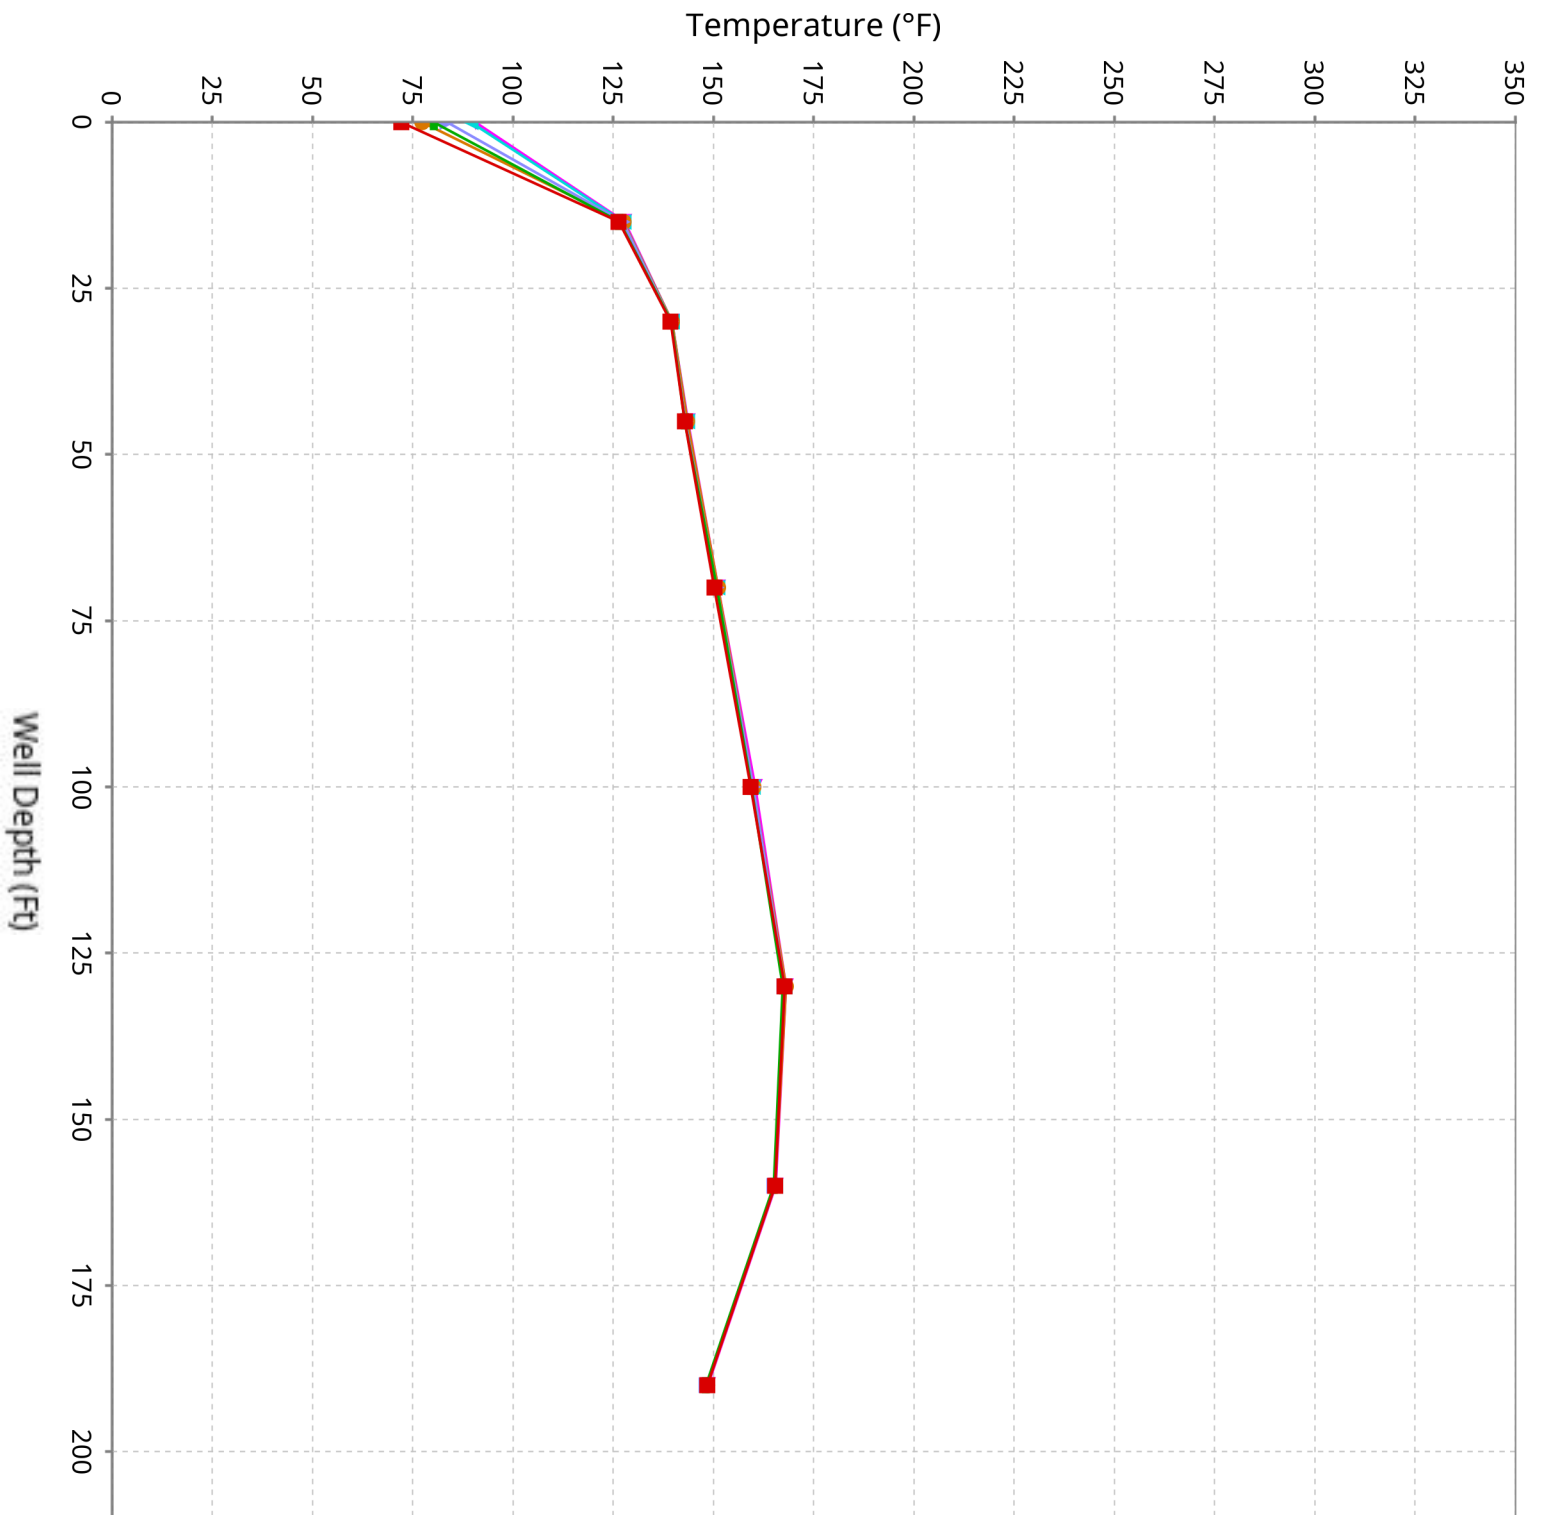


Vertical Temperature Profiles from Temperature Probes at Chiquita Landfill for TP-33

Maximum data for 1/1/2026 to 2/11/2026

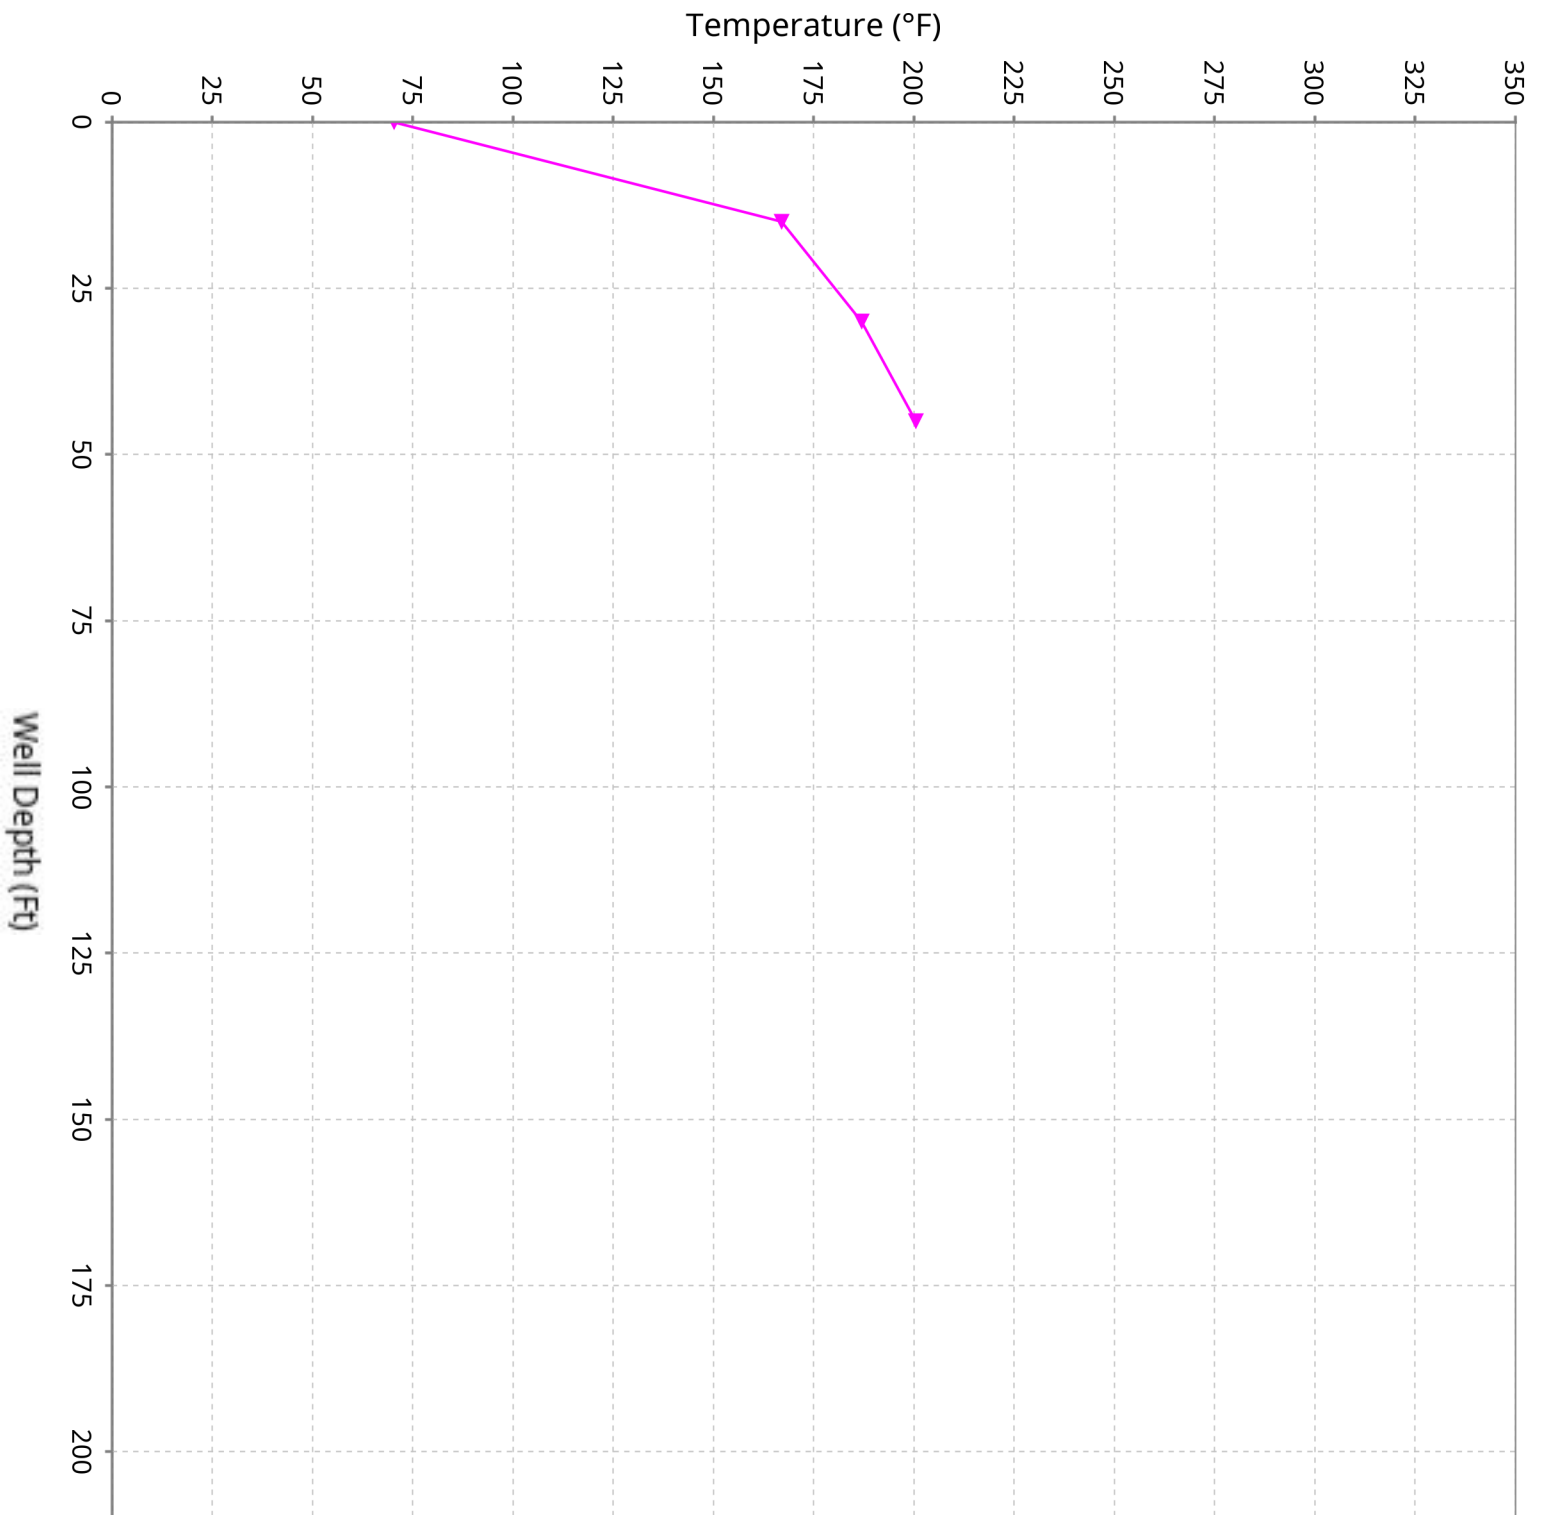


Vertical Temperature Profiles from Temperature Probes at Chiquita Landfill for TP-34

Maximum data for 1/1/2026 to 2/11/2026

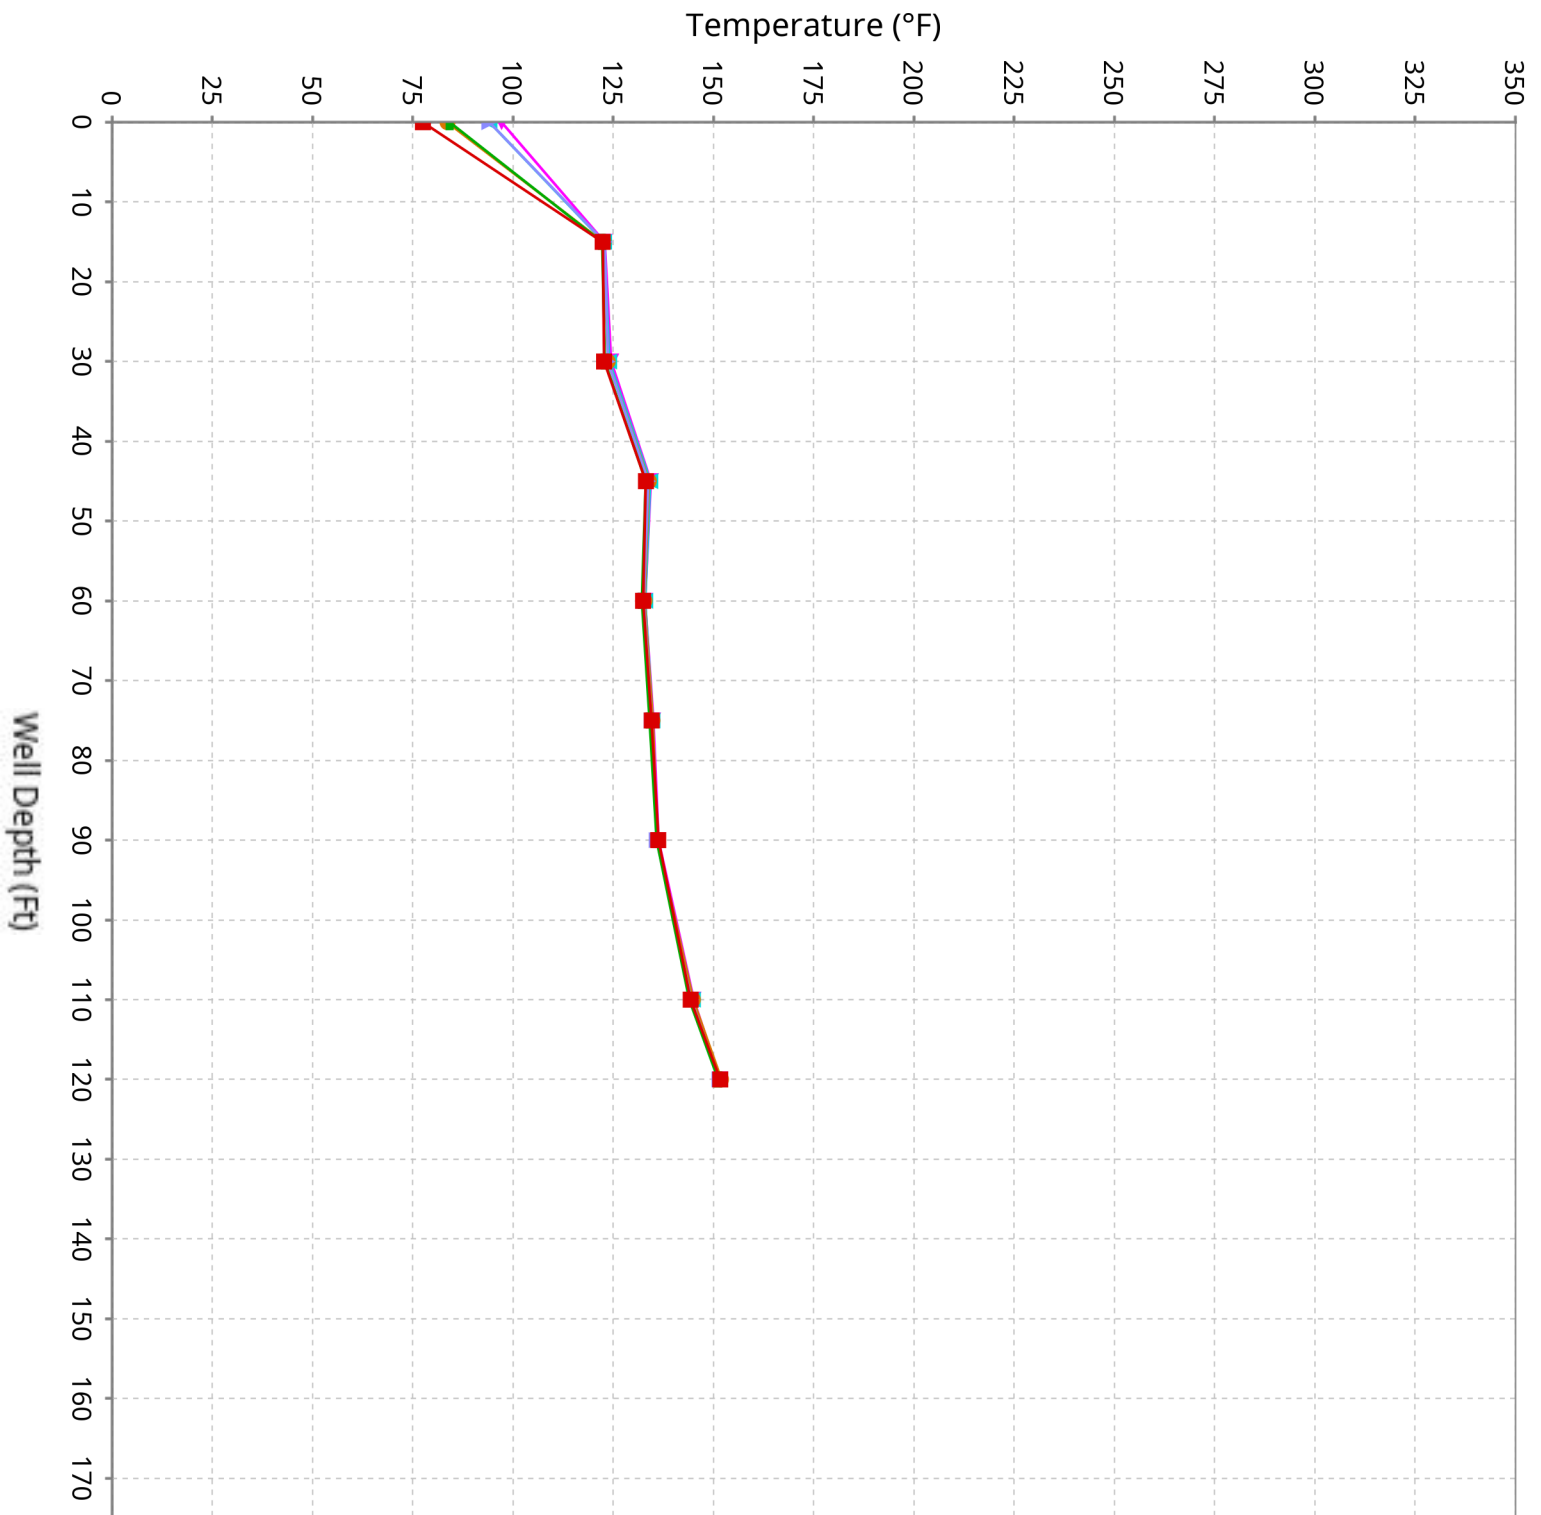


Vertical Temperature Profiles from Temperature Probes at Chiquita Landfill for TP-35

Maximum data for 1/1/2026 to 2/11/2026

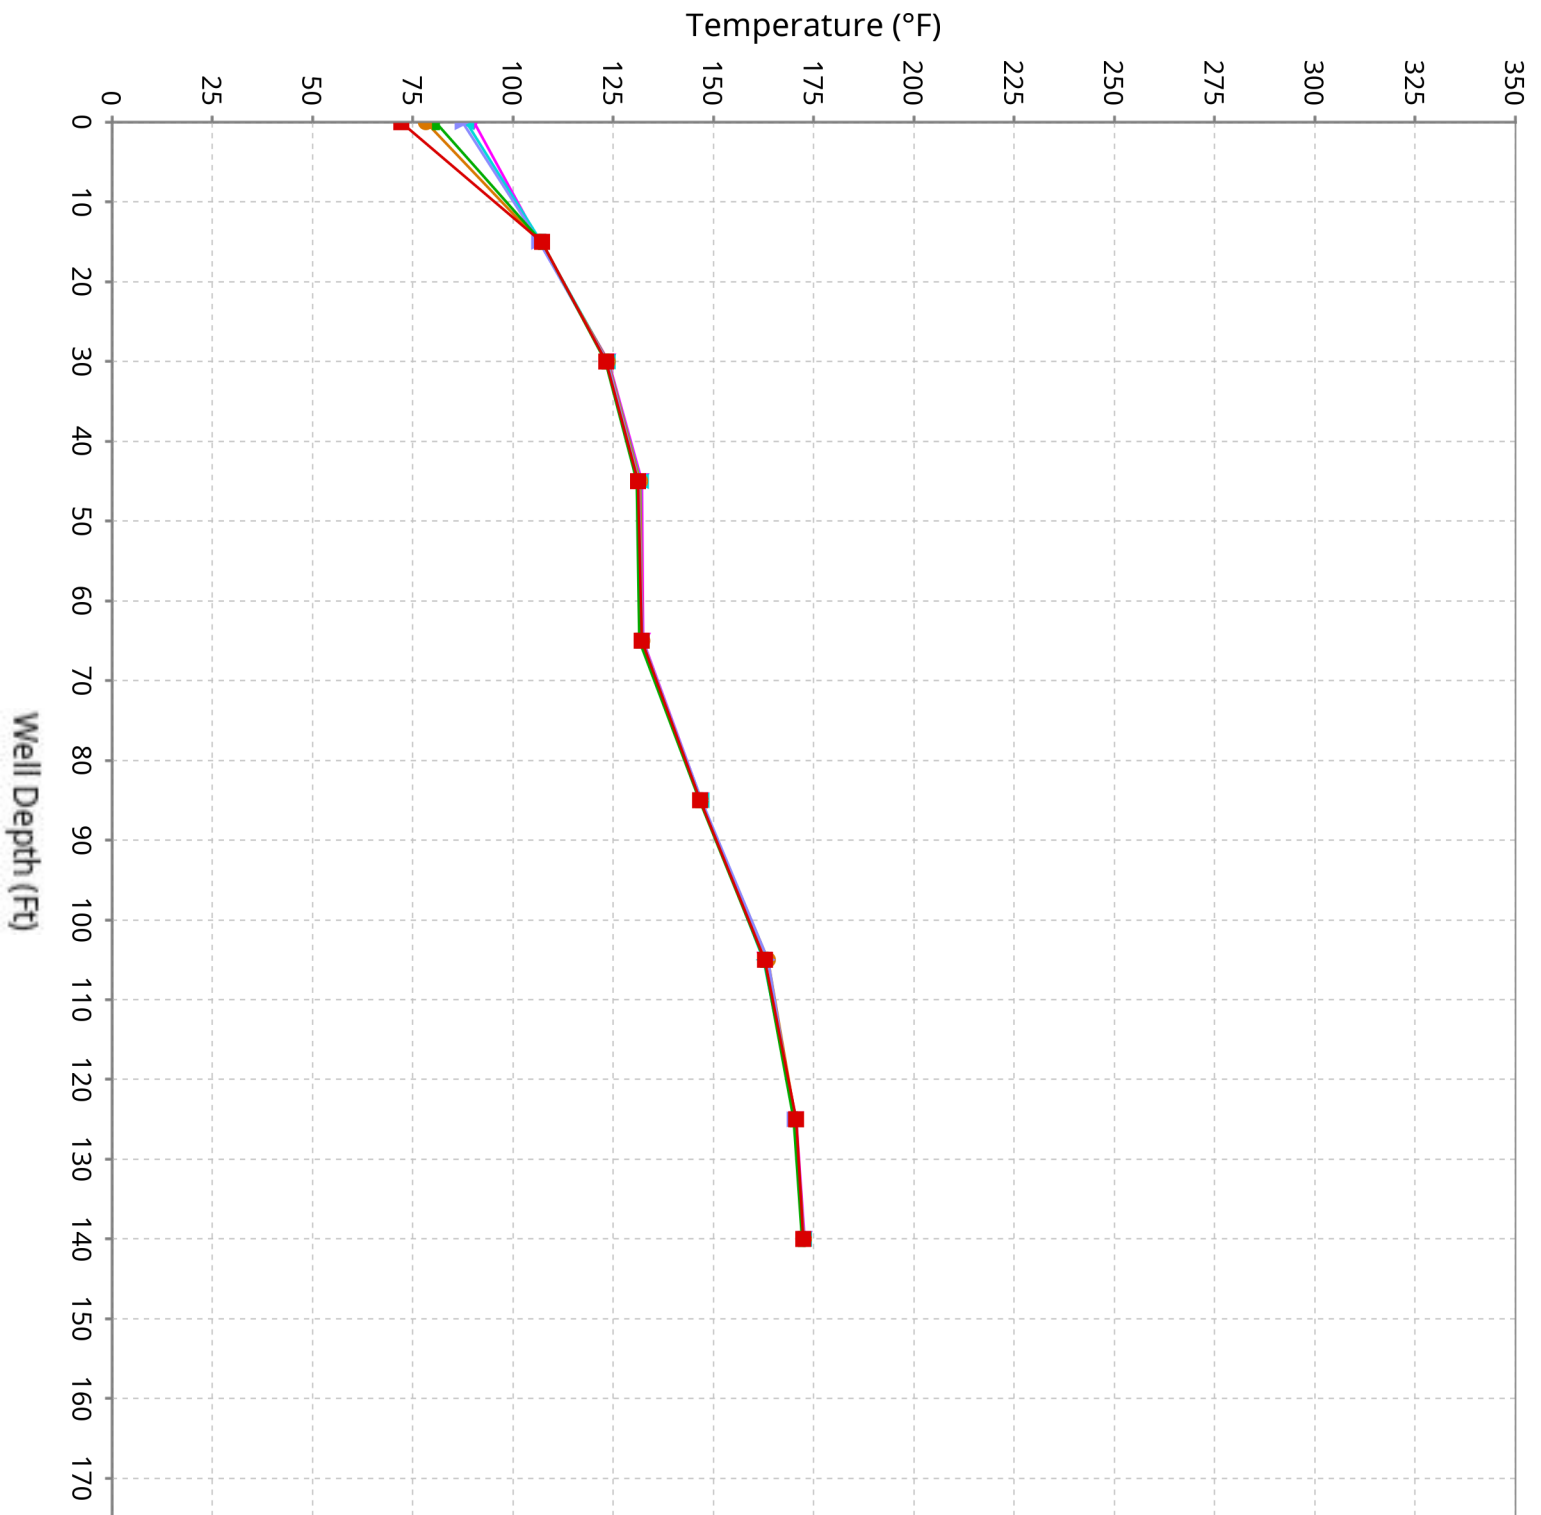


Vertical Temperature Profiles from Temperature Probes at Chiquita Landfill for TP-36

Maximum data for 1/1/2026 to 2/11/2026

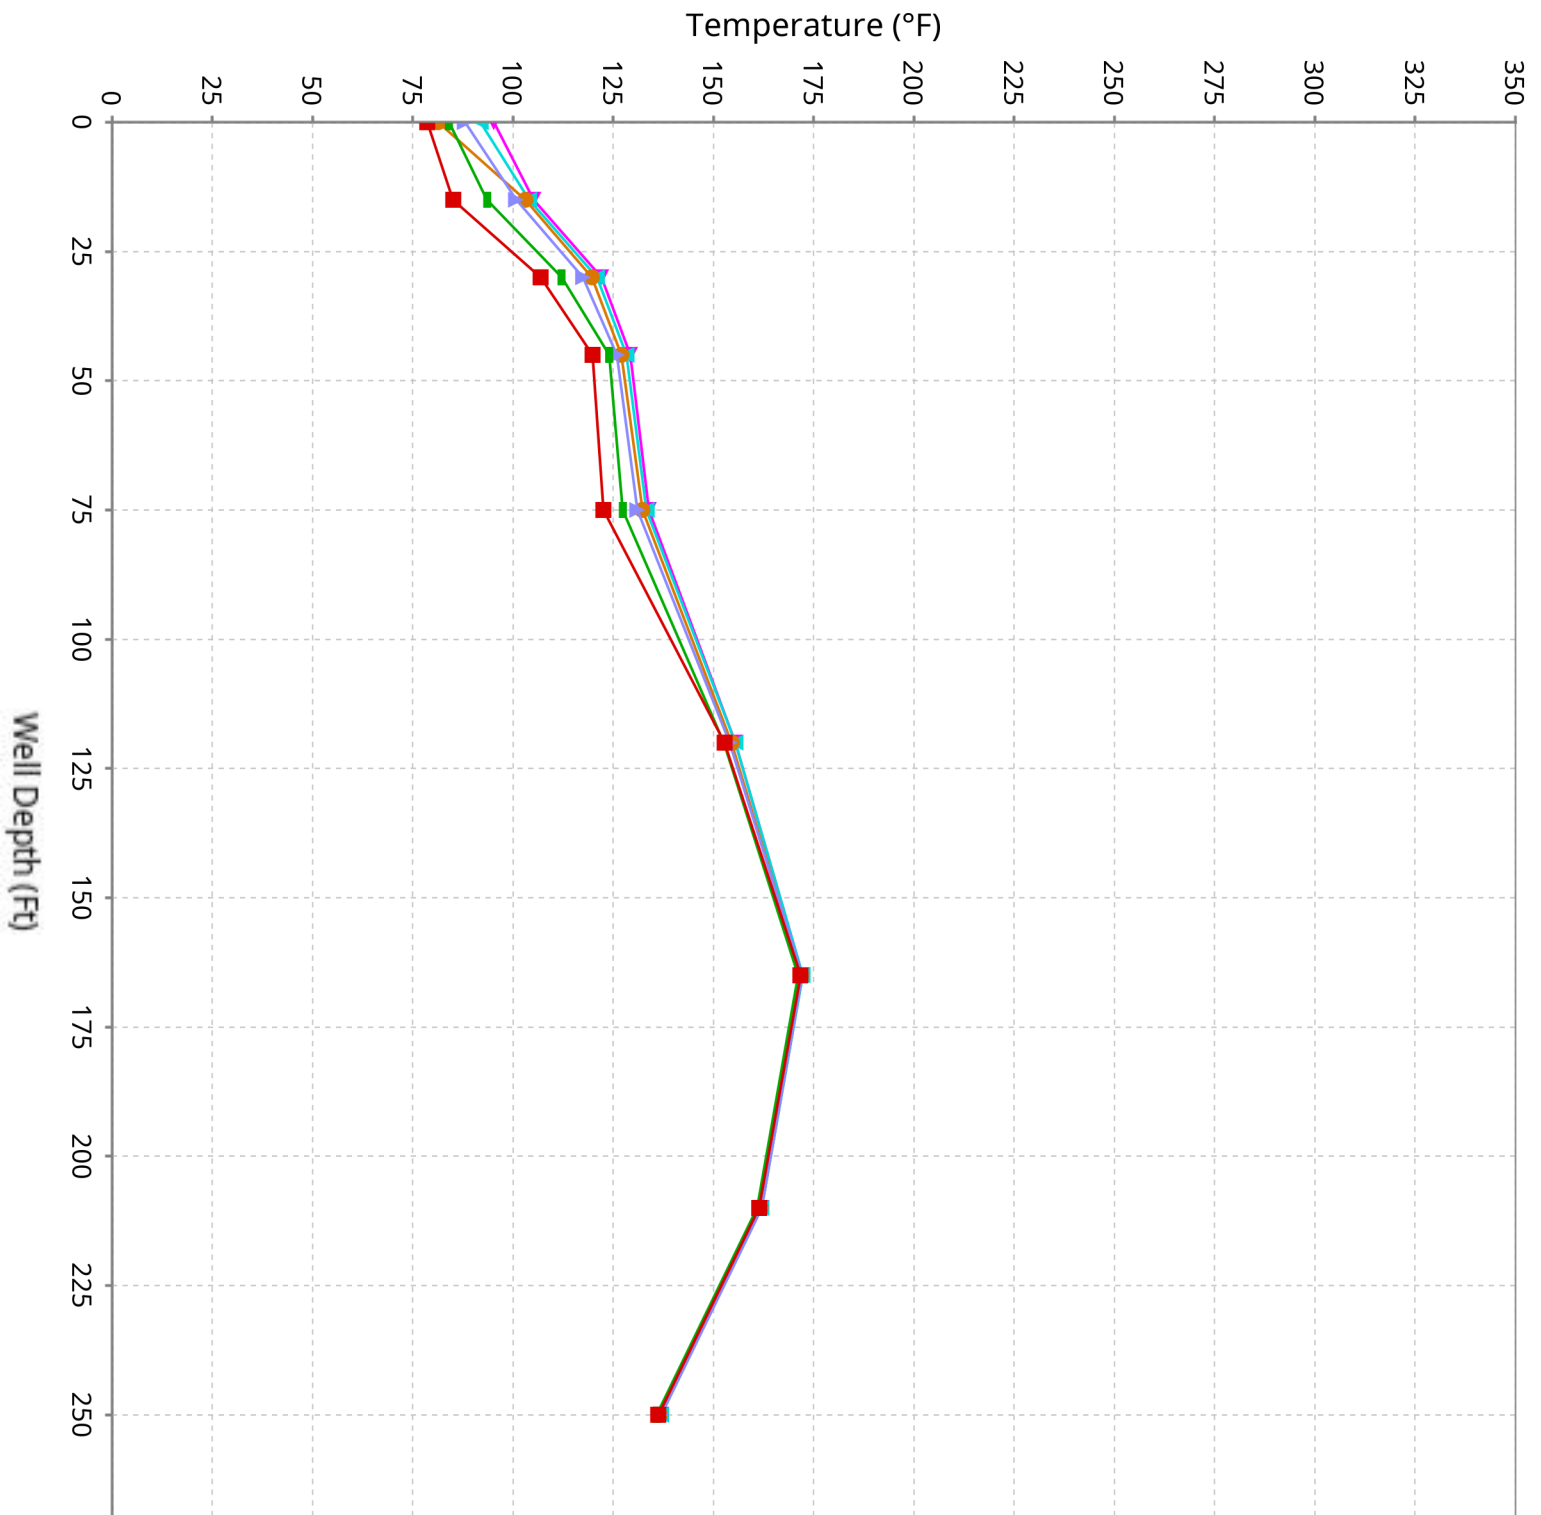


Vertical Temperature Profiles from Temperature Probes at Chiquita Landfill for TP-37

Maximum data for 1/1/2026 to 2/11/2026

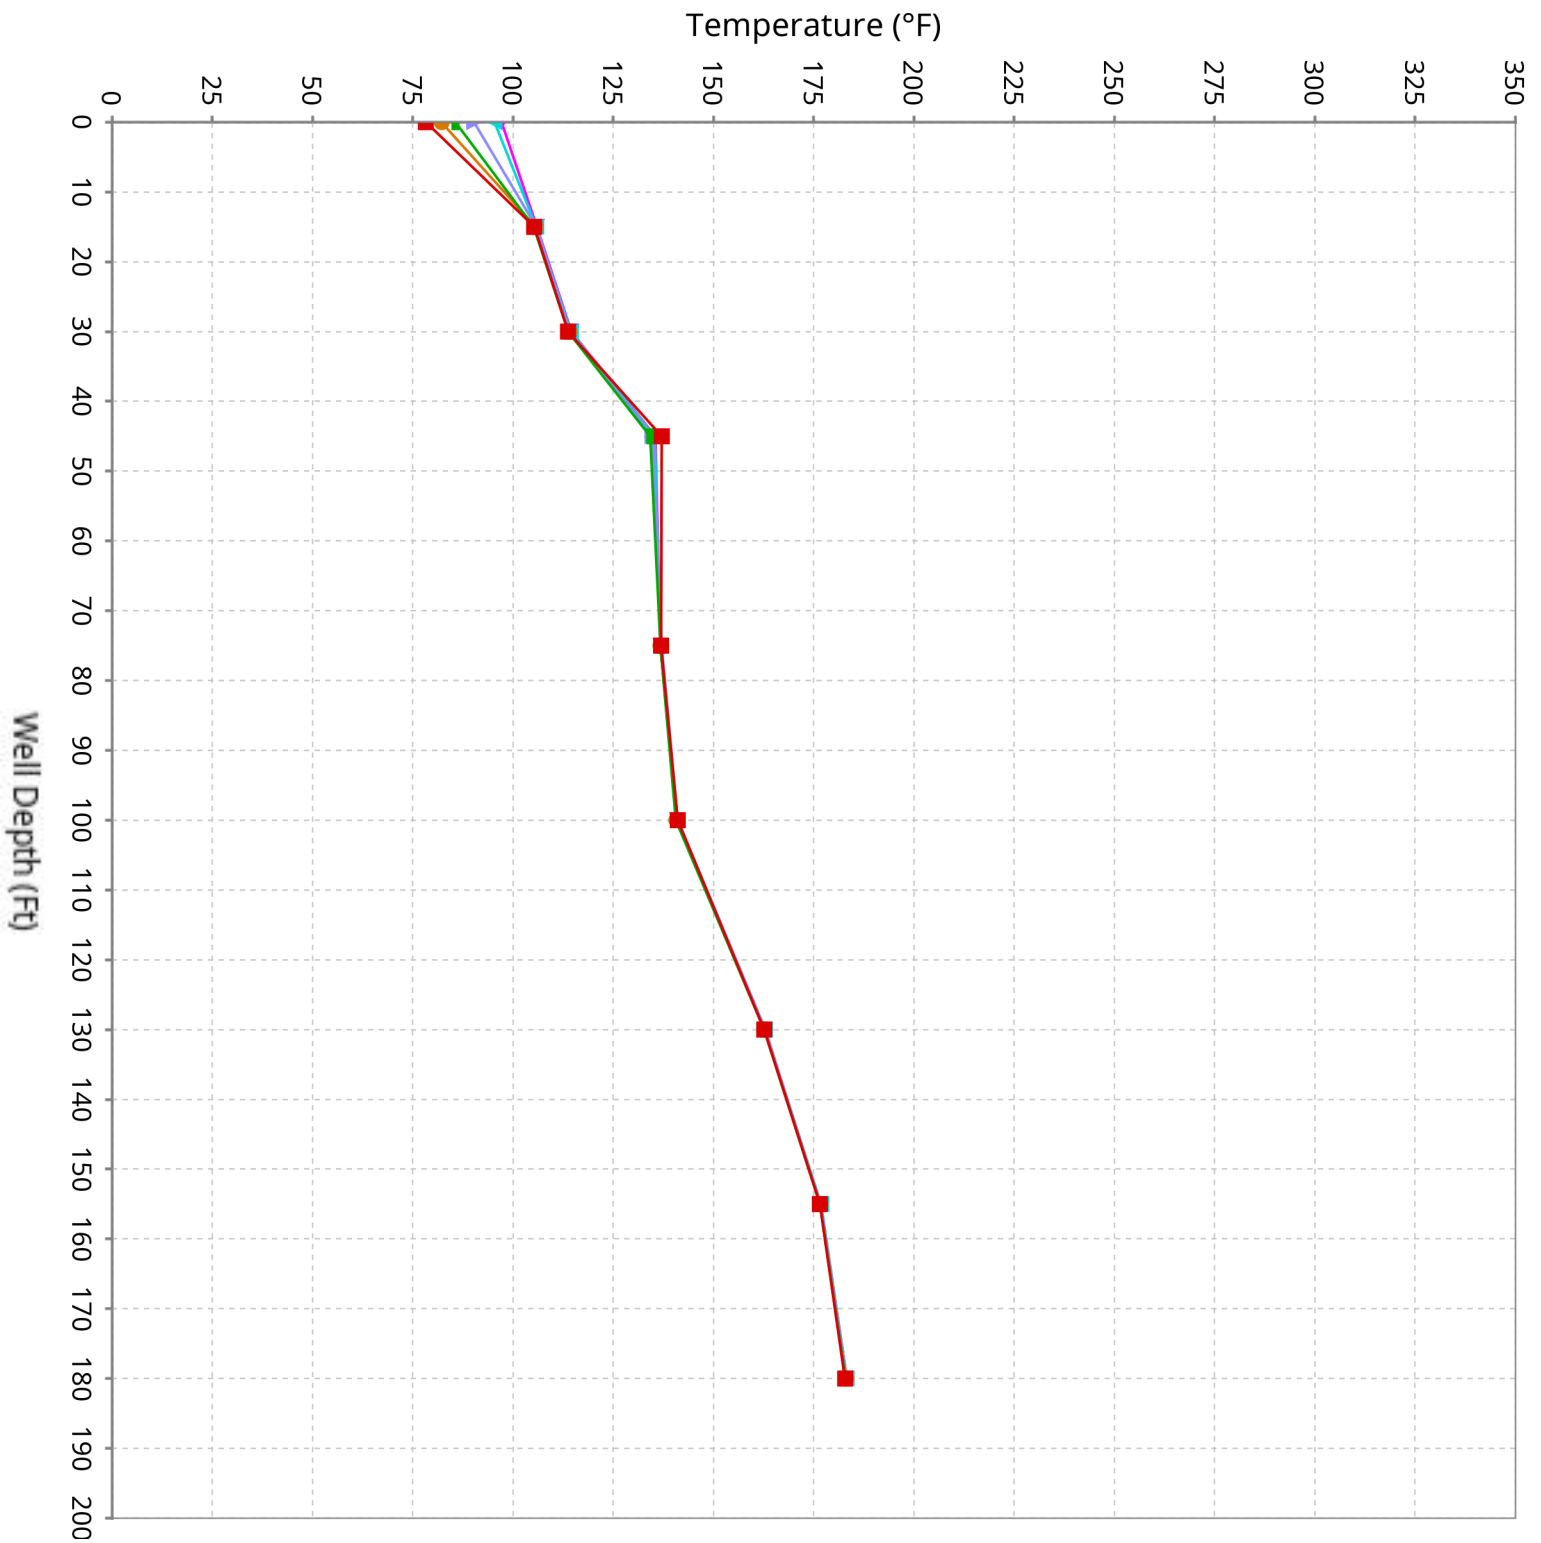


Vertical Temperature Profiles from Temperature Probes at Chiquita Landfill for TP-38

Maximum data for 1/1/2026 to 2/11/2026

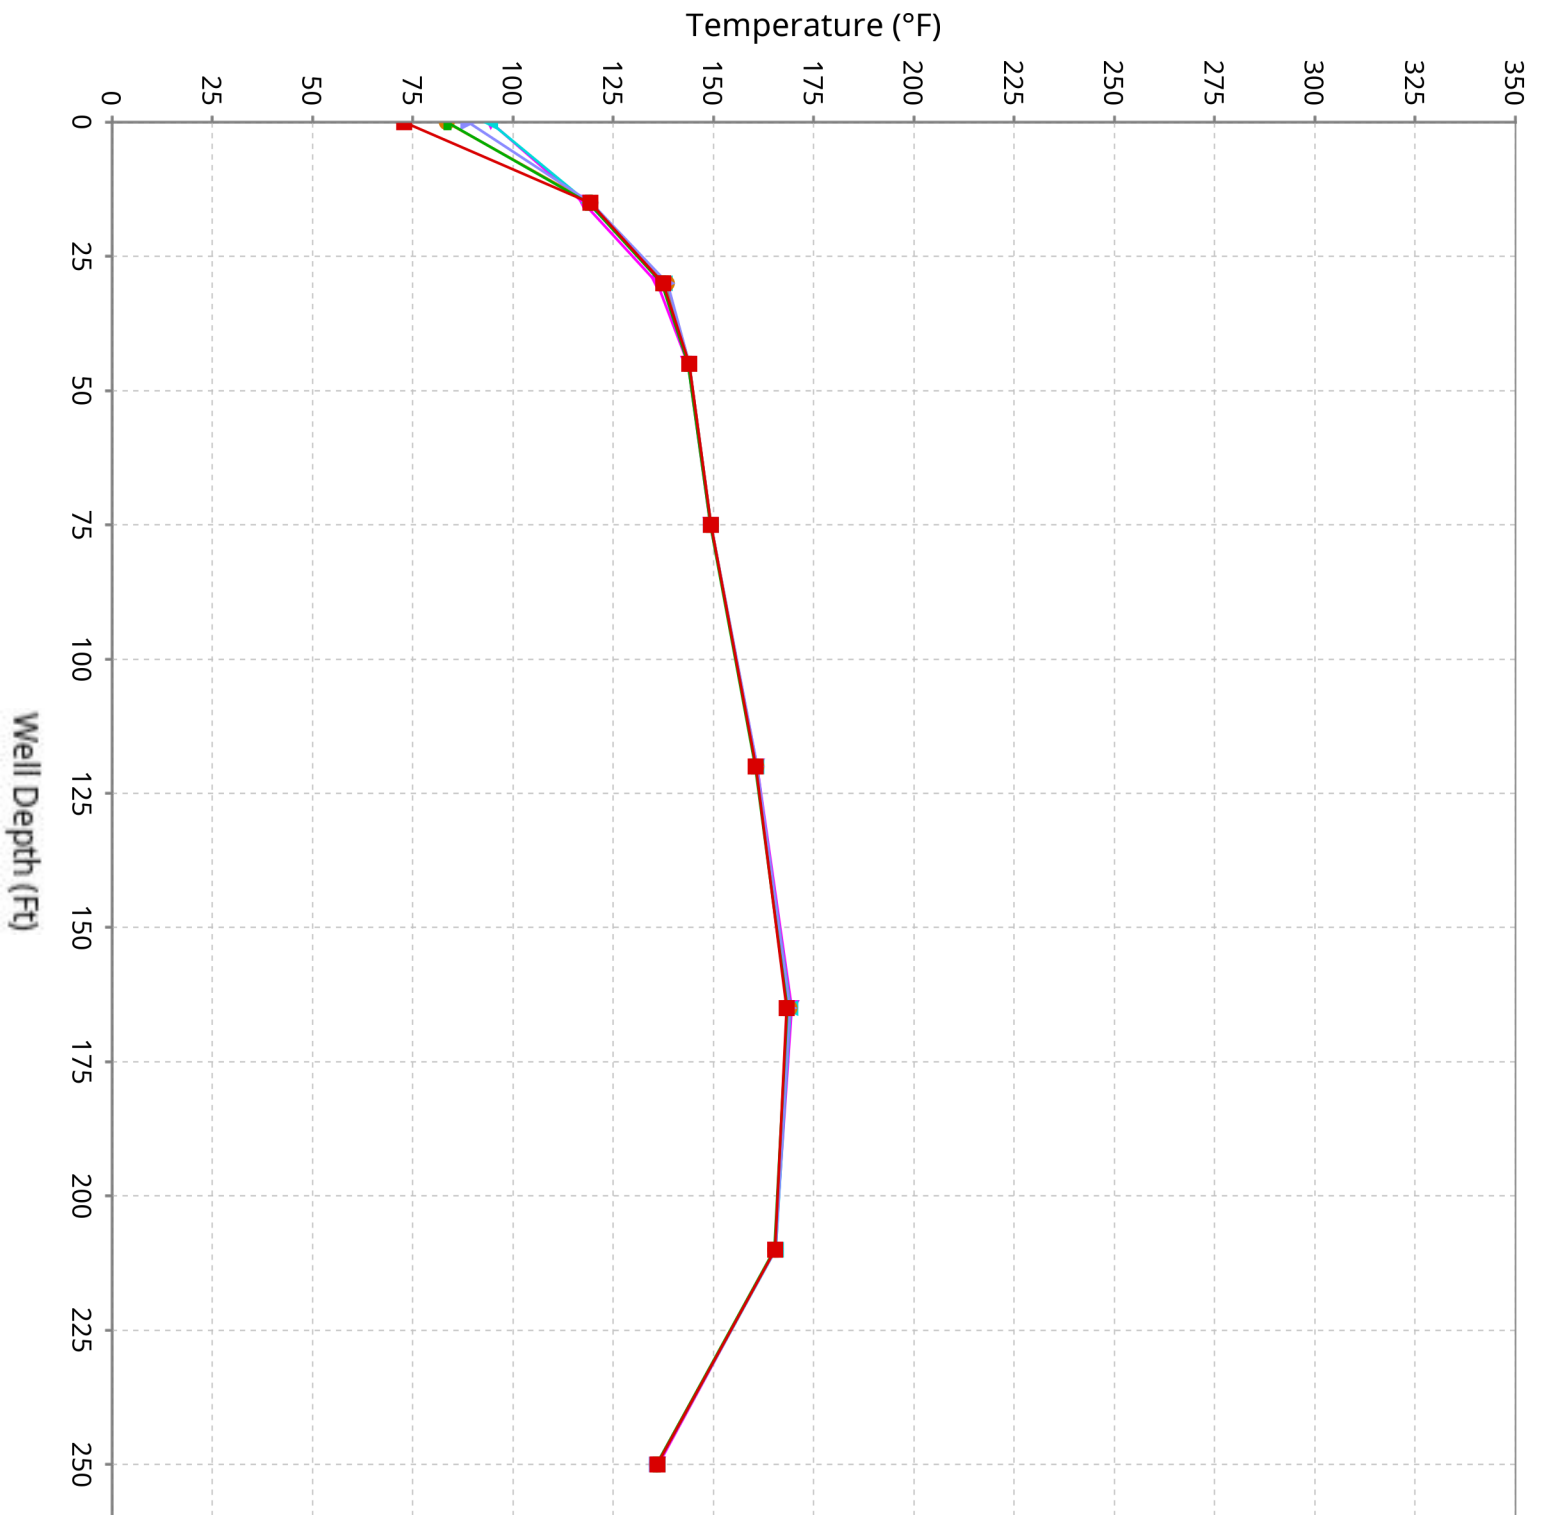


Vertical Temperature Profiles from Temperature Probes at Chiquita Landfill for TP-39


Maximum data for 1/1/2026 to 2/11/2026

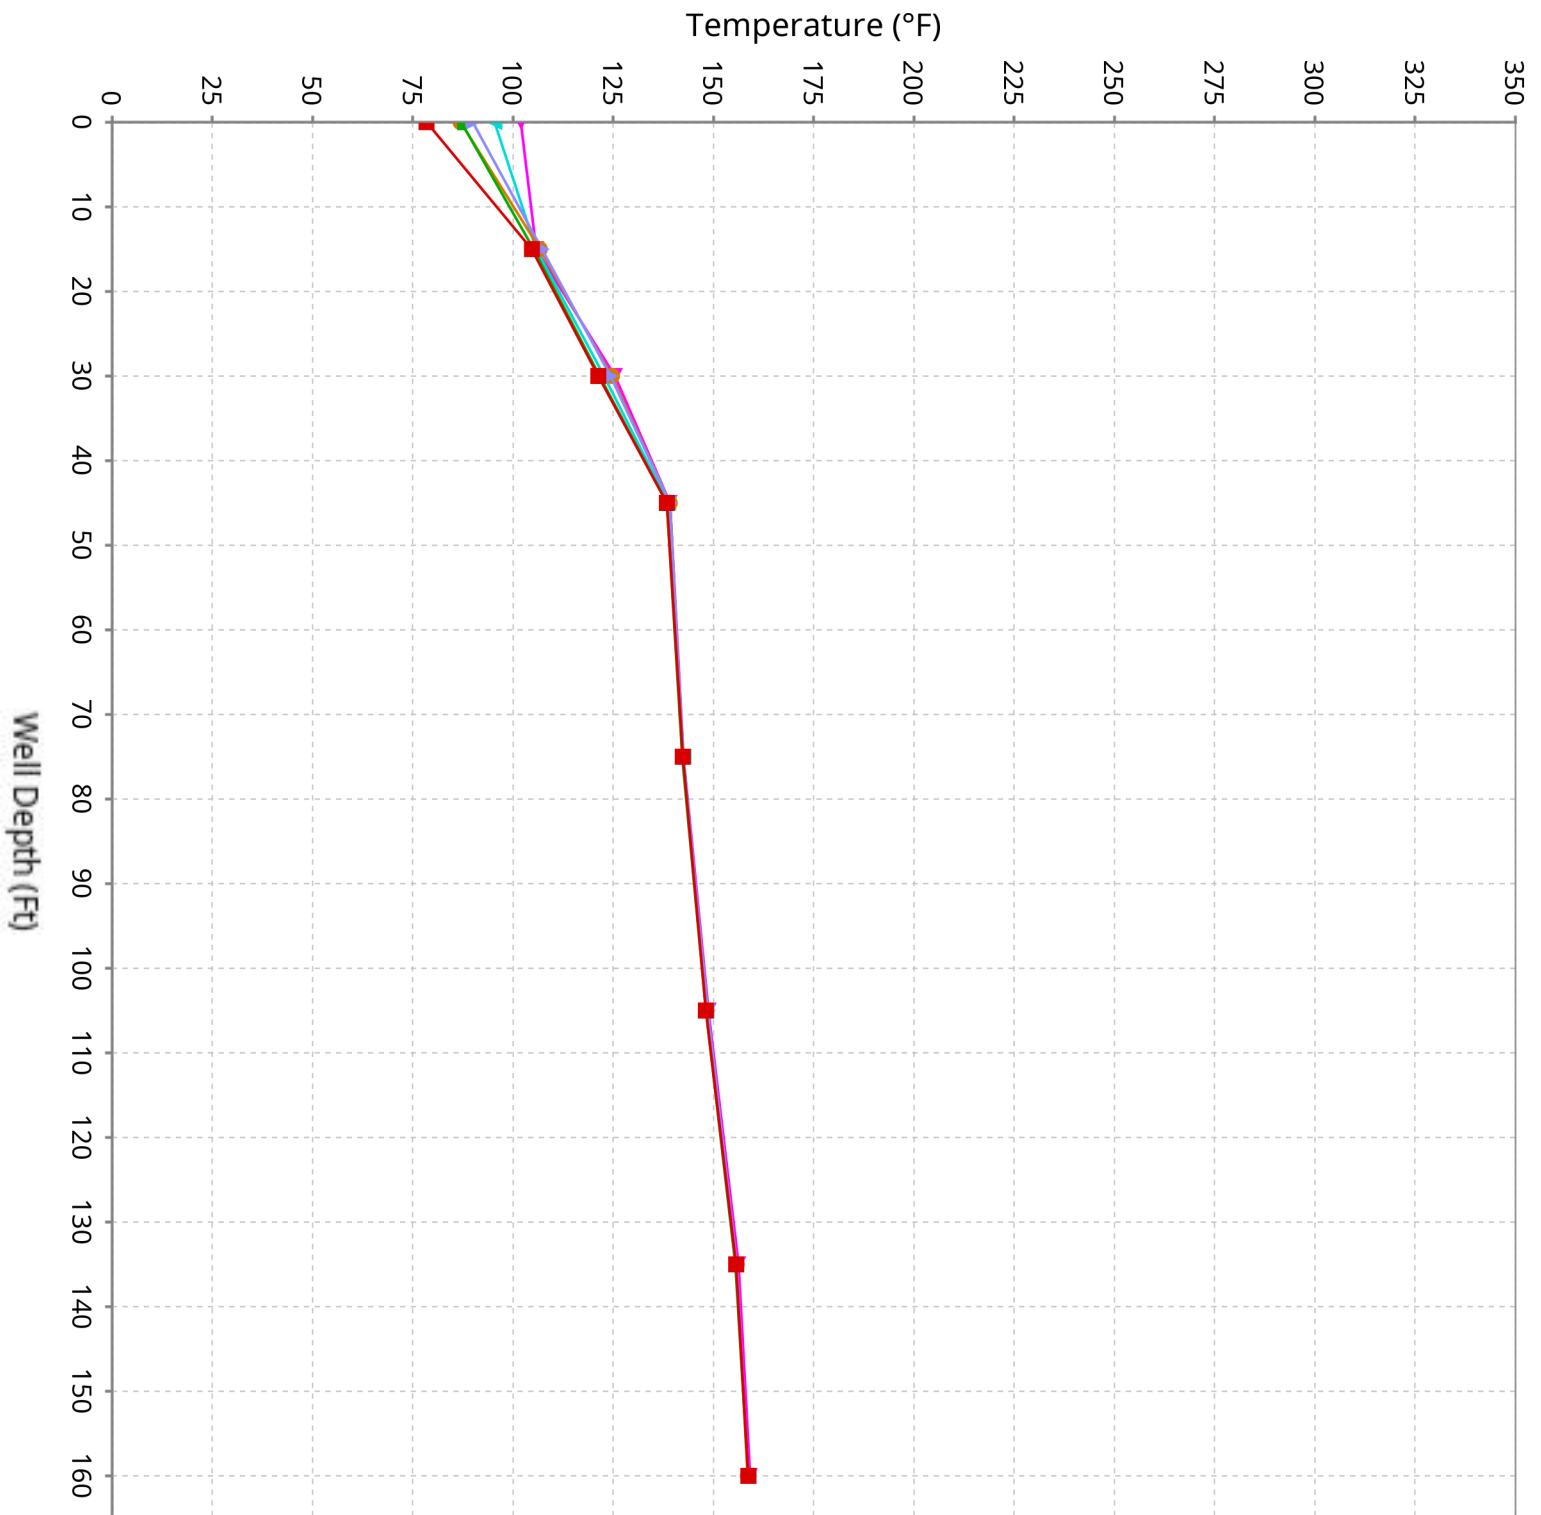

Vertical Temperature Profiles from Temperature Probes at Chiquita Landfill for TP-40

Maximum data for 1/1/2026 to 2/11/2026


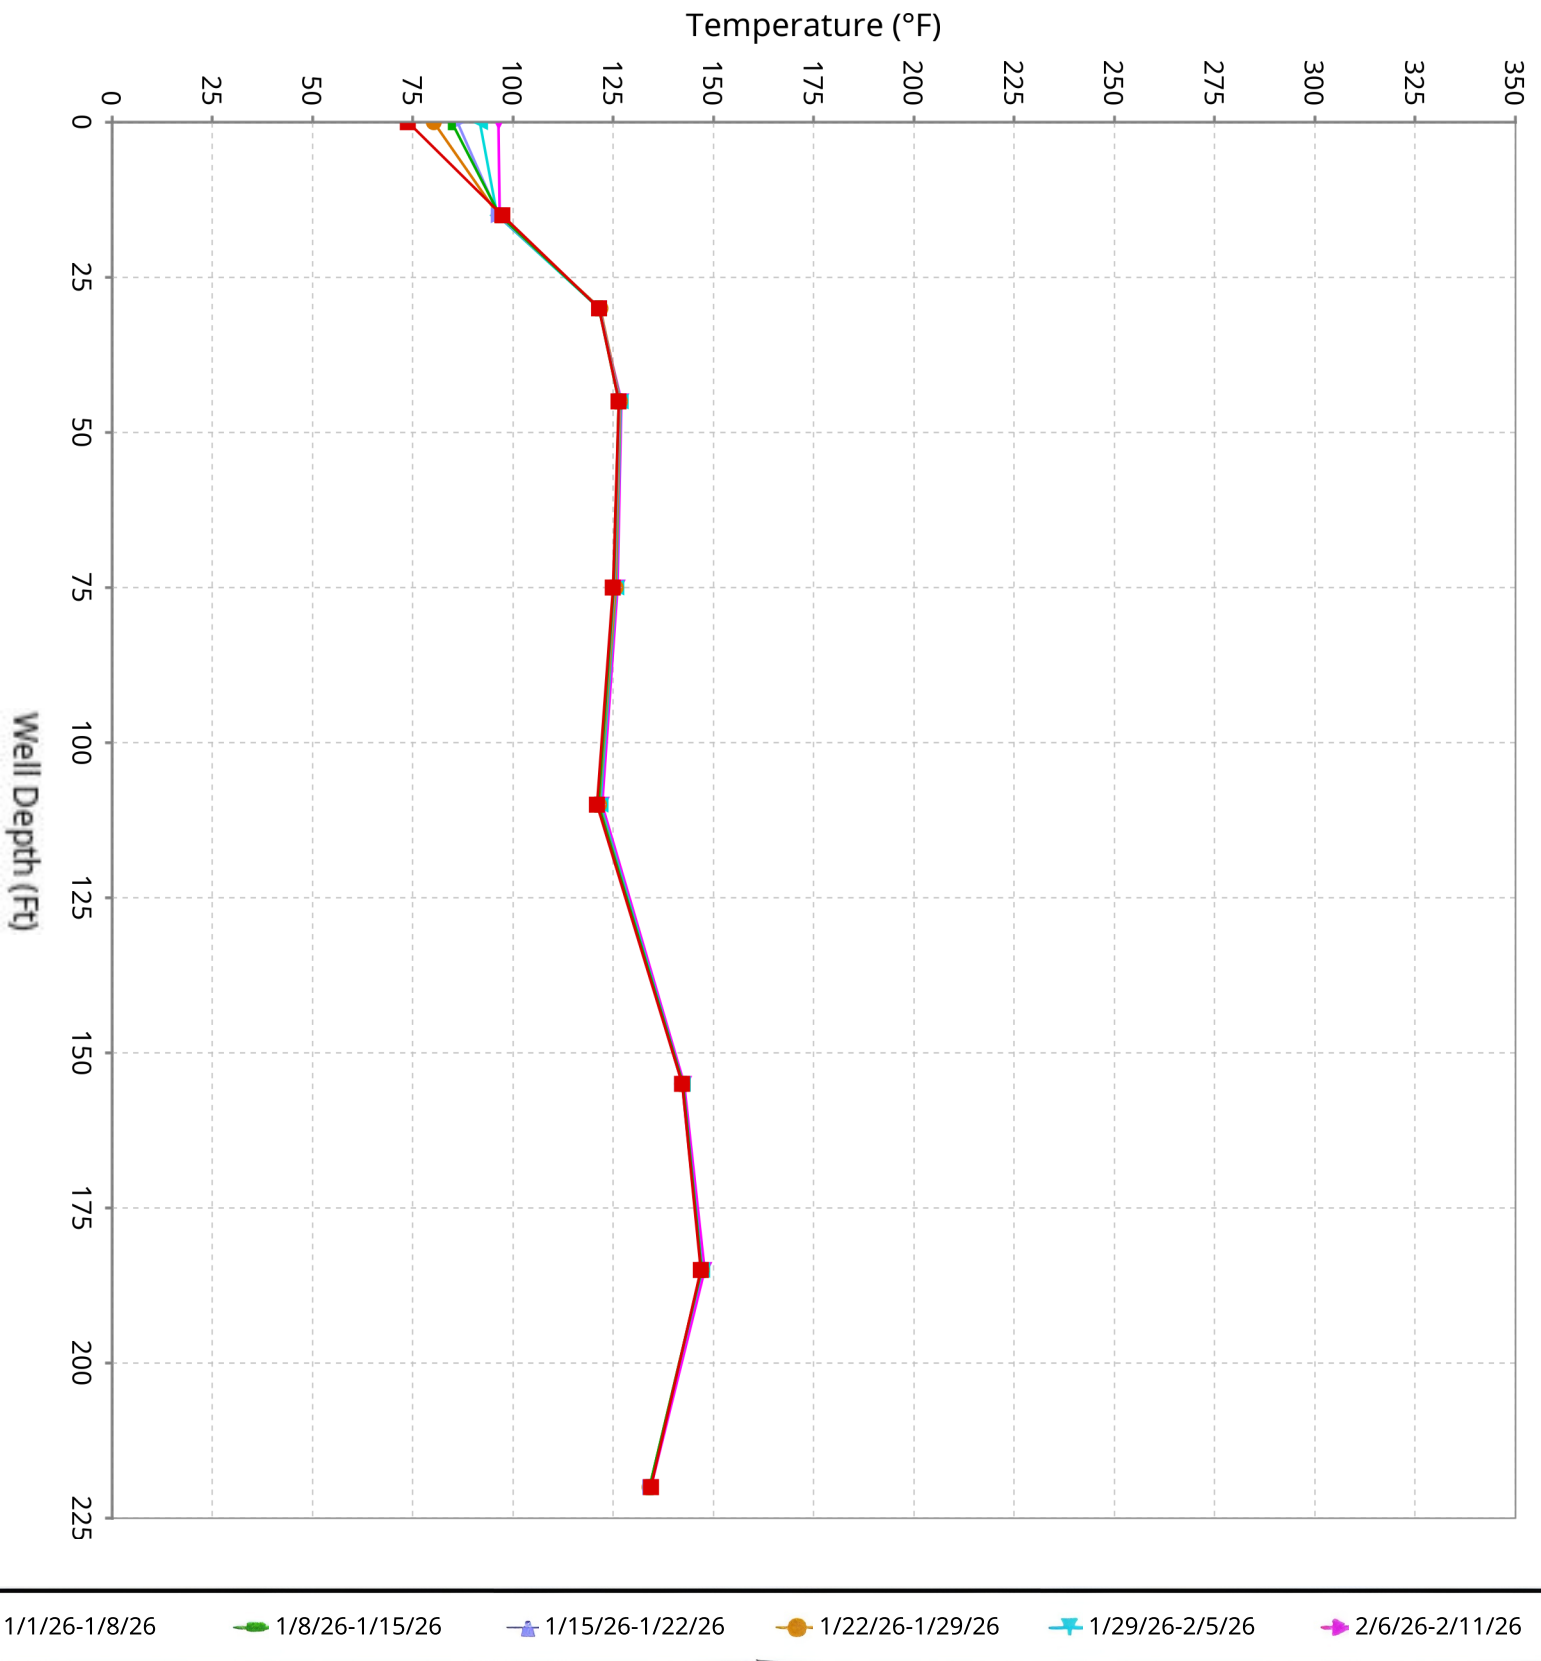




Appendix C
Temperature Monitoring Probe Site Map

1 2 3 4 5 6 7 8 9 10 11 12 13 14 15

A
B
C
D
E
F
G
H
I
J

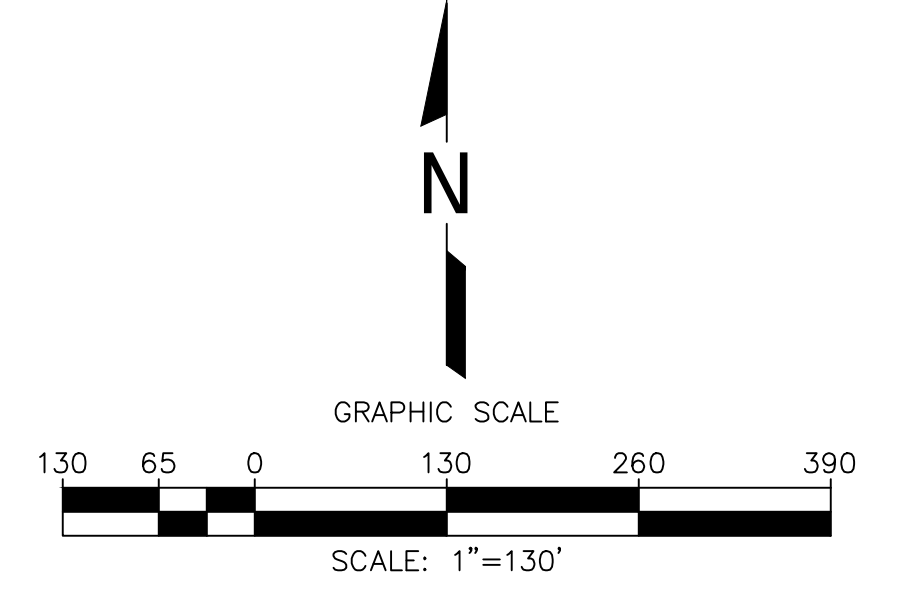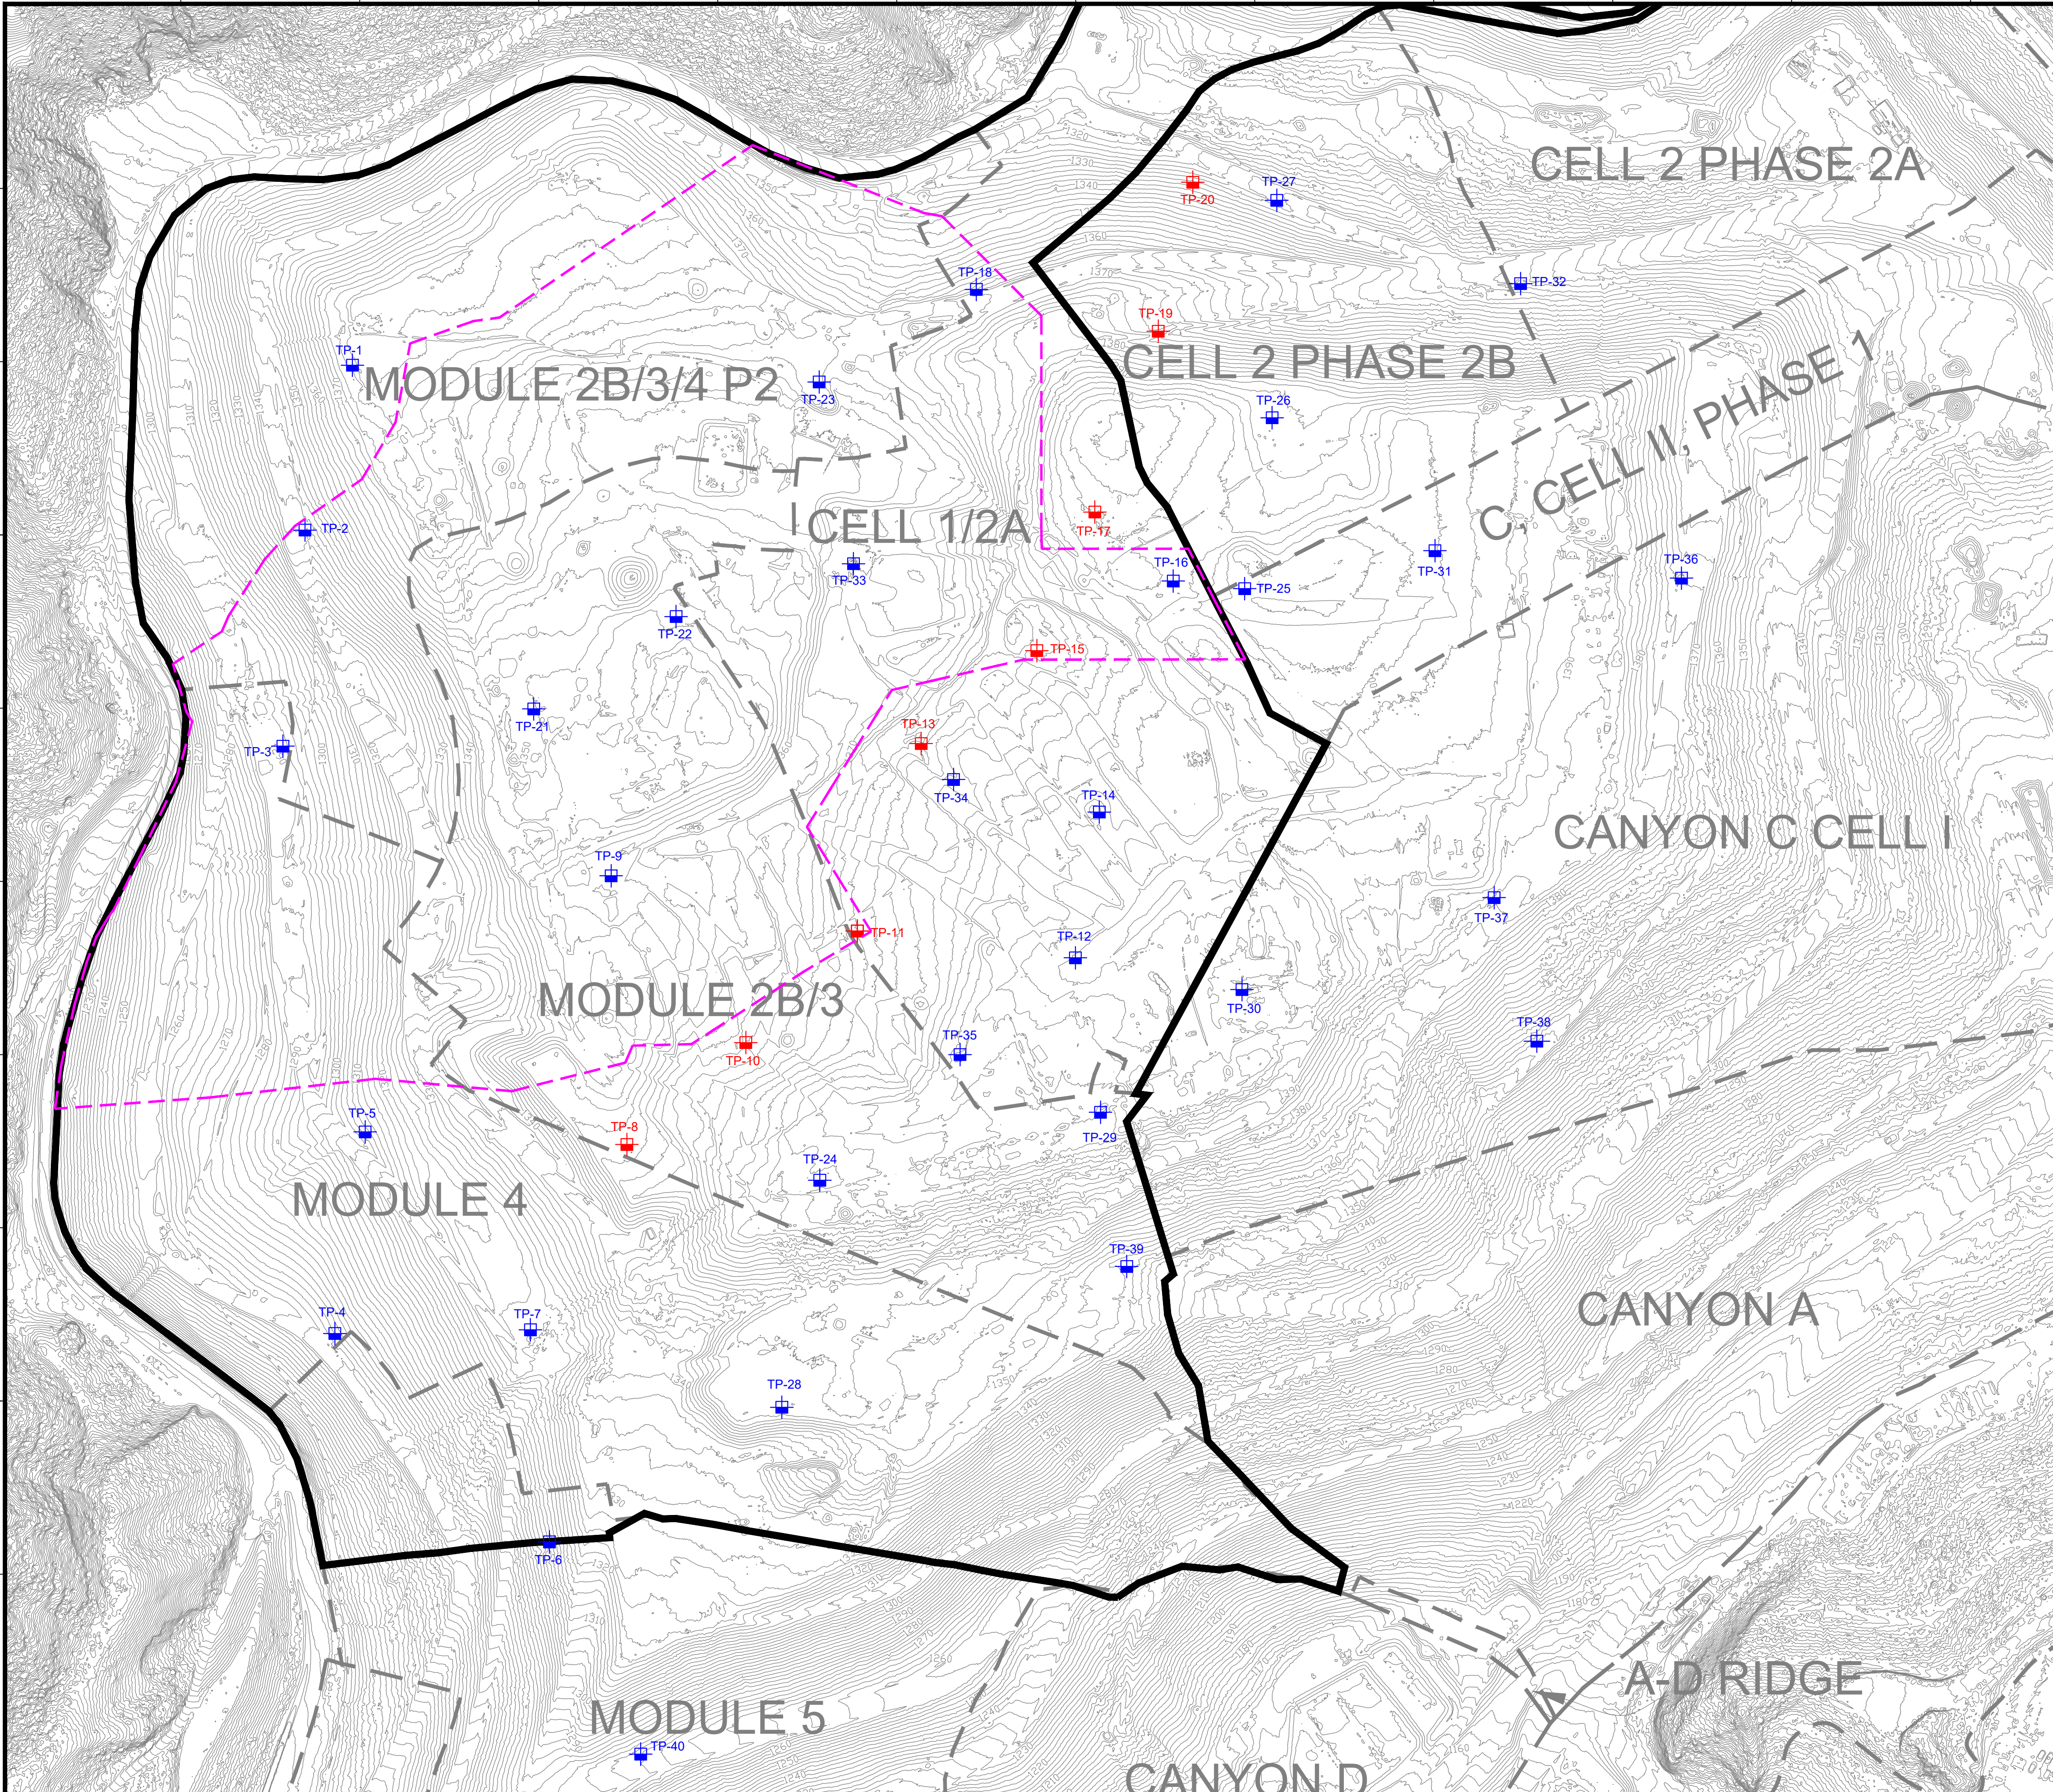

LEGEND

| | |
|--|---|
| | EXISTING TOPOGRAPHIC CONTOUR |
| | EXISTING CELL LIMITS (APPROXIMATE) |
| | INSTALLED TEMPERATURE PROBES - STANDALONE |
| | INSTALLED TEMPERATURE PROBES - INSTALLED WITHIN WELL CASING |
| | REACTION AREA BOUNDARY (APPROXIMATE) - BASED ON DATA REVIEW |
| | REACTION AREA BOUNDARY - CONDITION 9A |

| NO. | REVISION | DATE |
|-----|----------|------|
| | | |
| | | |
| | | |
| | | |

SHEET TITLE: EXISTING TEMPERATURE PROBE MAP
 PROJECT TITLE: CHIQUITA CANYON LANDFILL
 CASTAIC, CALIFORNIA



SCS ENGINEERS
 ENVIRONMENTAL CONSULTANTS
 3800 ALAMO, SUITE 300
 LONG BEACH, CA 90808
 PH: (562) 428-5544
 PROJ. NO: 012004123.41
 DSN. BY: _____
 APP. BY: _____
 F/ENGINEERS

DATE: 02/18/2026
 SCALE: AS SHOWN
 SHEET: 1

- GENERAL DRAWING NOTES:**
- EXISTING TOPOGRAPHIC SURVEY INFORMATION SHOWN WAS PROVIDED BY PROPELLER. AERIAL PHOTOGRAPHY DATED FEBRUARY 10, 2026.
 - NORTH ARROW SHOWN HERE IS REFERENCE TO THE CALIFORNIA STATE PLANE ZONE V COORDINATE SYSTEM, NAD 83.