


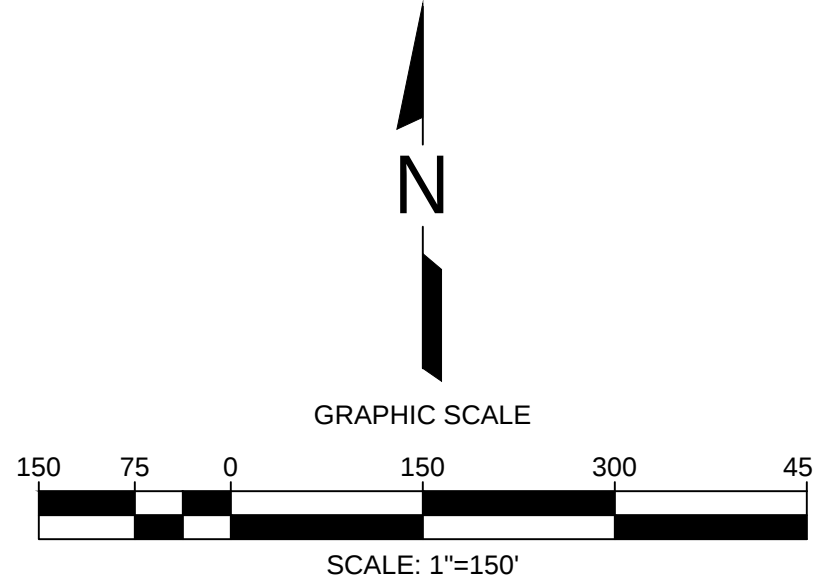

- | LEGEND | |
|---|--|
| — 1550 | TOPOGRAPHIC CONTOUR |
| ---- | REACTION MITIGATION AREA BOUNDARY |
| - - - - - | WESTERN BUTRESS FILL LIMITS |
| ---- | EXISTING CELL LIMITS (APPROXIMATE) |
| — 36" | EXISTING 36" LFG COLLECTION HEADER PIPING |
| — 30" | EXISTING 30" LFG COLLECTION HEADER PIPING |
| — 24" | EXISTING 24" LFG COLLECTION HEADER PIPING |
| — 20" | EXISTING 20" LFG COLLECTION HEADER PIPING |
| — 18" | EXISTING 18" LFG COLLECTION HEADER PIPING |
| — 12" | EXISTING 12" LFG COLLECTION HEADER PIPING |
| — 10" | EXISTING 10" LFG COLLECTION HEADER PIPING |
| — 8" | EXISTING 8" LFG COLLECTION LATERAL PIPING |
| — 4-6" | EXISTING 4" 6" LFG COLLECTION LATERAL PIPING |
| - - - - - | BELOW-GRADE PIPES ARE SHOWN DASHED |
|  | EXISTING FRAC TANKS |
|  | EXISTING ACTIVATED CARBON VESSEL |
|  | EXISTING CONDENSATE SUMP |
|  | EXISTING CORRUGATED LINER RISER |
|  | EXISTING HDPE LINER RISER |
|  | EXISTING LFG VERTICAL EXTRACTION WELL - MAIN CANYON, CANYON A, B, D, PRIMARY |
|  | EXISTING LFG VERTICAL EXTRACTION WELL - PRESSURIZED LEACHATE RELEASE |
|  | EXISTING GABION LFG COLLECTOR WELL |
|  | EXISTING SOIL VAPOR EXTRACTION WELL |
|  | EXISTING SURFACE COLLECTOR WELL/HEAD |
|  | EXISTING HORIZONTAL, TRENCH, SLOPE, COLLECTOR WELL |
|  | EXISTING REMOTE VERTICAL WELL/HEAD |
|  | EXISTING PERIMETER MIGRATION PROBE |
|  | EXISTING TEMPERATURE PROBE |
|  | EXISTING ISOLATION VALVE |
|  | EXISTING BLIND FLANGE |

GENERAL DRAWING NOTES:

1. EXISTING GGCS AS-BUILT DATED JULY 28, 2026.
2. EXISTING AERIAL PHOTOGRAPHY REFERENCED AND TOPOGRAPHIC SURVEY INFORMATION SHOWN WAS PROVIDED BY PROPELLOR, DATED JULY 22, 2026.
3. NORTH ARROW SHOWN HERE IS REFERENCE TO THE CALIFORNIA STATE PLANE ZONE V COORDINATE SYSTEM, NAD 83.
4. THE LOCATION OF ANY EXISTING PIPING, VALVES, TIE-IN LOCATIONS AND OTHER FEATURES ARE APPROXIMATE AND SHOULD BE USED FOR INFORMATION PURPOSES ONLY. ACTUAL FIELD CONDITIONS MAY VARY AND SUBJECT TO CHANGE BASED ON TOPOGRAPHIC FEATURES AND OTHER SITE-SPECIFIC FACTORS.