

From: Medina, Steven <SMedina@scsengineers.com>
Sent: Friday, August 7, 2026 4:03 PM
To: Baitong Chen; Christina Ojeda; Nathaniel Dickel
Cc: Huber, Rachelle; Chris Fear; Viswanathan, Srividhya; Mark.Adams; Dylan Smith; Sarah Phillips; Bill Haley
Subject: No. 6177-4 Stipulated Order for Abatement - Weekly Pump Installation and Operation Update
Attachments: 2026-08-07_CCLF_Existing De-Watering Well with Pump Map.pdf

[EXTERNAL SENDER: Use caution with links/attachments]

All,

In accordance with Condition 65 of the Modified Stipulated Order, below is the summary of the installation and operation of dewatering pumps for the Chiquita Canyon Landfill. This information is subject to change based on further review and verification.

During 07/31/2026 to 08/06/2026, Chiquita completed the installation of, and began operating during the day, five (5) new pumps in a vertical LFG extraction well for a total of one hundred eighty-seven (187) pumps operating in vertical LFG extraction wells. Additionally, twelve (12) pumps were taken offline last week, and five (5) new pumps became operational, leading to a net decrease of seven (7) pumps. Please note that Chiquita has additional pumps in operation in perimeter sumps that are not included in this count.

During 08/07/2026 to 08/13/2026, given the number of dewatering pumps installed to date, and the maintenance associated with those pumps, Chiquita plans to install and begin operating three (3) additional pumps in vertical LFG extraction wells in locations along the north and south slope of the reaction area.

Regards,



STEVEN Medina, E.I.T.

Project Professional

smedina@scsengineers.com

O: 858-583-7746

M: 858-204-4342

3900 Kilroy Airport Way, Suite #300


Long Beach, CA 90806



GENERAL DRAWING NOTES:

- NORTH ARROW SHOWN HERE IS REFERENCE TO THE CALIFORNIA STATE PLANE ZONE V COORDINATE SYSTEM, NAD 83.
- EXISTING TOPOGRAPHIC SURVEY INFORMATION WAS PROVIDED BY PROPELLOR. AERIAL PHOTOGRAPHY DATED JULY 29, 2026.
- EXISTING GCCS AS-BUILT INFORMATION IS DATED AUGUST 6, 2026.
- THE LOCATION OF ANY EXISTING GCCS COMPONENTS AND OTHER FEATURES ARE APPROXIMATE AND SHOULD BE USED FOR INFORMATION PURPOSES ONLY.

De-Watering Well Pumps Currently Installed but NOT Running		
#	Well I.D.	Well I.D.
1	CV-2337	CV-2431
2	CV-2339	CV-2431
3	CV-2341	CV-2431
4	CV-2349	CV-2431
5	CV-2352	CV-2431
6	CV-2453	CV-2431
7	CV-2454	CV-2431
8	CV-2456	CV-2431
9	CV-2466	CV-2431
10	CV-2478	CV-2431
11	CV-2498	CV-2431
12	CV-2540	CV-2431
13	CV-2543-PLR	CV-2431
14	CV-2556-PLR	CV-2431
15	CV-2590	CV-2431
16	CV-24101	CV-2431
17	CV-24127	CV-2431
18	CV-24162	CV-2431
19	CV-24223	CV-2431

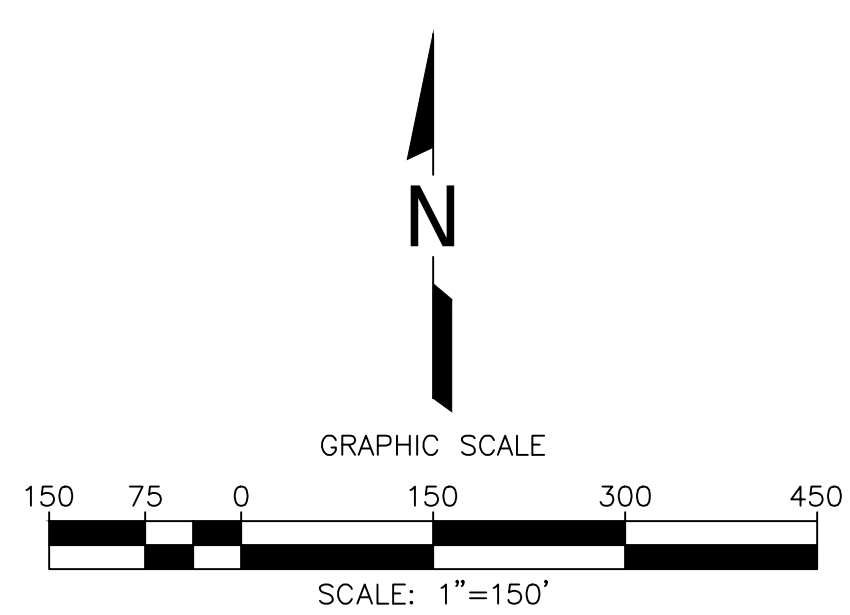

De-Watering Well Pumps Currently Running					
#	Well I.D.	Install Date	#	Well I.D.	Install Date
1	CV-2337	4/22/2024	95	CV-2431	9/18/2025
2	CV-2302	4/26/2024	96	CV-2425	9/22/2025
3	CV-2328	4/26/2024	97	CV-2530	10/3/2025
4	CV-2336	4/30/2024	98	CV-2533	10/17/2025
5	CV-24142	5/3/2024	99	CV-2529	10/18/2025
6	CV-24144	5/13/2024	100	CV-2433	10/28/2025
7	CV-2496	5/30/2024	101	CV-2010A	11/24/2025
8	CV-2497	5/30/2024	102	CV-2011A	11/24/2025
9	CV-2411	6/24/2024	103	CV-24156	12/17/2025
10	CV-2416	6/24/2024	104	CV-2551	12/30/2025
11	CV-24109	7/3/2024	105	CV-2557	1/5/2026
12	CV-24100	7/17/2024	106	CV-1902A	1/16/2026
13	CV-2348	7/22/2024	107	CV-24138	1/23/2026
14	CV-2345	7/27/2024	108	CV-2455	2/28/2026
15	CV-2344	7/30/2024	109	CV-2495	2/28/2026
16	CV-2417	8/13/2024	110	CV-24167	3/4/2026
17	CV-2418	8/14/2024	111	CV-24185	3/19/2026
18	CV-2427	8/15/2024	112	CV-24201	3/26/2026
19	CV-24124	8/24/2024	113	CV-24178	3/30/2026
20	CV-2423	8/26/2024	114	CV-2430	3/31/2026
21	CV-2409	8/30/2024	115	CV-2555	4/1/2026
22	CV-2481	9/4/2024	116	CV-24226	4/2/2026
23	CV-24108	9/4/2024	117	CV-24176	4/3/2026
24	CV-24120	9/10/2024	118	CV-2422-PLR	4/6/2026
25	CV-2437	11/26/2024	119	CV-2321	4/10/2026
26	CV-2451	12/23/2024	120	CV-2446	4/11/2026
27	CV-2470	12/24/2024	121	CV-2457	4/11/2026
28	CV-2445	1/6/2025	122	CV-2458	4/11/2026
29	CV-2432	1/7/2025	123	CV-2424-PLR	4/13/2026
30	CV-24212	1/10/2025	124	CV-2305	4/15/2026
31	CV-2462	1/14/2025	125	CV-24172	4/16/2026
32	CV-2463	1/15/2025	126	CV-2415	4/22/2026
33	CV-2001	1/23/2025	127	CV-2531	4/29/2026
34	CV-2479	1/28/2025	128	CV-24180	5/29/2026
35	CV-2483	1/29/2025	129	CV-2443	6/1/2026
36	CV-2338	2/8/2025	130	CV-2472	6/1/2026
37	CV-24202	2/20/2025	131	CV-24157	6/1/2026
38	CV-24209	2/28/2025	132	CV-24170	6/2/2026
39	CV-24197	3/11/2025	133	CV-2459	6/2/2026
40	CV-24165	4/7/2025	134	CV-2460	6/2/2026
41	CV-24166	4/7/2025	135	CV-2461	6/2/2026
42	CV-24168	4/7/2025	136	CV-2469	6/2/2026
43	CV-24171	4/7/2025	137	CV-2471	6/3/2026
44	CV-24134	4/9/2025	138	CV-2326	6/3/2026
45	CV-24135	4/11/2025	139	CV-2473	6/3/2026
46	CV-24173	4/15/2025	140	CV-2484	6/3/2026
47	CV-24174	4/15/2025	141	CV-2491	6/3/2026
48	CV-24175	4/15/2025	142	CV-24136	6/3/2026
49	CV-24159	4/16/2025	143	CV-24158	6/3/2026
50	CV-24154	4/17/2025	144	CV-24164	6/3/2026
51	CV-2465	4/25/2025	145	CV-2303	6/5/2026
52	CV-2208A	5/2/2025	146	CV-24148	6/5/2026
53	CV-24214	5/2/2025	147	CV-24152	6/5/2026
54	CV-2354	5/6/2025	148	CV-24163	6/5/2026
55	CV-2493	5/6/2025	149	CV-24165	6/5/2026
56	CV-24160	5/6/2025	150	CV-24215	6/5/2026
57	CV-2492	5/7/2025	151	CV-2467	6/5/2026
58	CV-2205	5/8/2025	152	CV-2553	6/7/2026
59	CV-24161	5/8/2025	153	CV-2426	6/9/2026
60	CV-24224	5/12/2025	154	CV-2434	6/9/2026
61	CV-24118	5/14/2025	155	CV-24120	6/9/2026
62	CV-24119	5/14/2025	156	CV-24128	6/9/2026
63	CV-24107	5/15/2025	157	CV-2333	6/10/2026
64	CV-24211	5/15/2025	158	CV-2406	6/10/2026
65	CV-24137	5/15/2025	159	CV-2477	6/10/2026
66	CV-24208	5/16/2025	160	CV-24125	6/10/2025
67	CV-24116	5/20/2025	161	CV-2334	6/11/2026
68	CV-24204	5/20/2025	162	CV-2343-PLR	6/15/2026
69	CV-24205	5/20/2025	163	CV-2474	6/16/2026
70	CV-2490	6/5/2025	164	CV-2316	6/17/2026
71	CV-24203	6/5/2025	165	CV-2482	6/18/2026
72	CV-24207	6/9/2025	166	CV-2544	6/18/2026
73	CV-24225	6/9/2025	167	CV-2546	6/18/2026
74	CV-24186	6/10/2025	168	CV-2545	6/19/2026
75	CV-24222	6/10/2025	169	CV-24177	6/22/2026
76	CV-24163	6/11/2025	170	CV-2548	6/25/2026
77	CV-2439	6/12/2025	171	CV-24126	7/1/2026
78	CV-2475	6/12/2025	172	CV-2414-PLR	7/3/2026
79	CV-24139	6/12/2025	173	CV-2407	7/7/2026
80	CV-24143	6/12/2025	174	CV-2441	7/7/2026
81	CV-24140	6/14/2025	175	CV-2452	7/7/2026
82	CV-24111	6/16/2025	176	CV-2449	7/9/2026
83	CV-24220	6/16/2025	177	CV-2009A	7/10/2026
84	CV-2436	6/23/2025	178	CV-2311	7/10/2026
85	CV-2444	6/23/2025	179	CV-25100D	7/14/2026
86	CV-55R	6/23/2025	180	CV-2501	7/17/2026
87	CV-24213	7/9/2025	181	CV-2502	7/18/2026
88	CV-24150	7/9/2025	182	CV-2564	7/21/2026
89	CV-2319	7/9/2025	183	CV-24151	7/21/2026
90	CV-24219	7/9/2025	184	CV-2505	7/22/2026
91	CV-24110	7/17/2025	185	CV-2324	7/23/2026
92	CV-2485	8/7/2025	186	CV-24102	7/28/2026
93	CV-2489	9/4/2025	187	CV-2507	8/3/2026
94	CV-2440	9/15/2025			

LEGEND

1150

TOPOGRAPHIC CONTOUR

EXISTING CELL LIMITS (APPROXIMATE)

REACTION MITIGATION AREA BOUNDARY - CONDITION 9A

REACTION MITIGATION AREA BOUNDARY

CV-XX

EXISTING VERTICAL EXTRACTION WELL

CV-XX PLR

EXISTING VERTICAL EXTRACTION WELL - PRESSURIZED LEACHATE RELEASE

EXISTING CONDENSATE SUMP - WITH PUMP

EXISTING DE-WATERING WELL - PUMP INSTALLED AND RUNNING

EXISTING DE-WATERING WELL - PUMP INSTALLED, NOT RUNNING

Zone Description	De-Watering Pumps			
	Total	Operational	Not Running	Pending Installation
Within Condition 9A Boundary	151	135	16	12
Outside of Condition 9A Boundary	55	52	3	6
Combined (Both Areas)	206	187	19	18
Condensate Sump	51	50	1	0

DATE

REVISION

NO

SHEET TITLE: EXISTING DE-WATERING WELLS

PROJECT TITLE: CHIQUITA CANYON LANDFILL CASTAIC, CALIFORNIA

CLIENT: CHIQUITA CANYON LANDFILL CASTAIC, CALIFORNIA

SCS ENGINEERS ENVIRONMENTAL CONSULTANTS
15000 WILSON AVENUE, SUITE 300
LONG BEACH, CA 90806
TEL: (562) 426-9544
FAX: (562) 426-9544

DATE: 08/07/2026
SCALE: AS SHOWN
SHEET: 1