

De: Huber, Rachelle <RHuber@scsengineers.com>
Enviado: Viernes 28 de agosto de 2026 4:56 PM
Para: Baitong Chen; Christina Ojeda; Nathaniel Dickel
Cc: Chris Fear; Viswanathan, Srividhya; Mark.Adams; Dylan Smith; Sarah Phillips; Bill Haley; Medina, Steven; Jones, Art; Kim, Jenny
Asunto: Orden de Depuración Estipulada No. 6177-4 - Actualización Semanal sobre la Instalación y Operación de las Bombas
Adjuntos: 2026-08-28_CCLF_Existing De-Watering Well with Pump Map_v0.1.pdf

Hola a todos -

Según la Condición 65 de la Orden Estipulada Modificada, a continuación, se encuentra el resumen de la instalación y operación de las bombas de desagüe para el Vertedero de Chiquita Canyon. Esta información está sujeta a cambios, en base a una mayor revisión y verificación.

Durante el período que transcurrió desde el 21/08/2026 hasta el 27/08/2026, Chiquita completó la instalación y comenzó a operar durante el día diez (10) bombas en pozos verticales de extracción de LFG dando un total de ciento noventa y siete (197) bombas operando en pozos verticales de extracción de LFG. Además, la semana pasada se retiraron dos (2) bombas de la línea y se pusieron operativas diez (10) bombas nuevas, generando un aumento neto de ocho (8) bombas. Se debe tener en cuenta que Chiquita tiene otras bombas en funcionamiento en sumideros perimetrales que no están incluidas en esta cuenta.

Durante el período que va del 28/08/2026 hasta el 03/09/2026, dada la cantidad de bombas de desagüe instaladas hasta la fecha y el mantenimiento asociado a esas bombas, Chiquita tiene planeado instalar y comenzar a operar tres (3) bombas adicionales en pozos verticales de extracción de LFG en ubicaciones a lo largo de la pendiente norte y sur de la zona reactiva.

Atentamente,



Rachelle Huber

Gerente de Proyectos

rhuber@scsengineers.com

O: 562-356-1068

C: 925-789-5710

4683 Chabot Drive, Suite 200


Pleasanton, CA 94588



GENERAL DRAWING NOTES:

1. EXISTING TOPOGRAPHIC SURVEY INFORMATION SHOWN WAS PROVIDED BY PROPELLER AERIAL PHOTOGRAPHY DATED AUGUST 19, 2026.
2. NORTH ARROW SHOWN IN REFERENCE TO CALIFORNIA STATE PLANE ZONE V COORDINATE SYSTEM, NAD 83.
3. EXISTING GCCS VERTICAL WELL AS-BUILT DATED AUGUST 27, 2026.
4. APPROXIMATED REACTION MITIGATION AREA BOUNDARY DATED AUGUST 10, 2026, BASED ON JULY WELLFIELD DATA PER SOFA CONDITION 8(m), AS DEFINED IN 9A.
5. THE LOCATION OF ANY EXISTING GCCS COMPONENTS AND OTHER FEATURES ARE APPROXIMATE AND SHOULD BE USED FOR INFORMATION PURPOSES ONLY.

De-Watering Well Pumps		
Currently Installed - NOT Running		
#	Well ID	
1	CV-2009A	
2	CV-2314-PLR	
3	CV-2349	
4	CV-2415	
5	CV-2432	
6	CV-2453	
7	CV-2466	
8	CV-2467	
9	CV-2478	
10	CV-2485	
11	CV-2491	
12	CV-2530	
13	CV-2548	
14	CV-2557	
15	CV-24201	
16	CV-24209	
17	CV-24210	
18	CV-24224	
19	CV-24226	

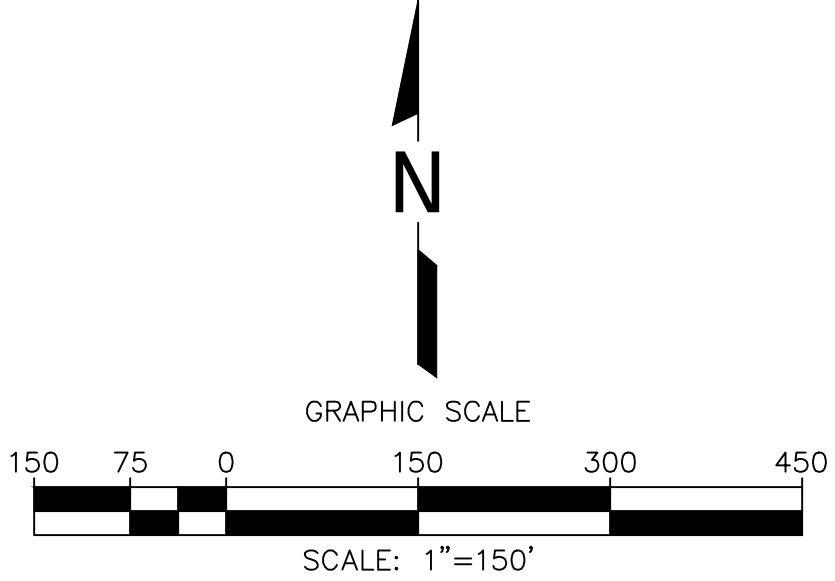

LEGEND

- 1150 TOPOGRAPHIC CONTOUR
- EXISTING CELL LIMITS (APPROXIMATE)
- REACTION MITIGATION AREA BOUNDARY - CONDITION 9A
- REACTION MITIGATION AREA BOUNDARY
- CV-XX EXISTING VERTICAL EXTRACTION WELL
- CV-XX PLR EXISTING VERTICAL EXTRACTION WELL - PRESSURIZED LEACHATE RELEASE
- EXISTING CONDENSATE SUMP - WITH PUMP
- EXISTING DE-WATERING WELL - PUMP INSTALLED AND RUNNING
- EXISTING DE-WATERING WELL - PUMP INSTALLED, NOT RUNNING

De-Watering Well Pumps Currently Running					
#	Well ID	Install Date	#	Well ID	Install Date
1	CV-2337	4/22/2024	100	CV-2010A	11/24/2025
2	CV-2302	4/26/2024	101	CV-2011A	11/24/2025
3	CV-2328	4/26/2024	102	CV-24156	12/17/2025
4	CV-2336	4/30/2024	103	CV-2551	12/30/2025
5	CV-24142	5/3/2024	104	CV-1902A	1/16/2026
6	CV-24144	5/13/2024	105	CV-24138	1/23/2026
7	CV-2496	5/30/2024	106	CV-2352	1/26/2026
8	CV-2497	5/30/2024	107	CV-2455	2/28/2026
9	CV-2411	6/24/2024	108	CV-2495	2/29/2026
10	CV-2416	6/24/2024	109	CV-24167	3/4/2026
11	CV-24109	7/3/2024	110	CV-24185	3/19/2026
12	CV-24100	7/17/2024	111	CV-24178	3/30/2026
13	CV-2348	7/22/2024	112	CV-2430	3/31/2026
14	CV-2345	7/27/2024	113	CV-2555	4/1/2026
15	CV-2344	7/30/2024	114	CV-24176	4/3/2026
16	CV-2417	8/13/2024	115	CV-2422-PLR	4/6/2026
17	CV-2418	8/14/2024	116	CV-2321	4/10/2026
18	CV-2341	8/15/2024	117	CV-2446	4/11/2026
19	CV-2427	8/15/2024	118	CV-2457	4/11/2026
20	CV-24124	8/24/2024	119	CV-2458	4/11/2026
21	CV-2423	8/26/2024	120	CV-2424-PLR	4/13/2026
22	CV-2409	8/30/2024	121	CV-2305	4/15/2026
23	CV-24108	9/4/2024	122	CV-24172	4/16/2026
24	CV-2437	11/26/2024	123	CV-2531	4/29/2026
25	CV-2451	12/23/2024	124	CV-24127	5/21/2026
26	CV-2470	12/24/2024	125	CV-24180	5/29/2026
27	CV-2445	1/6/2025	126	CV-2443	6/1/2026
28	CV-24212	1/10/2025	127	CV-2456	6/1/2026
29	CV-2462	1/14/2025	128	CV-2472	6/1/2026
30	CV-2463	1/15/2025	129	CV-24157	6/1/2026
31	CV-2001	1/23/2025	130	CV-24170	6/2/2026
32	CV-2479	1/28/2025	131	CV-2459	6/2/2026
33	CV-2483	1/29/2025	132	CV-2460	6/2/2026
34	CV-2338	2/8/2025	133	CV-2461	6/2/2026
35	CV-24202	2/20/2025	134	CV-2469	6/2/2026
36	CV-2208A	3/9/2025	135	CV-2471	6/3/2026
37	CV-24197	3/11/2025	136	CV-2326	6/3/2026
38	CV-24165	4/7/2025	137	CV-2473	6/3/2026
39	CV-24166	4/7/2025	138	CV-2484	6/3/2026
40	CV-24168	4/7/2025	139	CV-24136	6/3/2026
41	CV-24171	4/7/2025	140	CV-24158	6/3/2026
42	CV-24134	4/9/2025	141	CV-24164	6/3/2026
43	CV-24135	4/11/2025	142	CV-2303	6/5/2026
44	CV-24173	4/15/2025	143	CV-24148	6/5/2026
45	CV-24174	4/15/2025	144	CV-24152	6/5/2026
46	CV-24175	4/15/2025	145	CV-24153	6/5/2026
47	CV-24159	4/16/2025	146	CV-24155	6/5/2026
48	CV-24154	4/17/2025	147	CV-24215	6/5/2026
49	CV-2465	4/25/2025	148	CV-2553	6/7/2026
50	CV-24214	5/2/2025	149	CV-2426	6/9/2026
51	CV-2354	5/6/2025	150	CV-2434	6/9/2026
52	CV-2493	5/6/2025	151	CV-24120	6/9/2026
53	CV-24160	5/6/2025	152	CV-24128	6/9/2026
54	CV-2438	5/7/2025	153	CV-2333	6/10/2026
55	CV-2492	5/7/2025	154	CV-2406	6/10/2026
56	CV-2205	5/8/2025	155	CV-2477	6/10/2026
57	CV-24161	5/8/2025	156	CV-24125	6/10/2025
58	CV-24118	5/14/2025	157	CV-2343-PLR	6/15/2026
59	CV-24119	5/14/2025	158	CV-2474	6/16/2026
60	CV-24107	5/15/2025	159	CV-2316	6/17/2026
61	CV-24211	5/15/2025	160	CV-2482	6/18/2026
62	CV-24137	5/15/2025	161	CV-2544	6/18/2026
63	CV-24208	5/16/2025	162	CV-2546	6/18/2026
64	CV-24116	5/20/2025	163	CV-2545	6/19/2026
65	CV-24204	5/20/2025	164	CV-24177	6/22/2026
66	CV-24205	5/20/2025	165	CV-2540	6/23/2026
67	CV-2490	6/5/2025	166	CV-24126	7/1/2026
68	CV-24203	6/5/2025	167	CV-2414-PLR	7/3/2026
69	CV-24207	6/9/2025	168	CV-2407	7/7/2026
70	CV-24225	6/9/2025	169	CV-2441	7/7/2026
71	CV-24186	6/10/2025	170	CV-2452	7/7/2026
72	CV-24222	6/10/2025	171	CV-2449	7/9/2026
73	CV-24163	6/11/2025	172	CV-2311	7/10/2026
74	CV-2439	6/12/2025	173	CV-2454	7/14/2026
75	CV-2475	6/12/2025	174	CV-25100D	7/14/2026
76	CV-24139	6/12/2025	175	CV-2543-PLR	7/16/2026
77	CV-24143	6/12/2025	176	CV-2501	7/17/2026
78	CV-24140	6/14/2025	177	CV-24223	7/17/2026
79	CV-24111	6/16/2025	178	CV-2502	7/18/2026
80	CV-24220	6/16/2025	179	CV-2564	7/21/2026
81	CV-2436	6/23/2025	180	CV-24151	7/21/2026
82	CV-2444	6/23/2025	181	CV-2505	7/22/2026
83	CV-255R	6/23/2025	182	CV-2524	7/23/2026
84	CV-2498	7/1/2025	183	CV-24102	7/28/2026
85	CV-24101	7/3/2025	184	CV-2507	8/3/2026
86	CV-2319	7/9/2025	185	CV-2560	8/3/2026
87	CV-24129	7/9/2025	186	CV-2556-PLR	8/6/2026
88	CV-24150	7/9/2025	187	CV-2552	8/7/2026
89	CV-24213	7/9/2025	188	CV-2468	8/10/2026
90	CV-24219	7/9/2025	189	CV-1532A-PLR	8/12/2026
91	CV-24110	7/17/2025	190	CV-2503	8/12/2026
92	CV-24162	8/16/2025	191	CV-2339	8/13/2026
93	CV-2489	9/4/2025	192	CV-2541	8/13/2026
94	CV-2440	9/15/2025	193	CV-25104D	8/14/2026
95	CV-2431	9/18/2025	194	CV-2542	8/18/2026
96	CV-2425	9/22/2025	195	CV-2408	8/19/2026
97	CV-2533	10/17/2025	196	CV-2428	8/19/2026
98	CV-2529	10/18/2025	197	CV-2421	8/20/2026
99	CV-2433	10/28/2025			

Zone Description	De-Watering Pumps			
	Total	Operational	Not Running	Pending Installation
Within Condition 9A Boundary	160	148	12	13
Outside of Condition 9A Boundary	56	49	7	5
Combined (Both Areas)	216	197	19	18
Condensate Sump	52	51	1	0

DATE: 08/28/2026

SCALE: AS SHOWN

SHEET: 1

REVISION

NO.

DATE

DESCRIPTION

PROJECT TITLE:

CHICUITA CANYON LANDFILL
CASTAIC, CALIFORNIA

CLIENT:

SCS ENGINEERS
ENVIRONMENTAL CONSULTANTS
1500 N. CALIFORNIA AVE., SUITE 300
LONG BEACH, CA 90806
PH: (562) 426-9544

ACAD FILE: N:\CAD\ASBUILT-MASTERS

APP. BY: SRM

CHK. BY: SRM

DATE: 08/28/2026

A
B
C
D
E
F
G
H
I
J

\\son-fs02\data\Files\Engineers\Waste Connections\Chiquita Canyon LF\2026 Well and Pump Tracking\PROJECT\DWG\2026-08-28_CCL Existing De-Watering Well with Pump Map_v0.0.dwg Aug 28, 2026 - 4:53pm By: cway