



September 1, 2026

California Regional Water Quality Control Board
Los Angeles Region
320 W. 4th Street, Suite 200
Los Angeles, California 90013
ATTN: Information Technology Unit

Subject: Leachate Seep Report
Chiquita Canyon Landfill
WDRs Order No. R4-2018-0172
File No. 67-020

Pursuant to MRP No. CI-6231 Section B.3.a, Chiquita Canyon, LLC (“Chiquita”) hereby provides the following information regarding a seep discovered on August 25, 2026 during which approximately 0.25 gallons of characteristically non-hazardous leachate associated with Group C was observed in the stormwater channel but did not reach either sedimentation basin. This is a conservative estimate based on visual observations by Chiquita staff. Chiquita maintains appropriate response materials, including fully stocked spill kits, and has trained staff on site to respond to seeps to prevent liquids from entering the stormwater system.

i. Map - A map showing the location(s) of seepage.

The seep was observed in Grids 93 and 95, as indicated in **Attachment A**.

ii. Flow rate - An estimate of the flow rate.

The seep had a low flow rate.

iii. Description - A description of the nature of the discharge (e.g., all pertinent observations and analyses).

On August 25, 2026, at approximately 7:30 a.m., Chiquita personnel observed a small seep in Grids 93 and 95 that had a low flow rate. Chiquita personnel observed that approximately 0.25 gallons of leachate seeped from the joints in the stormwater channel. No liquid from the seep reached either sedimentation basin. The liquid was dark brown in color with low viscosity and traveled with a low flow rate.

September 1, 2026

Page 2 of 2

iv. Location – Location of sample(s) collected for laboratory analysis, as appropriate.

No sampling was conducted for this seep.

v. Corrective measures – approved (or proposed for consideration) by the Regional Board Executive Officer.


Liquid from the seep was contained by a check dam. The stormwater channel was pressure washed while applying vacuum to ensure the proper collection of all wash water. Sealant was then applied to the affected joints to help prevent future seepage. The cleanup took approximately 12 hours, and the concrete sealant was applied on Thursday, August 27, 2026.

If you should have any questions regarding this report, please do not hesitate to contact me at (661) 257-3655.

Sincerely,
Chiquita Canyon, LLC

Sarah Phillips
Corporate Compliance Manager
Chiquita Canyon

Attachments: Attachment A – Grid Map of Seep Location

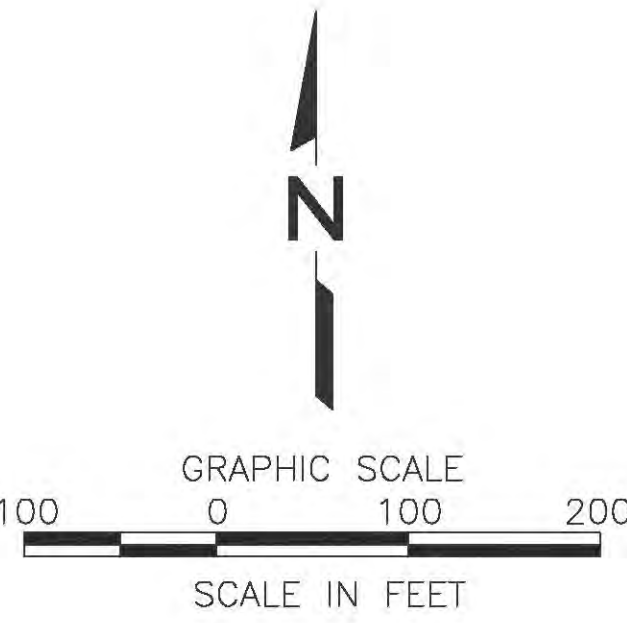

LEGEND

- CV-69 ACTIVE VERTICAL WELLS ABOVE GRADE
- CV-69 ACTIVE VERTICAL WELLS WITH HOV TEMP
- CV-69 ACTIVE VERTICAL WELLS WITH HOV O2
- CV-69 ACTIVE VERTICAL WELL WITH ELEVATED H2S
- CV-43 ACTIVE VERTICAL WELLS BELOW GRADE
- C-31 ACTIVE HORIZONTAL WELLS
- C-31 ACTIVE HORIZONTAL WELLS WITH HOV TEMP
- C-31 ACTIVE HORIZONTAL WELLS WITH ELEVATED H2S
- C-31 ACTIVE HORIZONTAL WELLS WITH STINGERS
- DW-1 DETECTION WELLS
- PZ-1 PIEZOMETER
- CV-38 REMOTE VERTICAL WELL HEADS
- CV-38 REMOTE VERTICAL WELL HEADS WITH HOV O2
- CV-38 REMOTE VERTICAL WELL HEADS WITH HOV TEMP
- GP-9 GAS PROBE
- V VALVE
- V VALVE VAULT
- AC ACTIVATED CARBON VESSEL
- LC-5 SAMPLE POINT

NOTES:

- EXISTING TOPOGRAPHY PLAN IS FROM PROPELLER DATA. THE TOPOGRAPHY DATA IS BASED ON AUGUST 11, 2023.
- EXISTING GCCS AS-BUILTS DATED 10-18-23.

DATE	
REVISION	
NO.	
SHEET TITLE: LANDFILL GAS COLLECTION SYSTEM WITH SEM MAP	
PROJECT TITLE: CHIQUITA CANYON LANDFILL 29201 HENRY MAYO DRIVE, CASTAIC, CALIFORNIA 91384	
CLIENT: SCS ENGINEERS ENVIRONMENTAL CONSULTANTS	
DATE: 10-20-2013	
SCALE: 1" = 100'	
1 of 1	