

From: WILLIAM.HALEY@WasteConnections.com
Sent: Friday, October 16, 2026 3:36 PM
To: Karen Gork
Cc: Todd.Thalhamer@Calrecycle.ca.gov; LFrias@ph.lacounty.gov; NQuick@ph.lacounty.gov; RRagland@ph.lacounty.gov; BMcphillips@counsel.lacounty.gov; Wes.Mindermann@CalRecycle.ca.gov; mark.debie@calrecycle.ca.gov; mark.debie@calrecycle.ca.gov; emorofuji@ph.lacounty.gov; btway@ph.lacounty.gov; Relon.MarkAnthony@epa.gov; Holybee.Tyler@epa.gov; Friedli.Laura@epa.gov; John Perkey; Sarah Phillips; Gregory.Shaffer@dtsc.ca.gov; Natasha.DiPietro@dtsc.ca.gov; Gregory.Gentile@dtsc.ca.gov; Dylan Smith
Subject: Re: Chiquita Canyon Landfill – Geosynthetic Cover – Mitigation Measure 4.1
Attachments: RM22.1077-CCL-EVOH-FIG 1-(2026-10-16)-FIG 1.pdf; Milestone 2B Chiquita Canyon LF Isopach_Sep.2026.pdf; 2026-10-16_CCLF Reaction Area - Reactive Wells - September_V1.0.pdf

Below is Chiquita’s weekly update on the status of the installation of the 60-mil EVOH/HDPE geomembrane cover at the Chiquita Canyon Landfill, in accordance with Mitigation Measure 4.1 of the LEA’s Compliance Order issued May 1, 2025.

As of October 9, 2026, D&E, on behalf of Chiquita, has installed approximately 4,295,480 square feet of tan 60-mil EVOH/HDPE geomembrane cover. Of this total, approximately 796,254 square feet has been deployed on top of the existing 30mil geomembrane to augment its effectiveness. Work conducted the week of October 5 included extensive repairs and detailing of existing panels, including boot fabrication, patching, extrusion welding, re-seaming, and sand bag placement as needed. Work continued during the week of October 12, 2026. Chiquita has included the below summary total of Liner quantities:


	New EVOH Liner Installed	EVOH over existing 30-mil Installed	Existing 30- mil Liner	Total Liner Coverage
8/7/2026	2,629,969	736,689	1,564,950	4,931,608
8/14/2026	2,752,615	736,689	1,564,950	5,054,254
8/21/2026	2,860,533	736,689	1,564,950	5,162,172
8/28/2026	2,972,601	736,689	1,564,950	5,274,240
9/4/2026	3,070,743	736,689	1,564,950	5,372,382
9/11/2026	3,130,545	736,689	1,564,950	5,432,184
9/18/2026	3,232,497	736,689	1,564,950	5,534,136
9/25/2026	3,411,786	736,689	1,564,950	5,713,425
10/2/2026	3,411,786	756,444	1,545,195	5,713,425
10/9/2026	3,499,254	796,226	1,545,195	5,840,675

The attached site map shows the approximate extent of geomembrane cover installed as of Wednesday, October 7, 2026, as well as the geomembrane coverage described in the revised draft workplan for extension of the geomembrane cover area submitted to the LEA, the US EPA, and DTSC on March 13, 2026. Also attached to this submission are the September 2026 monthly isopach map and a figure


identifying wells showing signs of reaction as of October 16, 2026 based on the June Reaction Mitigation Area. Due to technical limitations, we are currently unable to create one figure including all of this data.

Thank you,

P:\SITES\CHIQUITA CYN LF\MONITORING SUMMARY\FIGURES-WEEKLY\RM22.1077-CCL-EVOH-FIG 1--(2026-10-16).DWG October 16, 2026 -- 1:48 PM BY: GLA-USER


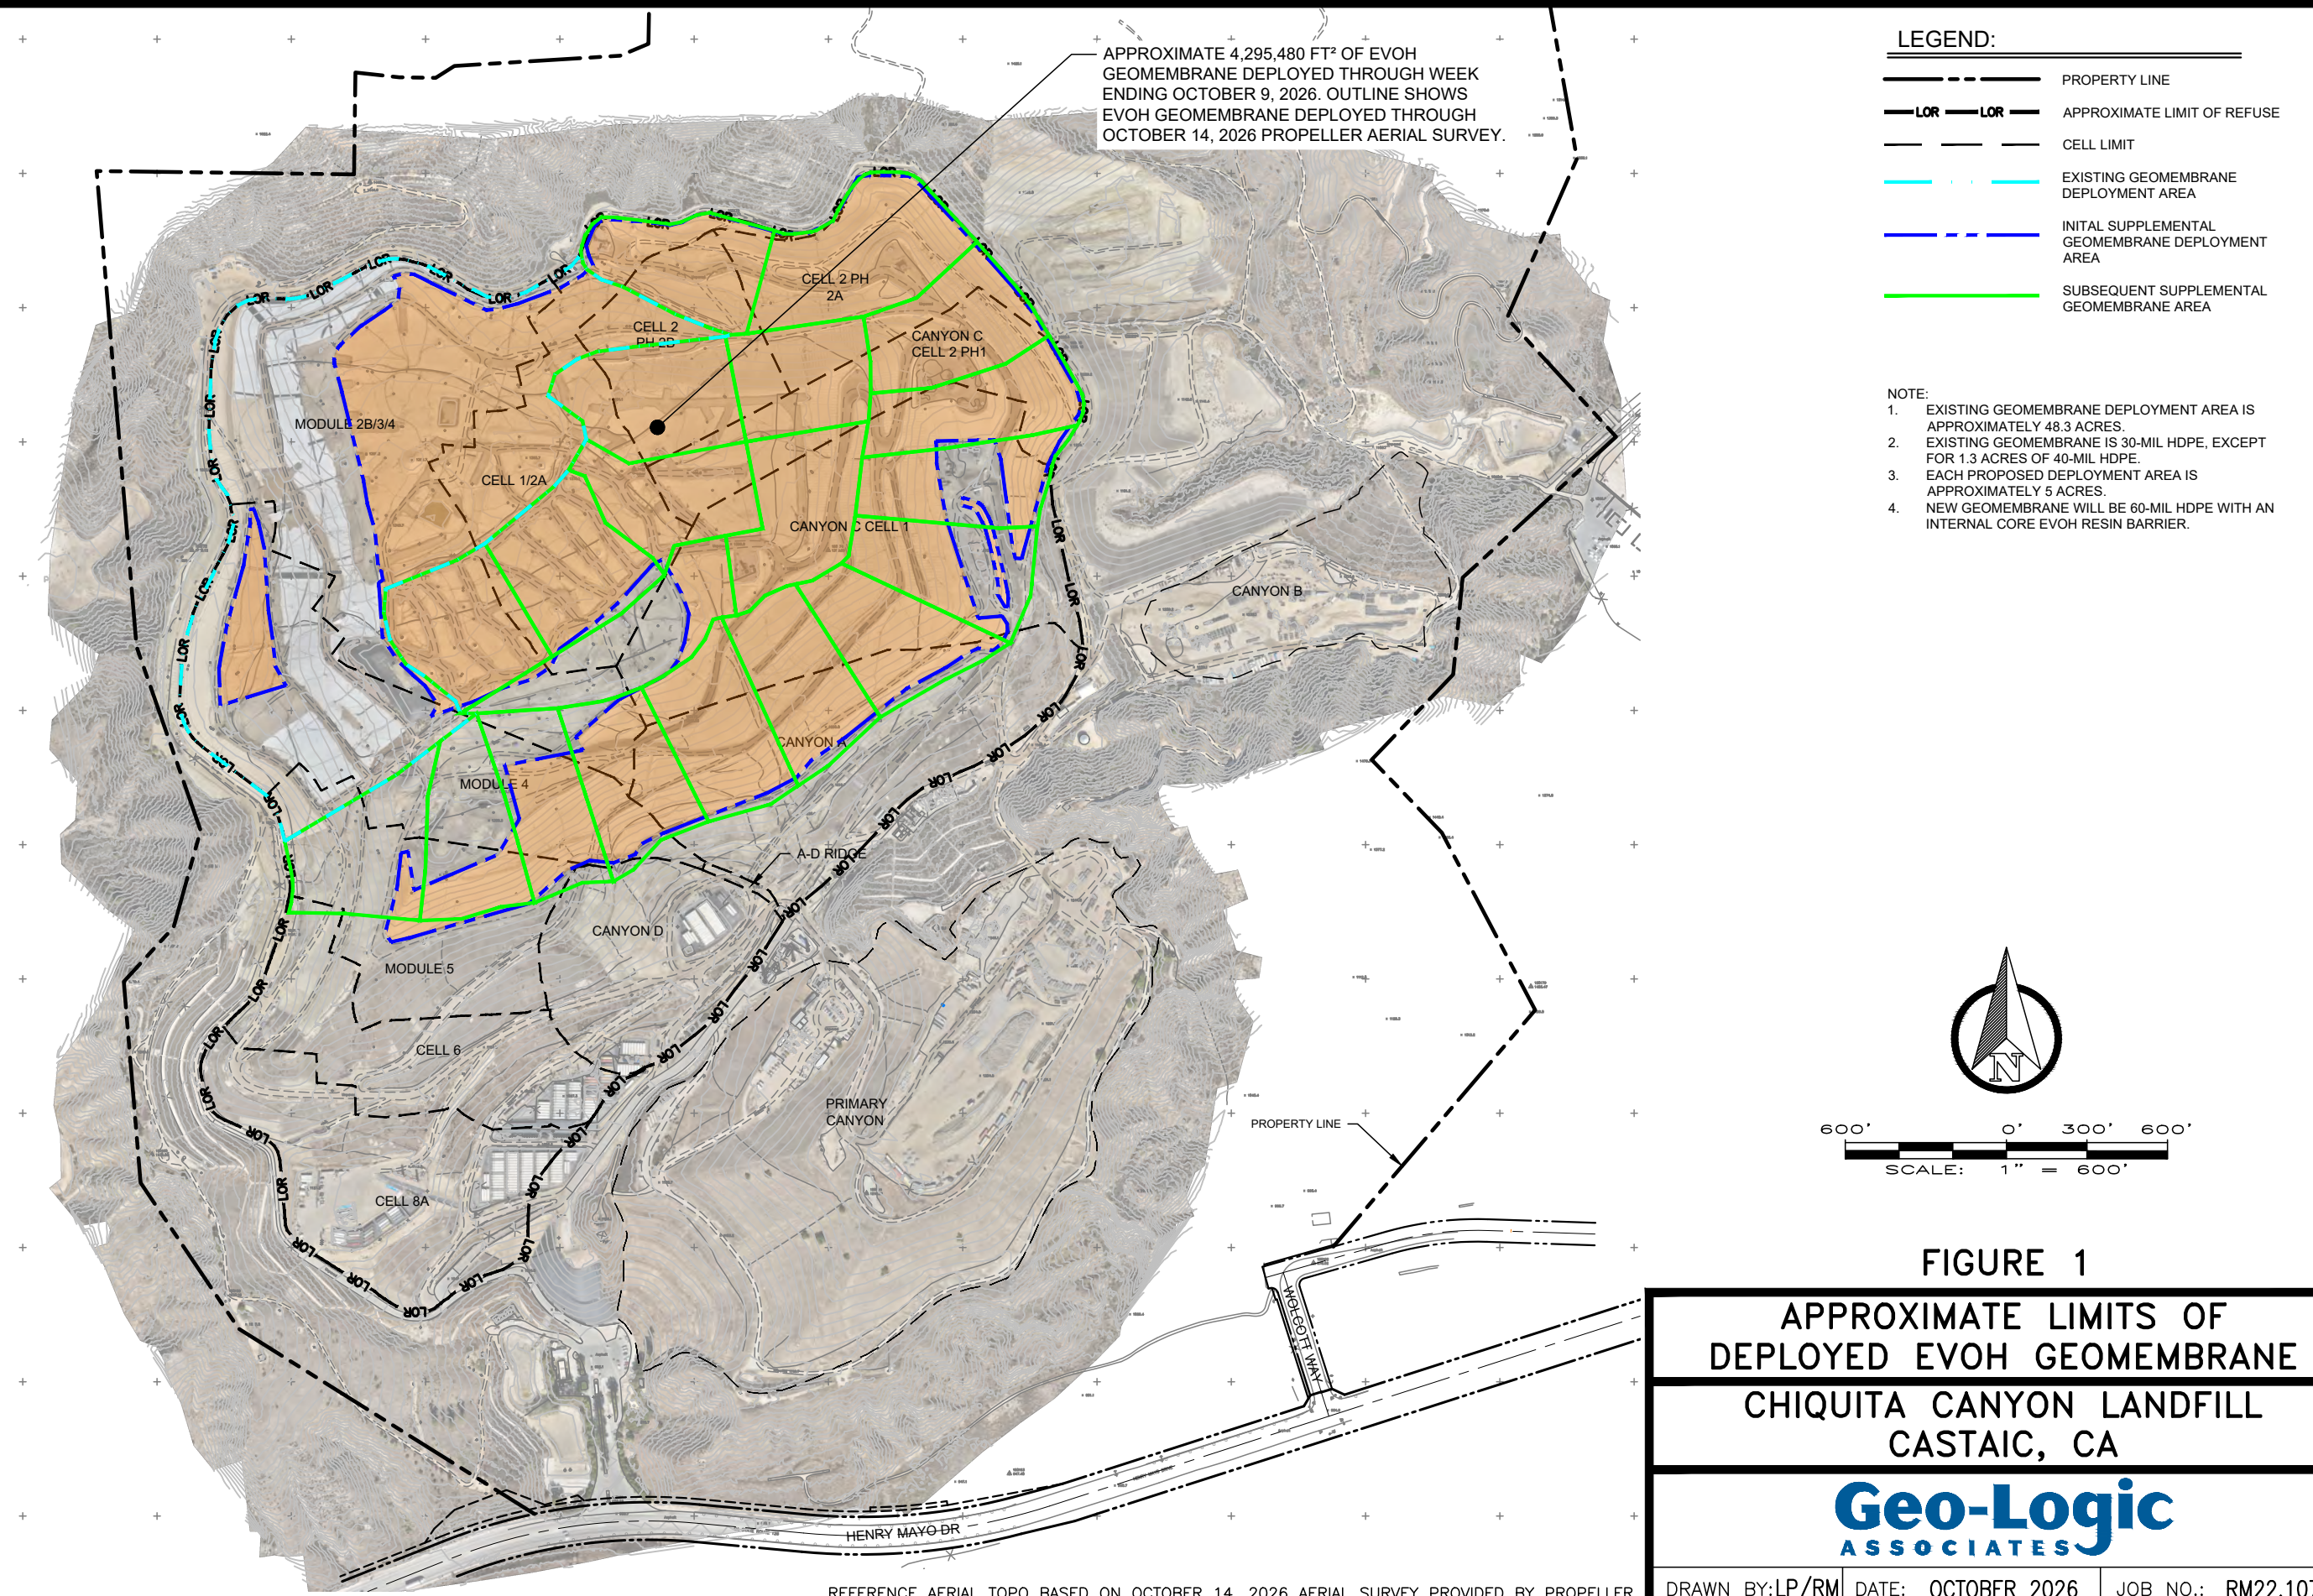


Chiquita Canyon Landfill -Isopach

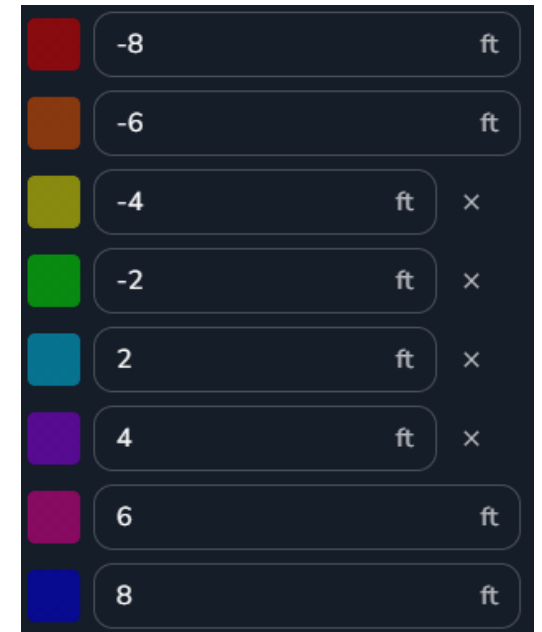

Sep 30, 2026 Survey Image. Sep 2, 2026 vs Sep 30, 2026

\\san-fs02\Files\Engineers\Waste_Connections\Chiquita_Canyon_LF\2026_Reaction_Area_Maps\09-September\DWG\2026-10-15_WC_CCLF_Reaction_Area_September_Reactive_Wells.dwg, Oct 15, 2026 - 8:42am By: istrosso

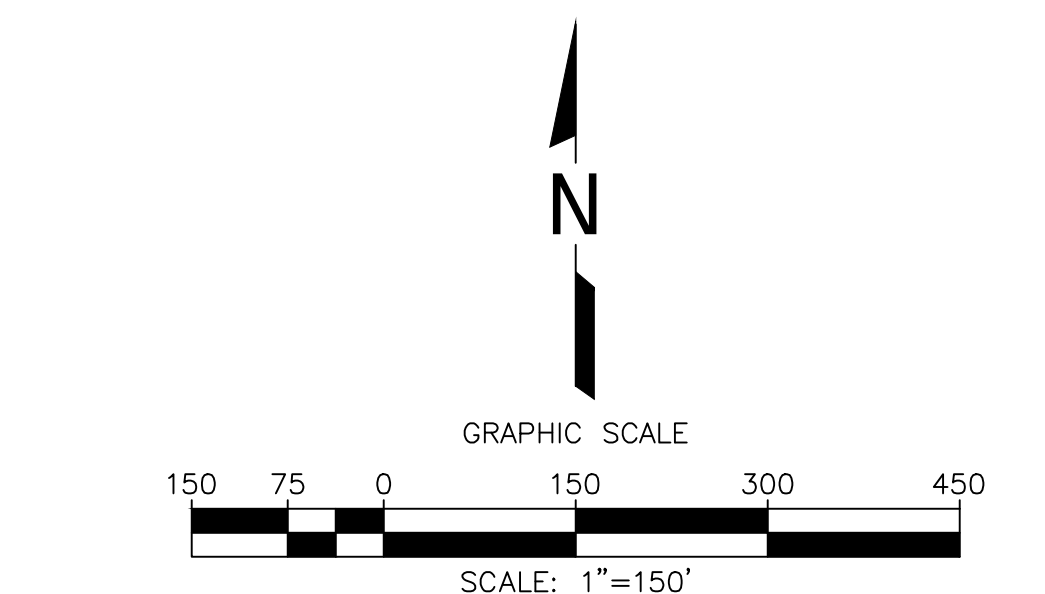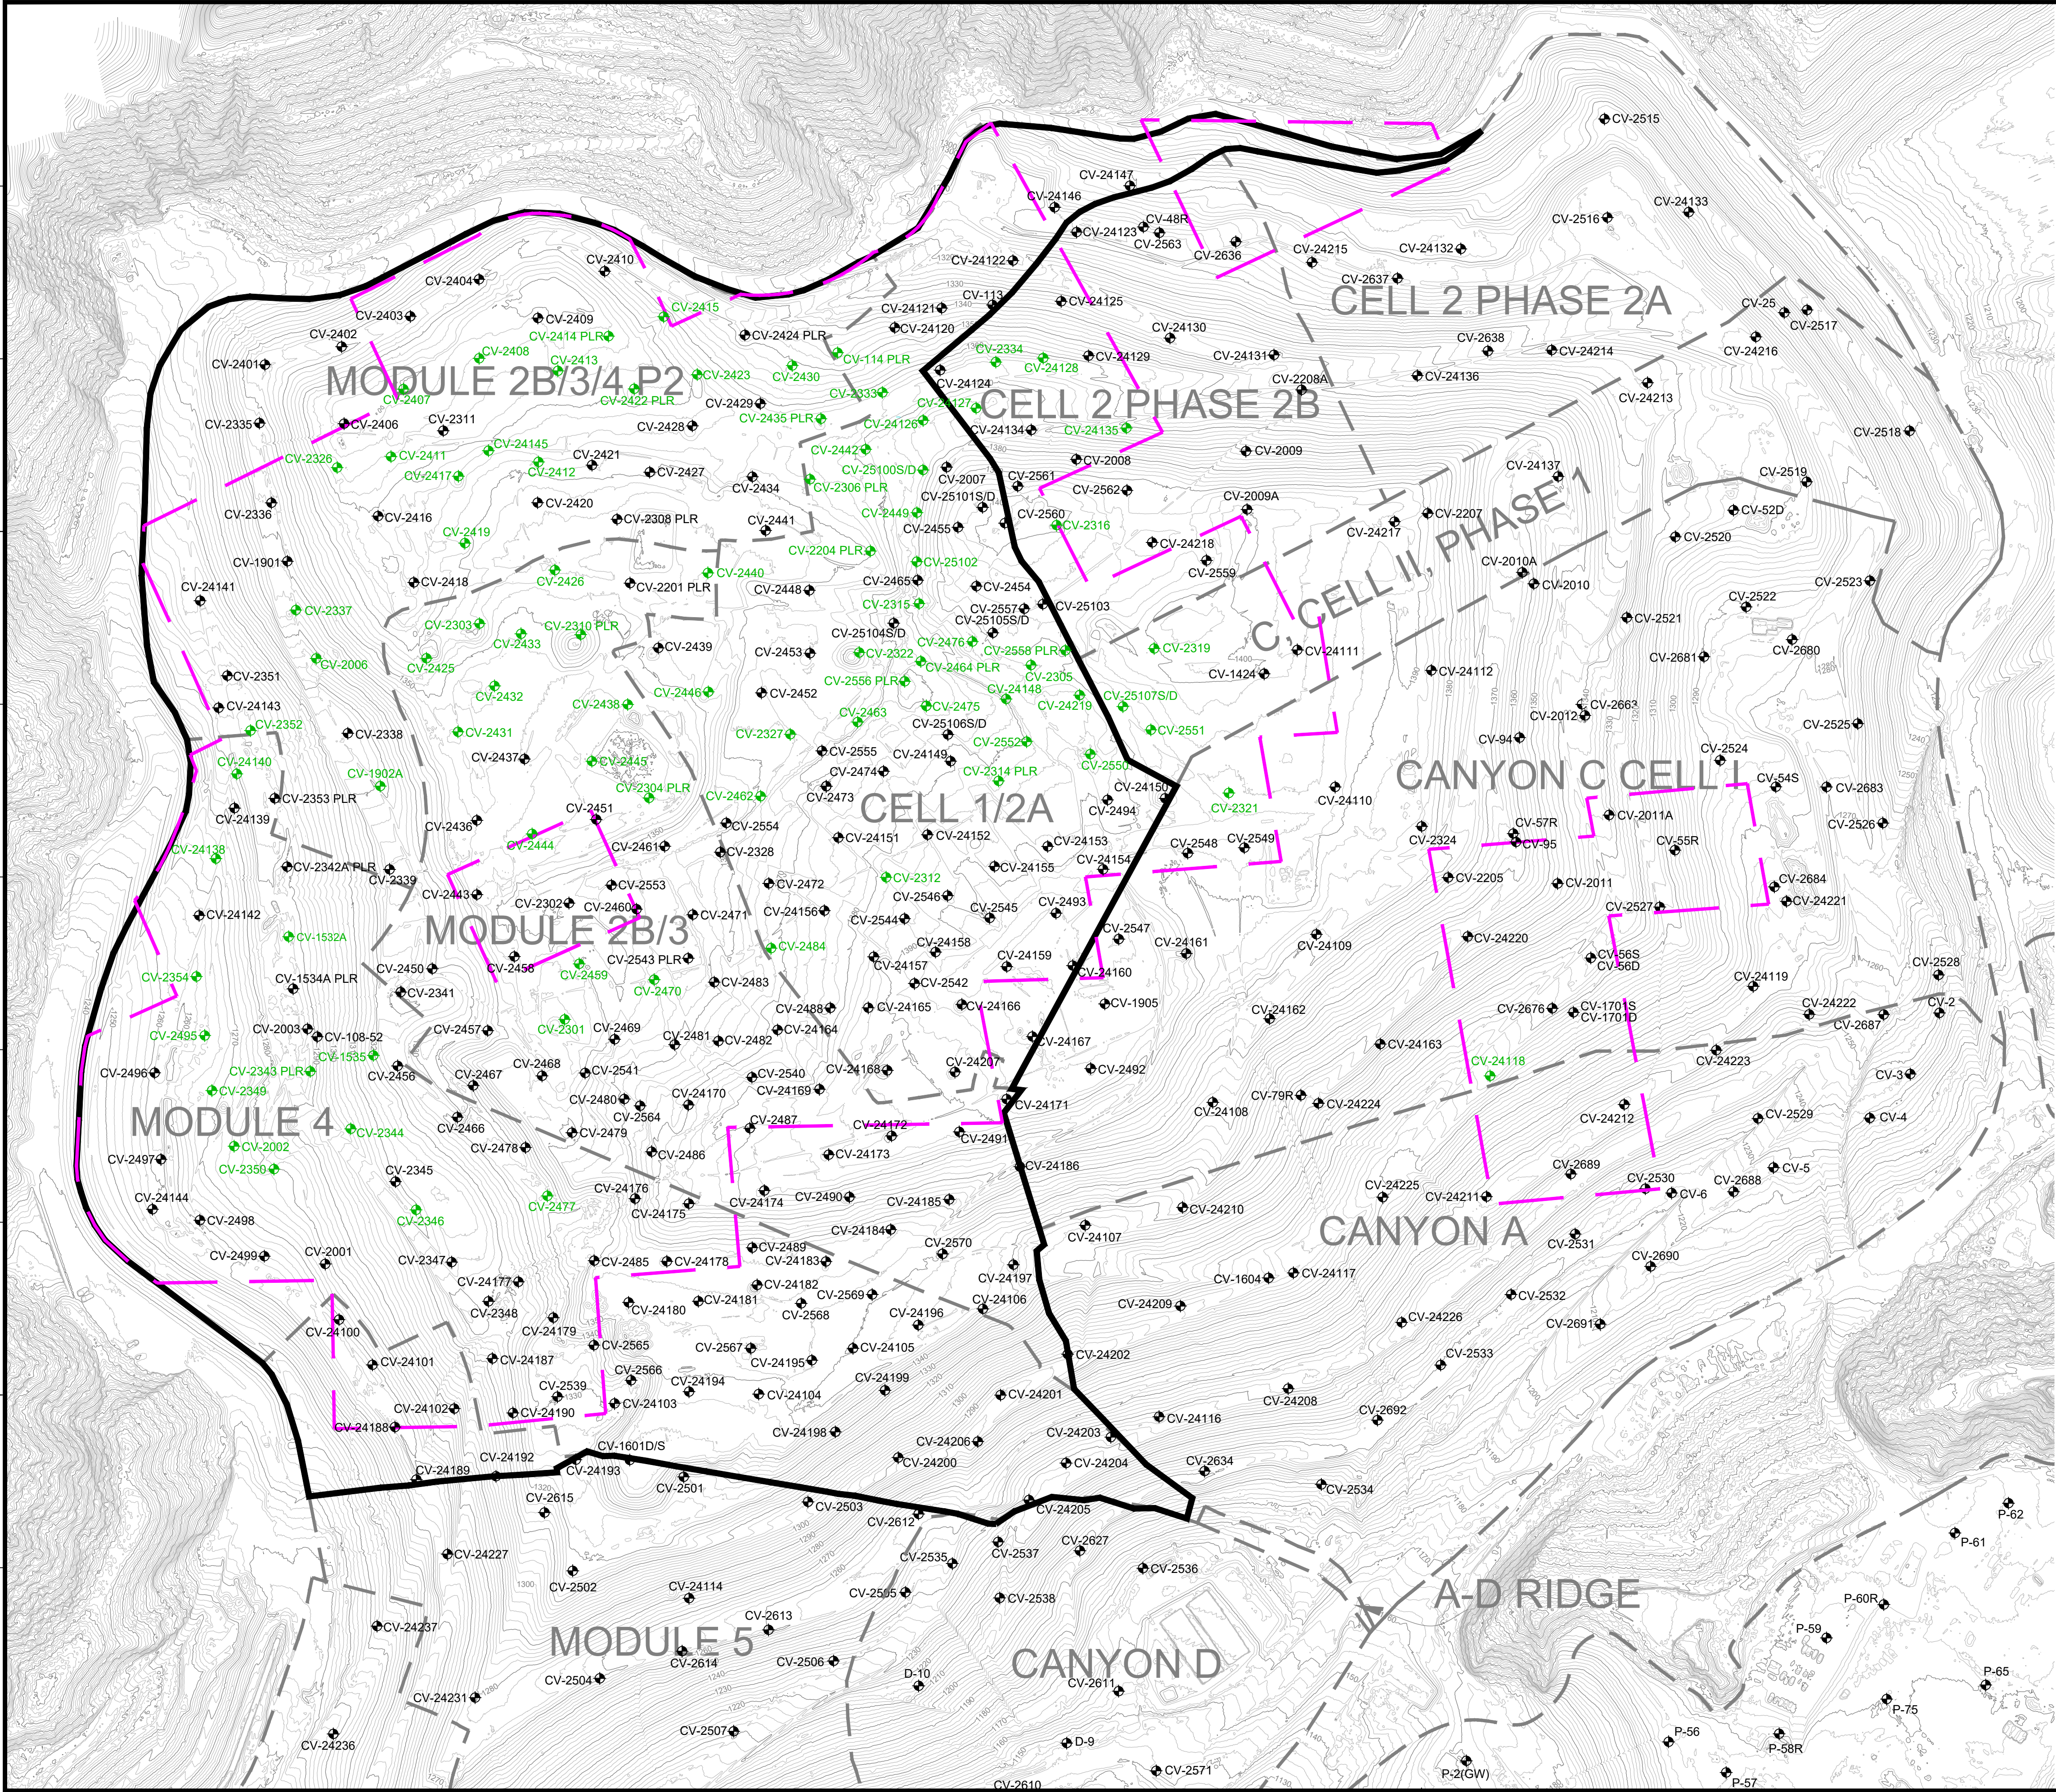

LEGEND	
	EXISTING TOPOGRAPHIC CONTOUR
	EXISTING CELL LIMITS (APPROXIMATE)
	PROPOSED REACTION MITIGATION AREA BOUNDARY
	REACTION MITIGATION AREA BOUNDARY - CONDITION 9A
	EXISTING VERTICAL WELLS
	EXISTING VERTICAL WELL - PRESSURIZED LEACHATE RELEASE
	EXISTING VERTICAL WELLS - REACTIVE

CLIENT:	SHEET TITLE: REACTION AREA MAP - SEPTEMBER 2026 REACTIVE VERTICAL EXTRACTION WELLS		PROJECT TITLE: CHIQUITA CANYON LANDFILL CASTAIC, CALIFORNIA	
	NO.		DATE	
	1		10/16/2026	
SCS ENGINEERS ENVIRONMENTAL CONSULTANTS 1500 N. 15TH AVENUE, SUITE 300 LONG BEACH, CA 90806 PH: (562) 426-9544	SCALE: AS SHOWN		SHEET: 1	
	DRAWN BY: ISR		CHECKED BY: RNH	
	APP. BY: ISR		DATE: 10/16/2026	

- GENERAL DRAWING NOTES:
- EXISTING GCCS AS-BUILT DATED SEPTEMBER 30, 2026.
 - APPROXIMATED REACTION MITIGATION AREA BOUNDARY DATED OCTOBER 9, 2026, BASED ON SEPTEMBER DATA, PER SOFA CONDITION 8(m) AS DEFINED IN 9B.
 - EXISTING TOPOGRAPHIC SURVEY INFORMATION SHOWN WAS PROVIDED BY PROPELLER AERIAL PHOTOGRAPHY DATED SEPTEMBER 30, 2026.
 - NORTH ARROW SHOWN HERE IS REFERENCE TO THE CALIFORNIA STATE PLANE ZONE V COORDINATE SYSTEM, NAD 83.
 - LOCATIONS OF EXISTING FEATURES ARE APPROXIMATE AND SHOULD BE USED FOR INFORMATIONAL PURPOSES ONLY. ACTUAL FIELD CONDITIONS MAY VARY AND ARE SUBJECT TO CHANGE BASED ON TOPOGRAPHIC OR SITE-SPECIFIC CONDITIONS.