

11 July 2025

### Five County Stadium - ADA Phase 2

Project No. RFB #25-070

To: All Known Bidders / Plan Rooms From: Daniel R Culbertson, AlA

Attached and described below are amendments to the original bid documents published on June 9, 2025. Please acknowledge your receipt of this document on your bid form. Failure to do so could disqualify your bid.

#### **ADDENDUM 02**

#### 1. Drawings

- D200 Demo Plan
  - General Notes, Existing Utilities Sections C, D and E
    - 1. Revise references from 'throughout the building' to 'throughout the work area.'
    - 2. Revise reference from 'Civil Drawings' to 'Plumbing Drawings.' There are no civil drawings that are a part of this bid package.
- A201 Floor Plan
  - Restroom plan 02/A201 toilet fixture callout was revised to read 'Floor mounted, floor outlet toilet fixtures - see plumbing dwgs.'
- A202 Floor Plan
  - Restroom plan 02/A202 was revised to properly indicate the location of sanitary napkin disposal 'E' instead of dispensers 'F' in the Accessible, Ambulatory and Typical restroom stalls.
  - The accessories indicated in the stalls are shown as typical conditions and should be applied to all similar conditions found in the restroom.
  - Restroom plan 02/A202 toilet fixture callout was revised to read 'Floor mounted, floor outlet toilet fixtures - see plumbing dwgs.'
- A203 Floor Plan
  - Restroom accessories 'F' and 'O' are now visually shown on the floor plan 02/A203 for 250G Men's and 251G Women's restrooms as applicable.
- A501 Interior Elevations
  - Toilet fixture callouts have been revised to read 'Floor mounted, floor outlet toilet fixtures see plumbing dwgs.'
  - o 01/A501 Interior Elevation A is revised to correctly coordinate with the lavatory and accessories quantity and arrangement indicated on the Floor Plan 02/A202.
  - o 01/A501 Interior Elevations A, B and D are revised to visually show restroom accessories 'O' and 'I' that are indicated on Floor Plan 02/A202.
  - o 02/A501 Interior Elevations A, B and D are revised to visually show restroom accessories 'O' and 'I' that are indicated on Floor Plan 02/A201.
- A502 Interior Elevations

- Toilet fixture callouts have been revised to read 'Floor mounted, floor outlet toilet fixtures - see plumbing dwgs.'
- o 01/A502 Interior Elevations D is revised to visually show restroom accessories 'O' and 'F' that are indicated on Floor Plan 02/A203.
- o 02/A502 Interior Elevations B is revised to visually show restroom accessory 'O' that is indicated on Floor Plan 02/A201.

#### A600 Schedules

- o Accessory 'G' Paper Towel Dispenser has been changed to Tork Model No. 5511282
- Accessory 'H' Paper Towel Dispenser with Trash Receptacle has been changed to Tork Model No. 5511282 with 309051
- Accessory 'O' Baby Changing Station has been changed to ASI Model No. 9018-9 and is shown as a surface mounted station.
- Accessory 'P' is no longer used.


#### 2. Project Manual

• Revise Specification 224000 Part 2 as outlined in the attached document.

#### 3. Attachments

- Revised Sheets D200, A201, A202, A203, A501, A502 and A600.
- Attachment from HDM Associates for the above specification changes.

**END ADDENDUM 02** 

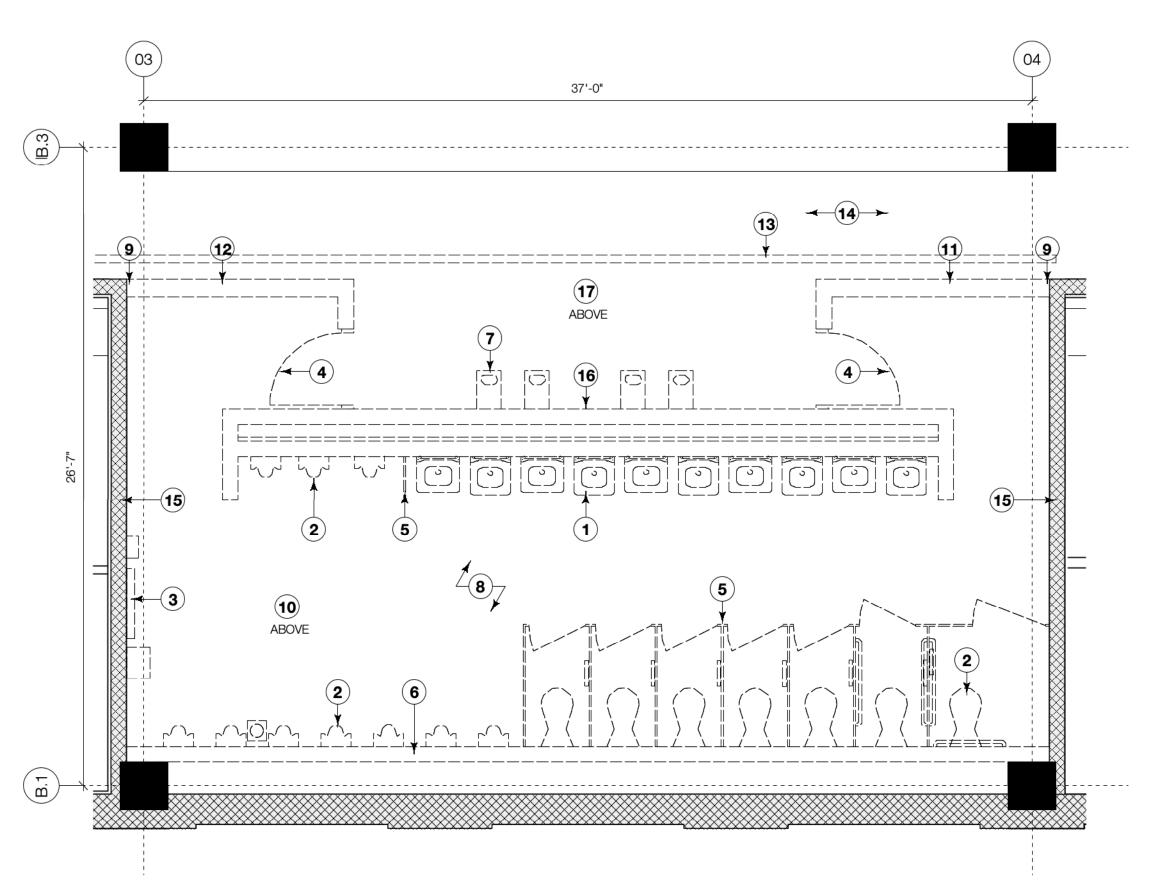

**ABOVE** 

# SPECIFIC DEMOLITION NOTES, Men's 101

- 1. REMOVE LAVATORY FIXTURE AND ASSOCIATED PLUMBING SEE PLUMBING DRAWINGS FOR ADDITIONAL INFORMATION
- 2. REMOVE TOILET / URINAL FIXTURE AN ASSOCIATED PLUMBING SEE PLUMBING DRAWINGS FOR ADDITIONAL INFORMATION
- 3. REMOVE MISCELLANEOUS RESTROOM ACCESORIES AND PATCH EXISTING WALLS IF SCHEDULED TO REMAIN
- 4. REMOVE EXISTING HM DOOR AND FRAME
- 5. REMOVE EXISTING PARTITIONS AND ASSOCIATED ACCESSORIES. PATCH FASTENER HOLES IN WALLS AND FLOORS AS REQUIRED
- 6. REMOVE CMU WALL AND PREP AREA FOR NEW WALL AND PLUMBING FIXTURES TAKING CARE NOT TO DAMAGE EXISTING ELECTRICAL OR PLUMBING INFRASTRUCTURE THAT MAY BE IN THE WALLS OR CAVITY - SEE PLUMBING DRAWINGS FOR MORE INFORMATION
- 7. REMOVE EXISTING DRINKING FOUNTAINS AND ASSOCIATED PLUMBING, TYP. OF (4) FOUR LOCATIONS
- 8. CLEAN EXISTING CONC. SLAB, COORDINATE WORK WITH SLAB REPAIR AND PATCHING WORK AFTER TRENCHING TO ACCOMMODATE NEW PLUMBING. PREP FOR NEW FLOOR FINISH INCLUDING A LIGHT SANDING TO REGULARIZE EVENESS AND APPEARANCE.
- 9. REMOVE CMU WALLS AND ASSOCIATED CLIP ANGLES BACK TO EXTENTS SHOWN. COORDINATE WORK WITH AND PREP FOR NEW CMU WALLS TO BE ADDED. SEE FLOOR PLANS FOR ADDITIONAL INFORMATION.
- 10. REMOVE LINEAR PENDENT FLORESCENT FIXTURES AND PREP FOR NEW LIGHTING - SEE ELCTRICAL DRAWINGS FOR MORE INFORMATION.
- 11. REMOVE AND RELOCATE EXISTING DRAIN VALVE IN WALL TO NEW WALL SEE PLUMBING AND PLAN DRAWINGS FOR ADDITIONAL INFORMATION
- 12. REMOVE AND RELOCATE EXISTING STAND PIPE TO NEW WALL SEE PLUMBING
- 13. REMOVE EXISTING TRENCH DRAIN, PREP FOR NEW TRENCH DRAIN INSTALLATION AND PATCH AND REPAIR CONCRETE. MATCH CONCRETE FINISH IN
- CONCOURSE.

14. REMOVE EXISTING CONCRETE FOR NEW TRENCH DRAIN - SE PLAN AND

PLUMBING DRAWING FOR EXTENTS AND MORE INFORMATION

15. PATCH REPAIR EXISTING CMU AND PREP FOR NEW PAINT

AND PLAN DRAWINGS FOR ADDITIONAL INFORMATION

- 16. REMOVE AND RELOCATE FIRE ALARM SEE FIRE ALARM DRAWINGS FOR MORE
- 17. REMOVE EXISTING RECESSED LIGHTING AND GYPSUM SOFFIT TO THE EXTENTS BETWEEN EXISTING CONCRETE BEAMS. EXISTING LG FRAMING TO REMAIN AND BE PREPPED FOR NEW FINISH.





# **SPECIFIC DEMOLITION NOTES, Women's 104**

- . REMOVE LAVATORY FIXTURE AND ASSOCIATED PLUMBING SEE PLUMBING DRAWINGS FOR ADDITIONAL INFORMATION
- 2. REMOVE TOILET FIXTURES AN ASSOCIATED PLUMBING SEE PLUMBING
- DRAWINGS FOR ADDITIONAL INFORMATION 3. REMOVE MISCELLANEOUS RESTROOM ACCESORIES AND PATCH EXISTING
- WALLS IF SCHEDULED TO REMAIN 4. REMOVE EXISTING HM DOOR AND FRAME
- 5. REMOVE EXISTING PARTITIONS AND ASSOCIATED ACCESSORIES. PATCH FASTENER HOLES IN WALLS AND FLOORS AS REQUIRED
- 5. REMOVE CMU WALL AND PREP AREA FOR NEW WALL AND PLUMBING FIXTURES TAKING CARE NOT TO DAMAGE EXISTING ELECTRICAL OR PLUMBING INFRASTRUCTURE THAT MAY BE IN THE WALLS OR CAVITY - SEE PLUMBING DRAWINGS FOR MORE INFORMATION
- 7. REMOVE EXISTING DRINKING FOUNTAINS AND ASSOCIATED PLUMBING, TYP. OF (4) FOUR LOCATIONS
- 8. CLEAN EXISTING CONC. SLAB, COORDINATE WORK WITH SLAB REPAIR AND PATCHING WORK AFTER TRENCHING TO ACCOMMODATE NEW PLUMBING. PREP FOR NEW FLOOR FINISH INCLUDING A LIGHT SANDING TO REGULARIZE EVENESS AND APPEARANCE.
- 9. REMOVE CMU WALLS AND ASSOCIATED CLIP ANGLES BACK TO EXTENTS SHOWN. COORDINATE WORK WITH AND PREP FOR NEW CMU WALLS TO BE ADDED. SEE FLOOR PLANS FOR ADDITIONAL INFORMATION.
- 10. REMOVE LINEAR PENDENT FLORESCENT FIXTURES AND PREP FOR NEW
- LIGHTING SEE ELECTRICAL DRAWINGS FOR MORE INFORMATION. 11. REMOVE AND RELOCATE EXISTING DRAIN VALVE IN WALL TO NEW WALL - SEE
- PLUMBING AND PLAN DRAWINGS FOR ADDITIONAL INFORMATION 12. REMOVE AND RELOCATE EXISTING STAND PIPE TO NEW WALL - SEE PLUMBING
- AND PLAN DRAWINGS FOR ADDITIONAL INFORMATION
- 13. REMOVE EXISTING TRENCH DRAIN, PREP FOR NEW TRENCH DRAIN INSTALLATION AND PATCH AND REPAIR CONCRETE. MATCH CONCRETE FINISH IN
- 14. REMOVE EXISTING CONCRETE FOR NEW TRENCH DRAIN SE PLAN AND PLUMBING DRAWING FOR EXTENTS AND MORE INFORMATION
- 15. PATCH AND REPAIR EXISTING CMU AND PREP FOR NEW PAINT
- 16. REMOVE AND RELOCATE FIRE ALARM SEE FIRE ALARM DRAWINGS FOR MORE
- 17. REMOVE EXISTING RECESSED LIGHTING AND GYPSUM SOFFIT TO THE EXTENTS BETWEEN EXISTING CONCRETE BEAMS. EXISTING LG FRAMING TO REMAIN AND BE PREPPED FOR NEW FINISH.



## **GENERAL DEMOLITION NOTES**

THE DEMOLITION AND REMOVAL WORK SHALL BE PERFORMED AS DESCRIBED IN THE DEMOLITION DOCUMENTS. THE WORK REQUIRED SHALL BE DONE WITH CARE, AND SHALL INCLUDE ALL REQUIRED SHORING, BRACING, ETC. THE CONTRACTOR SHALL BE RESPONSIBLE FOR ANY DAMAGE, WHICH MAY BE CAUSED BY DEMOLITION AND REMOVAL WORK TO ANY PART OR PARTS OF EXISTING STRUCTURES OR ITEMS DESIGNATED FOR REUSE OR TO REMAIN. PRIOR TO COMMENCEMENT OF WORK, THE CONTRACTOR SHALL PROVIDE A DETAILED DESCRIPTION OF METHODS AND EQUIPMENT TO BE USED FOR EACH OPERATION AND THE SEQUENCE THEREOF FOR REVIEW BY THE ARCHITECT.

### INVESTIGATION

THE CONTRACTOR SHALL MAKE SUCH INVESTIGATIONS, EXPLORATIONS AND PROBES AS ARE NECESSARY TO ASCERTAIN ANY REQUIRED PROTECTIVE MEASURES BEFORE PROCEEDING WITH DEMOLITION AND REMOVAL. THE CONTRACTOR SHALL GIVE PARTICULAR ATTENTION TO SHORING AND BRACING REQUIREMENTS SO AS TO PREVENT ANY DAMAGE TO NEW OR EXISTING

### **HAZARDOUS MATERIAL**

DEEMED HAZARDOUS, THE OWNER WILL FURTHER ARRANGE ABATEMENT OF THE MATERIAL. UNLESS NOTED OTHERWISE, LEAD-BASED PAINTS WILL NOT BE ABATED. MATERIAL DISPOSAL/SALVAGE

ALL DEBRIS RESULTING FROM THE DEMOLITION AND REMOVAL WORK SHALL BE REMOVED AND DISPOSED OF BY THE CONTRACTOR UNLESS NOTED OTHERWISE. MATERIAL DESIGNATED BY THE ARCHITECT OR ENGINEER TO BE SALVAGED SHALL BE STORED ON THE CONSTRUCTION SITE AS DIRECTED. A PRE-DEMOLITION WALKTHROUGH WITH THE ARCHITECT AND OWNER SHALL BE

THE CONTRACTOR MAY ENCOUNTER HAZARDOUS MATERIAL INCLUDING, BUT NOT LIMITED TO, LEAD-BASED PAINT. ALL HAZARDOUS MATERIALS SHALL BE ADDRESSED IN ACCORDANCE WITH OSHA

AND NCDEQ REQUIREMENTS. ANY QUESTIONABLE MATERIALS SHALL BE IMMEDIATELY REPORTED TO THE ARCHITECT. THE OWNER WILL MAKE ARRANGEMENTS TO SAMPLE AND TEST MATERIALS. IF

## CONDUCTED TO IDENTIFY COMPONENTS THAT ARE TO BE SALVAGED. RECYCLING AND/OR DISPOSAL IS TO BE CONDUCTED IN ACCORDANCE WITH LEED REQUIREMENTS. **EXISTING STRUCTURES**

WHERE PORTIONS OF THE EXISTING STRUCTURE TO REMAIN ARE TO BE IMPACTED. DEMOLISH THE PORTIONS TO BE REMOVED. REPAIR DAMAGE, AND LEAVE THE STRUCTURE IN PROPER CONDITION. FOR THE INTENDED USE. REMOVE CONCRETE AND MASONRY TO THE LINES DESIGNATED BY DRILLING, CHIPPING, OR OTHER SUITABLE METHODS UNLESS DIRECTED OTHERWISE BY ARCHITECT. LEAVE THE RESULTING SURFACES REASONABLY TRUE AND EVEN, WITH SHARP STRAIGHT CORNERS THAT WILL RESULT IN NEAT JOINTS WITH NEW CONSTRUCTION AND BE SATISFACTORY FOR THE PURPOSE INTENDED. WHERE ALTERATIONS OCCUR, OR NEW AND OLD WORK ARE TO JOIN, THE CONTRACTOR SHALL CUT, REMOVE, PLUG, REPAIR OR REMOVE THE ADJACENT MATERIALS TO THE EXTENT REQUIRED BY THE CONSTRUCTION CONDITIONS, SO AS TO LEAVE THE ALTERED WORK IN AS GOOD A CONDITION AS PRACTICAL.

### TEMPORARY PROTECTION

THE CONTRACTOR SHALL PROVIDE, ERECT, AND MAINTAIN, LIGHTS, BARRIERS, WEATHER PROTECTION, WARNING SIGNS AND OTHER ITEMS AS REQUIRED FOR PROPER PROTECTION OF THE PUBLIC AS WELL AS WORKMEN ENGAGED IN DEMOLITION OPERATIONS. THE CONTRACTOR SHALL ALSO PROTECT WALLS, WINDOWS, ROOFS, AND OTHER ADJACENT EXTERIOR CONSTRUCTION THAT ARE TO REMAIN AND THAT ARE EXPOSED TO BUILDING DEMOLITION OPERATIONS. THE CONTRACTOR SHALL REMOVE TEMPORARY WORK, SUCH AS ENCLOSURES, SIGNS, GUARDS, AND THE LIKE WHEN SUCH TEMPORARY WORK IS NO LONGER REQUIRED OR WHEN DIRECTED AT THE COMPLETION OF THE WORK.

### SITE DISTURBANCE

THE CONTRACTOR SHALL NOT CLOSE OR OBSTRUCT WALKWAYS OR DRIVEWAYS AND SHALL NOT STORE OR PLACE MATERIALS IN WALKWAYS OR DRIVEWAYS OR OTHER MEANS OF EGRESS. THE CONTRACTOR SHALL CONDUCT OPERATIONS WITH MINIMAL TRAFFIC INTERFERENCE AND COORDINATE ANY ROAD CLOSURES WITH THE APPROPRIATE JURISDICTION.

### **EXISTING UTILITIES**

SHALL BE CAPPED OR PLUGGED WITH SAME MATERIAL AS EXISTING PIPING.

THE CONTRACTOR SHALL INSPECT THE EXISTING UTILITIES, INCLUDING ELECTRICAL, PLUMBING, TELE/DATA AND MECHANICAL SYSTEMS TO DETERMINE THE EXTENT OF THE WORK REQUIRED. CARE SHALL BE TAKEN TO NOT REMOVE UTILITIES THAT ARE FEEDING THE ADJACENT PROPERTIES.


A) COORDINATE DE-ENERGIZATION AND REMOVAL/DISPOSAL OF ALL INCOMING UTILITIES TO BE REMOVED WITH LOCAL UTILITY COMPANIES. SUBMIT CONFIRMATION THAT SERVICES HAVE BEEN DECOMMISSIONED IN WRITING TO THE ARCHITECT.


B) WITH THE EXCEPTION OF A PANEL TO DISTRIBUTE POWER DURING THE CONSTRUCTION PERIOD, ALL ELECTRICAL APPARATUS AND ASSOCIATED COMPONENTS THROUGHOUT THE BUILDING ARE TO BE REMOVED AND DISPOSED. ITEMS TO BE REMOVED INCLUDE, BUT ARE NOT LIMITED TO, SUBPANELS, CONDUIT, TELE/DATA, WIRING, BOXES, RECEPTACLES, FIXTURES, SWITCHES, SUPPORTS, MISCELLANEOUS DEVICES, ETC. LIGHTING LAMP COMPONENTS AND BALLASTS, AS WELL AS ELECTRONIC EQUIPMENT CONTAINING HAZARDOUS MATERIALS SUCH AS MERCURY, LEAD AND PCBS (POLYCHLORINATED BIPHENYL) SHALL BE PROPERLY HANDLED, PROTECTED, STORED AND DISPOSED OF IN ACCORDANCE WITH ALL ENVIRONMENTAL, SAFETY, AND GOVERNMENTAL REGULATIONS

C) IN THE EVENT THAT IT IS PRESENT, REMOVE EXISTING GAS PIPING, REGULATORS, ETC. THROUGHOUT THE WORK AREA. COORDINATE WORK WITH LOCAL GAS UTILITY COMPANY. GAS PIPING TO BE ABANDONED IN PLACE SHALL BE PURGED THEN CAPPED AND SEALED WITH SAME MATERIALS AS EXISTING PIPING.

D) REMOVE EXISTING ABANDONED DOMESTIC WATER PIPING, VALVES, ETC. THROUGHOUT THE WORK AREA. CAP INCOMING SERVICE WHERE APPLICABLE (OTHERWISE, SERVICES TO BE REMOVIED IN ACCORDANCE WITH PLUMBING DRAWINGS) AND PREP FOR NEW WORK, COORDINATE WORK WITH LOCAL AUTHORITIES AS REQUIRED. E) REMOVE ALL EXISTING ABANDONED SANITARY SEWER PIPING THROUGHOUT THE WORK AREA. COORDINATE WORK WITH LOCAL AUTHORITIES. SANITARY SEWER PIPING ABANDONED IN PLACE

F) ANY FEES AND/OR PERMITS REQUIRED BY LOCAL UTILITIES AND LOCAL JURISDICTION ASSOCIATED WITH REMOVAL OF EXISTING EQUIPMENT, PIPING, METERS, ETC. BY THE CONTRACTOR SHALL BE THE RESPONSIBILITY OF THE CONTRACTOR.

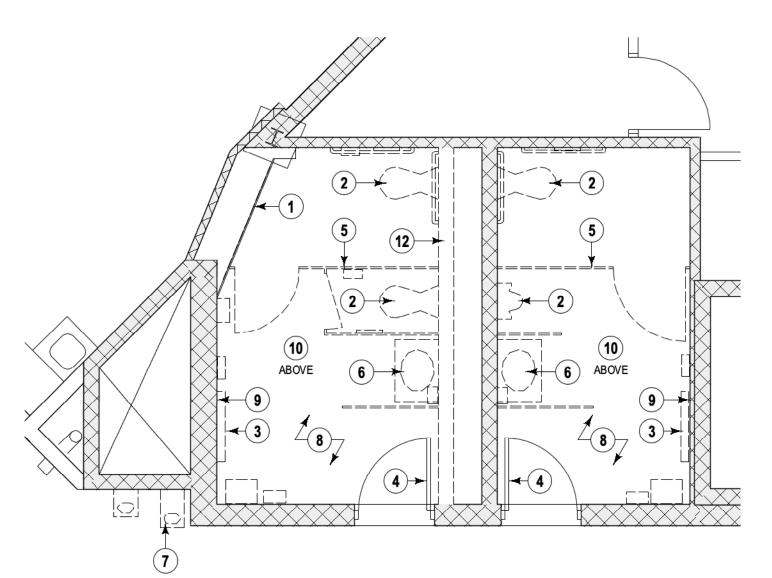

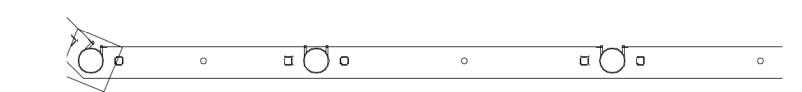

# SPECIFIC DEMOLITION NOTES, Upper Restrooms 201/202

- REMOVE WALL FINISHES TO EXTENTS SHOWN WITHIN ADA STALL TO DETERMINE FEASIBILITY OF ENLARGING SPACE AS SHOWN ON PLANS -PHOTO DOCUMENT CONDITION AND COORD, WARCHITECT AFTER EXPLORATORY DEMOLITION IS COMPLETE TO DETERMINE FINAL RESTROOM CONFIGURATION.
- 2. REMOVE TOILET / URINAL FIXTURES AN ASSOCIATED PLUMBING SEE PLUMBING DRAWINGS FOR ADDITIONAL INFORMATION
- 3. REMOVE MISCELLANEOUS RESTROOM ACCESORIES AND PATCH EXISTING WALLS IF SCHEDULED TO REMAIN
- 4. PREP HM DOOR AND FRAME FOR NEW PAINT ACCORDING TO MANUFACTURER'S RECOMMENDATION FOR THE SUBSTRATE
- 5. REMOVE EXISTING PARTITIONS AND ASSOCIATED ACCESSORIES. PATCH FASTENER HOLES IN WALLS AND FLOORS AS REQUIRED
- 6. REMOVE LAVATORY FIXTURE AND ASSOCIATED PLUMBING SEE
- PLUMBING DRAWINGS FOR ADDITIONAL INFORMATION 7. REMOVE EXISTING HI-LO DRINKING FOUNTAINS AND ASSOCIATED
- PLUMBING SEE PLUMBING DRAWINGS FOR MORE INFORMATION 8. REMOVE EXISTING FLOOR AND WALL TILE ALONG WITH GYPSUM WALL

FINISHES - PREP FOR NEW FINISHES THROUGHOUT RESTROOM

- REMOVE TILE AND GYPSUM WALL FINISHES BACK TO FRAMING AND PREP FOR NEW FINISHES - SEE FLOOR PLAN
- 10. REMOVE EXISTING ACT ASSOCIATED GRID AND ELECTRICAL FIXTURES. PREP FOR NEW CEILING TILES AND FIXTURES - SEE PLAN AND ELECTRICAL DRAWINGS
- 11. REMOVE AND RELOCATE FIRE ALARM SEE FIRE ALARM DRAWINGS FOR MORE INFORMATION
- 12. REMOVE CMU WALL, CLIP ANGLES AND ASSOCIATED FINISHES ON WOMEN'S RESTROOM 251G FOR CAVITY ACCESS TO PREP FOR NEW PLUMBING INSTALL. COORDINATE WORK WITH AND PREP FOR NEW WALLS AND FLOOR FINISH TO BE ADDED. SEE FLOOR PLANS FOR ADDITIONAL INFORMATION.



PROVISION STUDIO RALEIGH, NC 27604 www.provisionstudio.design

Structural Engineer: Lysaght & Associates


120 St. Mary's Street

**MEP Engineer:** HDM Associates, Inc.

106 Tarheel Court

Raleigh, NC 919.833.0495

Elizabeth City, NC 27909 252.698.3003

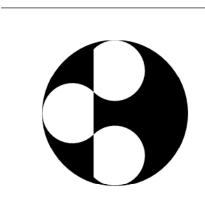





BID SET - 6/9/25

# FIVE COUNTY STADIUM ADA Phase 2


1501 NC Highway 39 Zebulon, NC 27597


PROJECT NO: PS\_56 REV DATE BY AMENDMENTS 02 25.07.11 DRC ADDENDUM 02

> ALL DIMENSIONS AND LEVELS ARE TO BE CHECKED ON SITE PRIOR TO THE COMMENCEMENT OF WORK. DRAWINGS ARE NOT TO BE SCALED. USE ONLY FIGURED DIMENSIONS.

**DEMO PLAN** Restrooms 158A, 158B, 251G & 250G

**D200** 

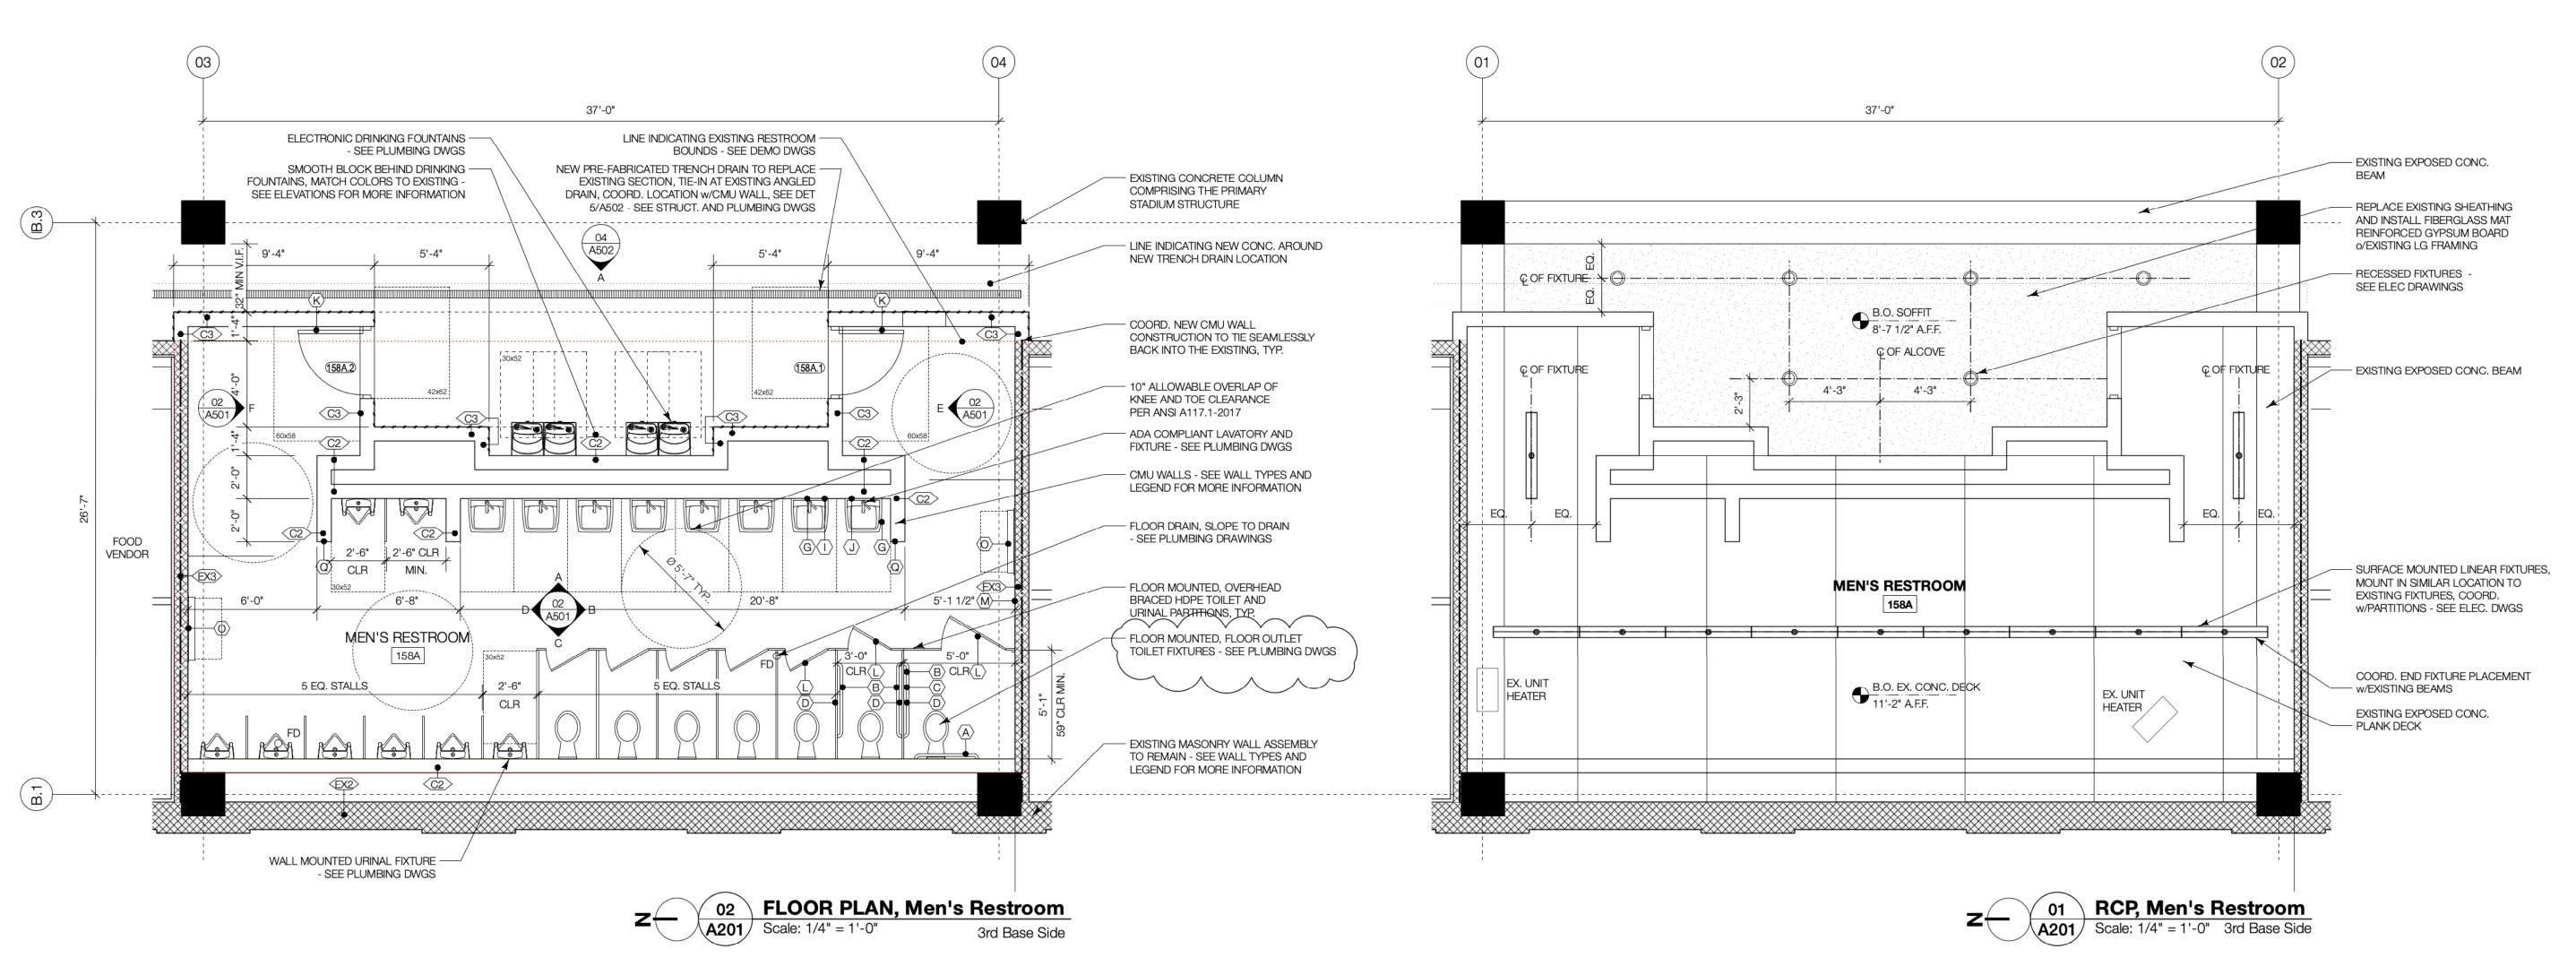

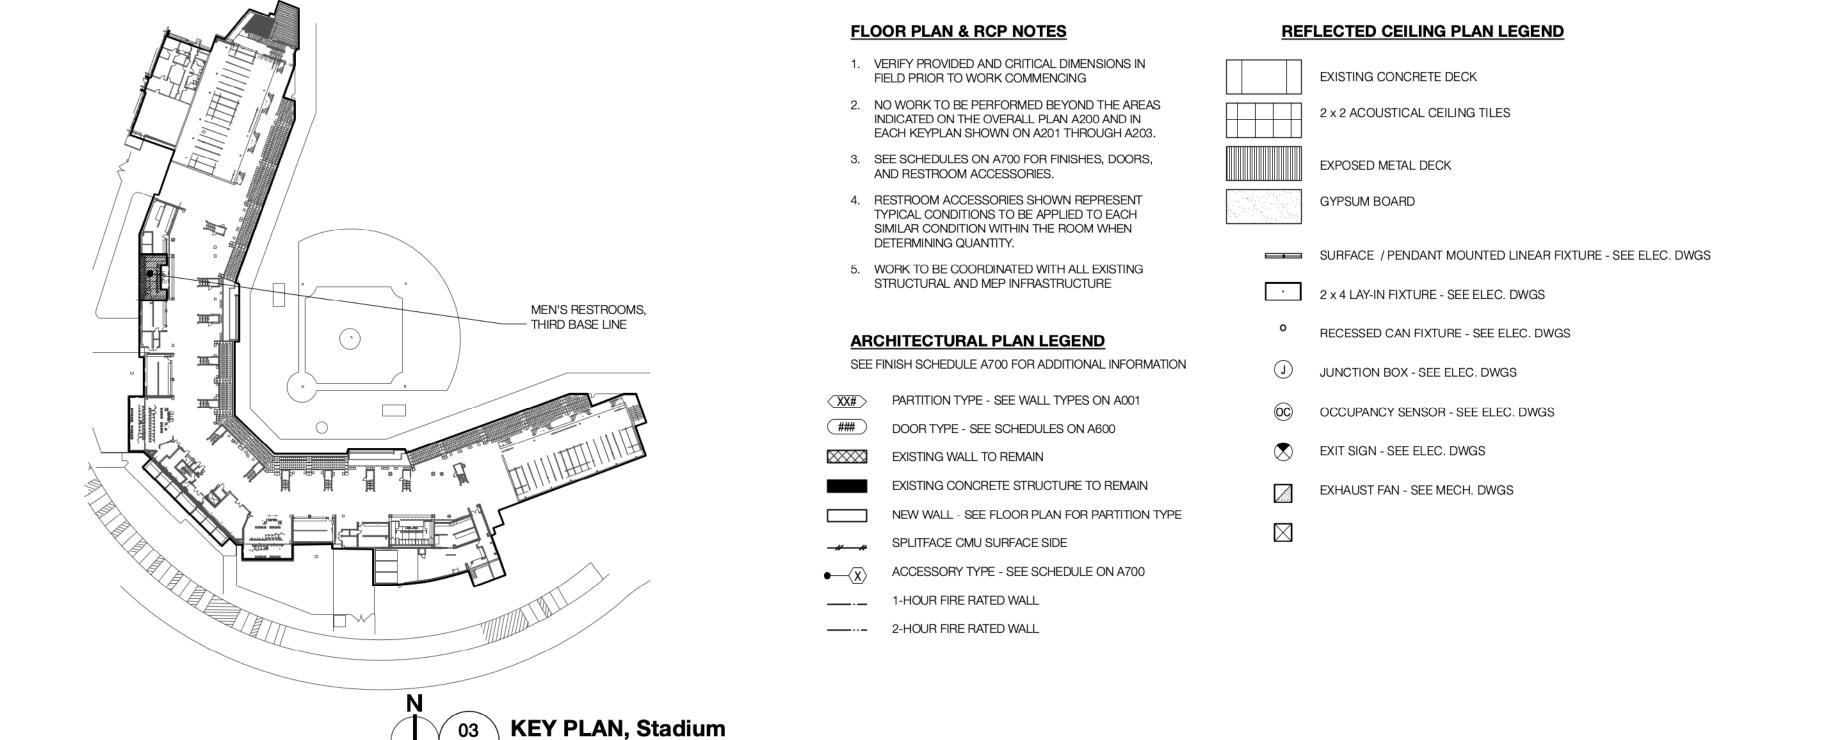


PROVISION STUDIO RALEIGH, NC 27604

www.provisionstudio.design

Structural Engineer: Lysaght & Associates 120 St. Mary's Street Raleigh, NC

919.833.0495

MEP Engineer: HDM Associates, Inc. 106 Tarheel Court Elizabeth City, NC 27909 252.698.3003

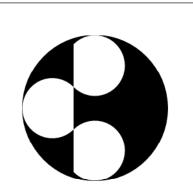





**FIVE COUNTY STADIUM** ADA Phase 2

1501 NC Highway 39 Zebulon, NC 27597

PROJECT NO: PS\_56


REV DATE BY AMENDMENTS 02 25.07.11 DRC ADDENDUM 02


> ALL DIMENSIONS AND LEVELS ARE TO BE CHECKED ON SITE PRIOR TO THE COMMENCEMENT OF WORK. DRAWINGS ARE NOT TO BE SCALED. USE ONLY FIGURED DIMENSIONS.

FLOOR PLAN & RCP 3rd Base Men's Restroom

# **A201**

DRAWN:	DC	CHECKED: DC /	J
25 Jun	e 09	PLOT DATE	

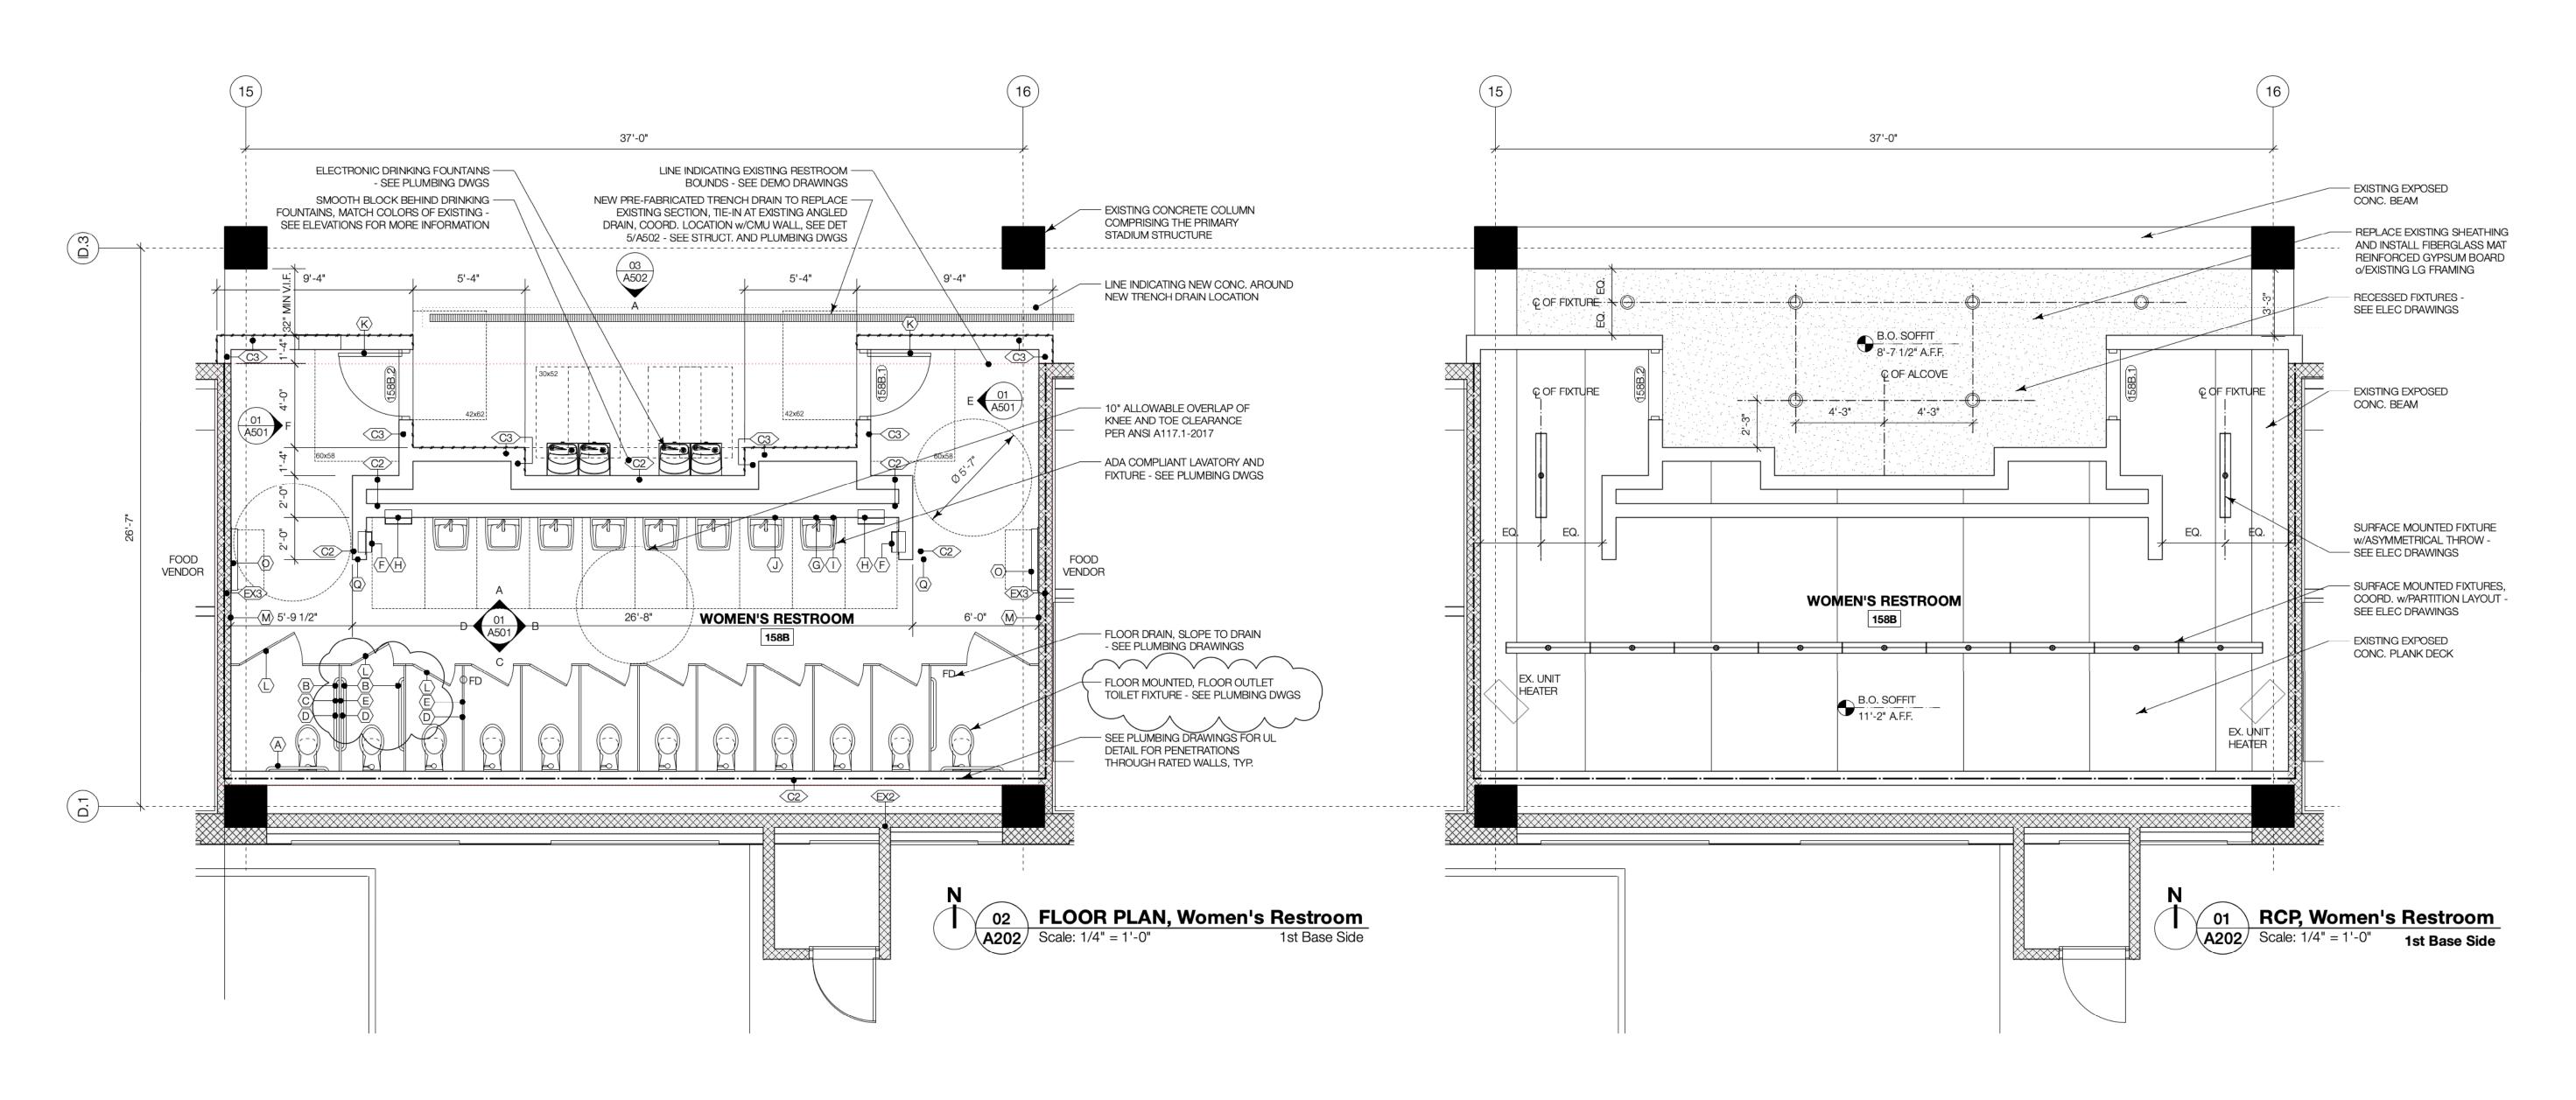

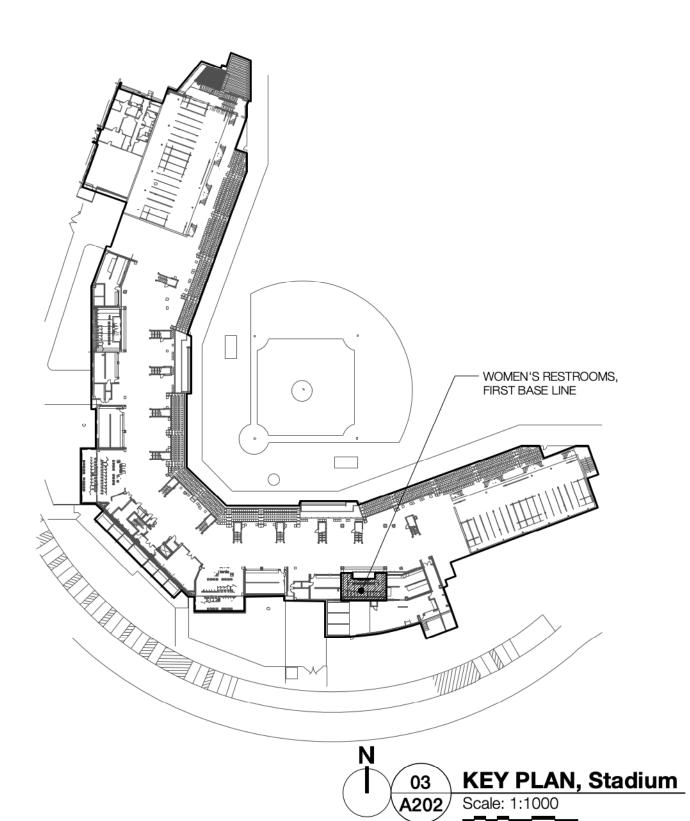

# **FLOOR PLAN & RCP NOTES**

- 1. VERIFY PROVIDED AND CRITICAL DIMENSIONS IN FIELD PRIOR TO WORK COMMENCING
- NO WORK TO BE PERFORMED BEYOND THE AREAS INDICATED ON THE OVERALL PLAN A200 AND IN EACH KEYPLAN SHOWN ON A201 THROUGH A203.
- 3. SEE SCHEDULES ON A700 FOR FINISHES, DOORS, AND RESTROOM ACCESSORIES.
- 4. RESTROOM ACCESSORIES SHOWN REPRESENT TYPICAL CONDITIONS TO BE APPLIED TO EACH SIMILAR CONDITION WITHIN THE ROOM WHEN DETERMINING QUANTITY.
- 5. WORK TO BE COORDINATED WITH ALL EXISTING STRUCTURAL AND MEP INFRASTRUCTURE

# ARCHITECTURAL PLAN LEGEND

PARTITION TYPE - SEE WALL TYPES ON A001

SEE FINISH SCHEDULE A700 FOR ADDITIONAL INFORMATION

DOOR TYPE - SEE SCHEDULES ON A600

EXISTING WALL TO REMAIN EXISTING CONCRETE STRUCTURE TO REMAIN

NEW WALL - SEE FLOOR PLAN FOR PARTITION TYPE SPLITFACE CMU SURFACE SIDE

ACCESSORY TYPE - SEE SCHEDULE ON A600 1-HOUR FIRE RATED WALL

---- 2-HOUR FIRE RATED WALL

# REFLECTED CEILING PLAN LEGEND

EXISTING CONCRETE DECK

2 x 2 ACOUSTICAL CEILING TILES

EXPOSED METAL DECK

GYPSUM BOARD

SURFACE / PENDANT MOUNTED LINEAR FIXTURE - SEE ELEC. DWGS

2 x 4 LAY-IN FIXTURE - SEE ELEC. DWGS

O RECESSED CAN FIXTURE - SEE ELEC. DWGS

JUNCTION BOX - SEE ELEC. DWGS

OC OCCUPANCY SENSOR - SEE ELEC. DWGS

EXIT SIGN - SEE ELEC. DWGS

EXHAUST FAN - SEE MECH. DWGS

**PROVISION STUDIO** RALEIGH, NC 27604


www.provisionstudio.design

Structural Engineer: Lysaght & Associates 120 St. Mary's Street Raleigh, NC

919.833.0495

252.698.3003

MEP Engineer: HDM Associates, Inc. 106 Tarheel Court Elizabeth City, NC 27909

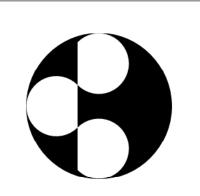






BID SET - 6/9/25

FIVE COUNTY STADIUM ADA Phase 2

1501 NC Highway 39


Zebulon, NC 27597 PROJECT NO: PS\_56

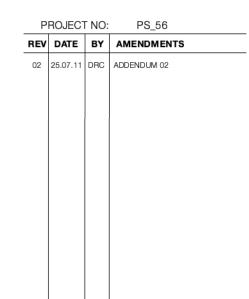



ALL DIMENSIONS AND LEVELS ARE TO BE CHECKED ON SITE PRIOR TO THE COMMENCEMENT OF WORK. DRAWINGS ARE NOT TO BE SCALED. USE ONLY FIGURED DIMENSIONS.

FLOOR PLAN & RCP 1st Base Women's Restroom

**A202** 

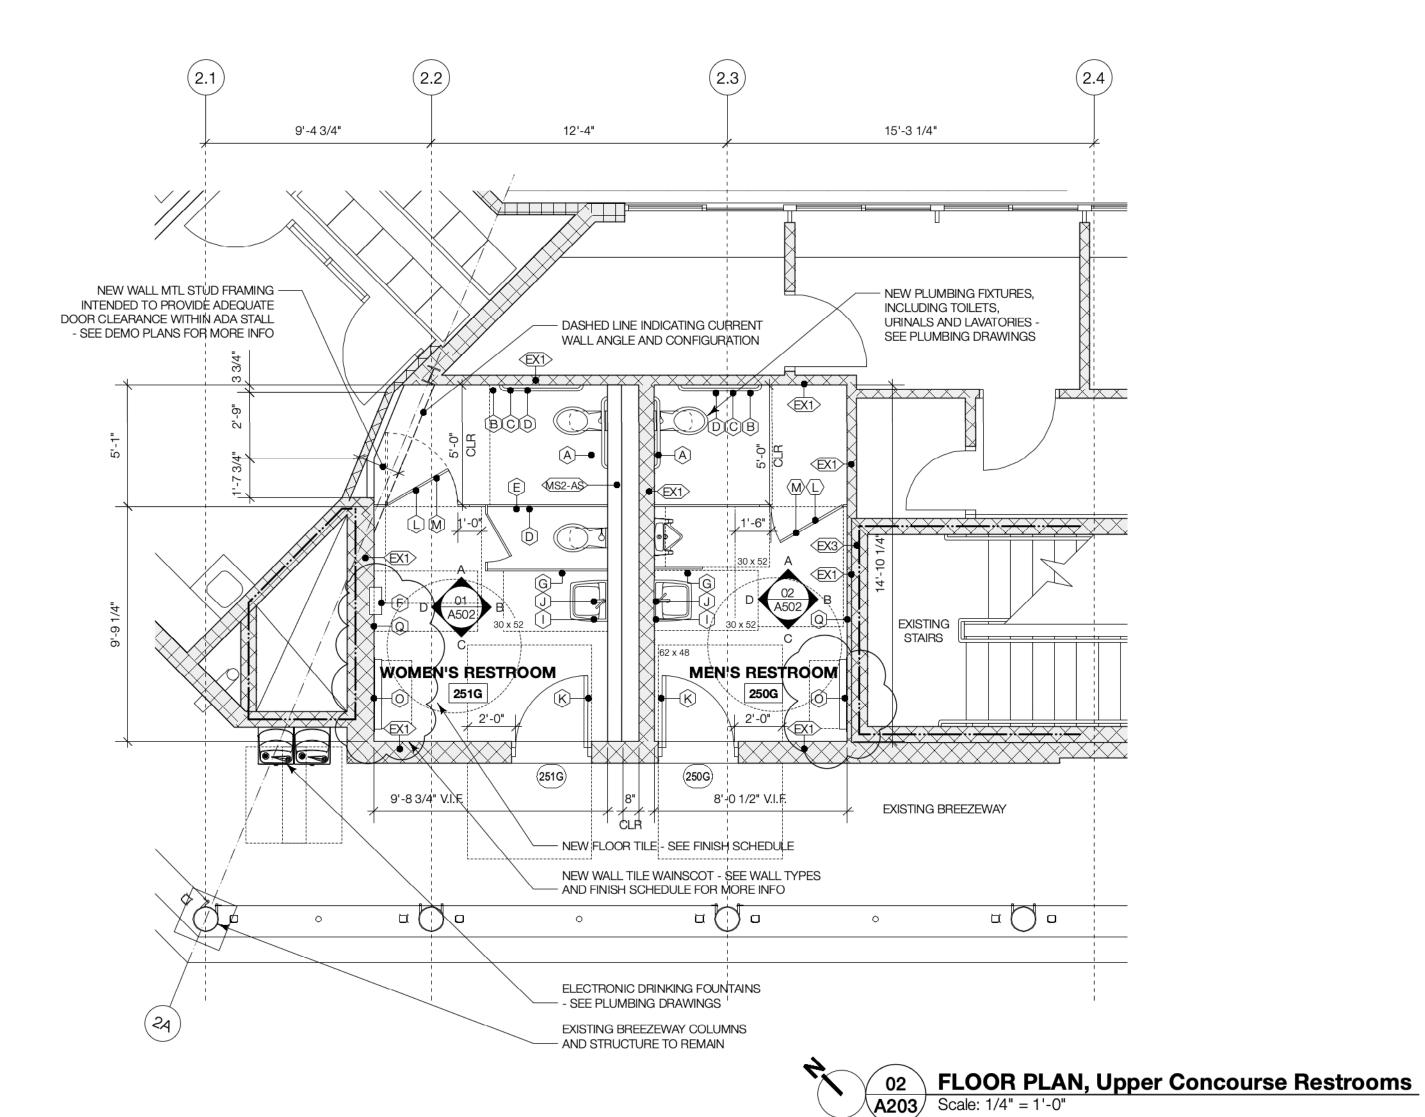

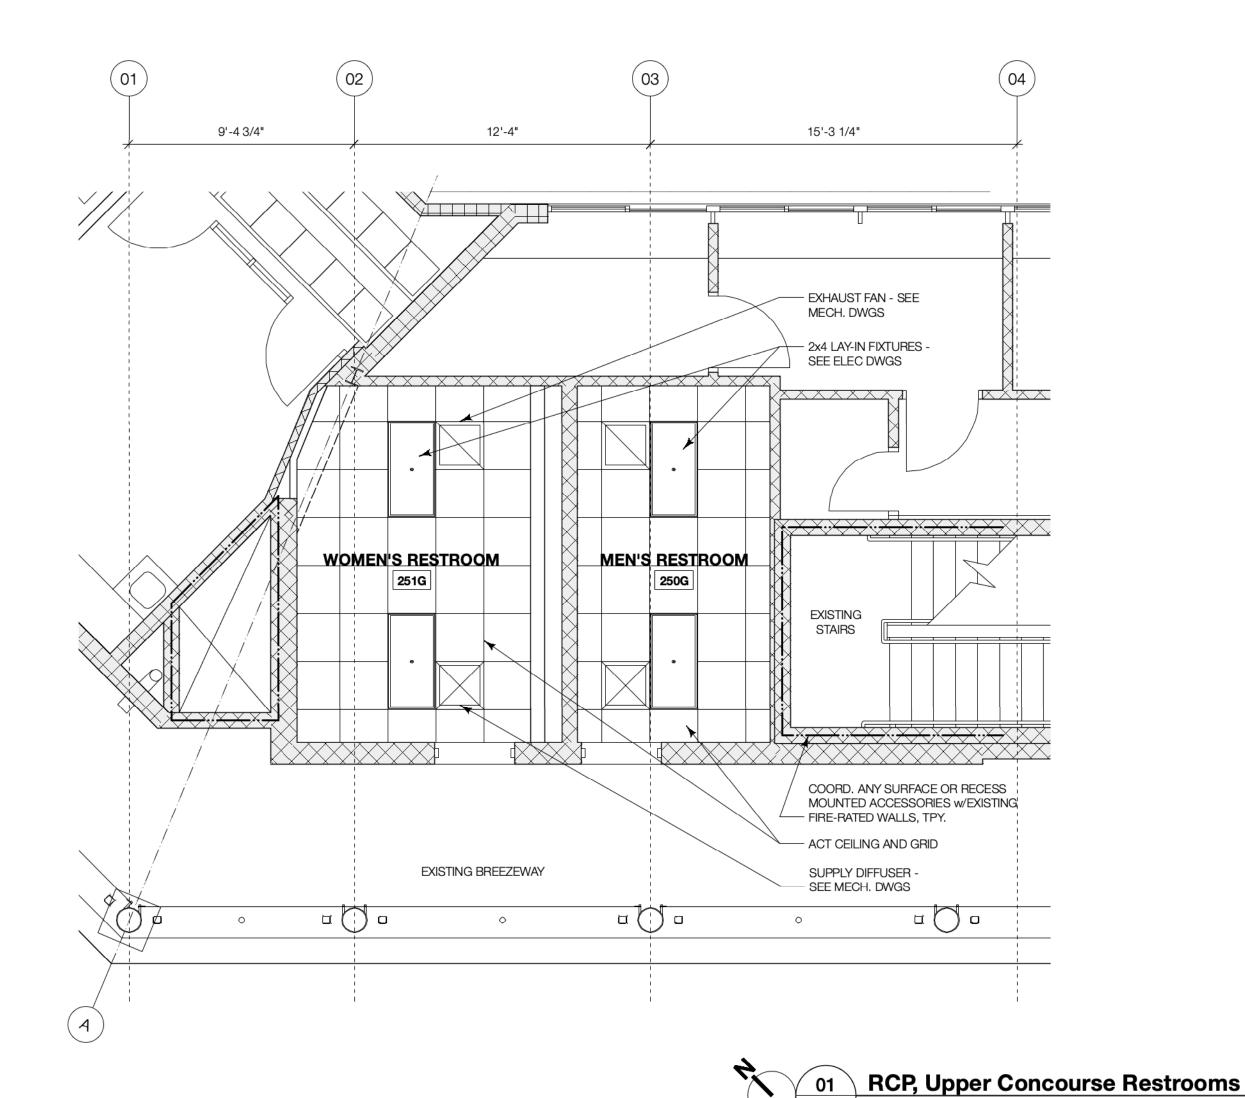

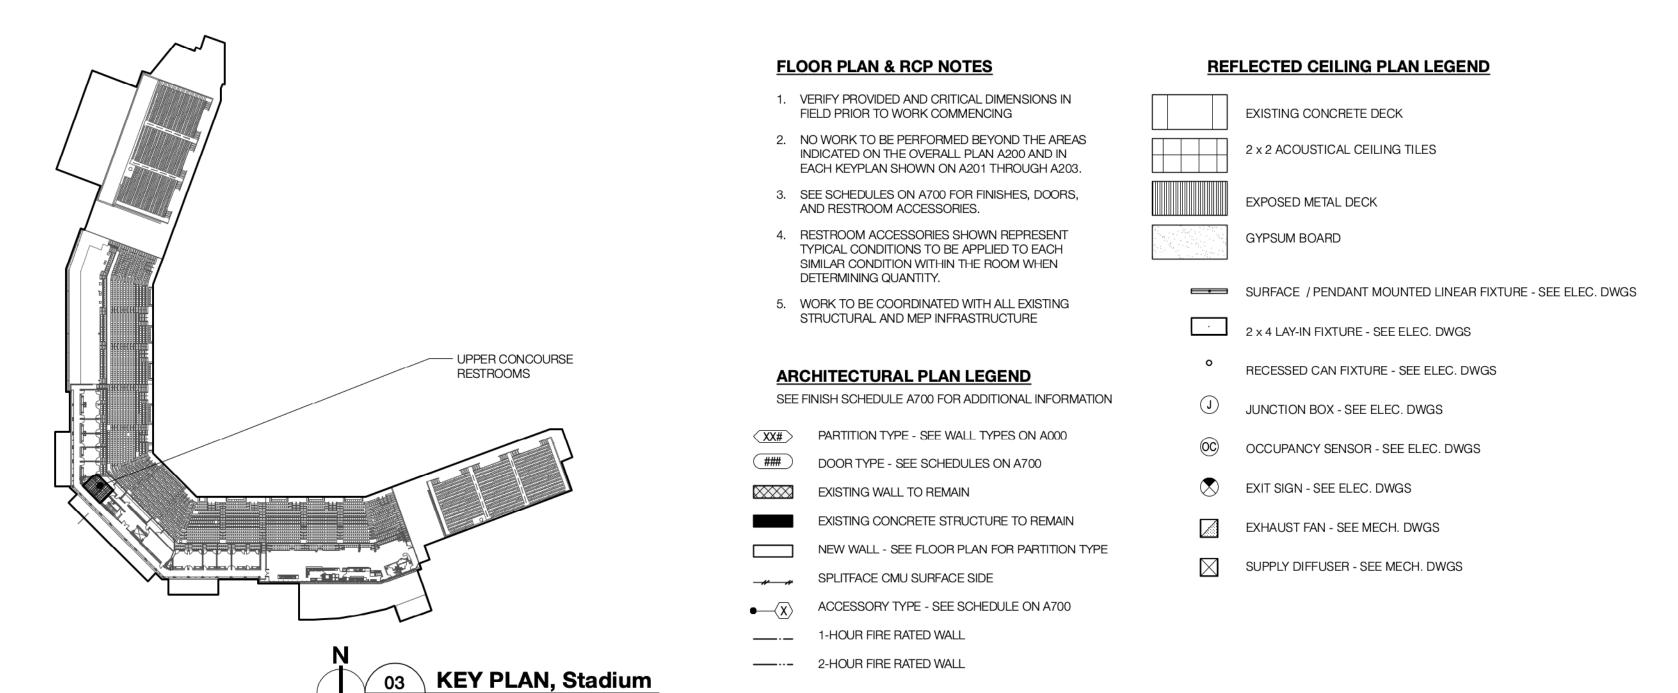

PROVISION STUDIO RALEIGH, NC 27604 www.provisionstudio.design


Structural Engineer: Lysaght & Associates 120 St. Mary's Street Raleigh, NC

919.833.0495

MEP Engineer: HDM Associates, Inc. 106 Tarheel Court Elizabeth City, NC 27909

252.698.3003



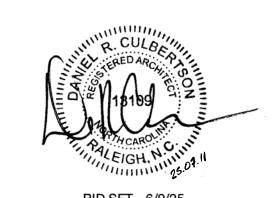

FIVE COUNTY STADIUM ADA Phase 2

1501 NC Highway 39 Zebulon, NC 27597

Р	ROJEC1	PS_56		
REV	DATE	ву	AMENDMENTS	
02	25.07.11	DRC	ADDENDUM 02	


ALL DIMENSIONS AND LEVELS ARE TO BE CHECKED ON SITE PRIOR TO THE COMMENCEMENT OF WORK. DRAWINGS ARE NOT TO BE SCALED.
USE ONLY FIGURED DIMENSIONS.

FLOOR PLAN & RCP
Upper Concourse Restrooms

A203

DRAWN: DC CHECKED: DC

25 June 09 PLOT

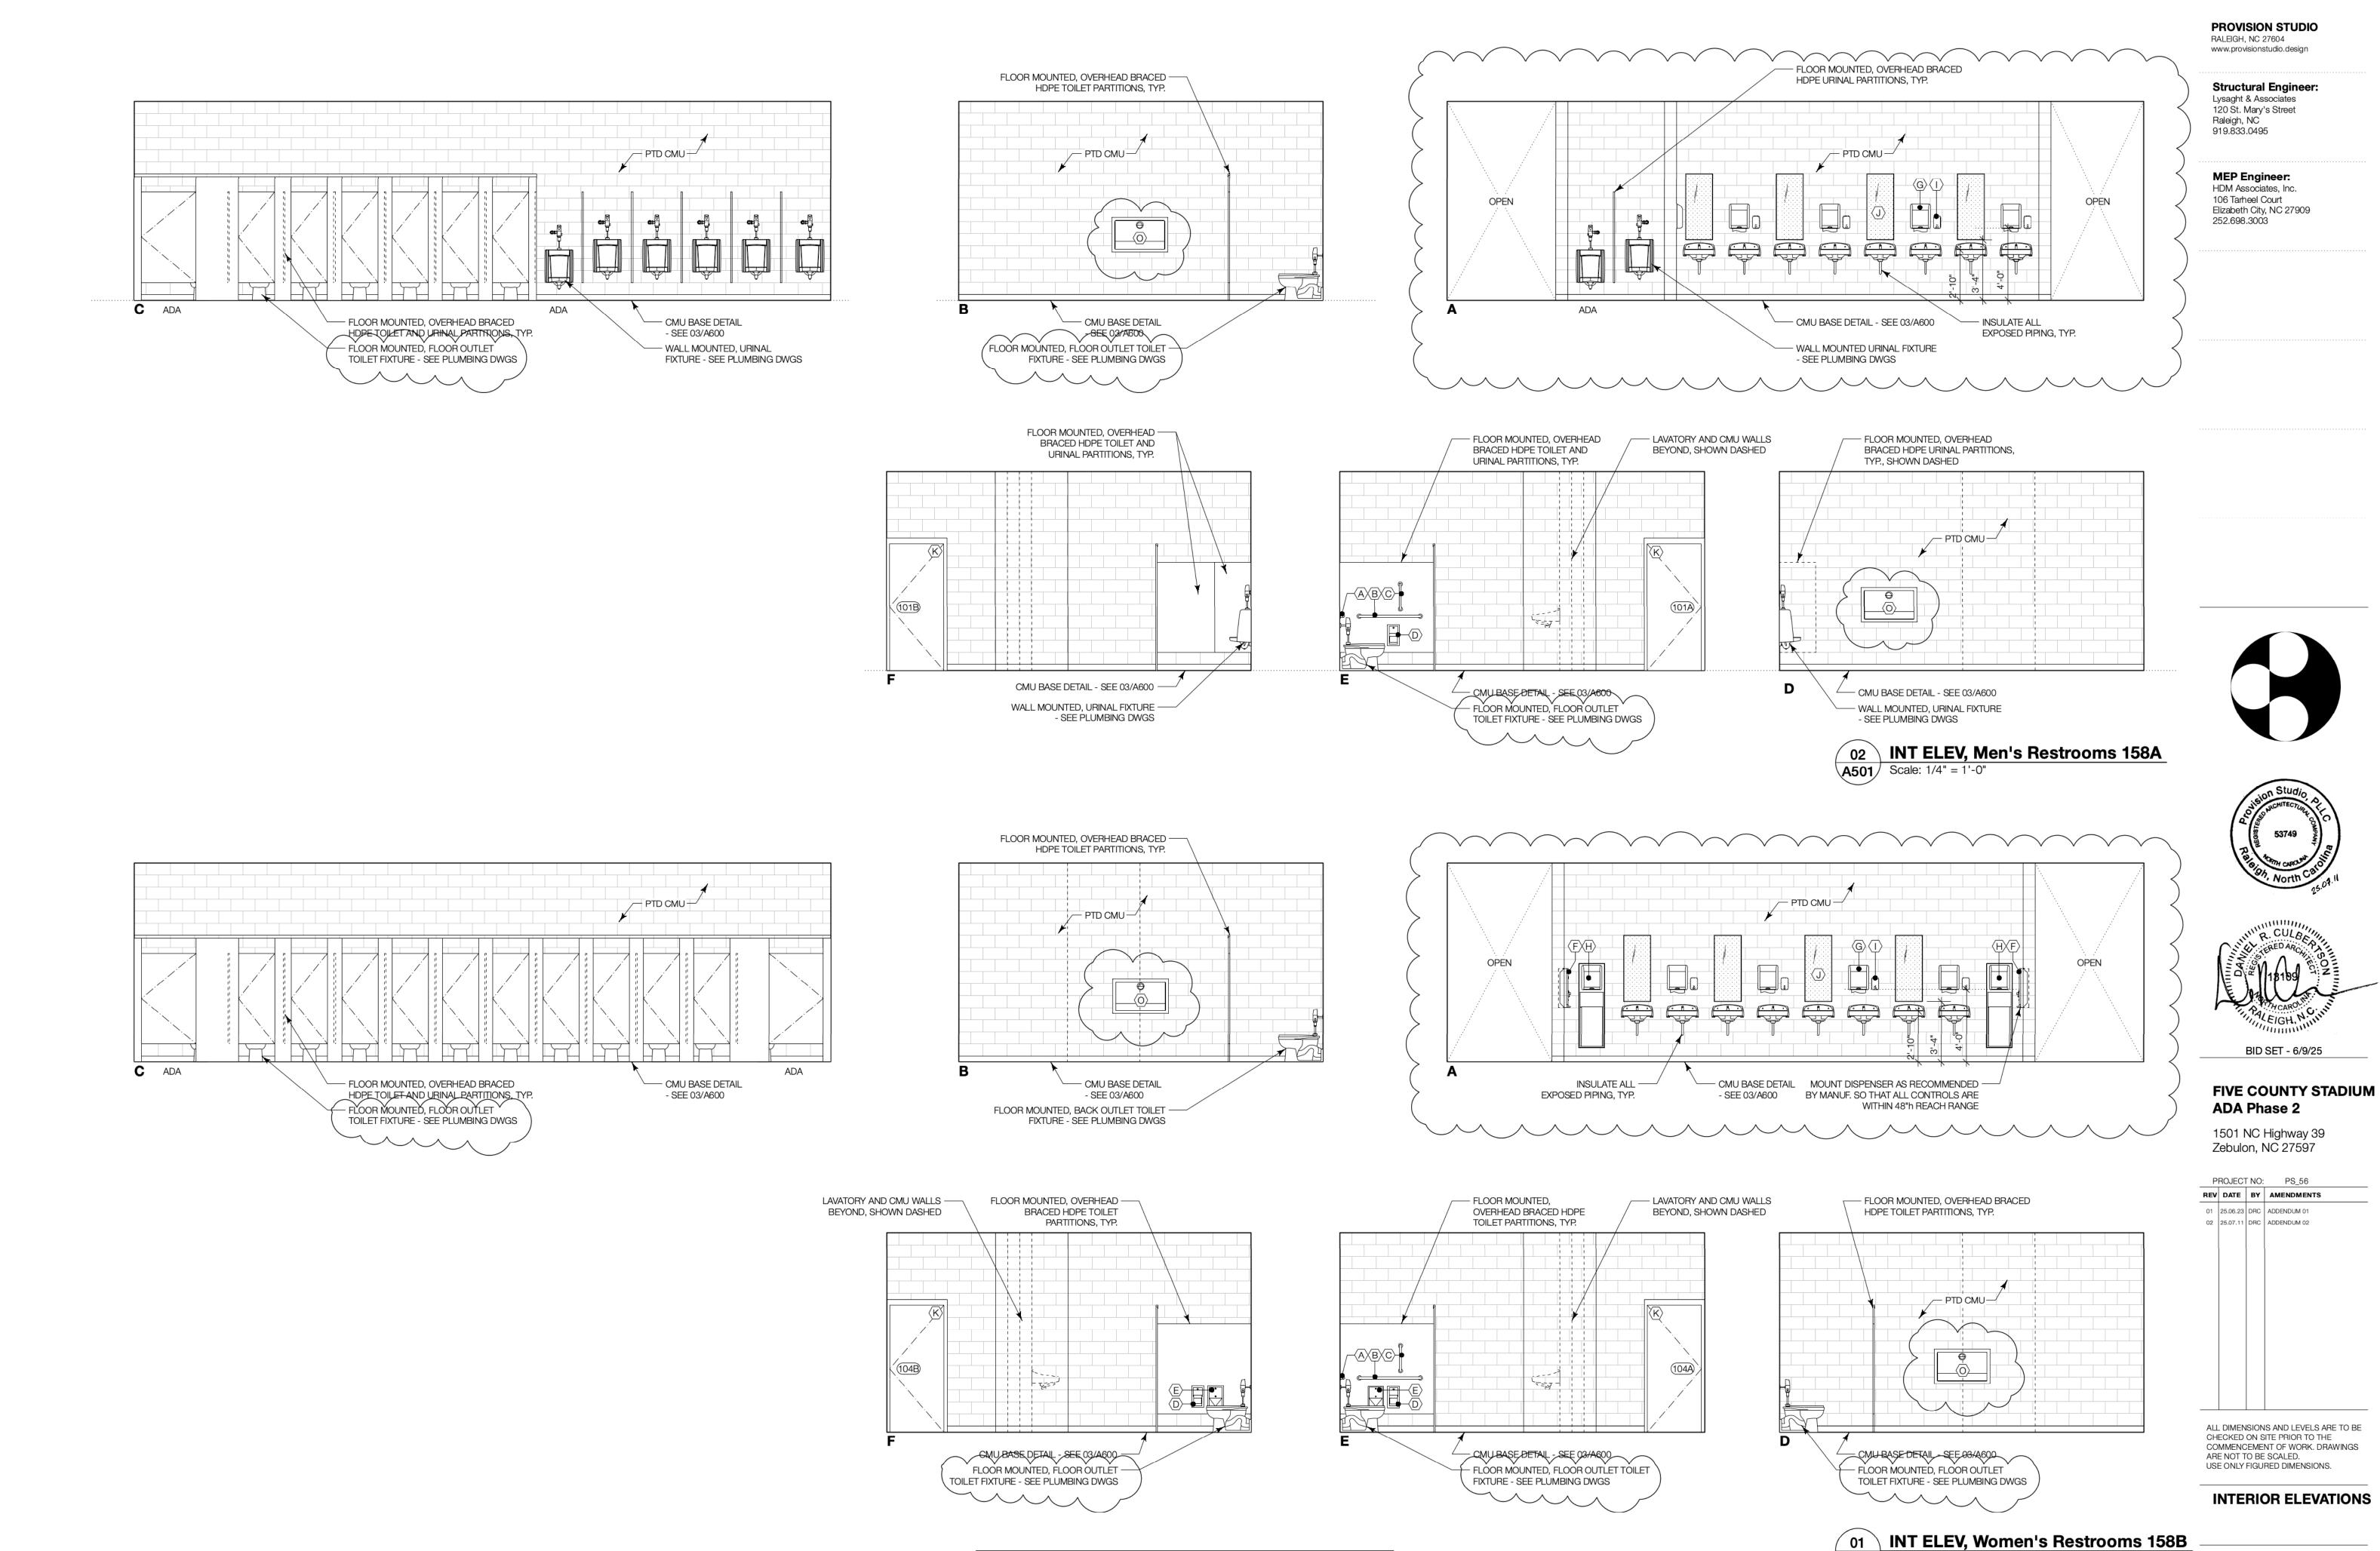


NOTE: MOUNT RESTROOM ACCESSORIES AND FIXTURES AS

HEIGHT INFORMATON CAN BE FOUND ON SHEET A001.


RECOMMENDED BY MANUFACTURER TO COMPLY WITH ADA / ANSI A117.1 AND CHAPTER 11 OF THE NCSBC. COMMON MOUNTING


**A501** 


**A501** Scale: 1/4" = 1'-0"

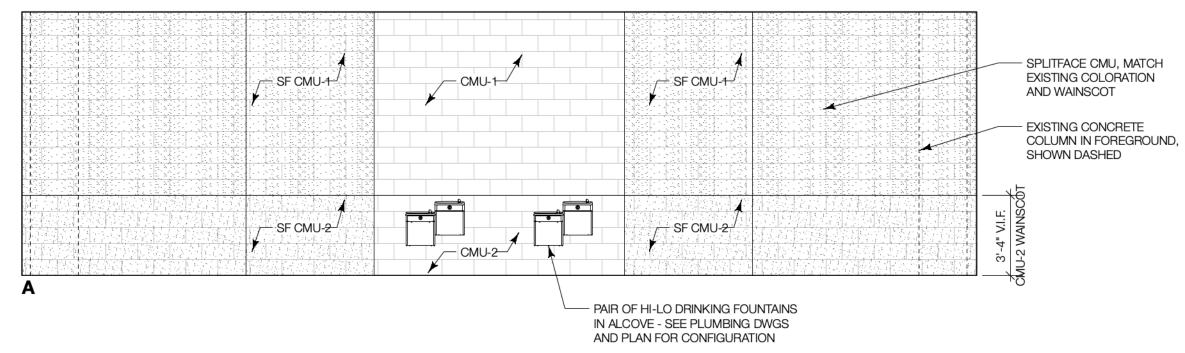





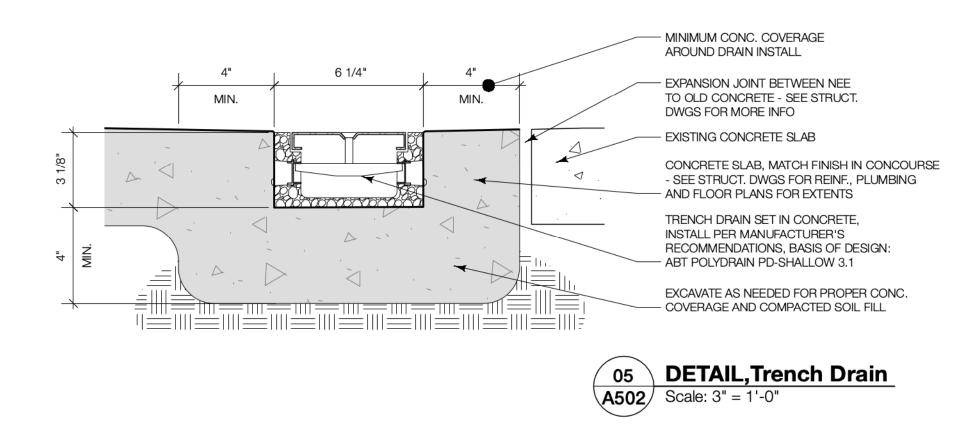

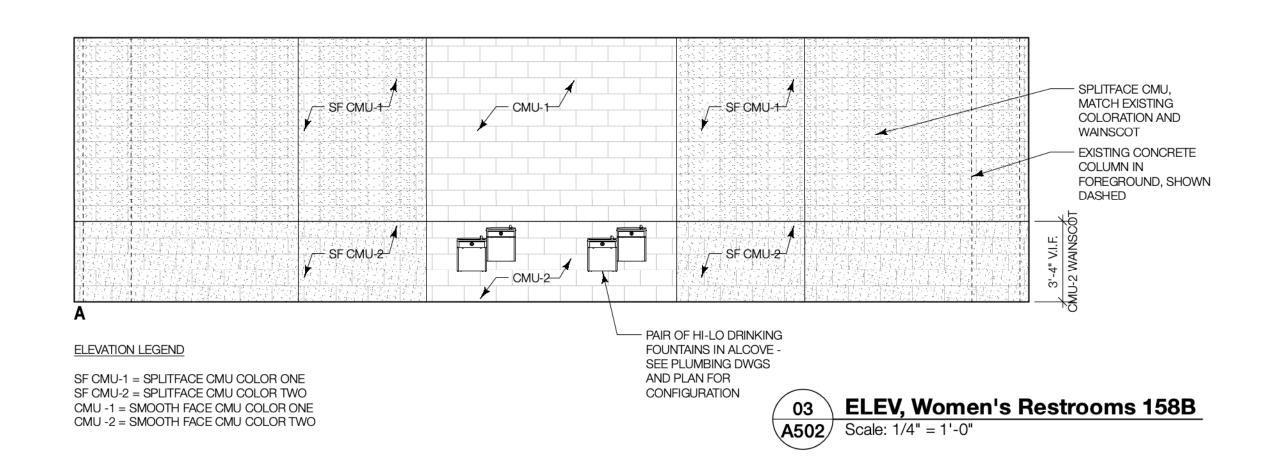


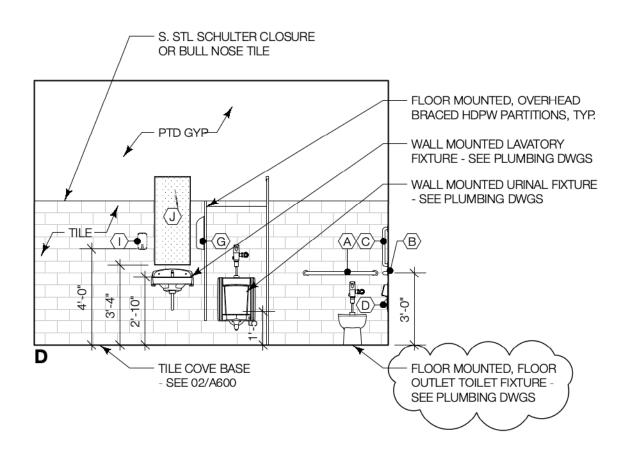


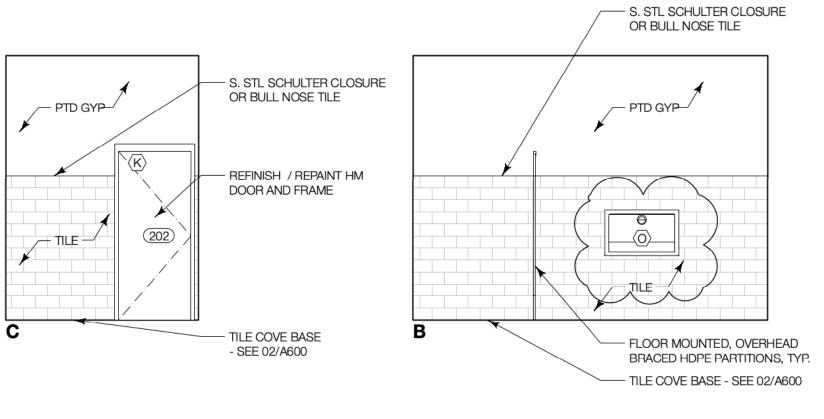


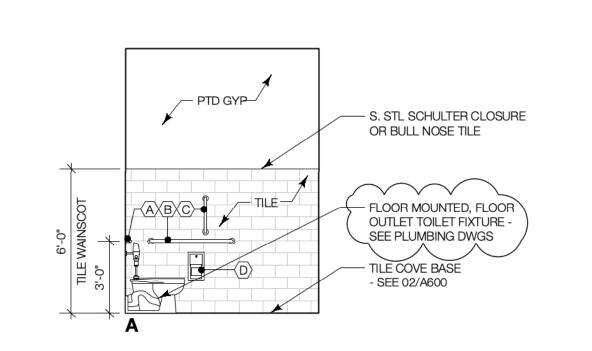



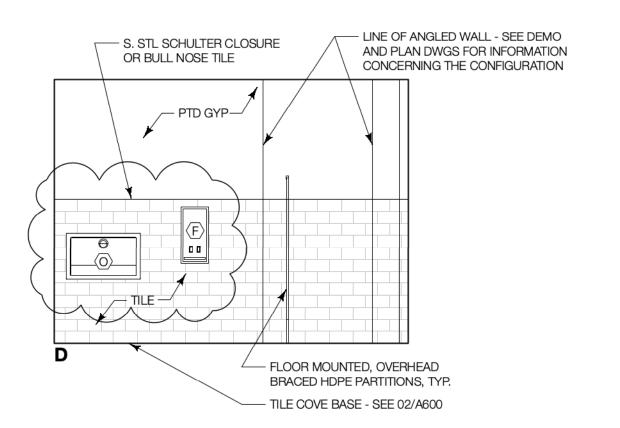

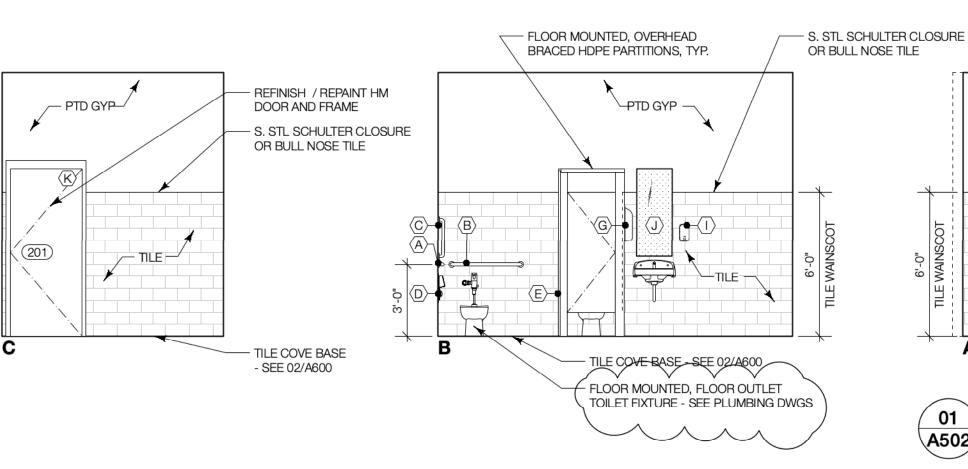

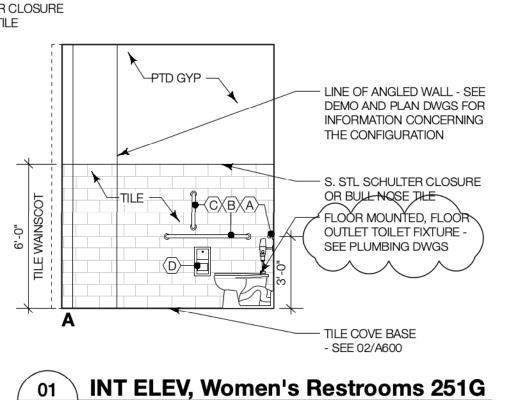

**A502** Scale: 1/4" = 1'-0"

ALL DIMENSIONS AND LEVELS ARE TO BE CHECKED ON SITE PRIOR TO THE COMMENCEMENT OF WORK. DRAWINGS ARE NOT TO BE SCALED. USE ONLY FIGURED DIMENSIONS.

**PROVISION STUDIO** RALEIGH, NC 27604 www.provisionstudio.design

Structural Engineer: Lysaght & Associates 120 St. Mary's Street Raleigh, NC

919.833.0495

MEP Engineer:

252.698.3003

HDM Associates, Inc.

106 Tarheel Court Elizabeth City, NC 27909

INTERIOR ELEVATIONS

BID SET - 6/9/25

ADA Phase 2

1501 NC Highway 39 Zebulon, NC 27597

PROJECT NO: PS\_56


REV DATE BY AMENDMENTS

01 25.06.23 DRC ADDENDUM 01 02 25.07.11 DRC ADDENDUM 02


FIVE COUNTY STADIUM

**A502** 


CHECKED: DC / JZ DRAWN: DC

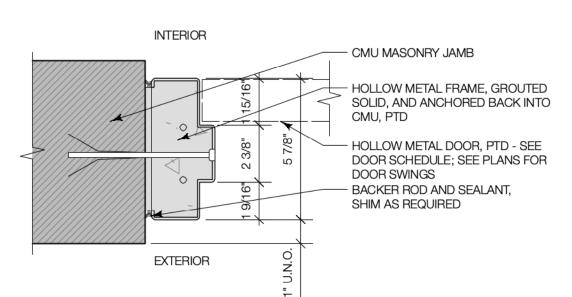


**JAMB DETAIL, HM Door A600**/ Scale: 3" = 1'-0"

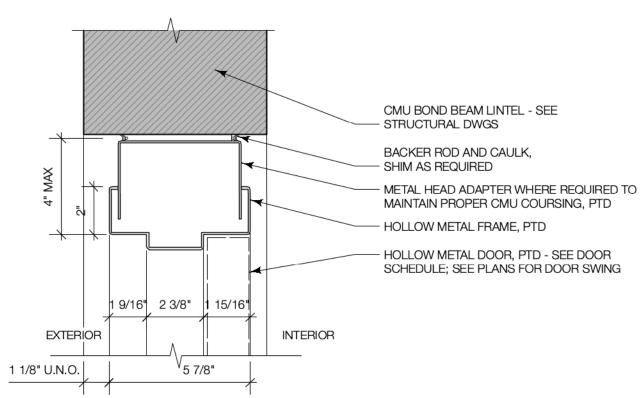


**HEAD DETAIL, HM Door** 

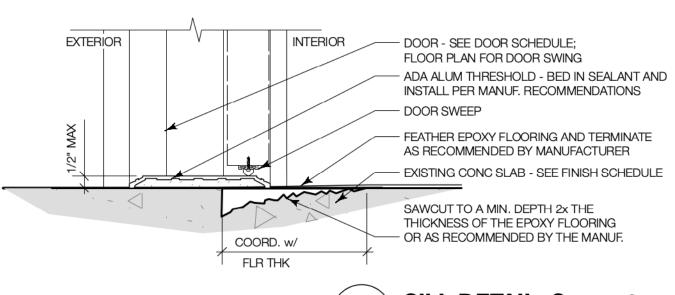



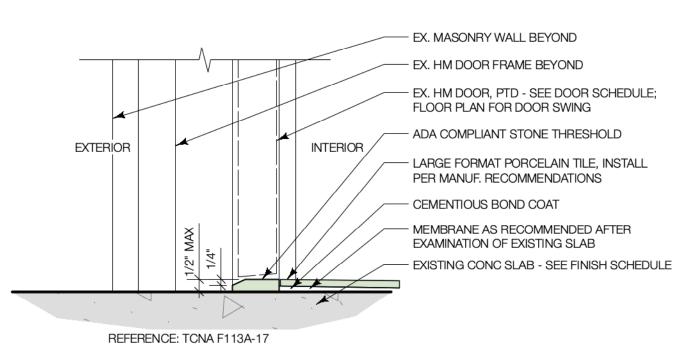

SILL DETAIL, Tile **A600** Scale: 3" = 1'-0"

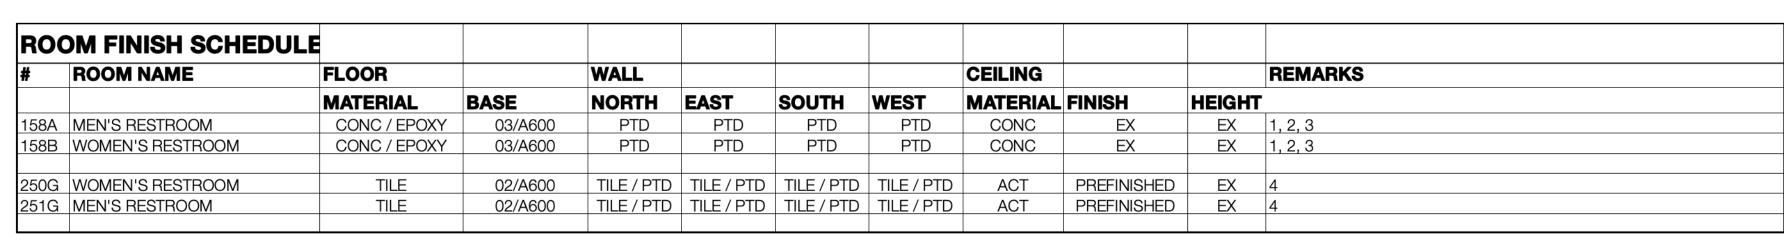


### **FINISH NOTES**


1. PAINT FINISH COLORS TO BE SELECTED BY OWNER - SEE SPECIFICATIONS FOR MORE INFORMATION

2. LIGHT GRIND CONCRETE TO REGULARIZE EVENESS FINISH WITH EPOXY BROADCAST SYSTEM AND URETHANE SEALCOAT - SEE SPECIFICATIONS FOR MORE INFORMATION 3. DECK AND EXPOSED STEEL FRAMING AT RESTROOM CEILING TO BE PAINTED


4. FINISH PER TCNA STANDARDS FOR CERAMIC TILE FLOOR / WAINSCOT

DOO	R SCHEDULE											
#	LOCATION	DOOR				FRAME						REMARKS
		SIZE	MATERIAL	TYPE	FINISH	MATERIAL	TYPE	FINISH	SILL	HEAD	JAMB	
158A.1	MEN'S RESTROOM 158A	3'-0" x 7'-0" x 1-3/4"	НМ	D1A	PTD	НМ	F1A	PTD	06/A600	07/A600	08/A600	
158A.2	MEN'S RESTROOM 158A	3'-0" x 7'-0" x 1-3/4"	НМ	D1A	PTD	HM	F1A	PTD	06/A600	07/A600	08/A600	
158B.1	WOMEN'S RESTROOM 158B	3'-0" x 7'-0" x 1-3/4"	НМ	D1A	PTD	HM	F1A	PTD	06/A600	07/A600	08/A600	
158B.2	WOMEN'S RESTROOM 158B	3'-0" x 7'-0" x 1-3/4"	HM	D1A	PTD	HM	F1A	PTD	06/A600	07/A600	08/A600	
251G	WOMEN'S RESTROOM 251G	EX	EX	НМ	PTD	HM	F1A	PTD	05/A600	EX	EX	REPAINT EXISTING HM DOOR
250G	MEN'S RESTROOM 250G	EX	EX	НМ	PTD	НМ	F1A	PTD	05/A600	EX	EX	REPAINT EXISTING HM DOOR

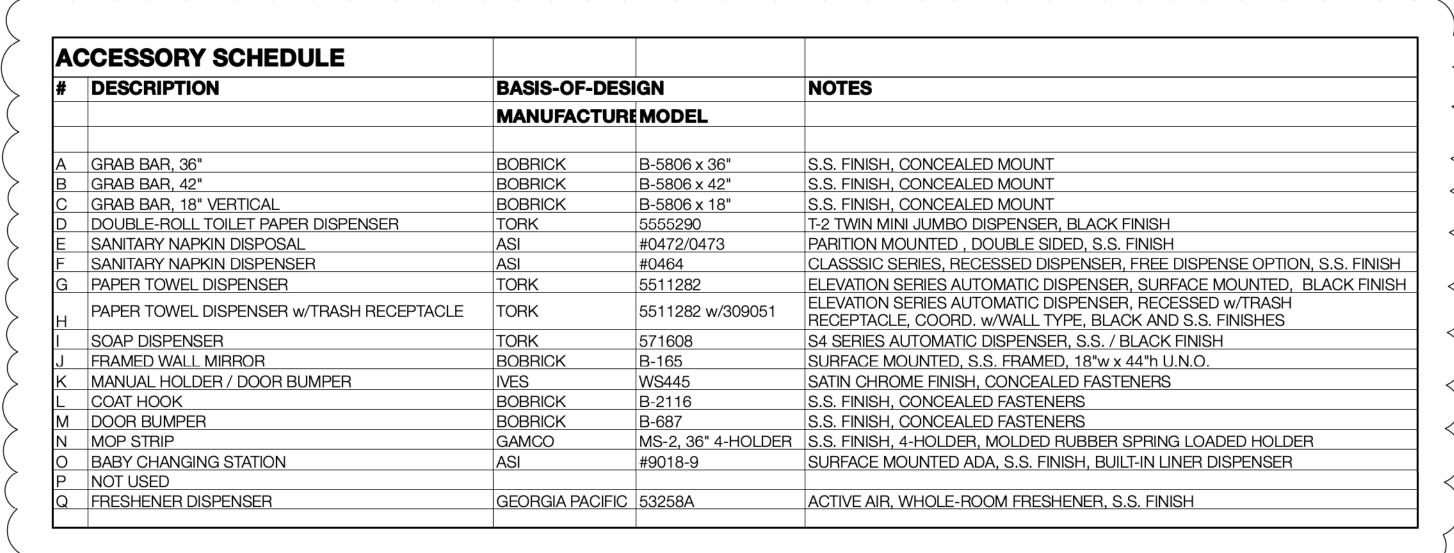


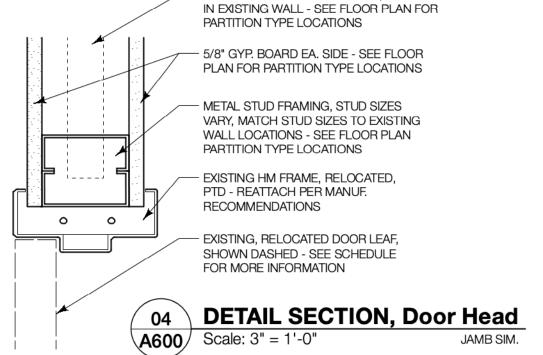


- SOUND ATTENUATION BLANKET, IF FOUND

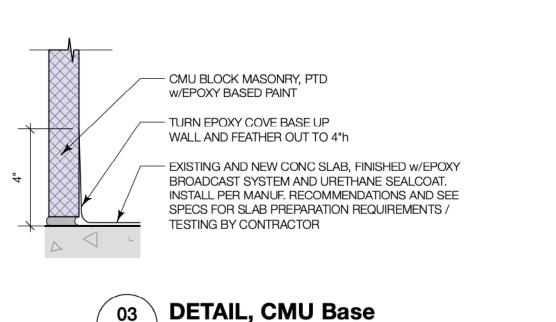

**A600** Scale: 3" = 1'-0"

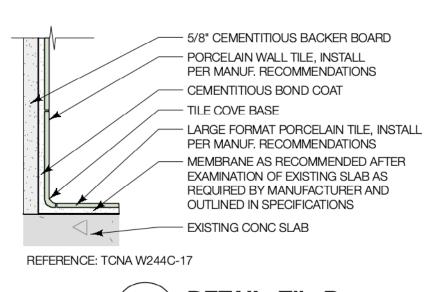



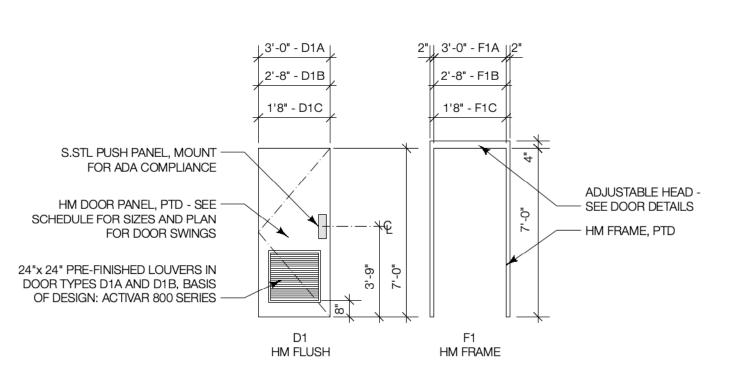

**DOOR TYPES AND FRAMES A600** Scale: 1/4" = 1'-0"


### **PROVISION STUDIO** RALEIGH, NC 27604

www.provisionstudio.design


Raleigh, NC 919.833.0495

Structural Engineer: Lysaght & Associates 120 St. Mary's Street

**MEP Engineer:** HDM Associates, Inc. 106 Tarheel Court Elizabeth City, NC 27909 252.698.3003

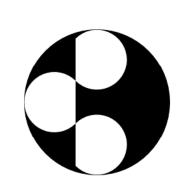




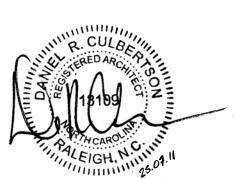

# **FIVE COUNTY STADIUM** ADA Phase 2

BID SET - 6/9/25

1501 NC Highway 39 Zebulon, NC 27597

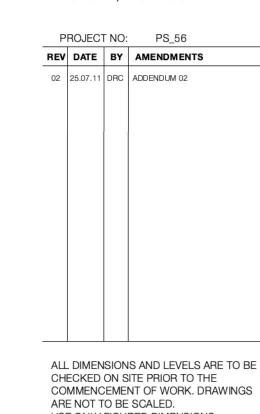

USE ONLY FIGURED DIMENSIONS.

**SCHEDULES** 

# A600

DRAWN:	DC	CHECKED: DC / JZ
25 June 09		PLOT DATE



106 Tarheel Court Elizabeth City, NC 27909 Phone: 252-698-3003

E-mail: hdma@mindspring.com

### **HDM Associates Addendum Items:**

**Date:** July 10, 2025

**Project** 

Title: Five County Stadium – ADA Phase 2

HDM

Project No.: 25001

#### **Specifications:**

- 1. Specification 224000 "Plumbing Fixtures" Part 2, Section 2.2 WATER CLOSET FLUSH VALVE FLOOR MOUNT FLOOR OUTLET HC (P-1A) Change section title to:
  - 2.2 WATER CLOSET FLUSH VALVE FLOOR MOUNT FLOOR OUTLET (P-1A)
- 2. Specification 224000 "Plumbing Fixtures" Part 2, Section 2.2, Paragraph A Delete and replace with the following:
  - A. Bowl: ANSI A112.19.2; floor mounted, floor outlet, siphon jet, vitreous china closet bowl, with elongated rim, 1-1/2 inch spud, and china bolt caps. American Standard, Madera or engineer approved equal.
- 3. Specification 224000 "Plumbing Fixtures" Part 2, Section 2.3 WATER CLOSET FLUSH VALVE FLOOR MOUNT FLOOR OUTLET (P-1) Change section title to:
  - 2.3 WATER CLOSET FLUSH VALVE FLOOR MOUNT FLOOR OUTLET HC (P-1)

#### **End of HDM Associates Addendum**