

Archived: Thursday, April 24, 2025 9:47:35 AM

From: [Medina, Steven](#)

Sent: Friday, April 18, 2025 10:56:48 AM

To: bchen@aqmd.gov ndickel@aqmd.gov [Christina Ojeda](#)

Cc: [Han, Jessie](#) [Haley, William \(Bill\)](#) [Amanda Froman](#) [Kelly Kincella](#) [Steve Cassulo](#) [Nicole Ward](#) [Viswanathan, Srividhya](#) [Jones, Art](#) kate.logan@wasteconnections.com

Subject: Re: Case No. 6177-4 Stipulated Order for Abatement – Well Drilling Update

Importance: Normal

Sensitivity: None

Attachments:

[Outlook-fdqfclry.png](#) [Outlook-r0vhbgs4.png](#) [Outlook-s2q2drr0.png](#) [Outlook-4kwivhay.png](#) [Outlook-msz1rpn.png](#)
[Outlook-snn2unzq.png](#) [Outlook-fioyy3wu.png](#) [Outlook-k2bojgrm.png](#) [Outlook-crz2za3u.png](#) [2025 CCLF GCCS Expan](#)
[Master Plan_Proposed LFG Extraction Well and Temp Probe Map_2025-04-18.pdf](#)

[EXTERNAL SENDER: Use caution with links/attachments]

All,

In accordance with Condition 15(c) of the Stipulated Order, below is the up-to-date construction summary for the Chiquita Canyon Landfill 2024 GCCS Expansion Master Plan Project.

During 04/14/2025 to 04/18/2025, Chiquita completed the installation of zero (0) vertical LFG extraction wells, as forecasted in our April 11, 2025, update. The total count of vertical LFG extraction wells installed from December 6, 2023 (the start date of the GCCS Master Expansion) through today remains two hundred thirty-five (235).

During 04/14/2025 to 04/18/2025, Chiquita completed the installation of zero (0) temperature probes, as forecasted in our April 11, 2025, update. The total count of temperature probes installed from February 26th, 2024 (the start date of the temperature probe installations) through today remains thirty-two (32).

The wells and temperature probes scheduled for drilling during the week of 04/21/2025 to 04/25/2025 are as follows (subject to change):

Rig 0 (Continuum): The drilling rig has mobilized off-site and is no longer drilling. The twenty-three (23) proposed wells, as shown on the attached map, are planned for potential drilling this year but remain subject to change.

Temperature Probe Rig (Cascade): Drilling is currently on hold, as forecasted in our April 11, 2025, update. Chiquita is evaluating the installation of the remaining two temperature probes (TMP-22 and TMP-23).

Regards,

STEVEN Ruben Medina, **E.I.T.**

Associate Professional

SCS Engineers

3900 Kilroy Airport Way, Suite 300


Long Beach, CA 90806

858-204-4342 (c)

5160srm@scsengineers.com

Driven by Client Success

www.scsengineers.com

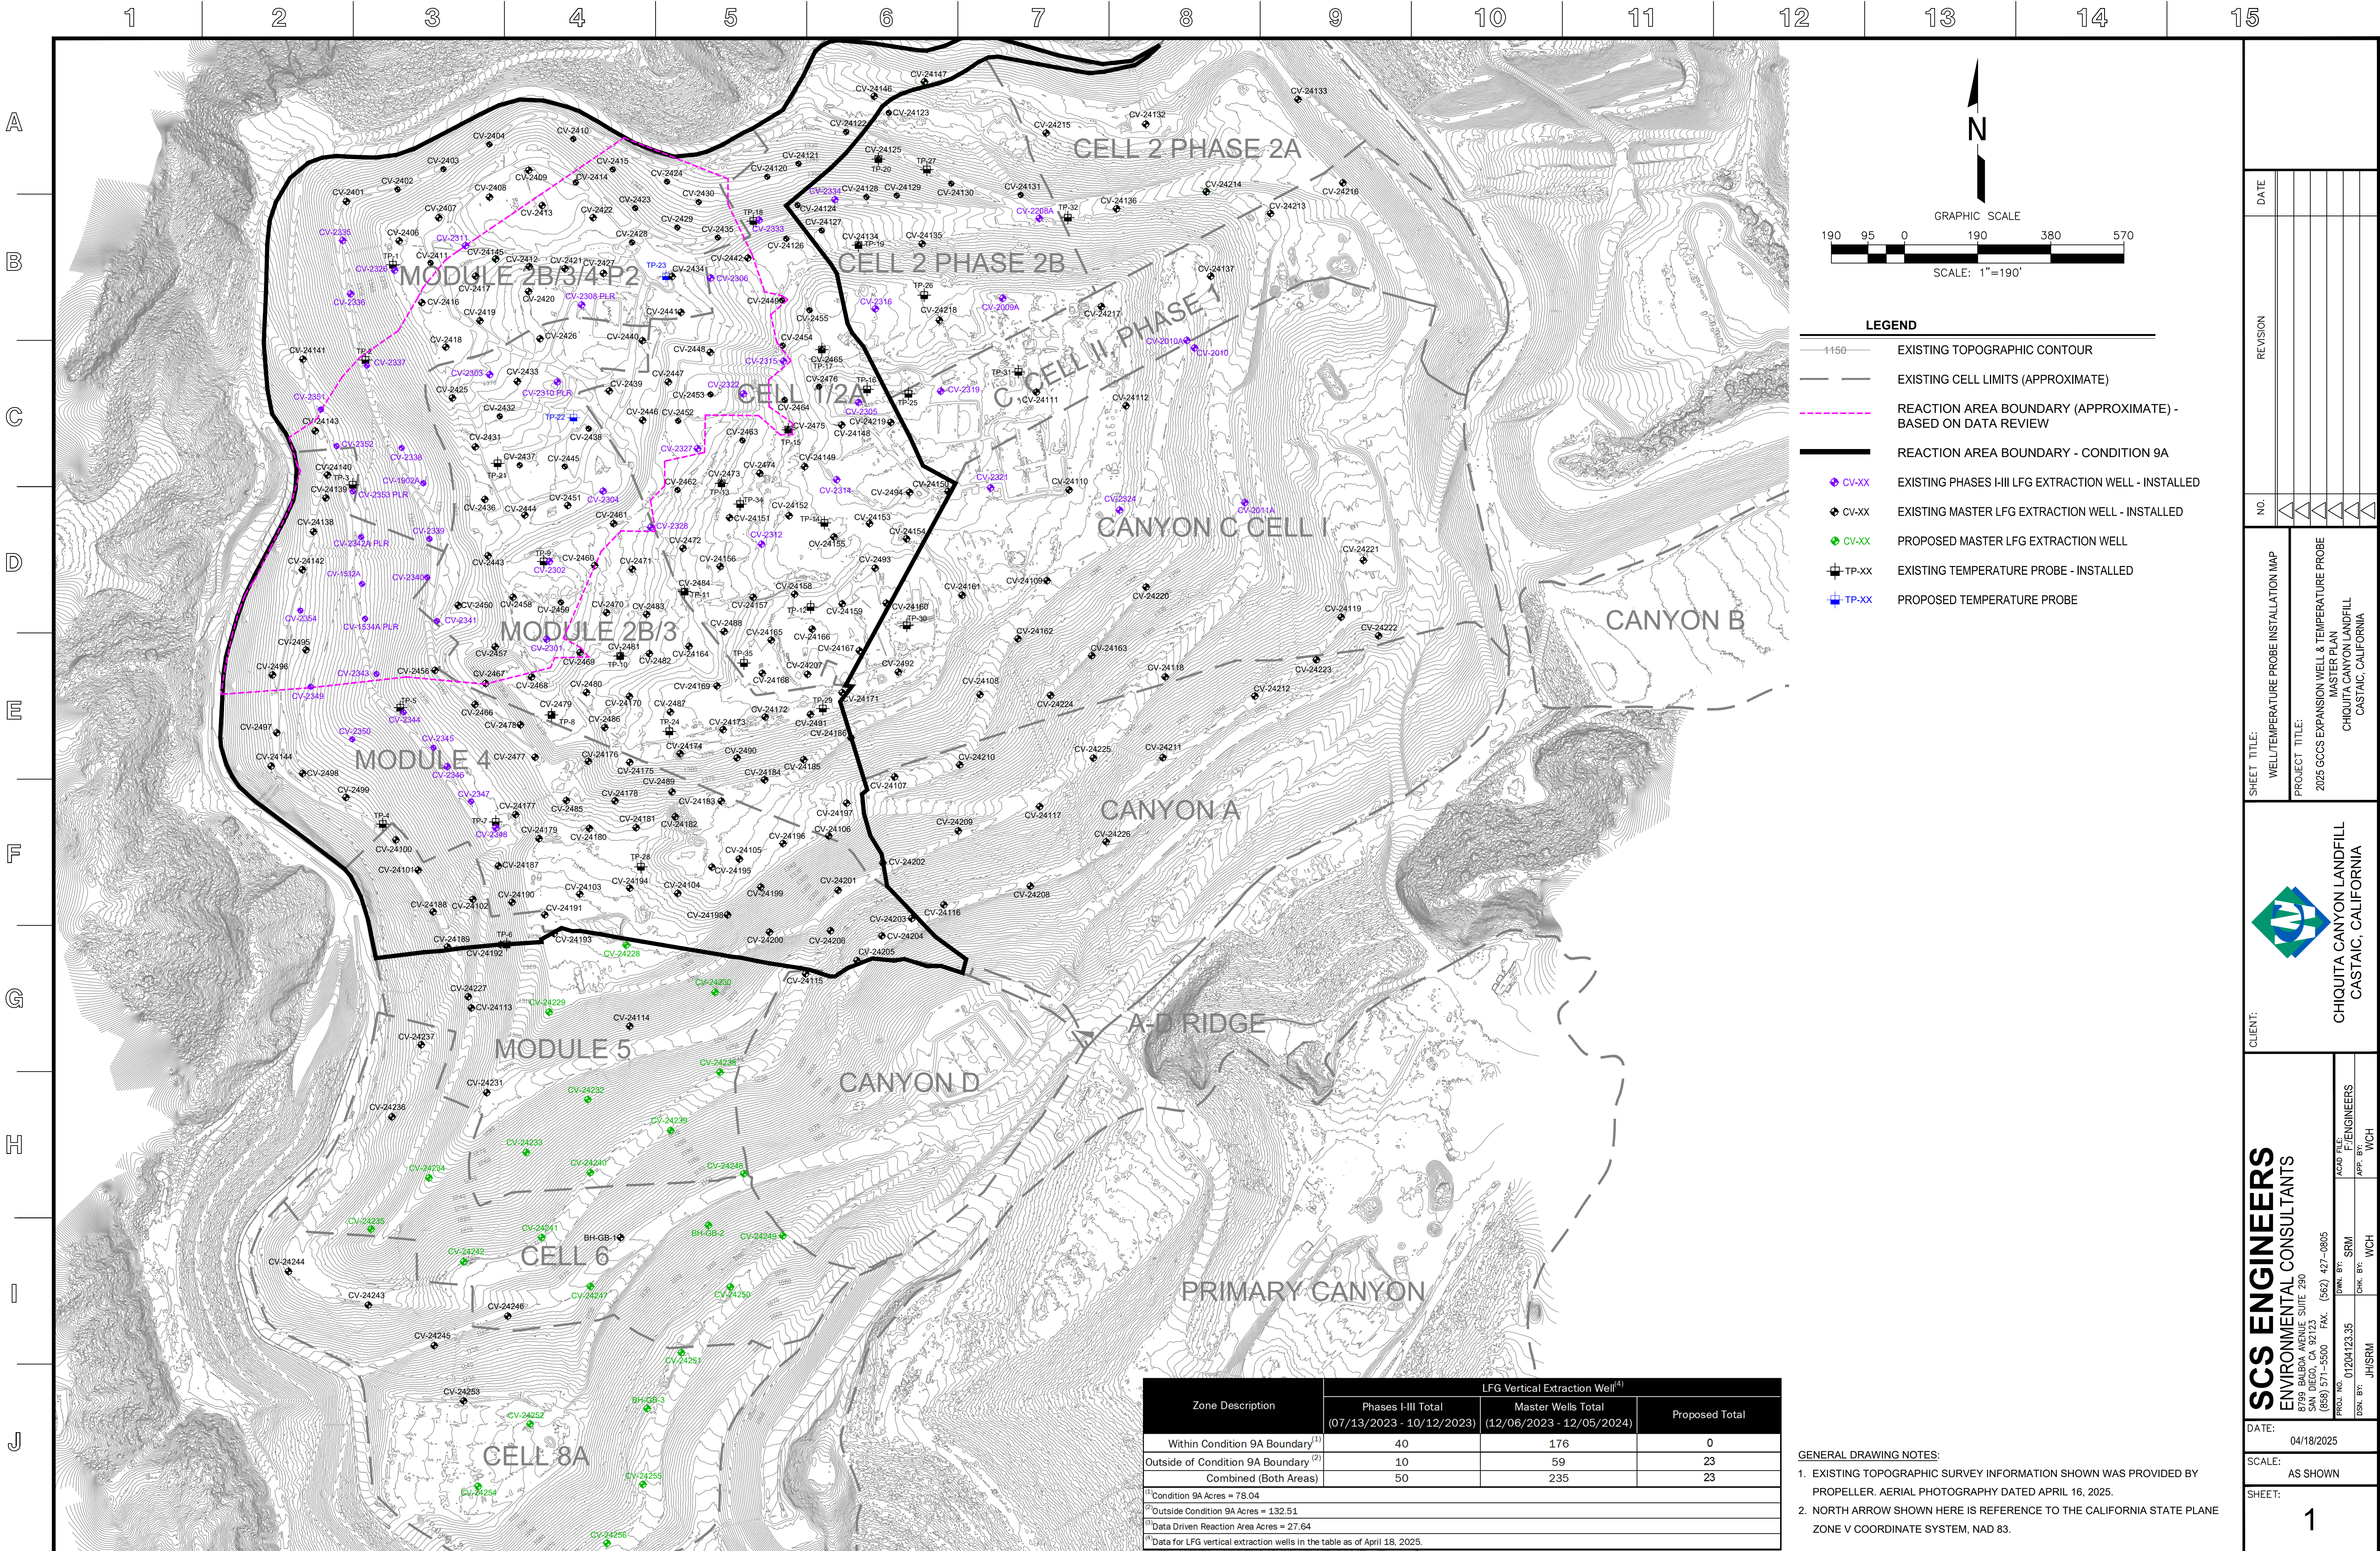

190950190380570

GRAPHIC SCALE

SCALE: 1"=190'

1150

EXISTING TOPOGRAPHIC CONTOUR

EXISTING CELL LIMITS (APPROXIMATE)

REACTION AREA BOUNDARY (APPROXIMATE) - BASED ON DATA REVIEW

REACTION AREA BOUNDARY - CONDITION 9A

CV-XX

EXISTING PHASES I-III LFG EXTRACTION WELL - INSTALLED

CV-XX

EXISTING MASTER LFG EXTRACTION WELL - INSTALLED

CV-XX

PROPOSED MASTER LFG EXTRACTION WELL

TP-XX

EXISTING TEMPERATURE PROBE - INSTALLED

TP-XX

PROPOSED TEMPERATURE PROBE

Zone Description	LFG Vertical Extraction Well ⁽⁴⁾		
	Phases I-III Total (07/13/2023 - 10/12/2023)	Master Wells Total (12/06/2023 - 12/05/2024)	Proposed Total
Within Condition 9A Boundary ⁽¹⁾	40	176	0
Outside of Condition 9A Boundary ⁽²⁾	10	59	23
Combined (Both Areas)	50	235	23

⁽¹⁾Condition 9A Acres = 78.04

⁽²⁾Outside Condition 9A Acres = 132.51

⁽³⁾Data Driven Reaction Area Acres = 27.64

⁽⁴⁾Data for LFG vertical extraction wells in the table as of April 18, 2025.

GENERAL DRAWING NOTES:

1. EXISTING TOPOGRAPHIC SURVEY INFORMATION SHOWN WAS PROVIDED BY PROPELLER. AERIAL PHOTOGRAPHY DATED APRIL 16, 2025.

2. NORTH ARROW SHOWN HERE IS REFERENCE TO THE CALIFORNIA STATE PLANE ZONE V COORDINATE SYSTEM, NAD 83.

DATE: 04/18/2025

SCALE: AS SHOWN

SHEET: 1