

Archived: Friday, May 2, 2025 10:06:20 AM

From: [Medina, Steven](#)

Sent: Friday, April 25, 2025 9:10:50 AM

To: bchen@aqmd.gov ndickel@aqmd.gov [Christina Ojeda](#)

Cc: [Han, Jessie Haley, William \(Bill\)](#) [Amanda Froman Kelly Kincella](#) [Steve Cassulo](#) [Nicole Ward](#) [Viswanathan, Srividhya Jones, Art](#) kate.logan@wasteconnections.com

Subject: Re: Case No. 6177-4 Stipulated Order for Abatement – Well Drilling Update

Importance: Normal

Sensitivity: None

Attachments:

[Outlook-fdqfclry.png](#) [Outlook-r0vhbgs4.png](#) [Outlook-s2q2drr0.png](#) [Outlook-4kwivhay.png](#) [Outlook-msz1rpn.png](#)
[Outlook-snn2unzq.png](#) [Outlook-fioyy3wu.png](#) [Outlook-k2bojgrm.png](#) [Outlook-crz2za3u.png](#) [Outlook-hpwurbl1.png](#) 025
[CCLF GCCS Expan Master Plan_Proposed LFG Extraction Well and Temp Probe Map_2025-04-25.pdf](#)

[EXTERNAL SENDER: Use caution with links/attachments]

All,

In accordance with Condition 15(c) of the Stipulated Order, below is the up-to-date construction summary for the Chiquita Canyon Landfill 2024 GCCS Expansion Master Plan Project.

During 04/21/2025 to 04/25/2025, Chiquita completed the installation of zero (0) vertical LFG extraction wells, as forecasted in our April 18, 2025, update. The total count of vertical LFG extraction wells installed from December 6, 2023 (the start date of the GCCS Master Expansion) through today remains two hundred thirty-five (235).

During 04/21/2025 to 04/25/2025, Chiquita completed the installation of zero (0) temperature probes, as forecasted in our April 18, 2025, update. The total count of temperature probes installed from February 26th, 2024 (the start date of the temperature probe installations) through today remains thirty-two (32).

The wells and temperature probes scheduled for drilling during the week of 04/28/2025 to 05/02/2025 are as follows (subject to change):

Rig 0 (Continuum): The drilling rig has mobilized off-site and is no longer drilling. The twenty-three (23) proposed wells, as shown on the attached map, are planned for potential drilling this year but remain subject to change.

Temperature Probe Rig (Cascade): Drilling is currently on hold, as forecasted in our April 18, 2025, update. Chiquita is evaluating the installation of the remaining two temperature probes (TMP-22 and TMP-23).

Regards,

STEVEN Ruben Medina, **E.I.T.**

Staff Professional

SCS Engineers

3900 Kilroy Airport Way, Suite 300



Long Beach, CA 90806

858-204-4342 (c)

5160srm@scsengineers.com

Driven by Client Success

www.scsengineers.com

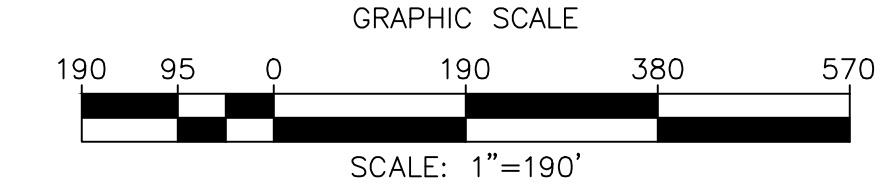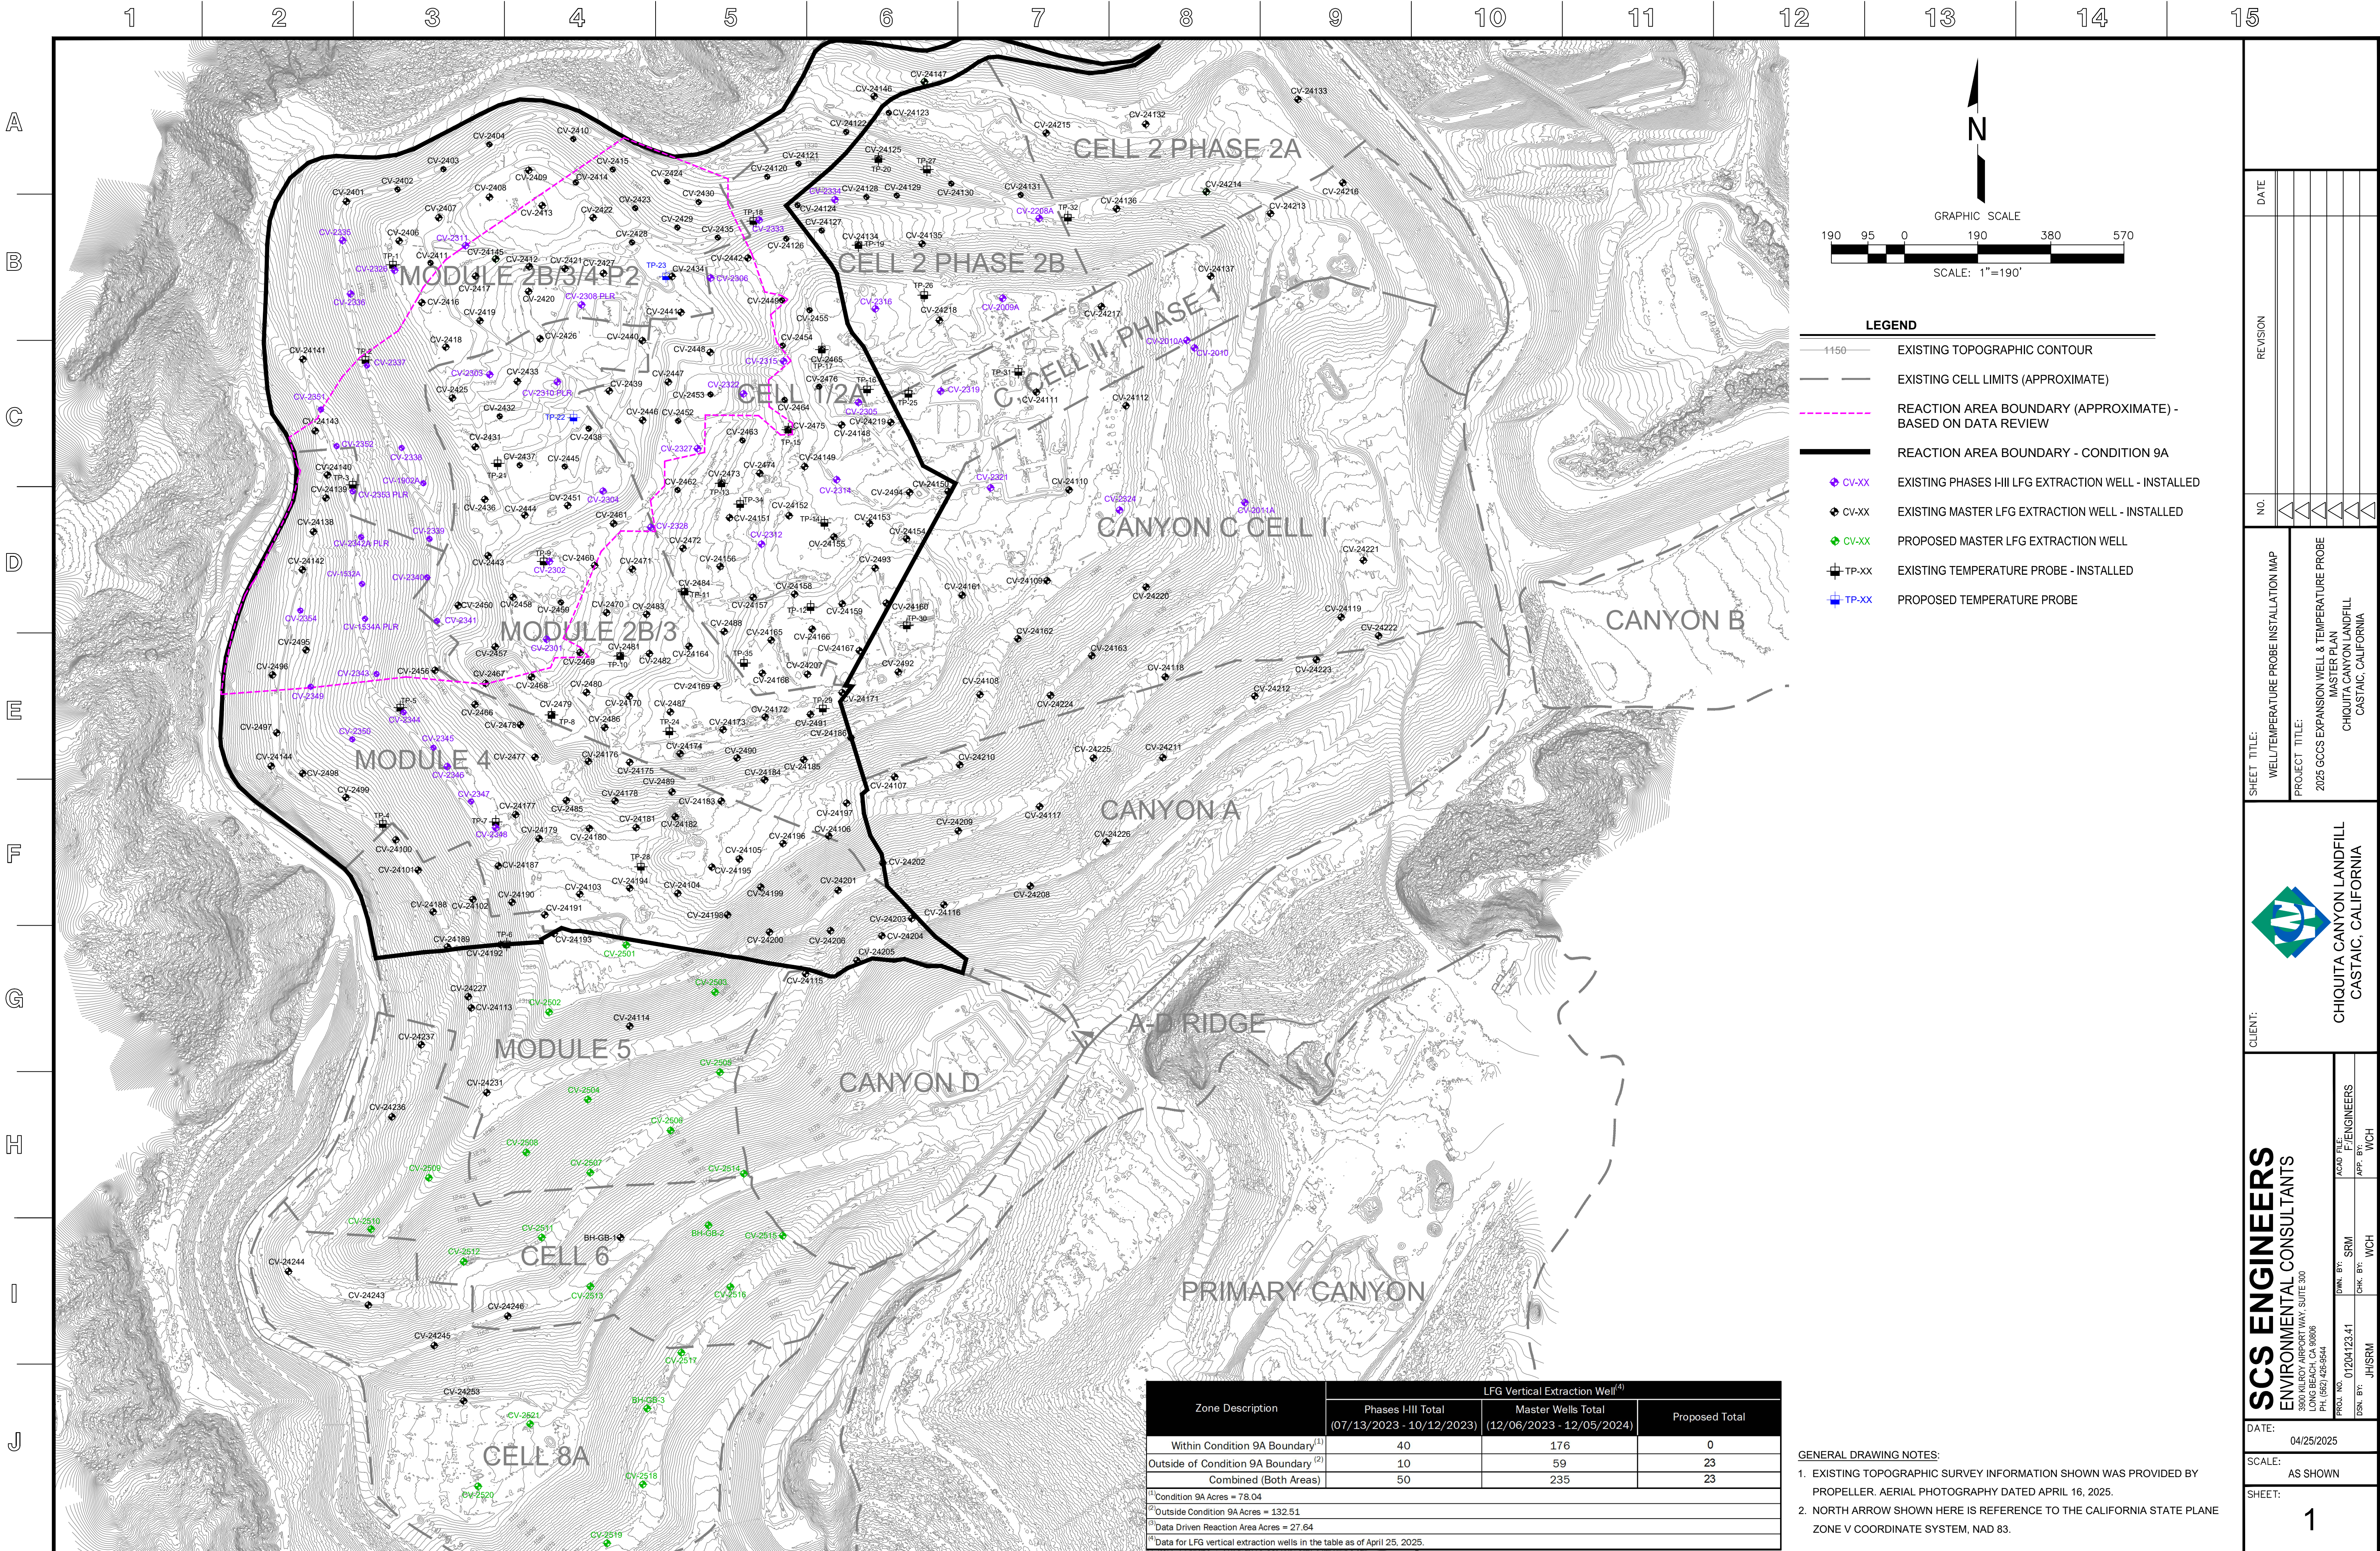

- LEGEND**
- 1150 EXISTING TOPOGRAPHIC CONTOUR
 - EXISTING CELL LIMITS (APPROXIMATE)
 - REACTION AREA BOUNDARY (APPROXIMATE) - BASED ON DATA REVIEW
 - REACTION AREA BOUNDARY - CONDITION 9A
 - EXISTING PHASES I-III LFG EXTRACTION WELL - INSTALLED
 - EXISTING MASTER LFG EXTRACTION WELL - INSTALLED
 - PROPOSED MASTER LFG EXTRACTION WELL
 - EXISTING TEMPERATURE PROBE - INSTALLED
 - PROPOSED TEMPERATURE PROBE

Zone Description	LFG Vertical Extraction Well ⁽⁴⁾		
	Phases I-III Total (07/13/2023 - 10/12/2023)	Master Wells Total (12/06/2023 - 12/05/2024)	Proposed Total
Within Condition 9A Boundary ⁽¹⁾	40	176	0
Outside of Condition 9A Boundary ⁽²⁾	10	59	23
Combined (Both Areas)	50	235	23

⁽¹⁾Condition 9A Acres = 78.04
⁽²⁾Outside Condition 9A Acres = 132.51
⁽³⁾Data Driven Reaction Area Acres = 27.64
⁽⁴⁾Data for LFG vertical extraction wells in the table as of April 25, 2025.

GENERAL DRAWING NOTES:

1. EXISTING TOPOGRAPHIC SURVEY INFORMATION SHOWN WAS PROVIDED BY PROPELLER. AERIAL PHOTOGRAPHY DATED APRIL 16, 2025.

2. NORTH ARROW SHOWN HERE IS REFERENCE TO THE CALIFORNIA STATE PLANE ZONE V COORDINATE SYSTEM, NAD 83.

DATE	
REVISION	
NO.	
SHEET TITLE:	WELL/TEMPERATURE PROBE INSTALLATION MAP
PROJECT TITLE:	2025 GCCS EXPANSION WELL & TEMPERATURE PROBE MASTER PLAN CHIQUITA CANYON LANDFILL CASTAIC, CALIFORNIA
CLIENT:	 CHIQUITA CANYON LANDFILL CASTAIC, CALIFORNIA
DATE:	04/25/2025
SCALE:	AS SHOWN
SHEET:	1